


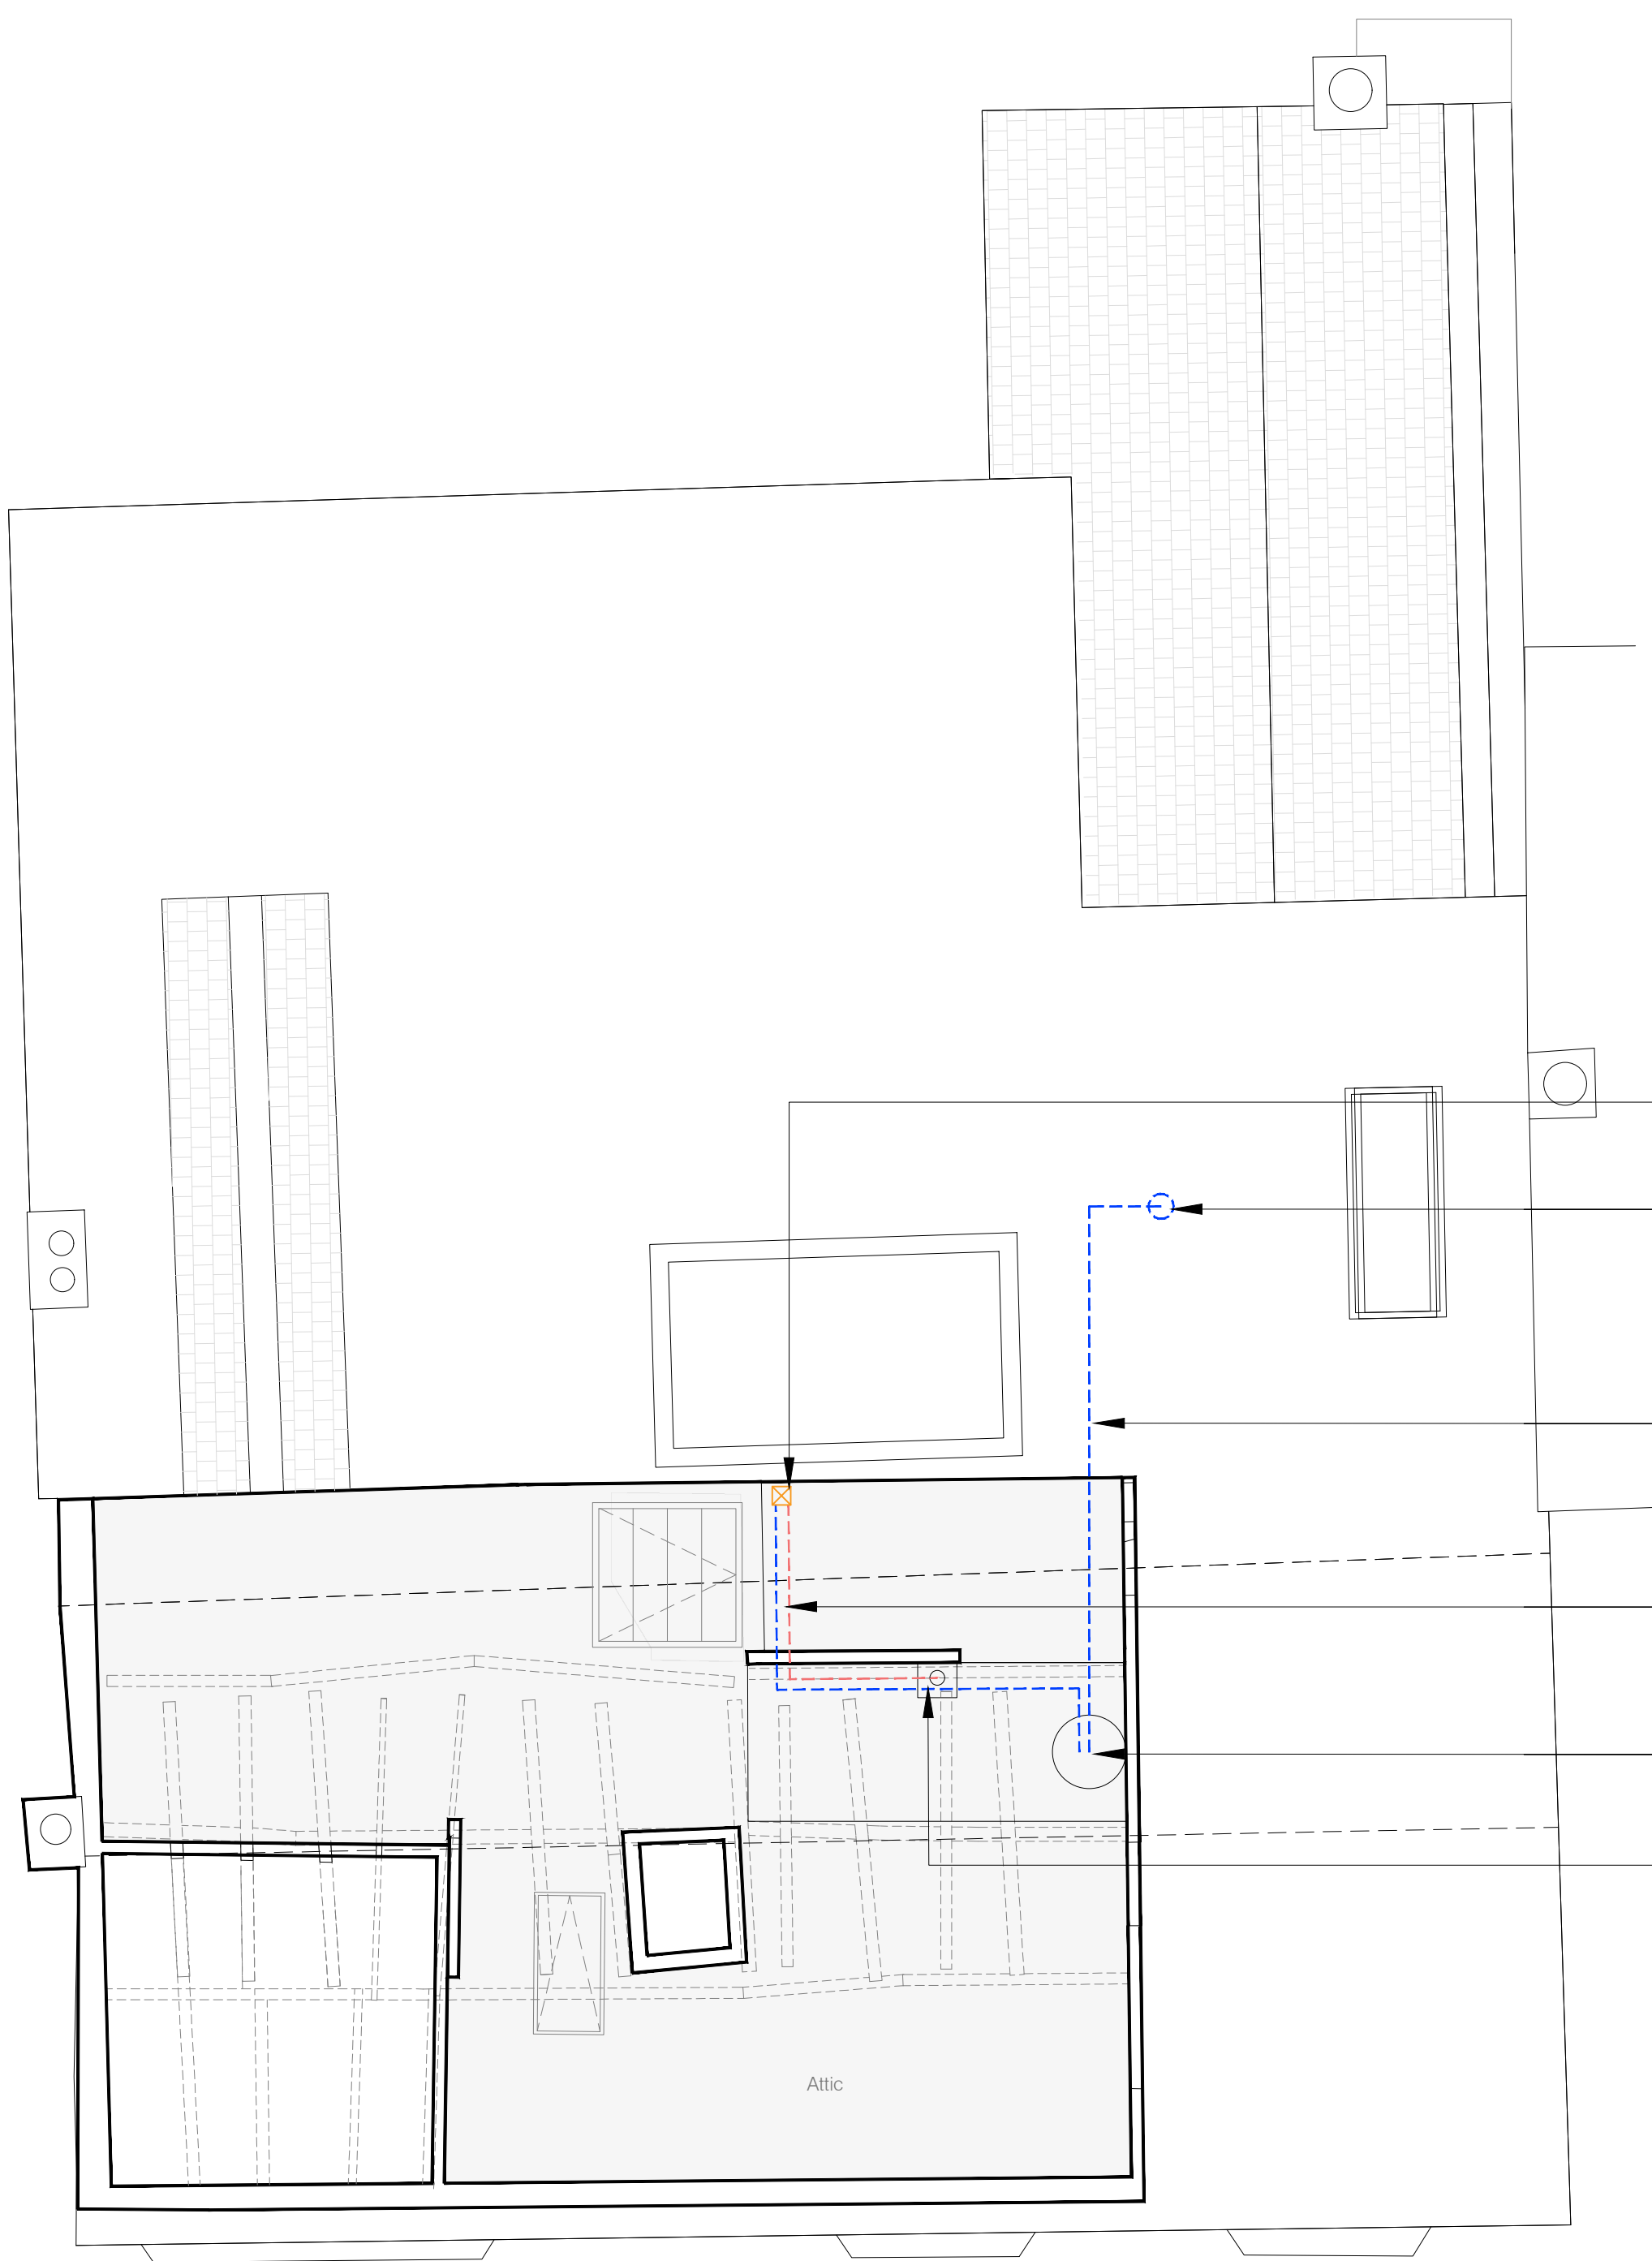


- Riser from cellar
- .Services drop down within new walls to new bathroom below
- Hot&Cold Water services run through between new & existing roof structure. Services drop down within new walls to new bathroom below
- Gas & Water Services
- New Water Tank
- New boiler

SECOND FLOOR PLAN  
Scale 1:50@A1  
1:100@A3

NOTE  
DRAWINGS TO BE READ IN CONJUNCTION WITH SUBMITTED  
DESIGN&ACCESS STATEMENT AND HERITAGE STATEMENT

SERVICES INFORMATION OBTAINED FROM THE CONTRACTOR  
WHO INSTALLED IT.

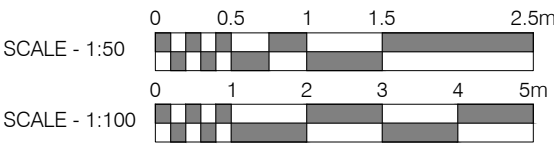

| Rev. | Comments: | By: | Date: |
|------|-----------|-----|-------|
| -    | -         | -   | -     |

Do not scale this drawing All dimensions must be checked on site  
All rights reserved. No reproduction in any material form is permitted  
without consent.

| LISTED BUILDING<br>CONSENT                                                      |                 |              |                |
|---------------------------------------------------------------------------------|-----------------|--------------|----------------|
| Client:<br>Mr. Simon Dougall                                                    |                 |              |                |
| Project Title:<br>107 High St, Lindfield, Haywards Heath, West Sussex, RH16 2HR |                 |              |                |
| Drawing Title:<br>'As Built' Services:<br>Second Floor                          |                 |              |                |
| Scale:<br>1:50@A1<br>1:100@A3                                                   | Date:<br>Sep 25 | Drawn:<br>KN | Checked:<br>KW |

| kyson <sup>®</sup>                                                                                                                   |                      |                |
|--------------------------------------------------------------------------------------------------------------------------------------|----------------------|----------------|
| Studio<br>28 Scrutton Street<br>London<br>UK<br>EC2A 4RP<br>T: +44(0) 20 7247 2462<br>E: enquiries@kyson.co.uk<br>W: www.kyson.co.uk |                      |                |
| Project No.:<br>900-25                                                                                                               | Drawing No.:<br>2402 | Revision:<br>- |