


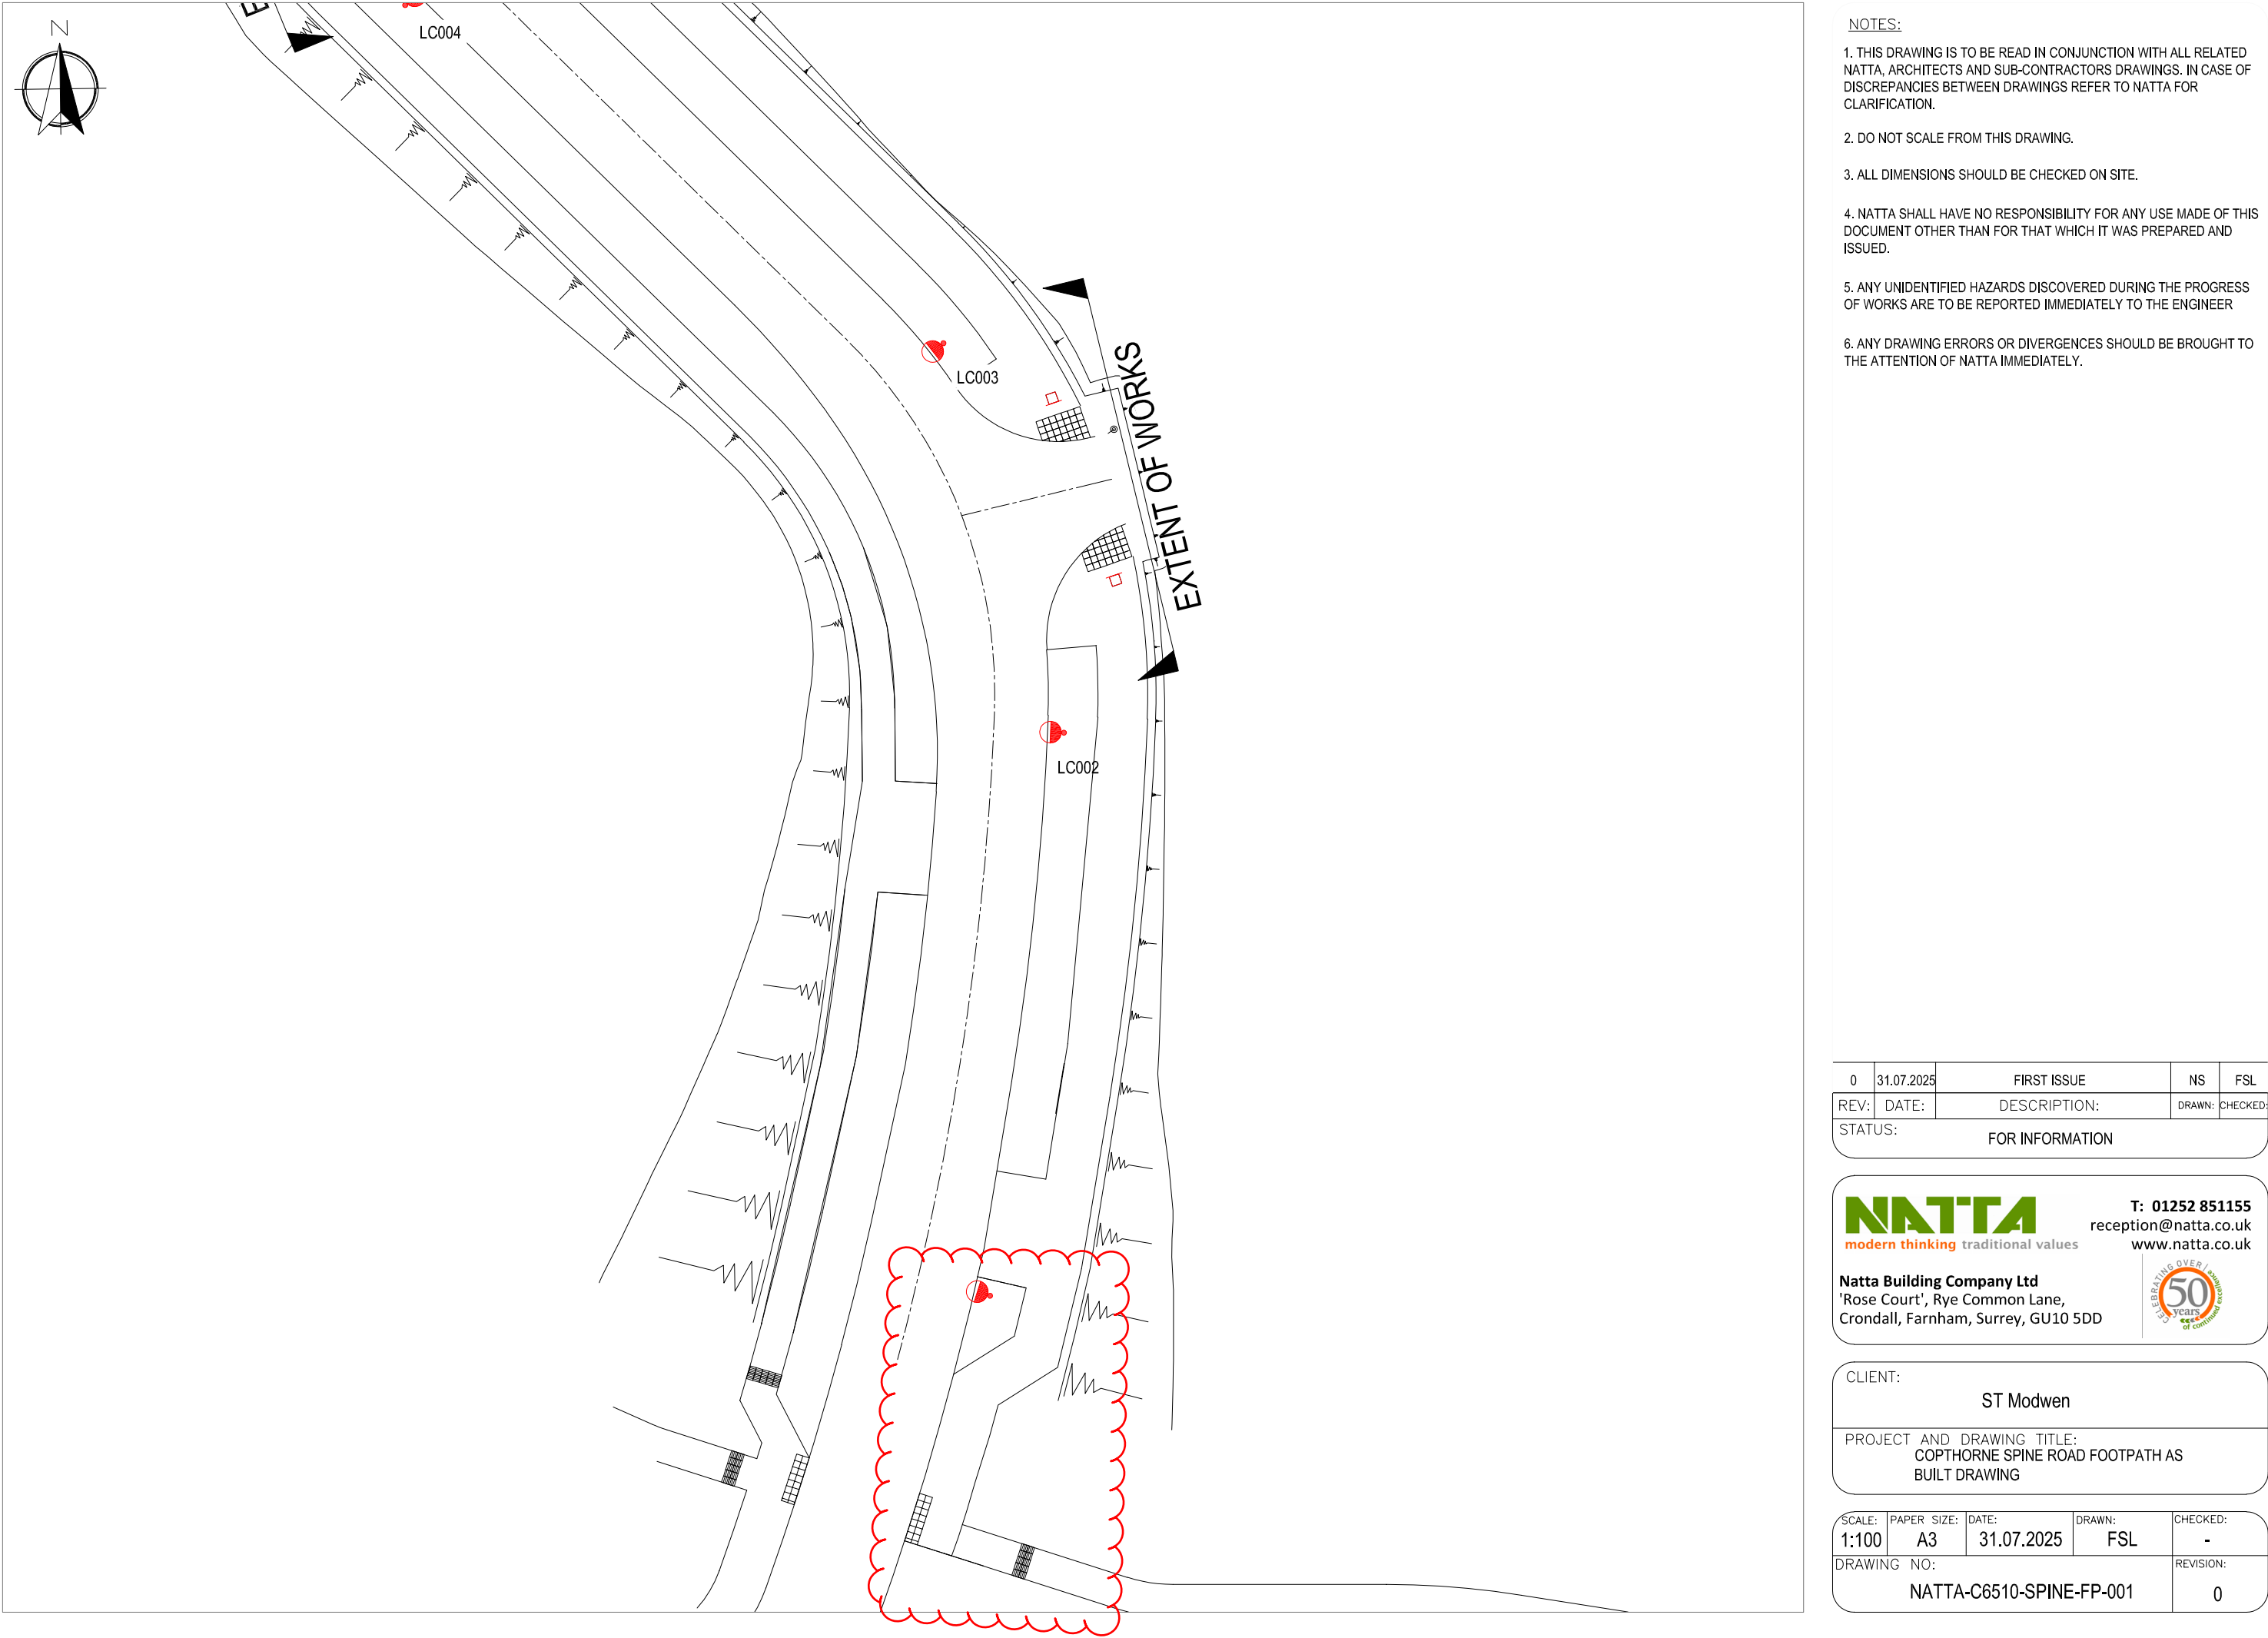

- NOTES:
1. THIS DRAWING IS TO BE READ IN CONJUNCTION WITH ALL RELATED NATTA, ARCHITECTS AND SUB-CONTRACTORS DRAWINGS. IN CASE OF DISCREPANCIES BETWEEN DRAWINGS REFER TO NATTA FOR CLARIFICATION.
  2. DO NOT SCALE FROM THIS DRAWING.
  3. ALL DIMENSIONS SHOULD BE CHECKED ON SITE.
  4. NATTA SHALL HAVE NO RESPONSIBILITY FOR ANY USE MADE OF THIS DOCUMENT OTHER THAN FOR THAT WHICH IT WAS PREPARED AND ISSUED.
  5. ANY UNIDENTIFIED HAZARDS DISCOVERED DURING THE PROGRESS OF WORKS ARE TO BE REPORTED IMMEDIATELY TO THE ENGINEER
  6. ANY DRAWING ERRORS OR DIVERGENCES SHOULD BE BROUGHT TO THE ATTENTION OF NATTA IMMEDIATELY.

|         |            |                 |        |          |
|---------|------------|-----------------|--------|----------|
| 0       | 31.07.2025 | FIRST ISSUE     | NS     | FSL      |
| REV:    | DATE:      | DESCRIPTION:    | DRAWN: | CHECKED: |
| STATUS: |            | FOR INFORMATION |        |          |



**T: 01252 851155**  
reception@natta.co.uk  
www.natta.co.uk

**Natta Building Company Ltd**  
'Rose Court', Rye Common Lane,  
Crondall, Farnham, Surrey, GU10 5DD



CLIENT:

ST Modwen

PROJECT AND DRAWING TITLE:

COPTHORNE SPINE ROAD FOOTPATH AS BUILT DRAWING

|                          |             |            |        |           |
|--------------------------|-------------|------------|--------|-----------|
| SCALE:                   | PAPER SIZE: | DATE:      | DRAWN: | CHECKED:  |
| 1:100                    | A3          | 31.07.2025 | FSL    | -         |
| DRAWING NO:              |             |            |        | REVISION: |
| NATTA-C6510-SPINE-FP-001 |             |            |        | 0         |