


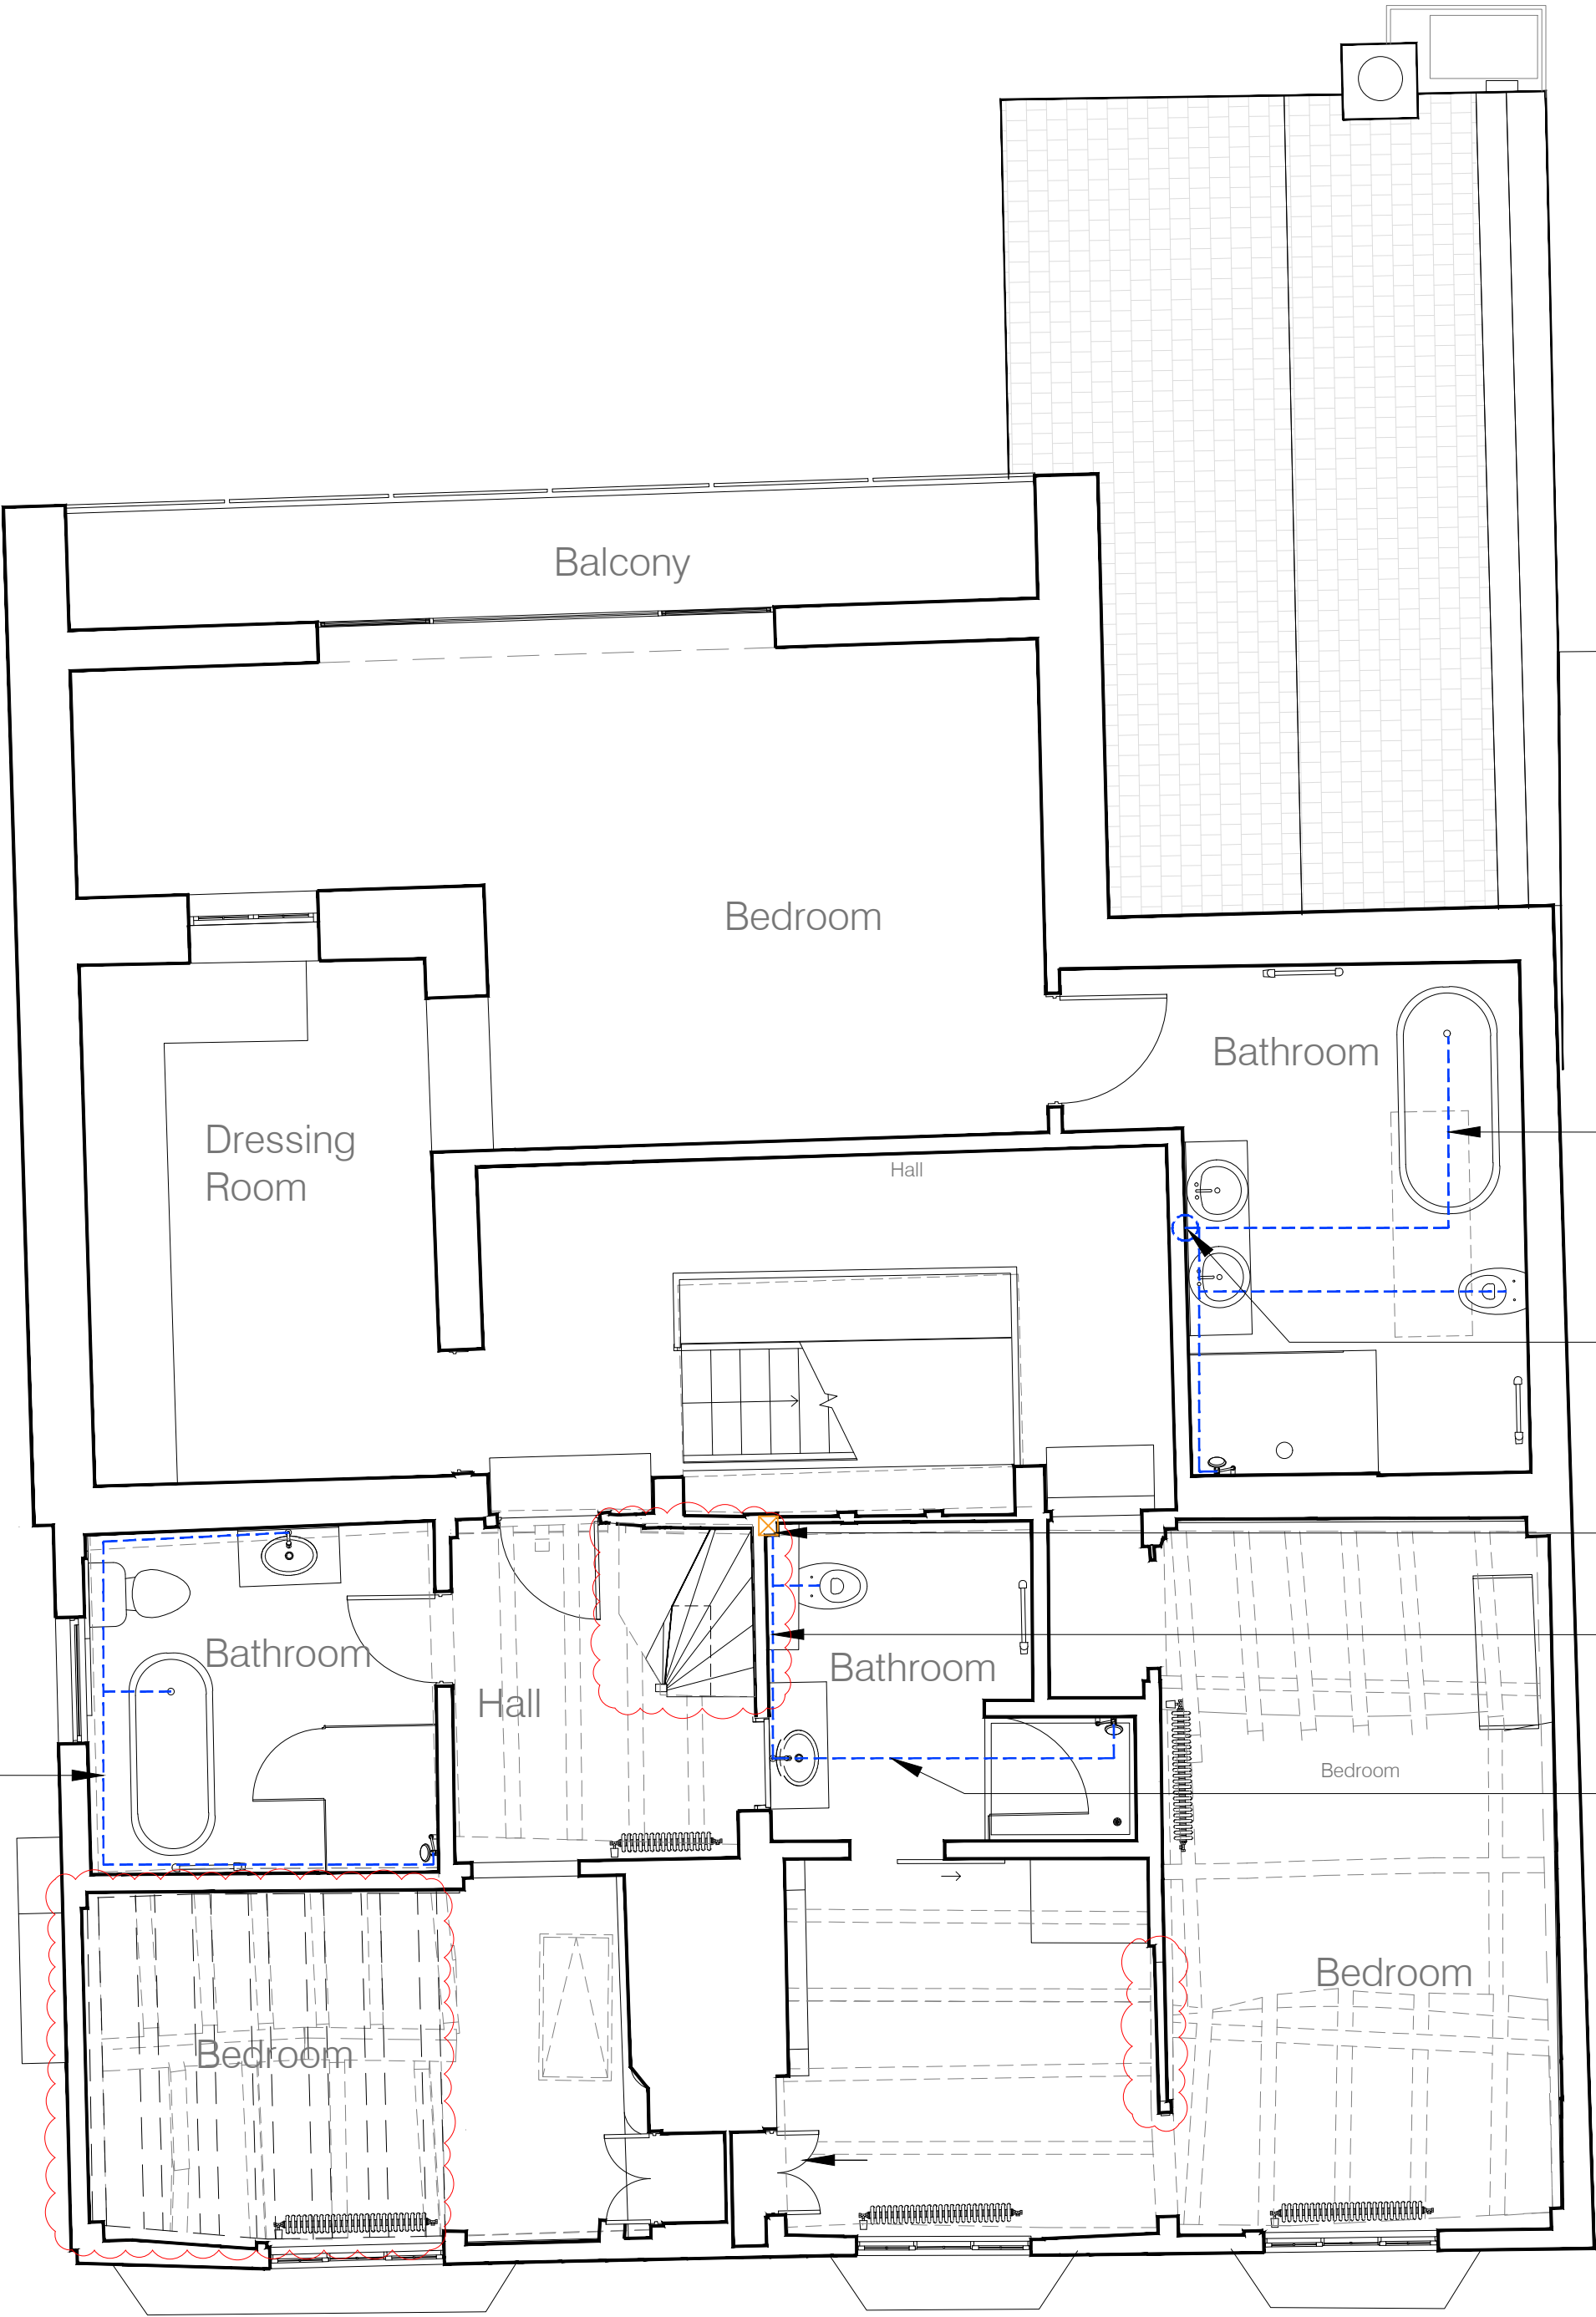

Water services rise from WC below, clipped to joists

Water services distributed from new wall via new floor structure

Water services drop in new walls to new bathroom & utility below

Service riser from cellar to loft


Water pipes clipped to joists

Joists notched to allow for pipe runs

FIRST FLOOR PLAN
Scale 1:50@A1
1:100@A3

NOTE
DRAWINGS TO BE READ IN CONJUNCTION WITH SUBMITTED
DESIGN&ACCESS STATEMENT AND HERITAGE STATEMENT

SERVICES INFORMATION OBTAINED FROM THE CONTRACTOR
WHO INSTALLED IT.

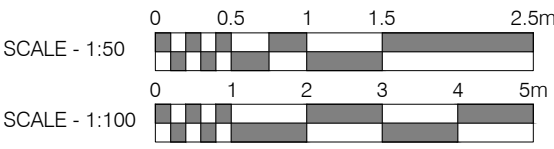

Rev.	Comments:	By:	Date:
A	Amendments as clouded.	KN	Nov 25

Do not scale this drawing All dimensions must be checked on site
All rights reserved. No reproduction in any material form is permitted without consent.

LISTED BUILDING CONSENT			
Client: Mr. Simon Dougall			
Project Title: 107 High St, Lindfield, Haywards Heath, West Sussex, RH16 2HR			
Drawing Title: 'As-Built' Services: First Floor			
Scale:	Date:	Drawn:	Checked:
1:50@A1 1:100@A3	Sep 25	KN	KW

kyson [®] Studio		
28 Scrutton Street London UK EC2A 4RP		
T: +44(0) 20 7247 2462 E: enquiries@kyson.co.uk W: www.kyson.co.uk		
Project No.:	Drawing No.:	Revision:
900-25	2401	A