


5 CLAYTON PARK, HASSOCKS, WEST SUSSEX, BN6 8JQ

August 2026

Drawing : 529/ 01A

rev A. 25 Aug 26: proposed pergola shown hatched

Retrospective application for a pergola with operable louvre panels. Fabric blinds to north and east side and glass sliding panels facing the garden on the east side of the pergola and a bespoke wooden shed with door opening into garden. All in a sunken garden; lower than main back garden.

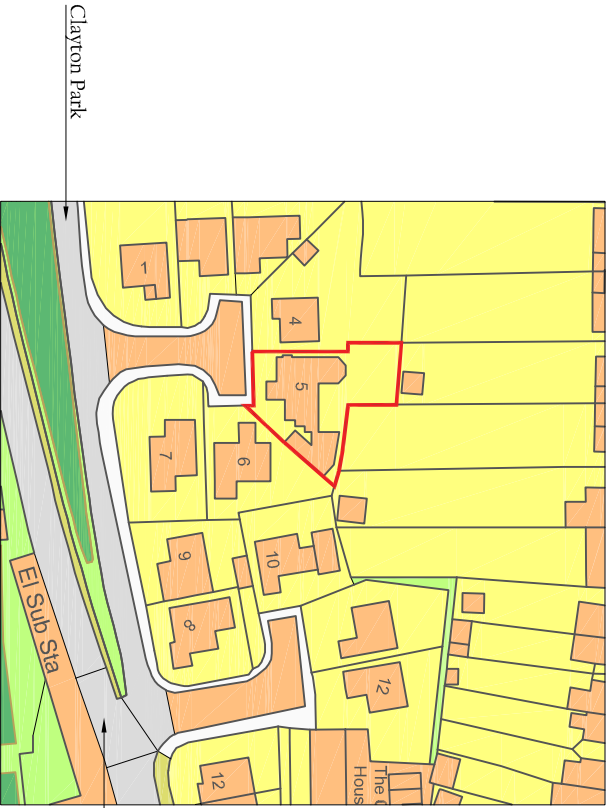


LOCATION PLAN (PRE- DEVELOPMENT) 1:1250

site boundary outlined in red



SCALE BAR 1:1250

NB: Location plan and block plan are based on ordnance survey information

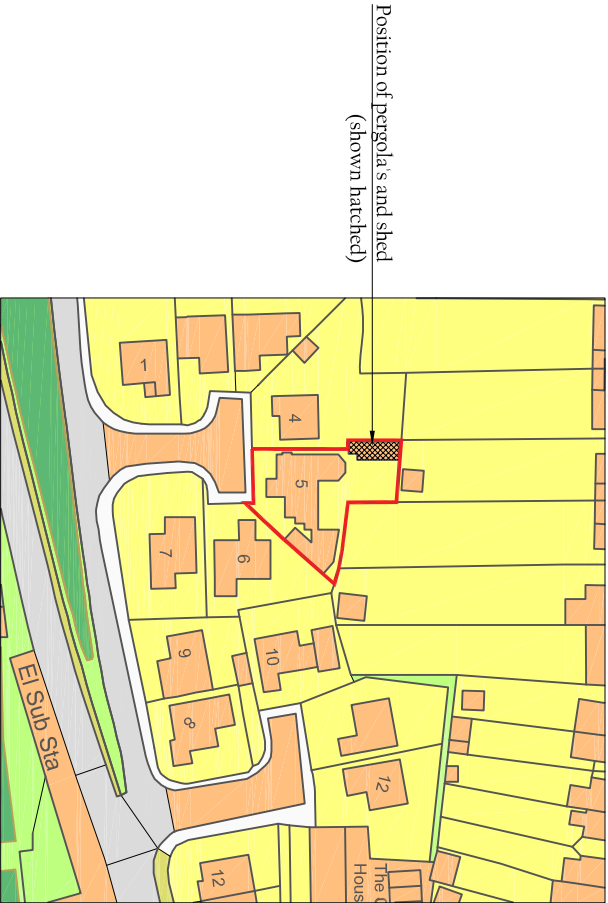


AS BUILT LOCATION PLAN 1:1250

site boundary outlined in red



SCALE BAR 1:1250

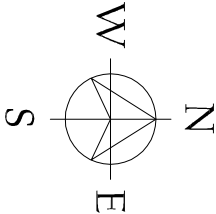

JAMES BRECKELL : ARCHITECT : ARB : RIBA

89 Old Fort Road, Shoreham by Sea, West Sussex, BN43 5HA Tel 07733 268 297, Email: james@breckell.co.uk