


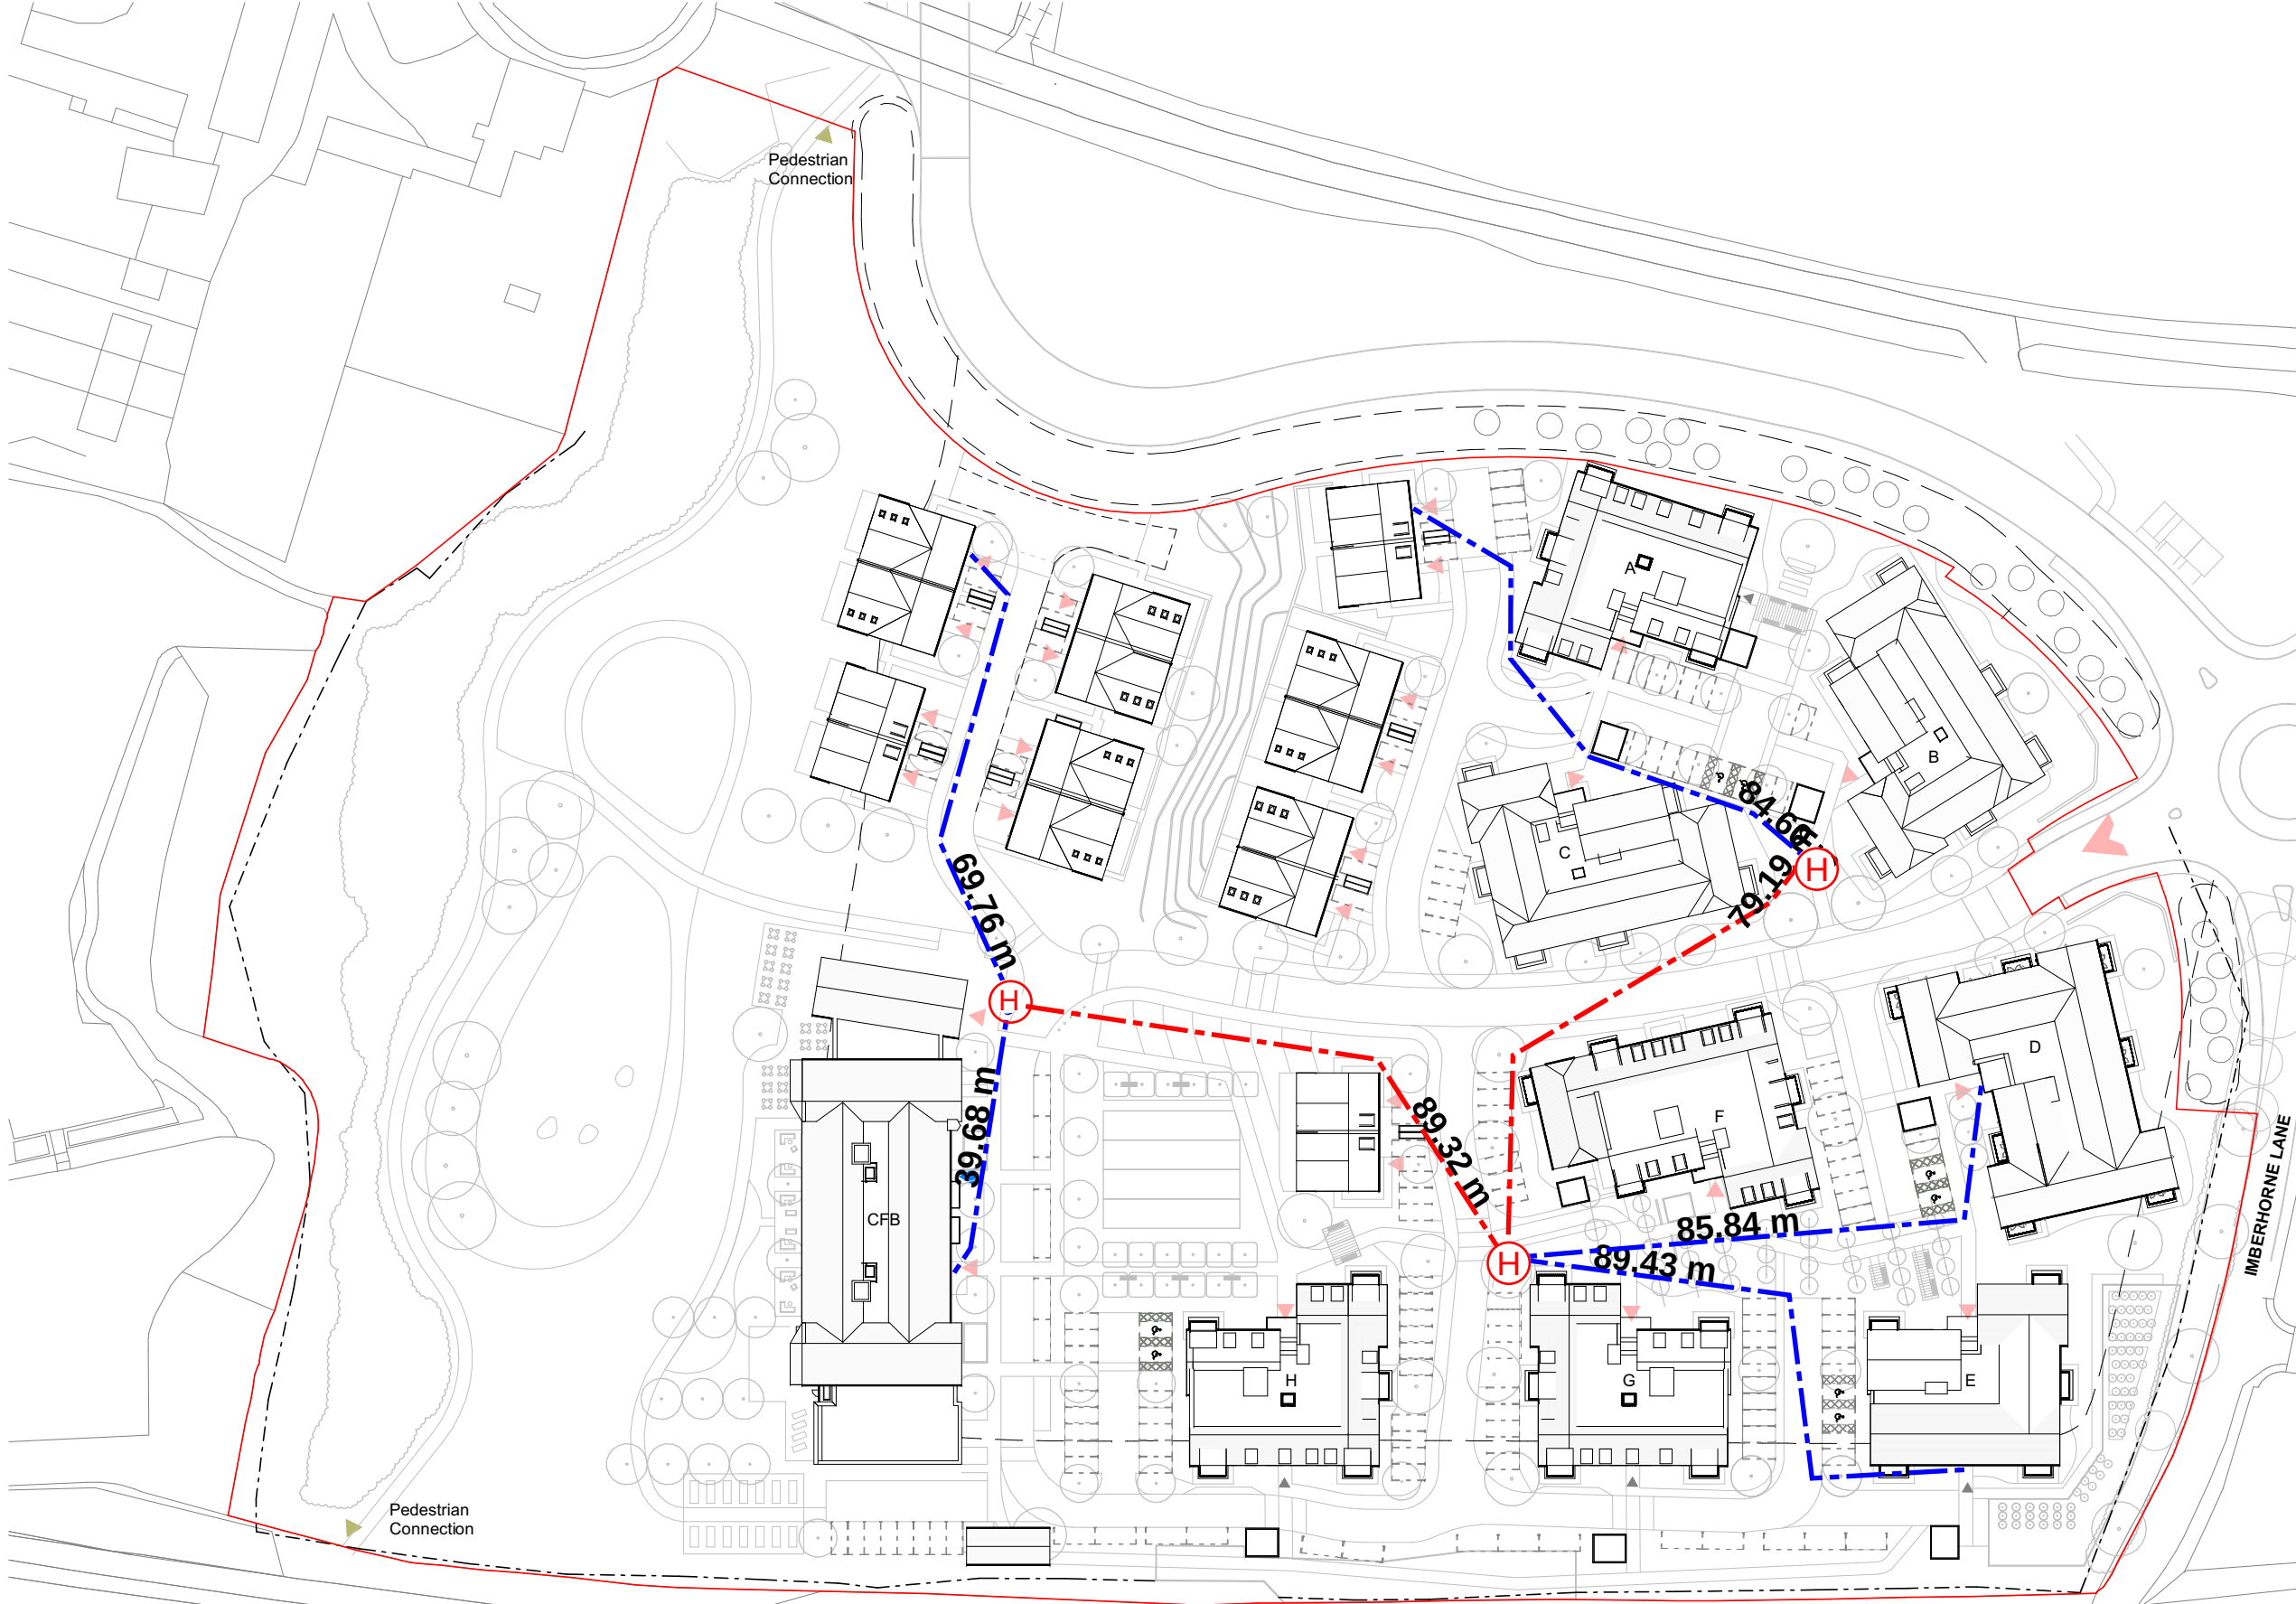

- Key
- Site Boundary
 - Site Vehicular Entrance
 - Pedestrian Connection
 - Development Zone Parameter Boundary
 - Existing Fence Line
 - Building Entrance
 - Secondary Building Entrance
 - Service Entrance

- CFB - 2 Storey
- Block A - 2.5 Storey
- Block B - 2 Storey
- Block C - 2 Storey
- Block D - 2 Storey
- Block E - 2 Storey
- Block F - 2.5 Storey
- Block G - 2.5 Storey
- Block H - 2.5 Storey

Client	Rangeford Villages
Project	Kingscote Place
Address	Imberhorne Lane, East Grinstead
DWG Name	Proposed FH Mark Up
Date	03-08-2026
Revision	02
Issue	01
Scale	1:1000
Produced by	SR



0m 20m 40m 60m

CDM REGULATIONS 2015. All current drawings and specifications for the project must be read in conjunction with the Designer's Hazard and Environment Assessment Record. All intellectual property rights reserved.

Designed with reference to the surveys, information and reports listed: 3.2.4 16186-100-AA_Y-RevC produced by Maltby Land Surveys LTD ,

Rev	Date	Description
P14	16.07.20	Updated Blocks as per Design Freeze
P15	31.07.20	Bin stores and substation updated

Dwn	Ckd	Drawn	RB
BF	SA	Checked	SA
RB	SA	Date	Sept' 25
		Scale @ A3	1 : 1000

Kingscote Place, East Grinstead

Indicative Site Layout

Project	Origin	Function	Space	Form	Discipline	Number
KCP-	PRP - ZZ -	XX - DR - A -	1010			
Revision	Status					
P15 -	Preliminary -					

PRP