




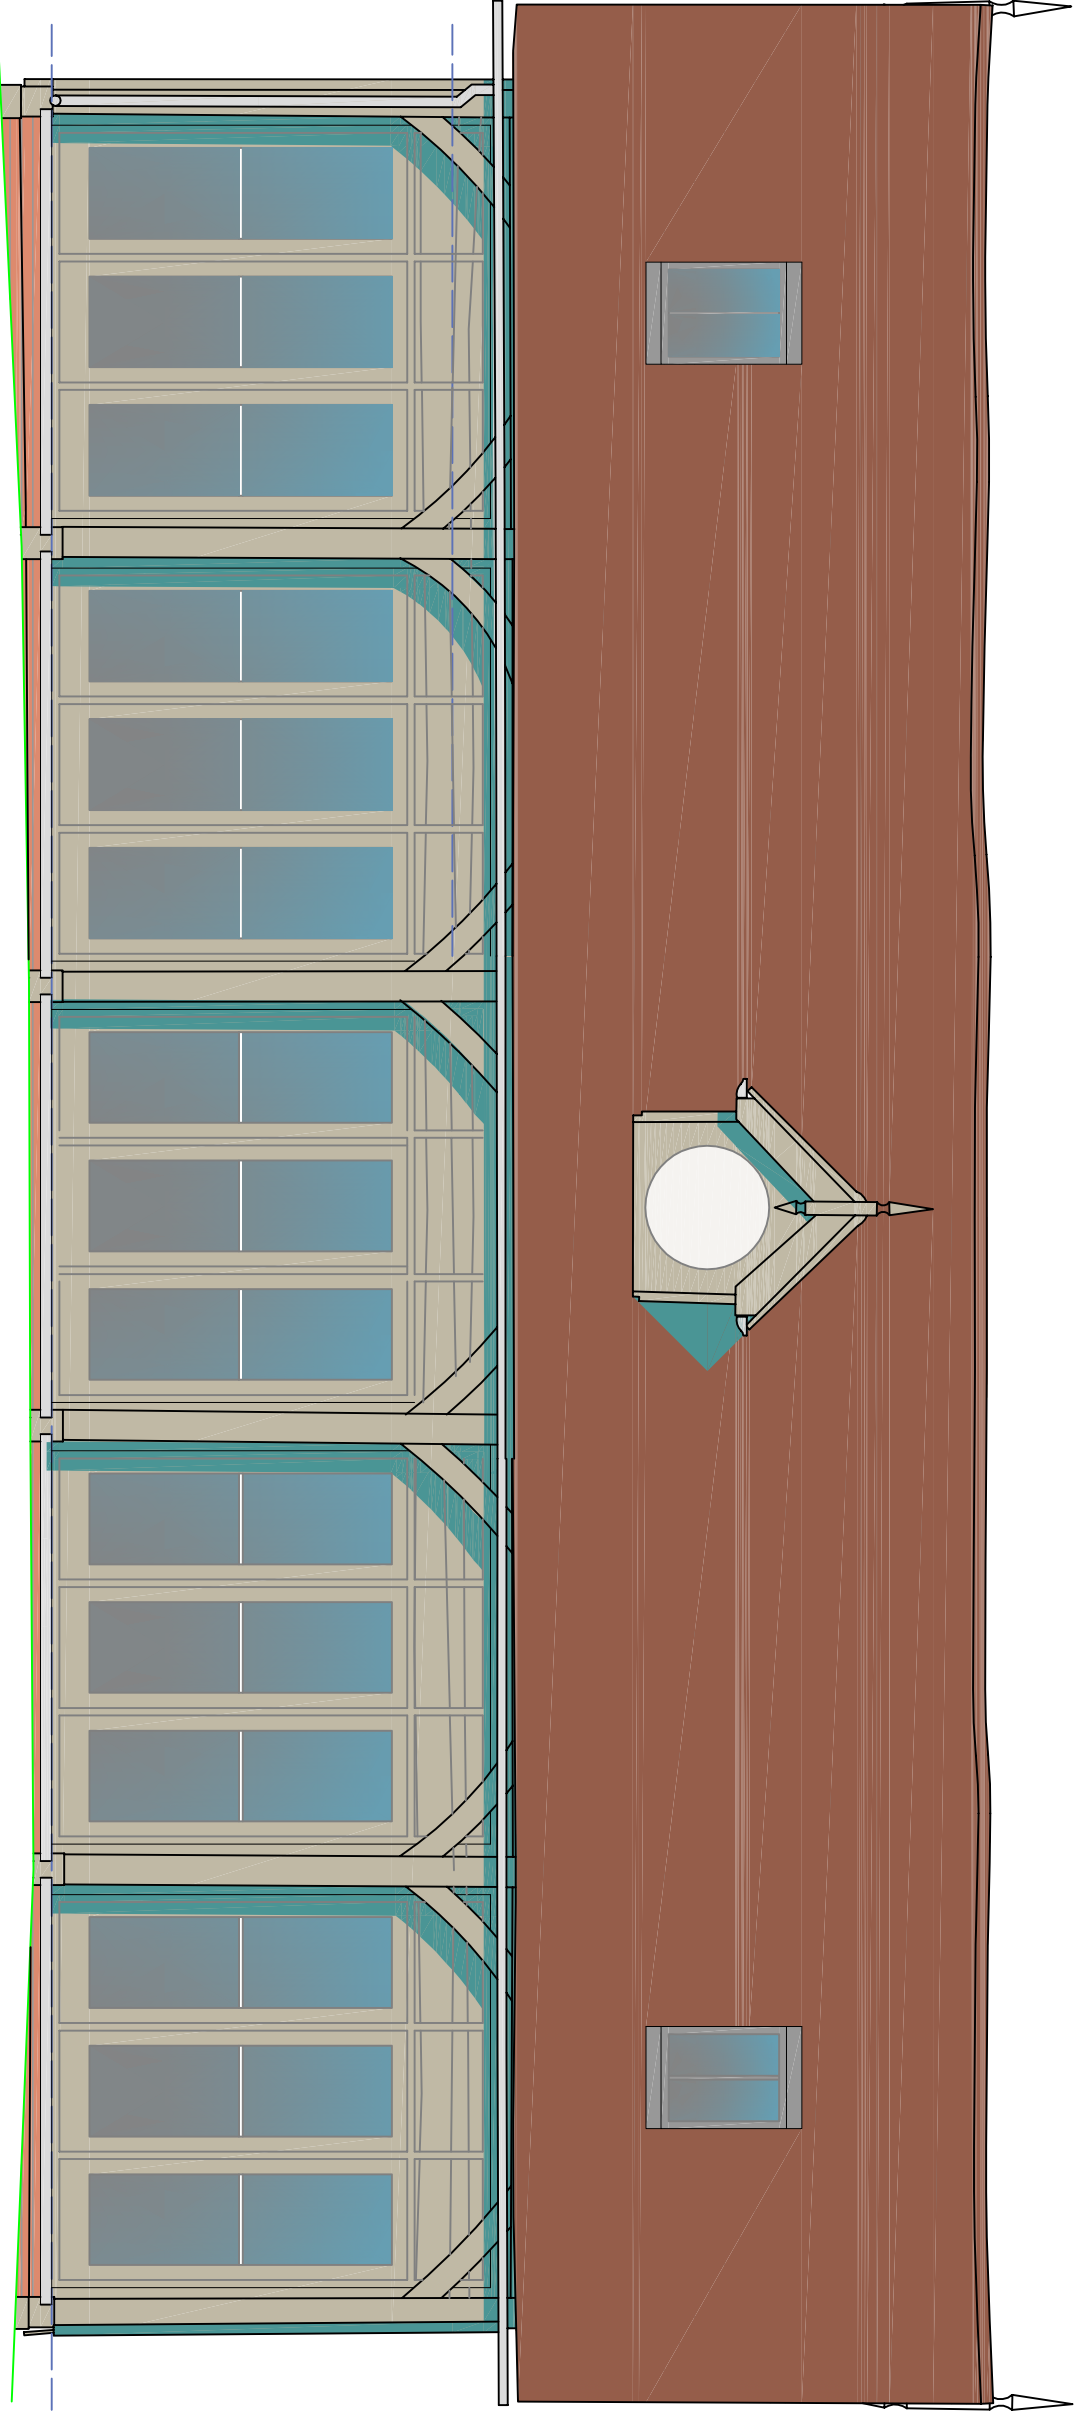


Existing / As built Eastern elevation Scale 1:50 @A1

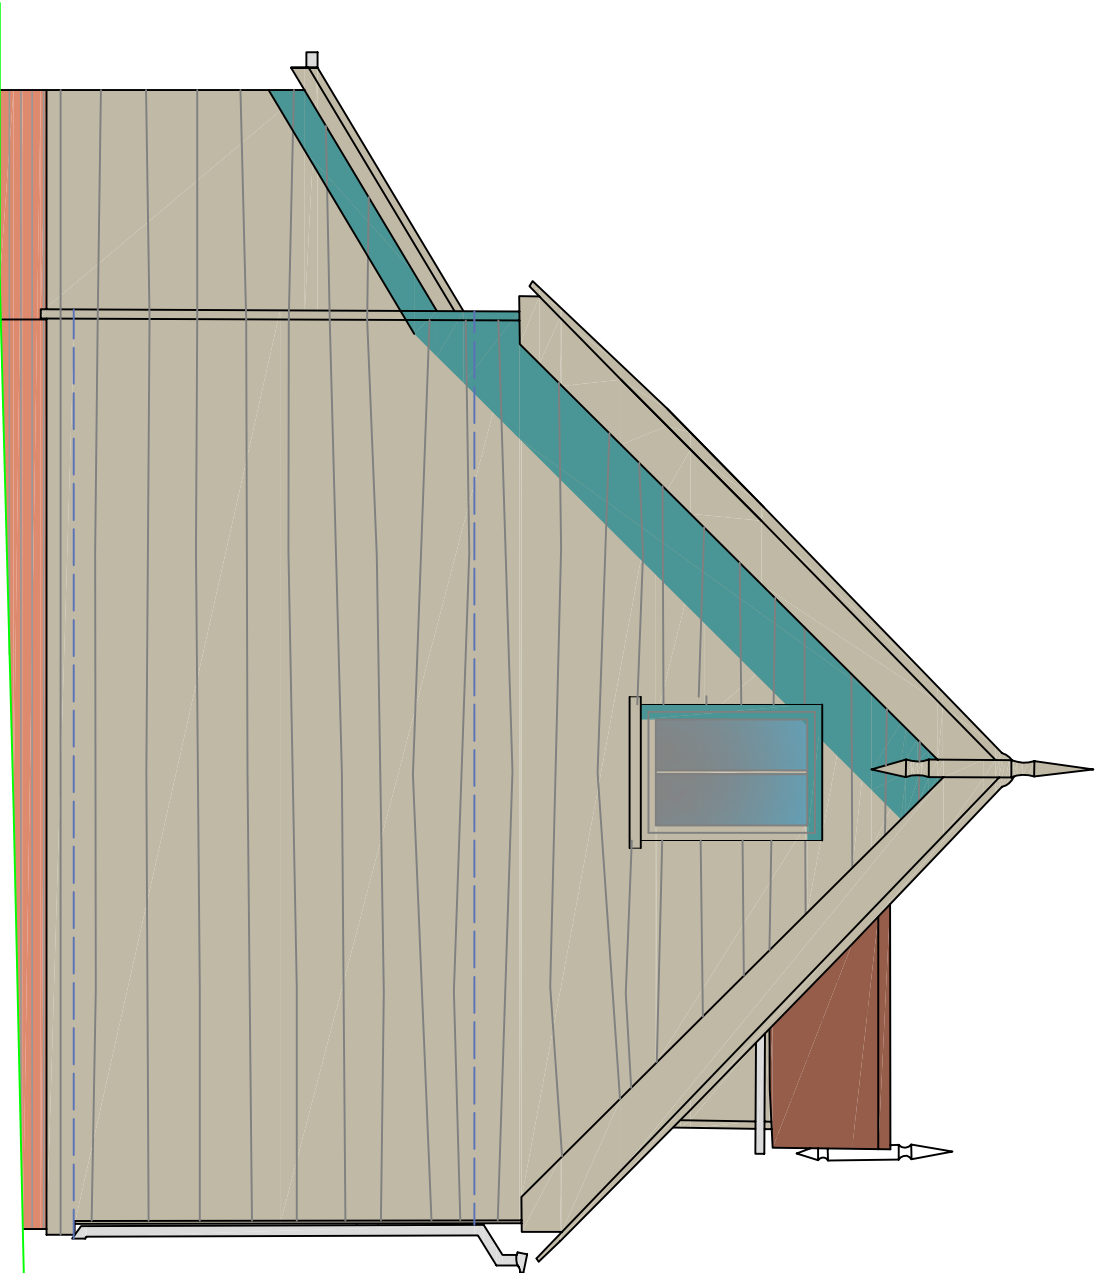


Existing / As built Southern elevation Scale 1:50 @A1

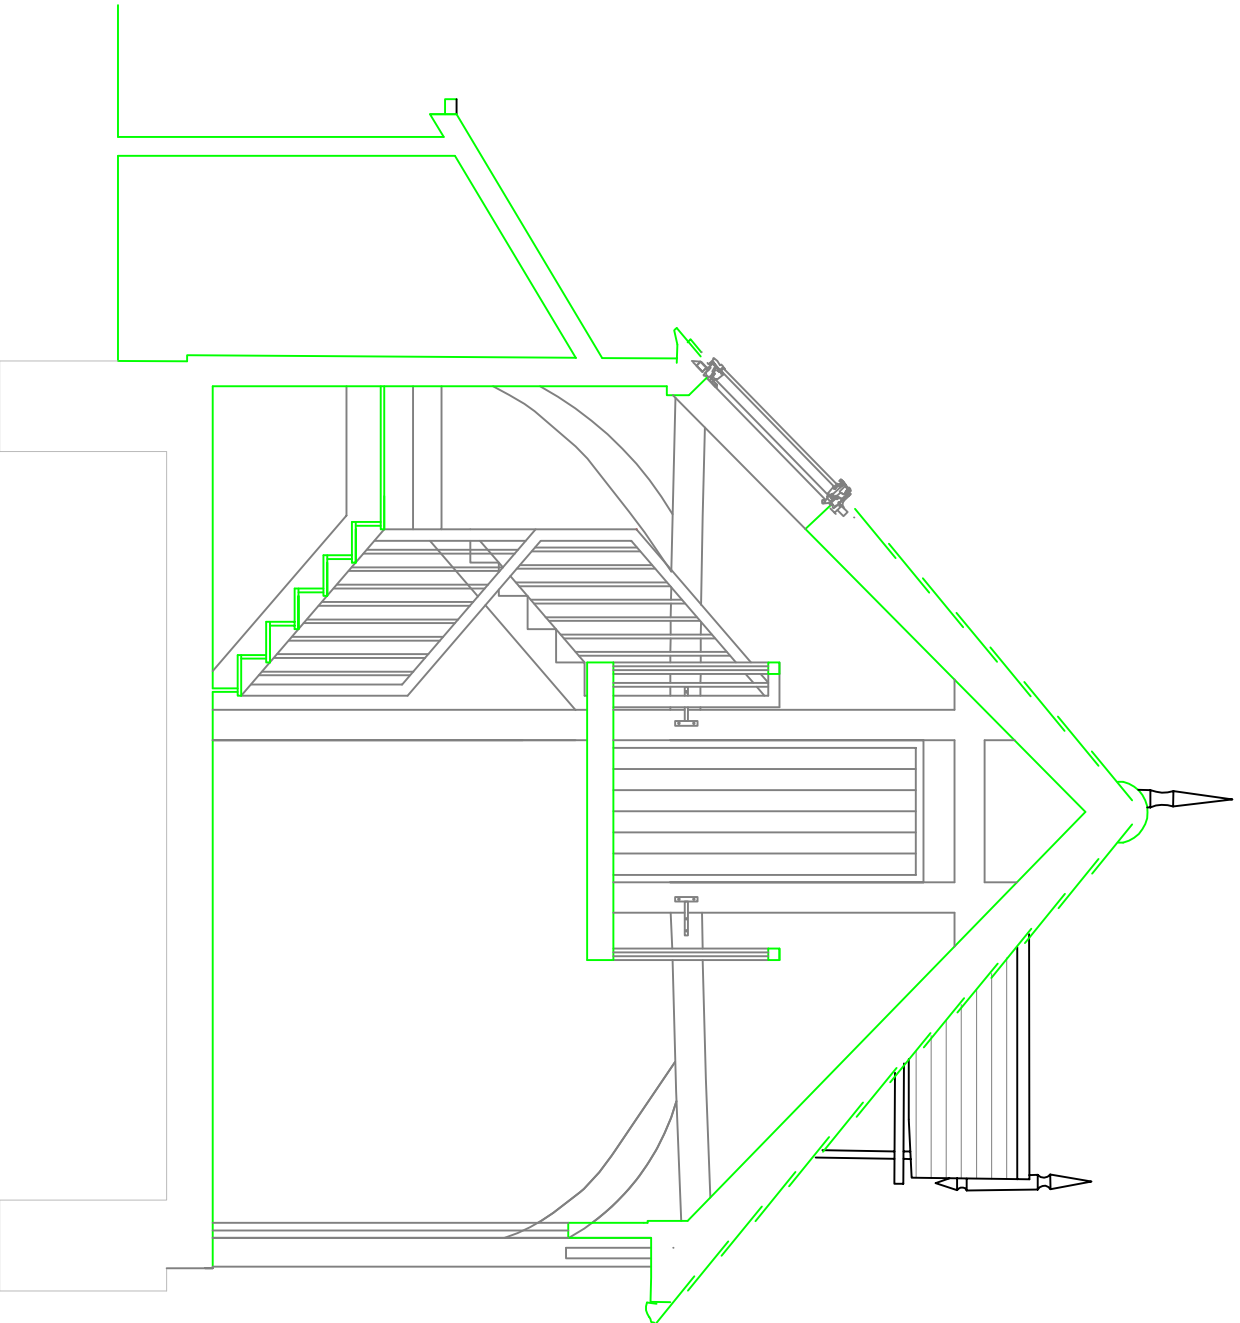

Existing / As built Section AA Scale 1:50 @A1

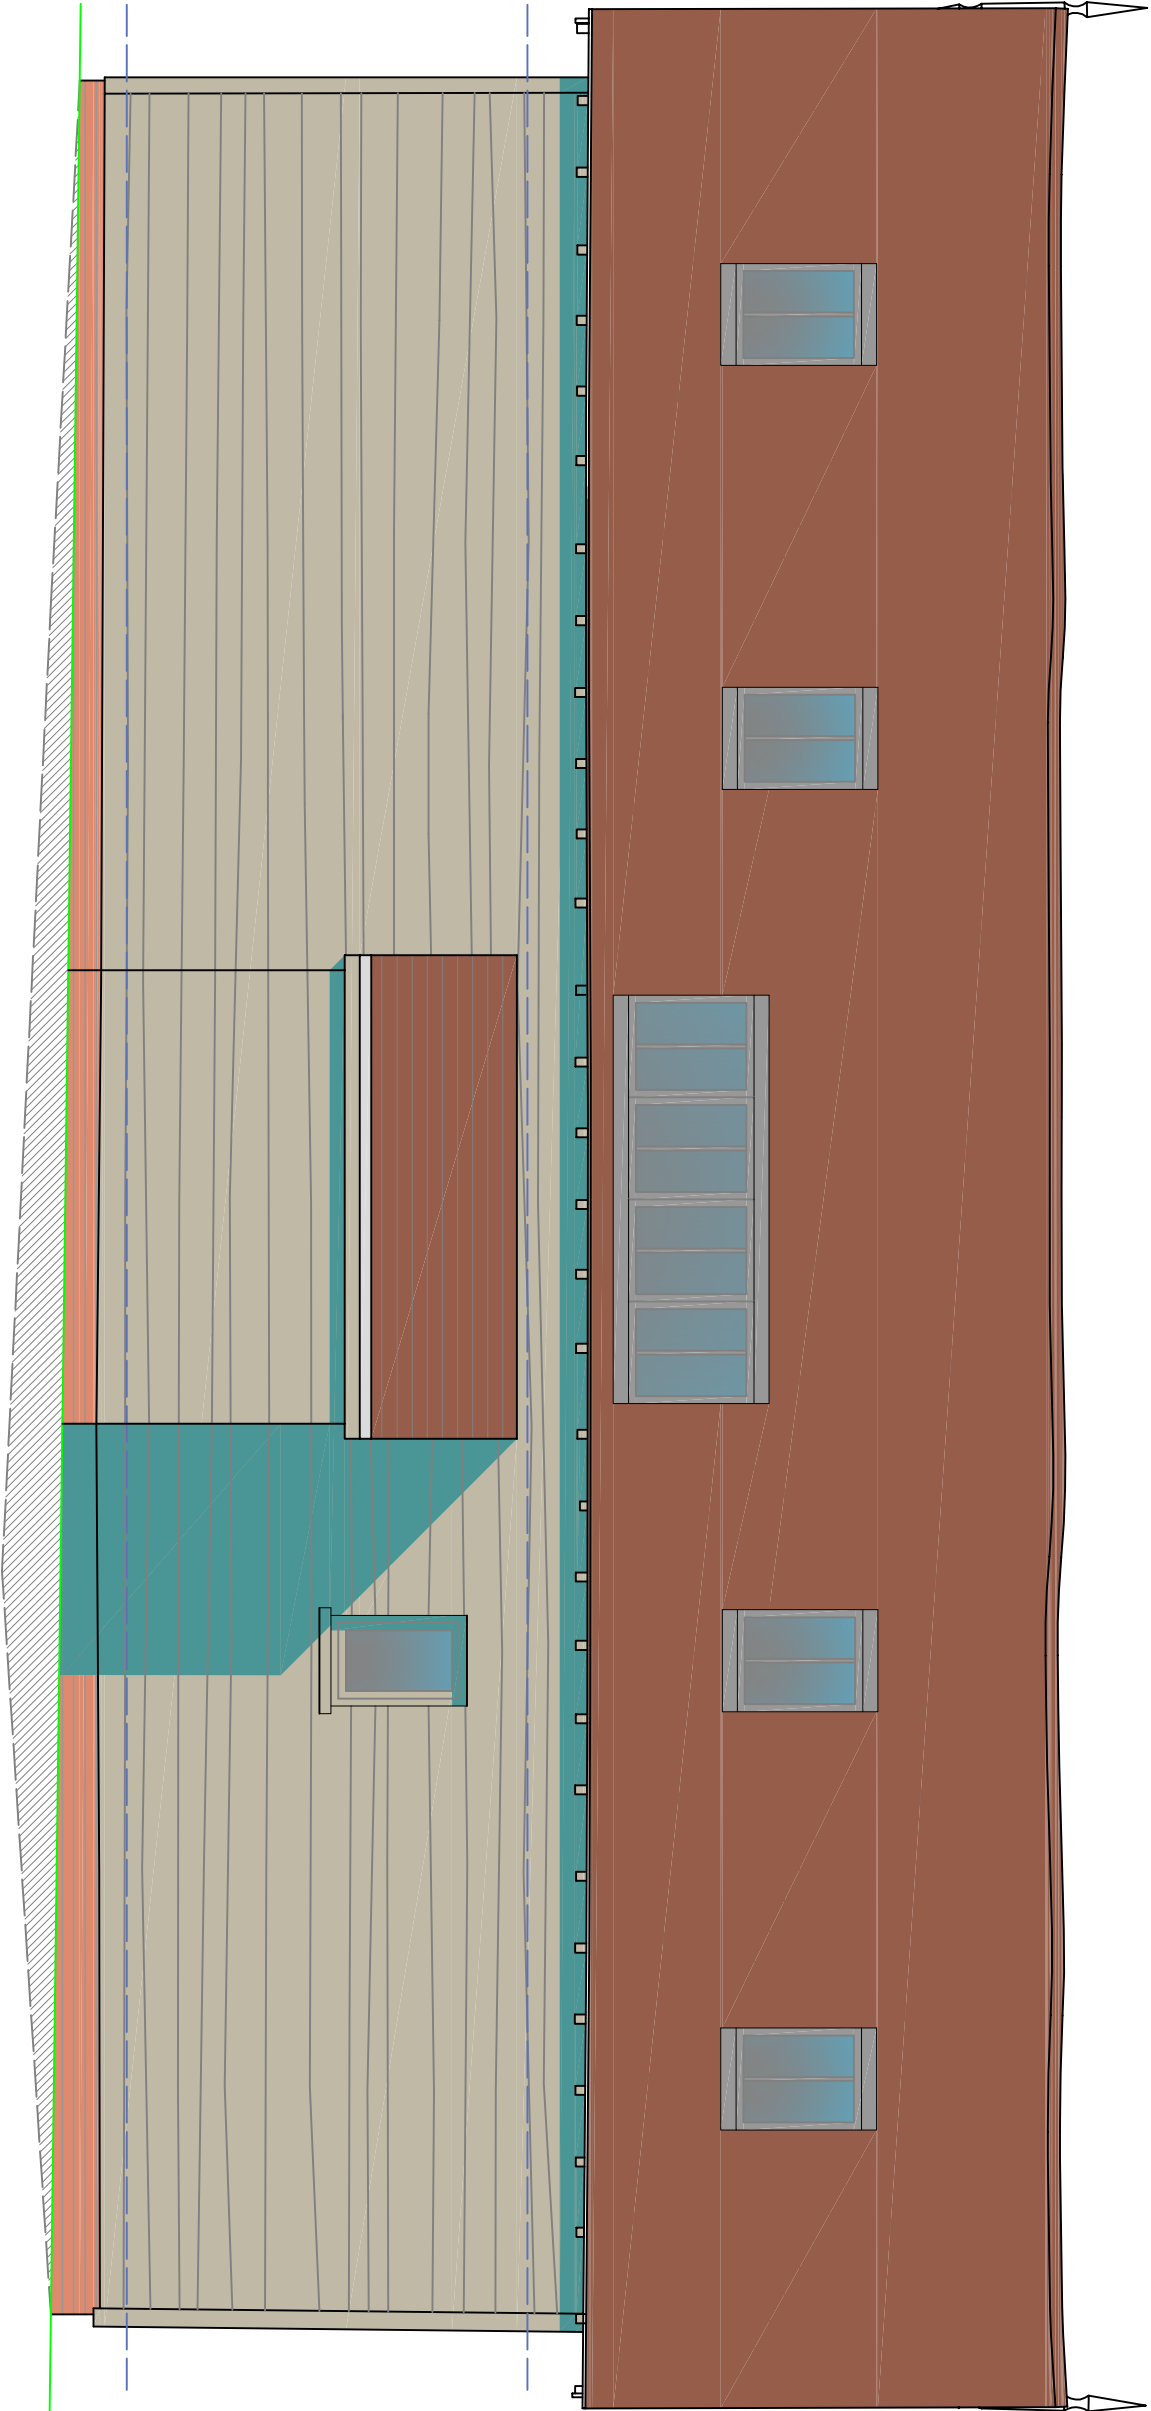


Existing / As built Western elevation Scale 1:50 @A1

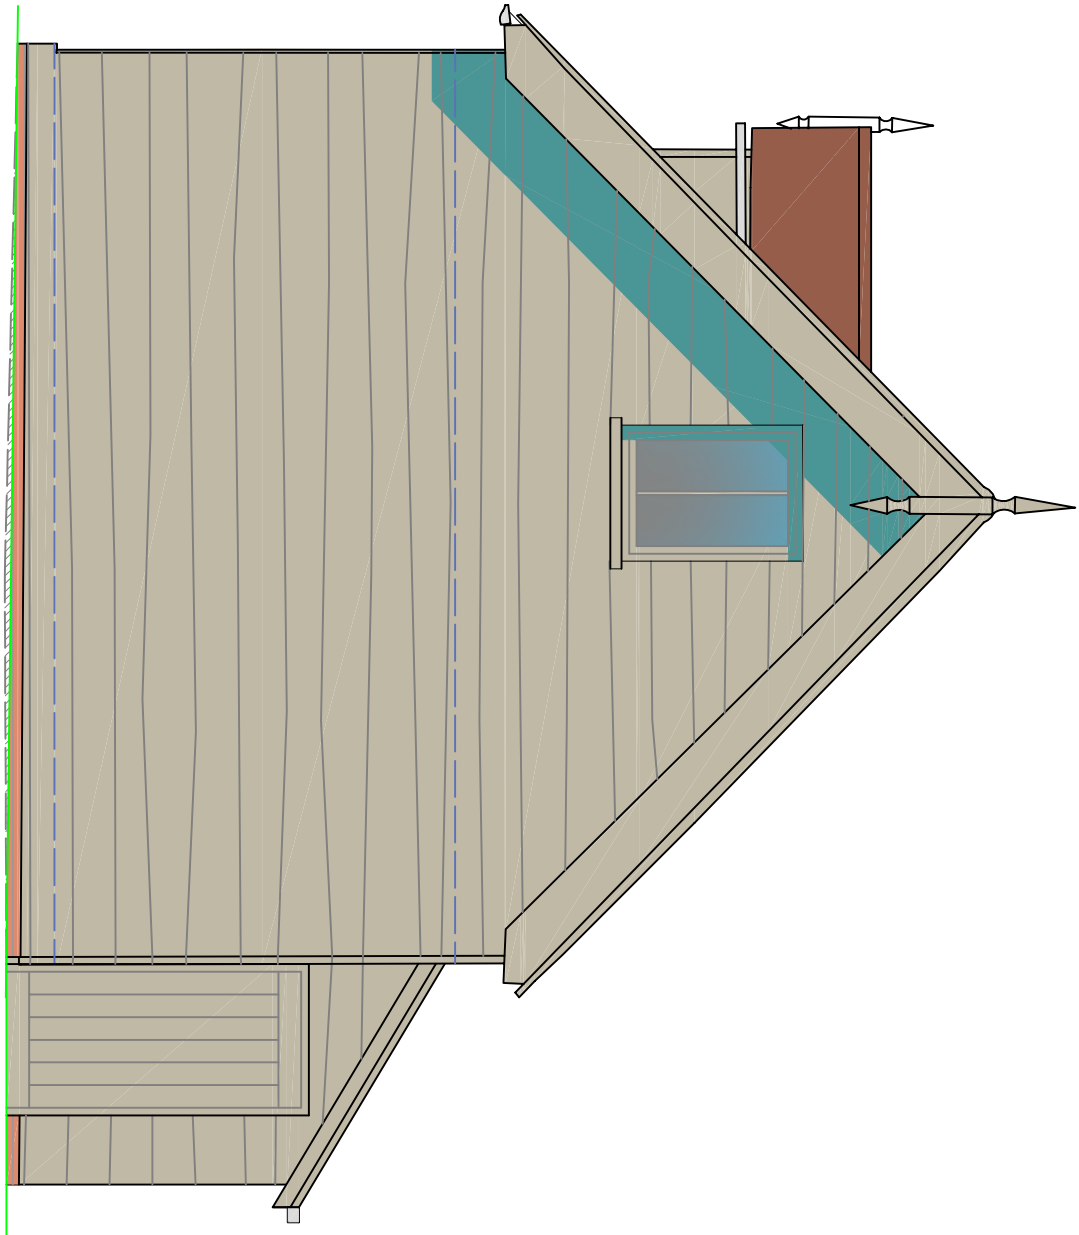

Existing / As built Northern elevation Scale 1:50 @A1



Existing Location Plan Scale 1:1250 @A1

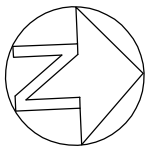

No dimensions to be scaled from this drawing. All dimensions to be checked on site, and notes completed by competent and qualified persons only. This drawing is copyright and should not be reproduced without the permission of the designers.

Fergus Carr, RIBA  
ARB Reg No. 069563F  
07699995111  
ferguscarr@gmail.com

Carr Architecture  
Partners: Fergus Carr, RIBA  
Seamus, 100 St. John's Road,  
Scarborough, YO15 1JH

A 180725 Boundary lines amended, sliding doors and plant room shown

Client: Mr & Mrs Penver Project: Barn extension, Providence Farm, Warrington

Drawing: Existing / as-built elevations, sections & Plan Scale: 1:50 & 1:250@A1 Date: Nov 2024

FRFC\_Wrrigd\_04\_BR\_EX\_02\_A