


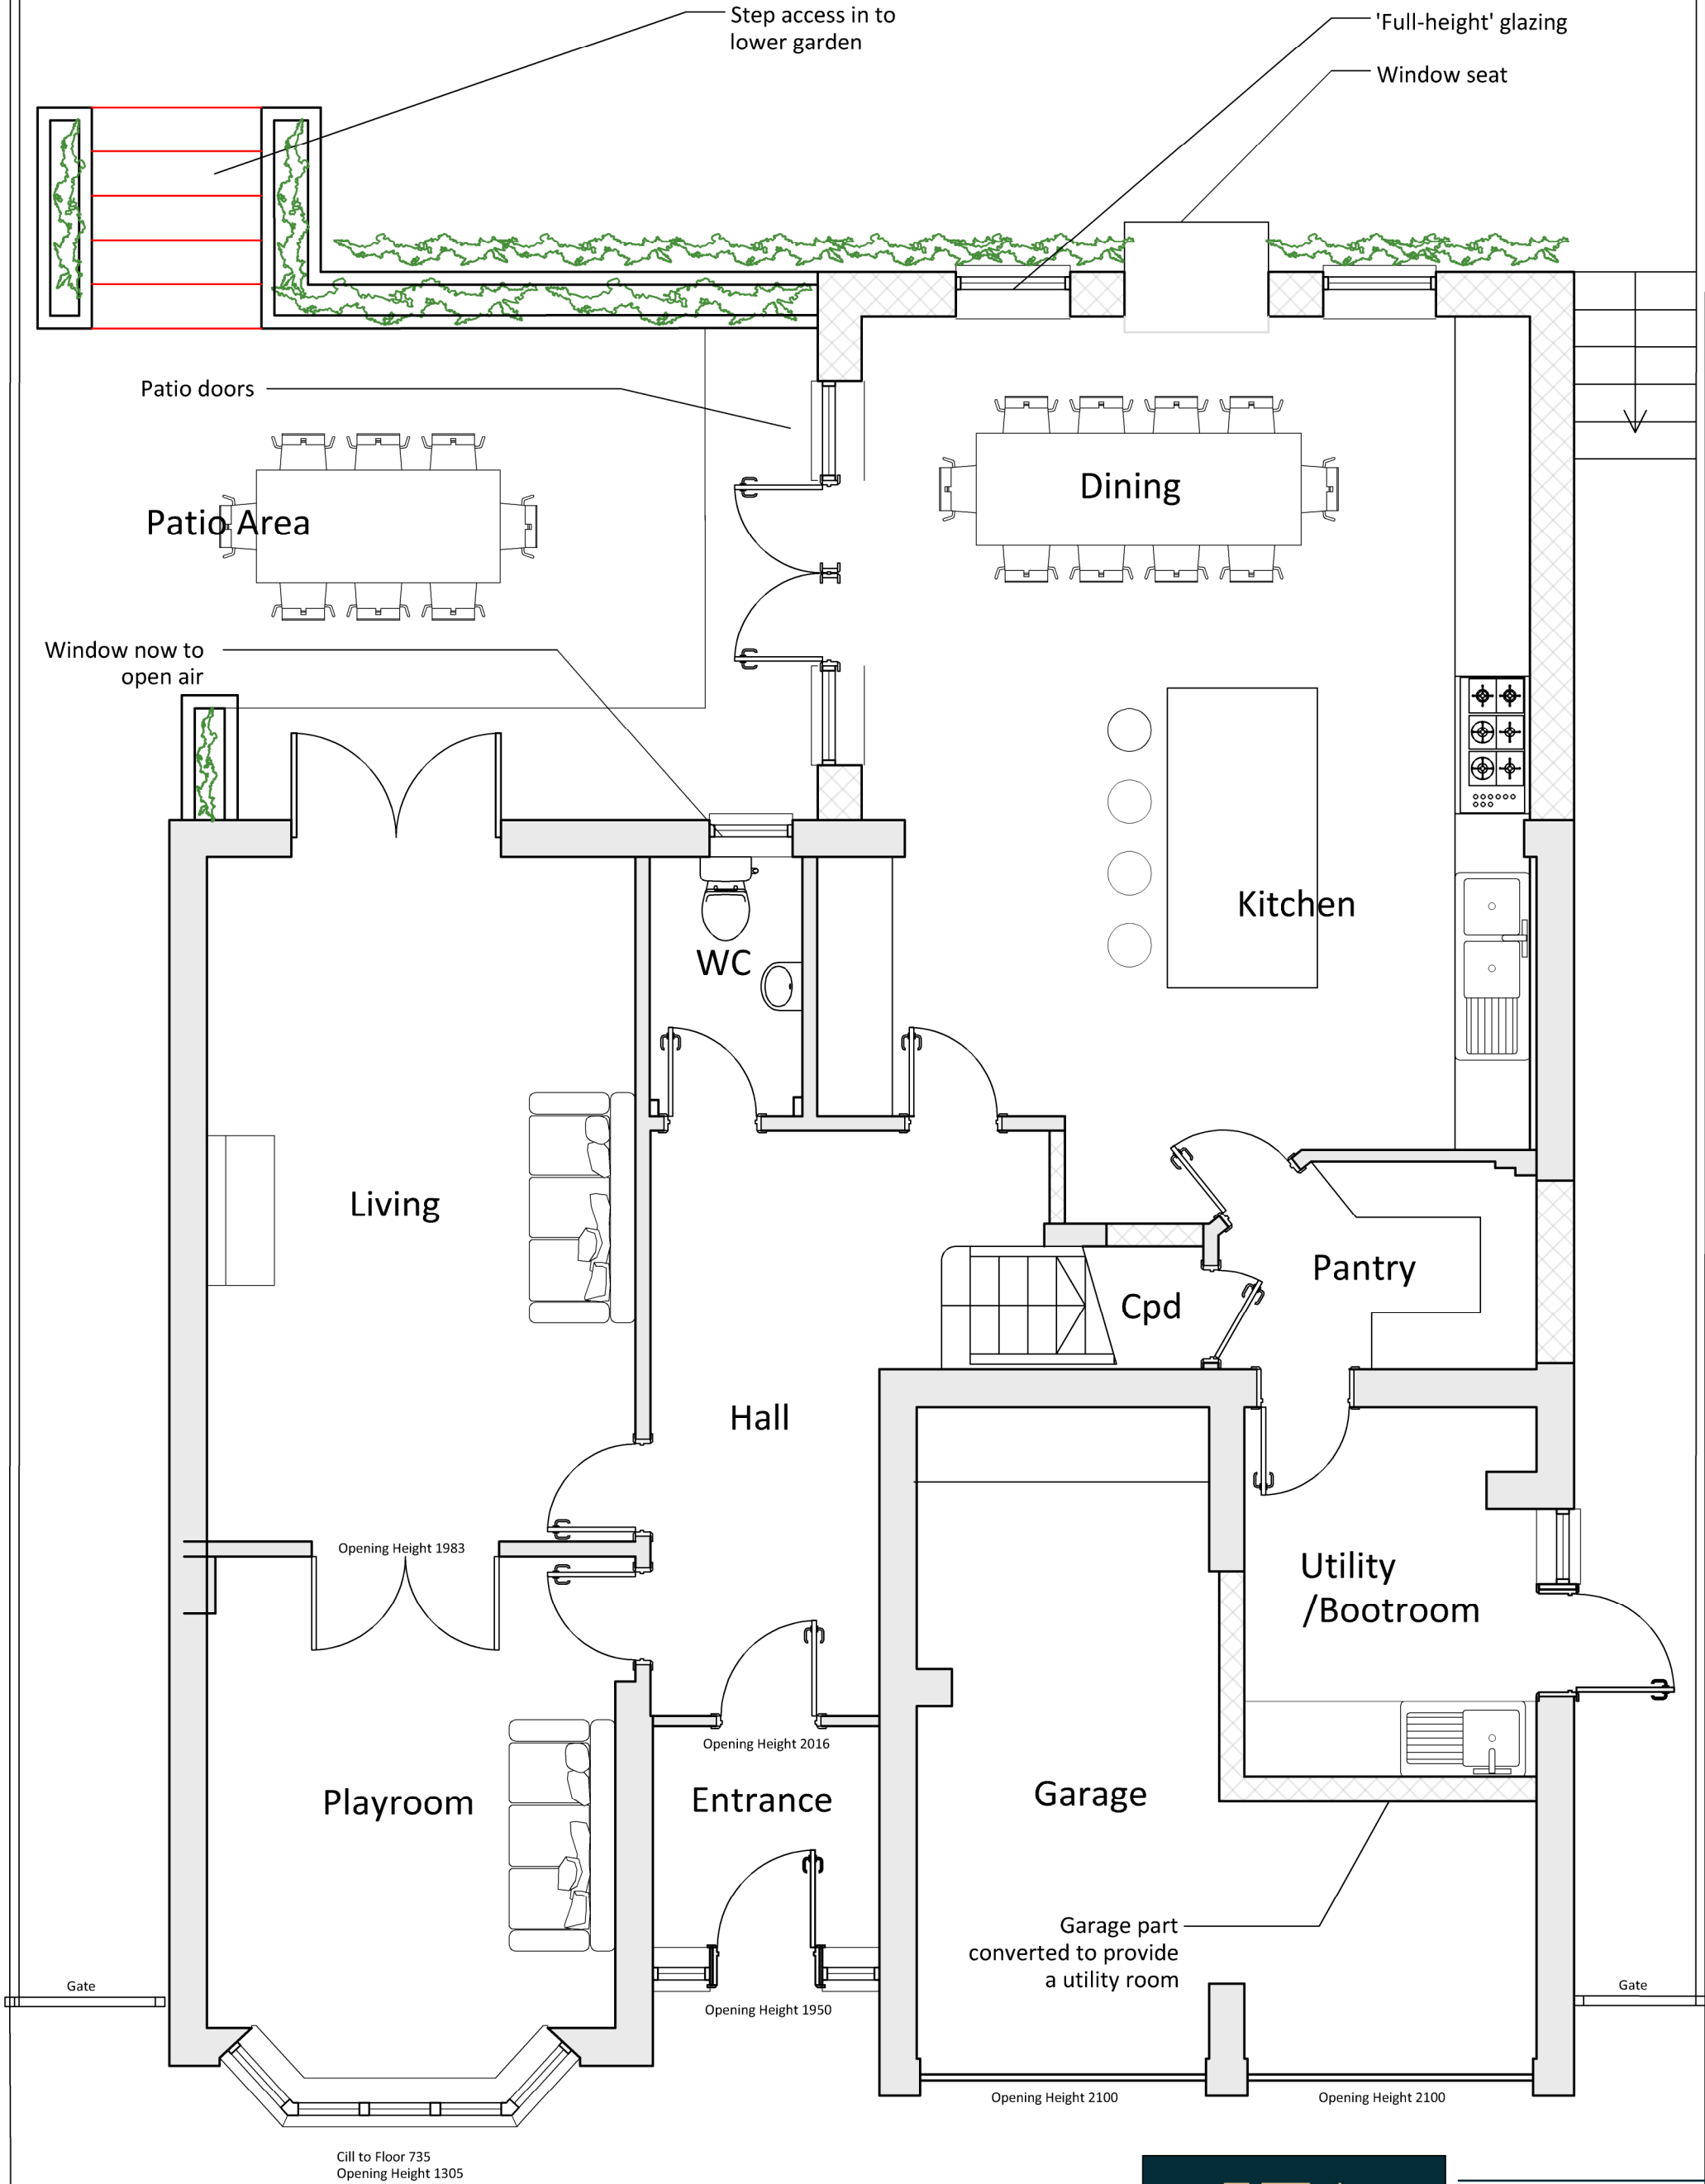

0m 1m 2m 3m 4m 5m



C	10.09.26	Drawing As Per 'As-Built'
JT		
B	12.02.25	Minor alterations to patio
A		
A	05.02.25	Planning Issue
A		
Rev	Date/By	Revision Note



Client
Mr and Mrs Dyer
Project
33 Willow Park
Haywards heath
RH16 3UA
Drawing
Proposed Ground Floor Plan

PLANNING

Drawing Number	Date
067-001-210 Rev C	February 2025
Scale	Paper Size
1:50	A3
Drawn JT	Checked JT

E-mail info@jtalimited.co.uk
Telephone 07956 870 019
Web www.jtalimited.co.uk
All dimensions to be verified on site.
Unauthorized reproduction of information herein is strictly forbidden. Copyright 2022
Jonathan Talley Architects Limited is the trading name of Jonathan Talley Architects Limited, a limited company registered
in England and Wales with registered number 13707071 whose registered office is at 16 Corndon Avenue, Haywards
Heath, RH16 3UP