



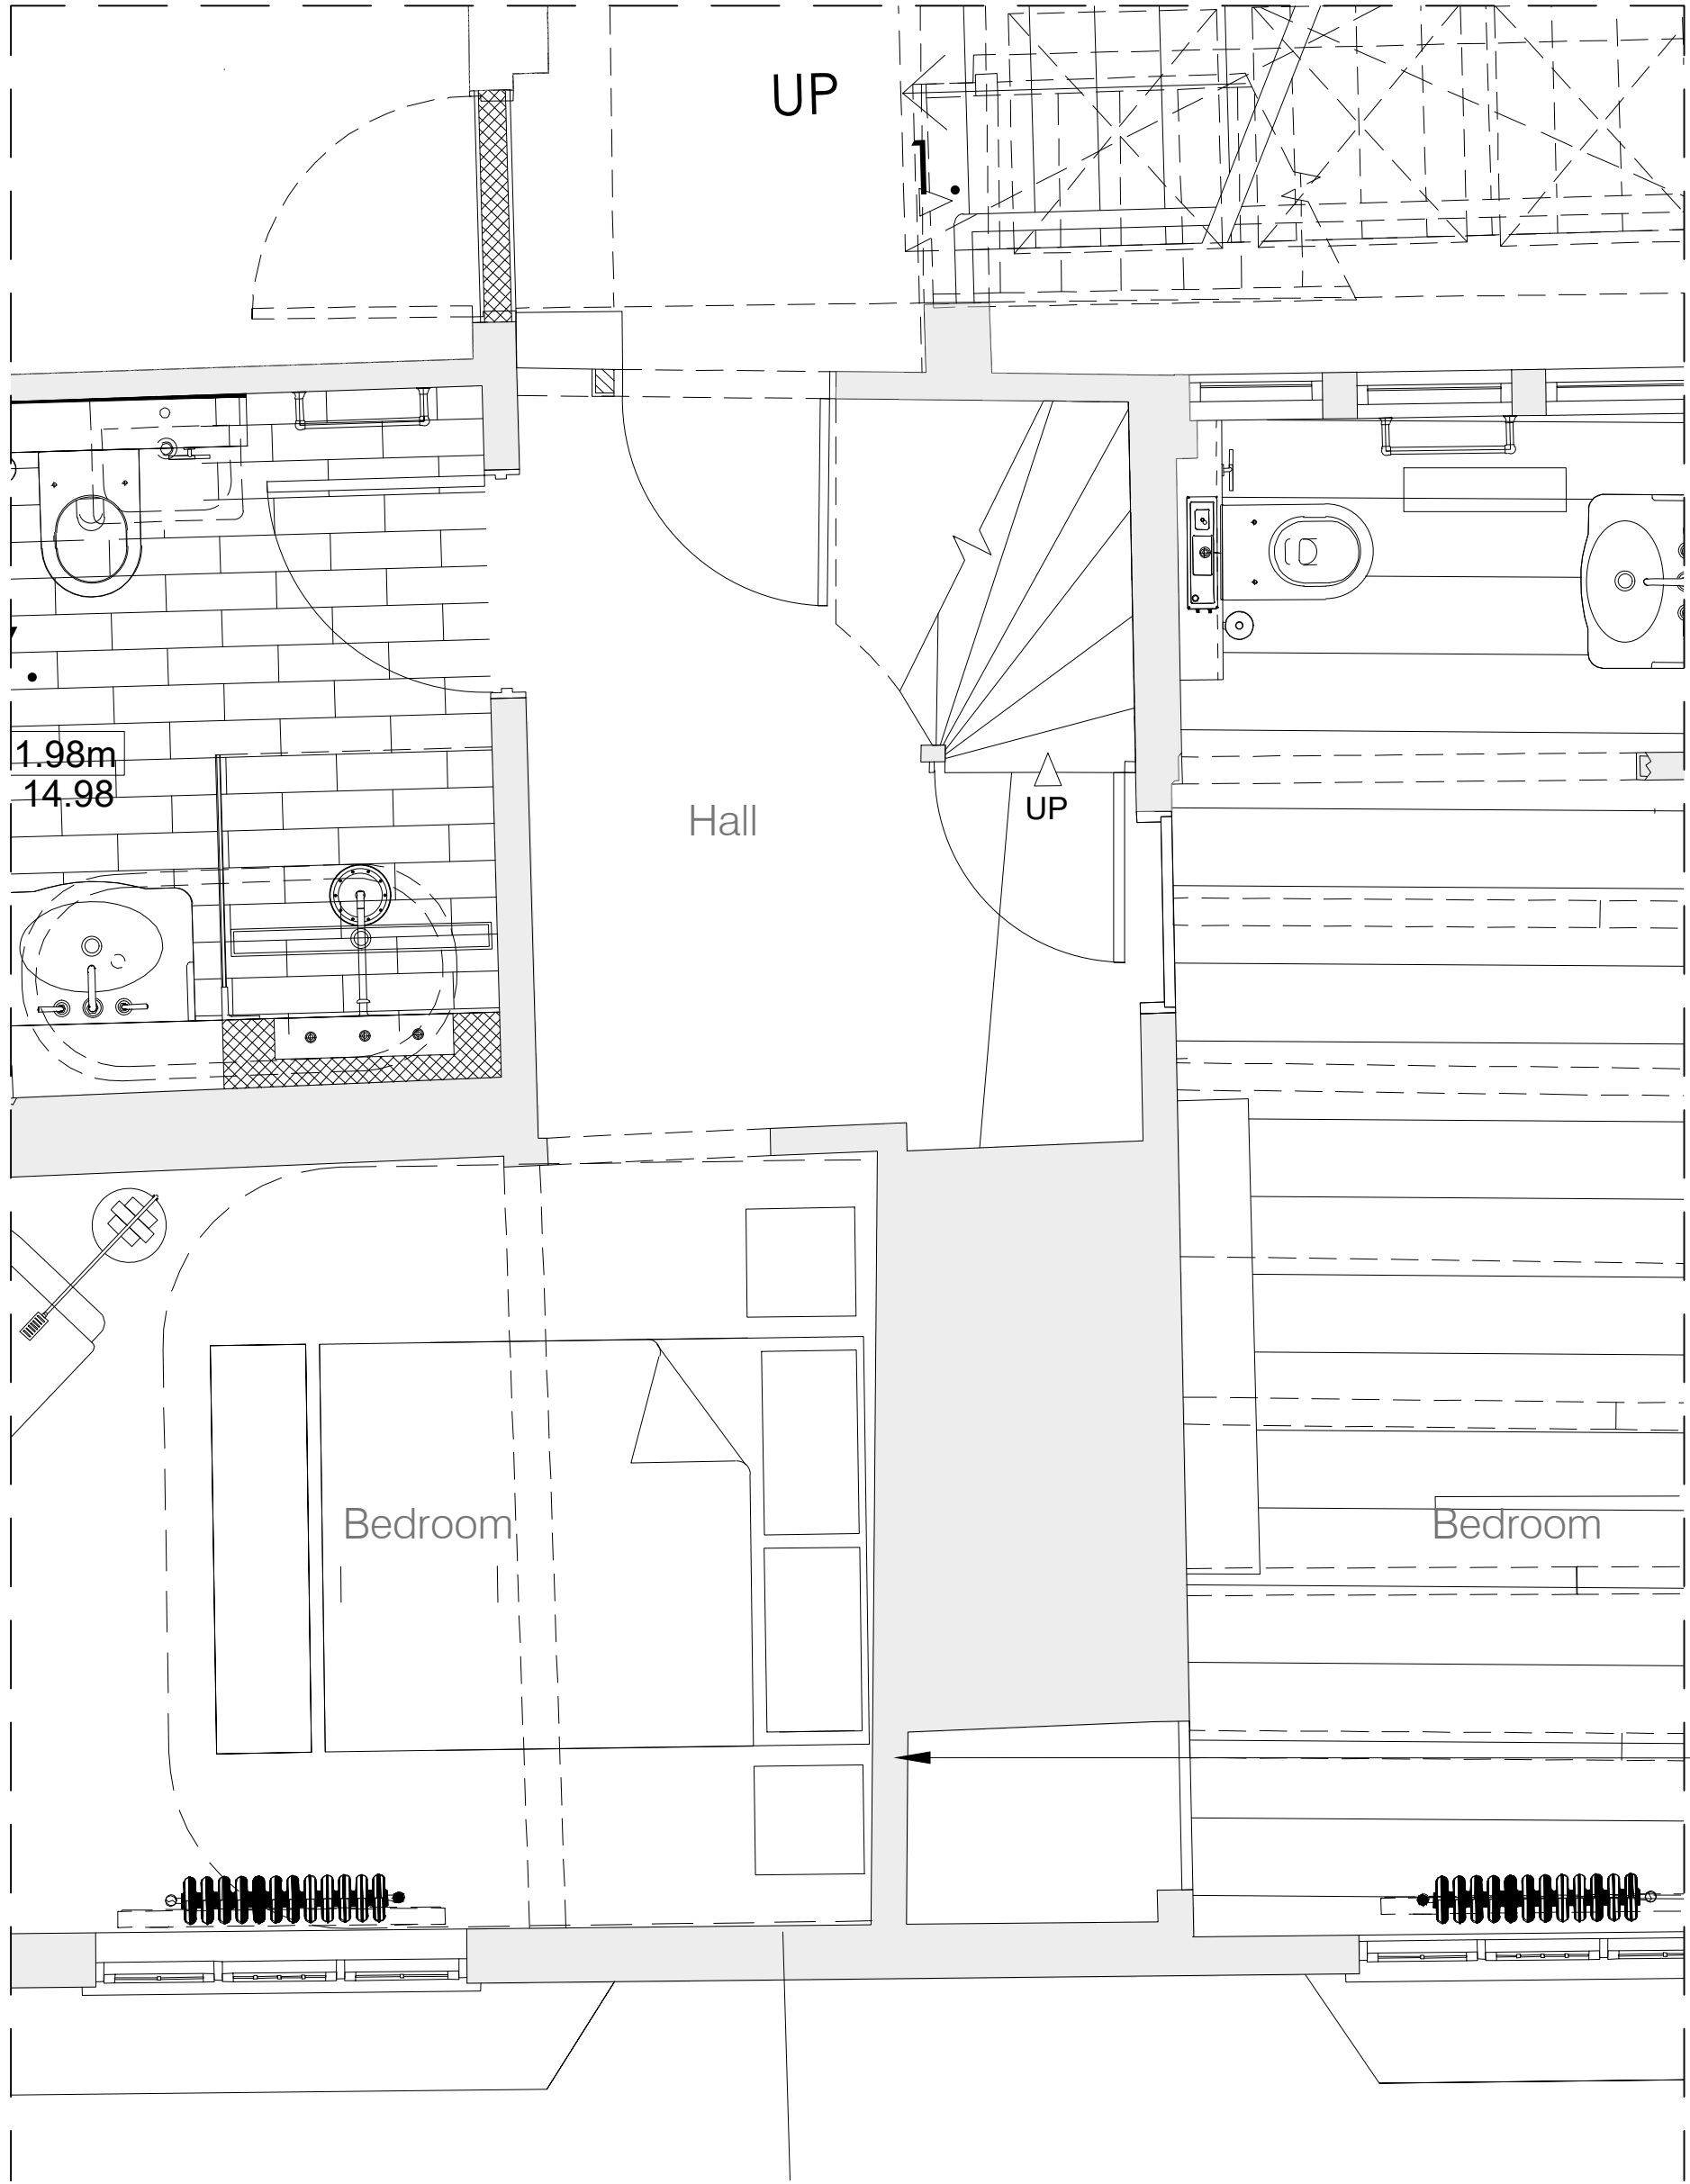

Approved Scheme First Floor Plan
Scale 1:25@A1
1:50@A3

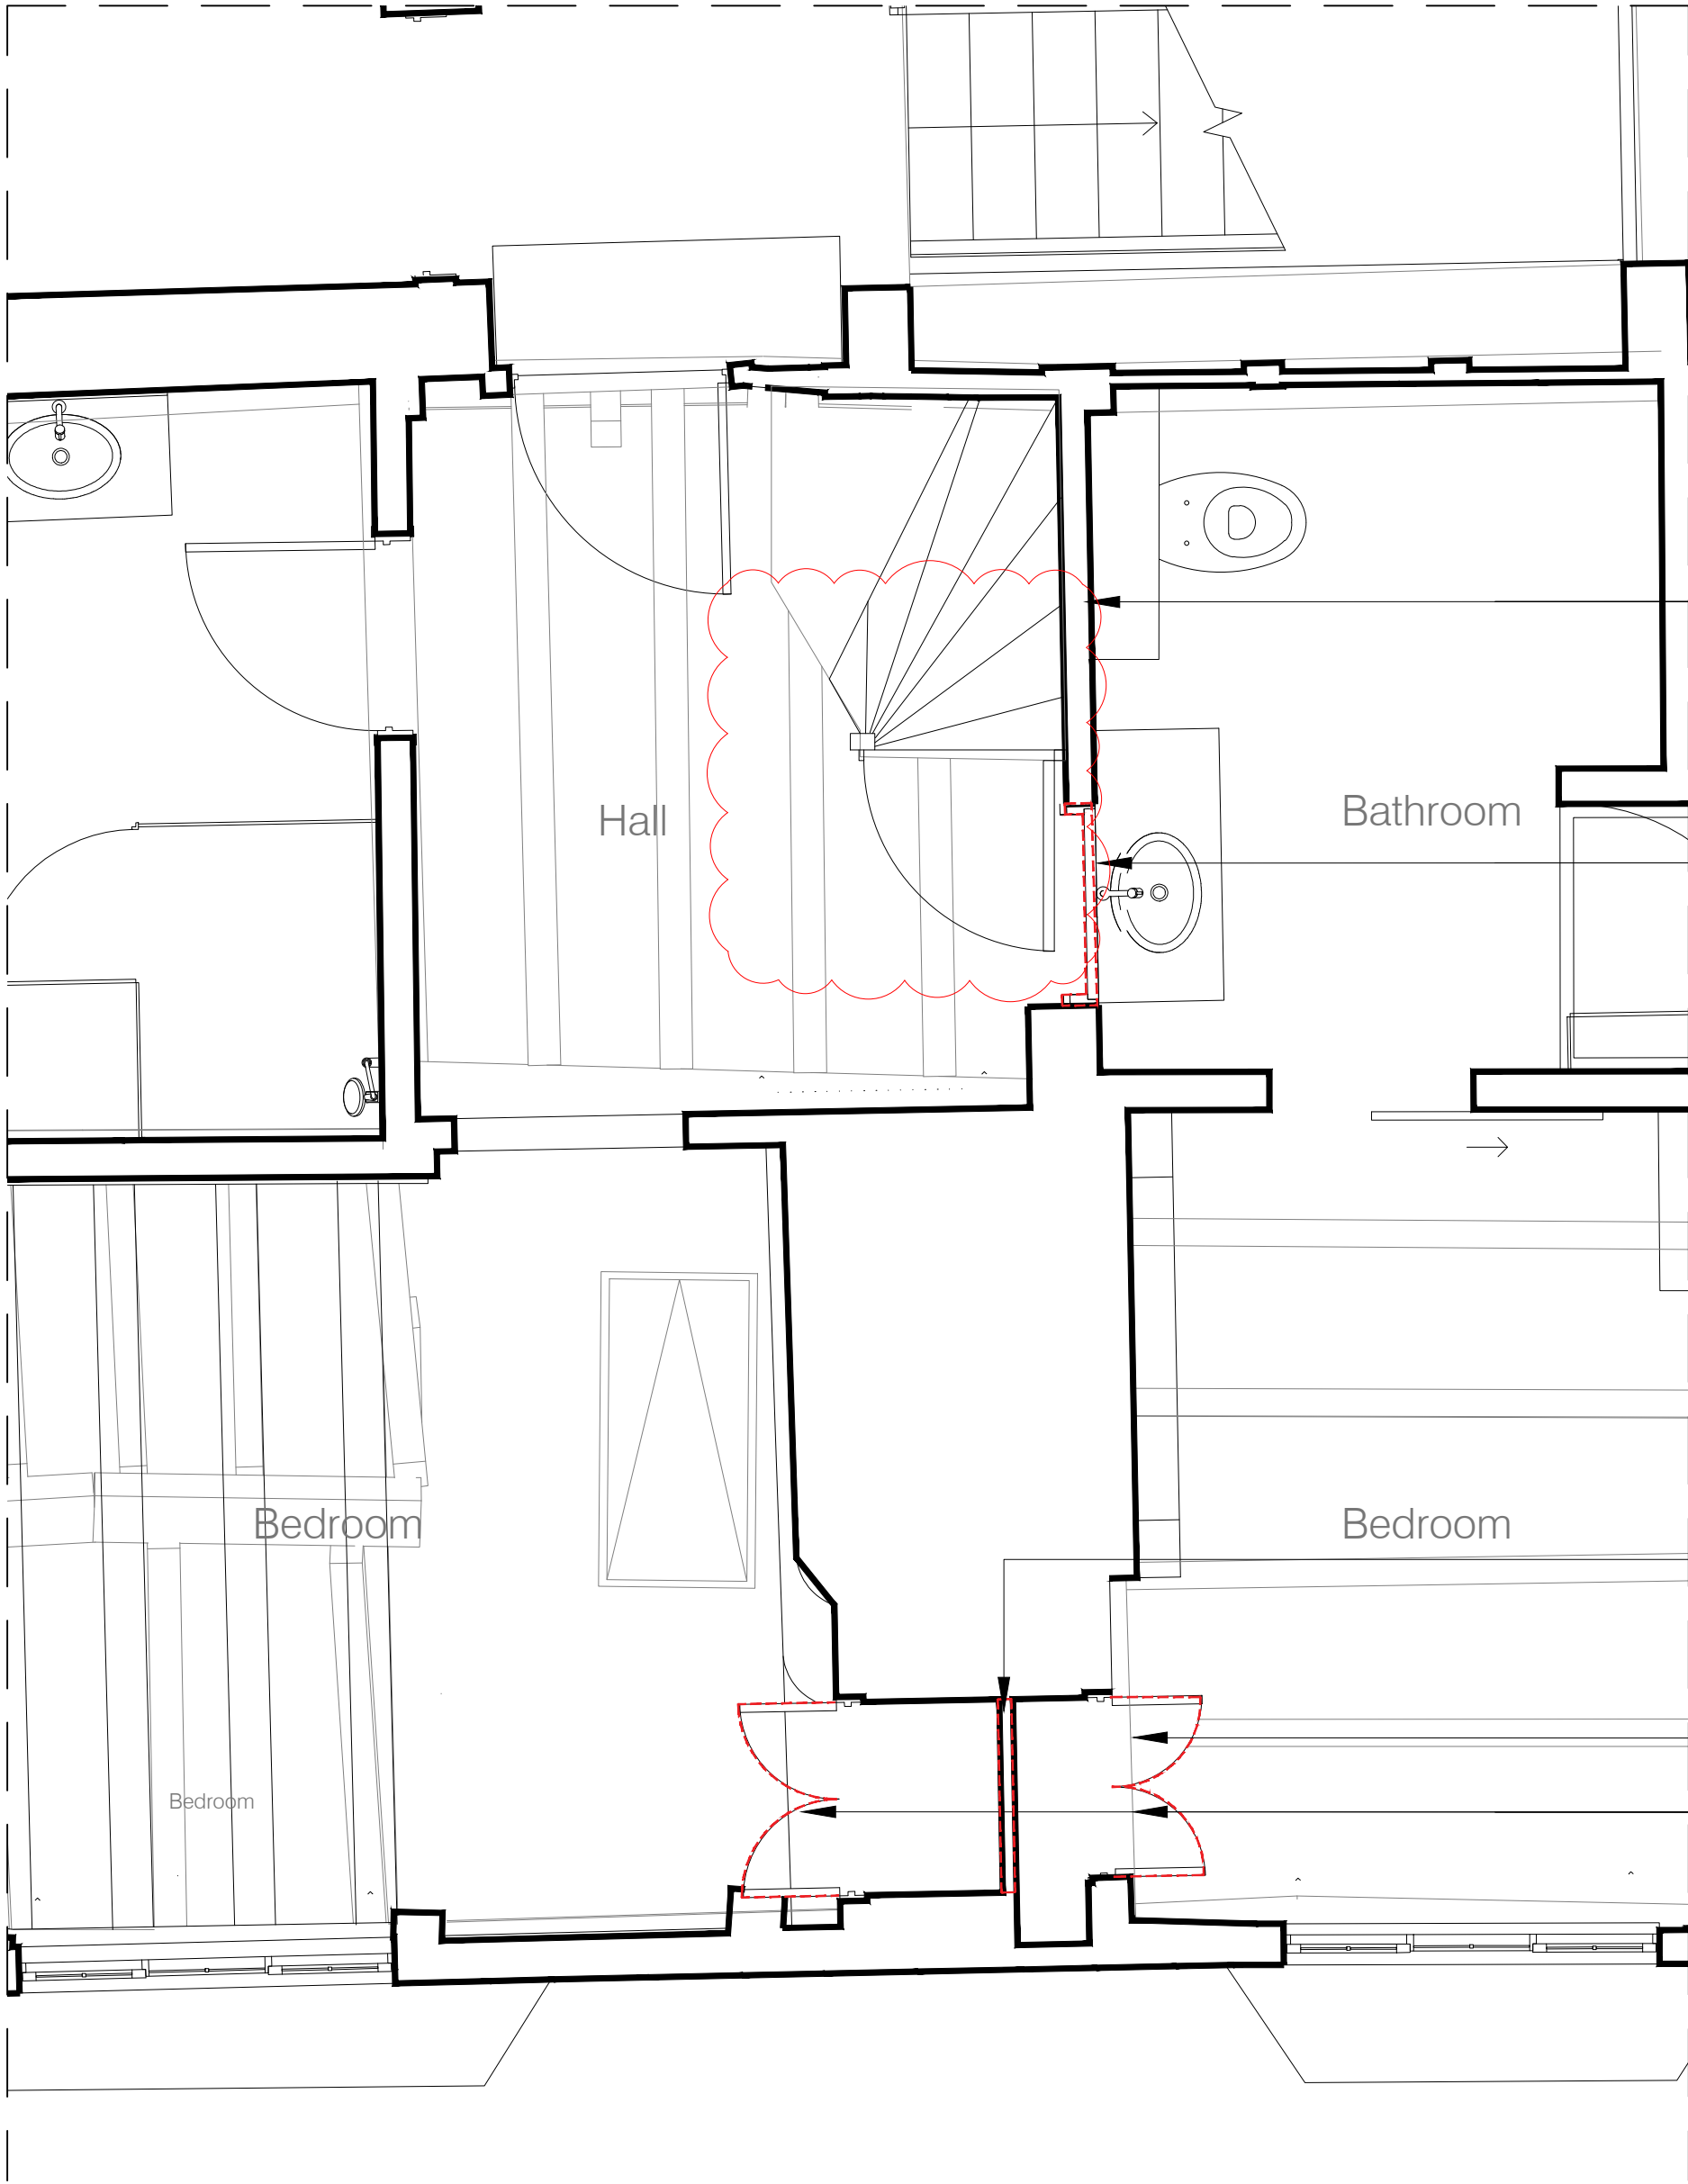

Proposed Scheme First Floor Plan
Scale 1:25@A1
1:50@A3


Refer to drawing 5008

Opening in wall reinstated.
Existing door retained by the
Applicant to be reinstalled and
fixed shut to suit new en-suite
layout. Door to be exposed on
both sides.
Sink and vanity unit are
freestanding are removable.

Existing division reinstated

Existing door replaced

Fitted wardrobes joinery, 2no
18mm MDF back panels painted
off white

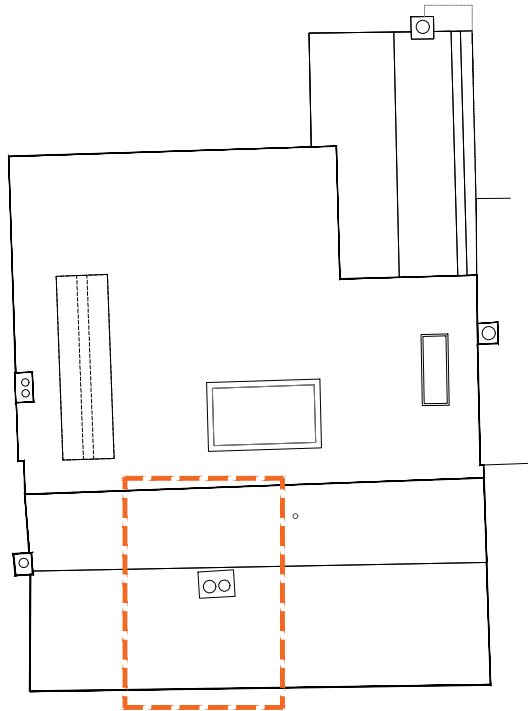

KEY PLAN
Scale 1:200@A1
1:400@A3



Fitted Wardrobe, view from North bedroom



Existing timber door to be
re-instated and fixed shut

KEY:
Highlighted difference between Approved
Scheme and 'As-Built'/Proposed Scheme

NOTE
DRAWINGS TO BE READ IN CONJUNCTION WITH SUBMITTED
DESIGN&ACCESS STATEMENT AND HERITAGE STATEMENT
MATERIALS INSTALLED IN ACCORDANCE WITH THOSE
OUTLINED IN CONDITION #9 OF APPROVAL DM/23/1605

Rev.	Comments:	By:	Date:
B	Amendments as clouded.	KN	Nov 25
C	First floor staircase access door reinstated	KN	Feb 25

LISTED BUILDING
CONSENT

Client:
Mr. Simon Dougall

Project Title:
107 High St, Lindfield, Haywards Heath, West Sussex, RH16 2HR

Drawing Title:
Fitted Wardrobes Joinery & Re-instated Door

Scale:
1:25@A1
1:50@A3

Date:
Apr 25

Drawn:
KN

Checked:
KW

kyson
Studio

28 Scrutton Street
London
UK
EC2A 4RP

T: +44(0) 20 7247 2462
E: enquiries@kyson.co.uk
W: www.kyson.co.uk

Project No.:
900-25

Drawing No.:
5013

Revision:
C

Do not scale this drawing All dimensions must be checked on site.
All rights reserved. No reproduction in any material form is permitted
without consent.

