




Approved West Elevation
Scale 1:25@A1
1:50@A3

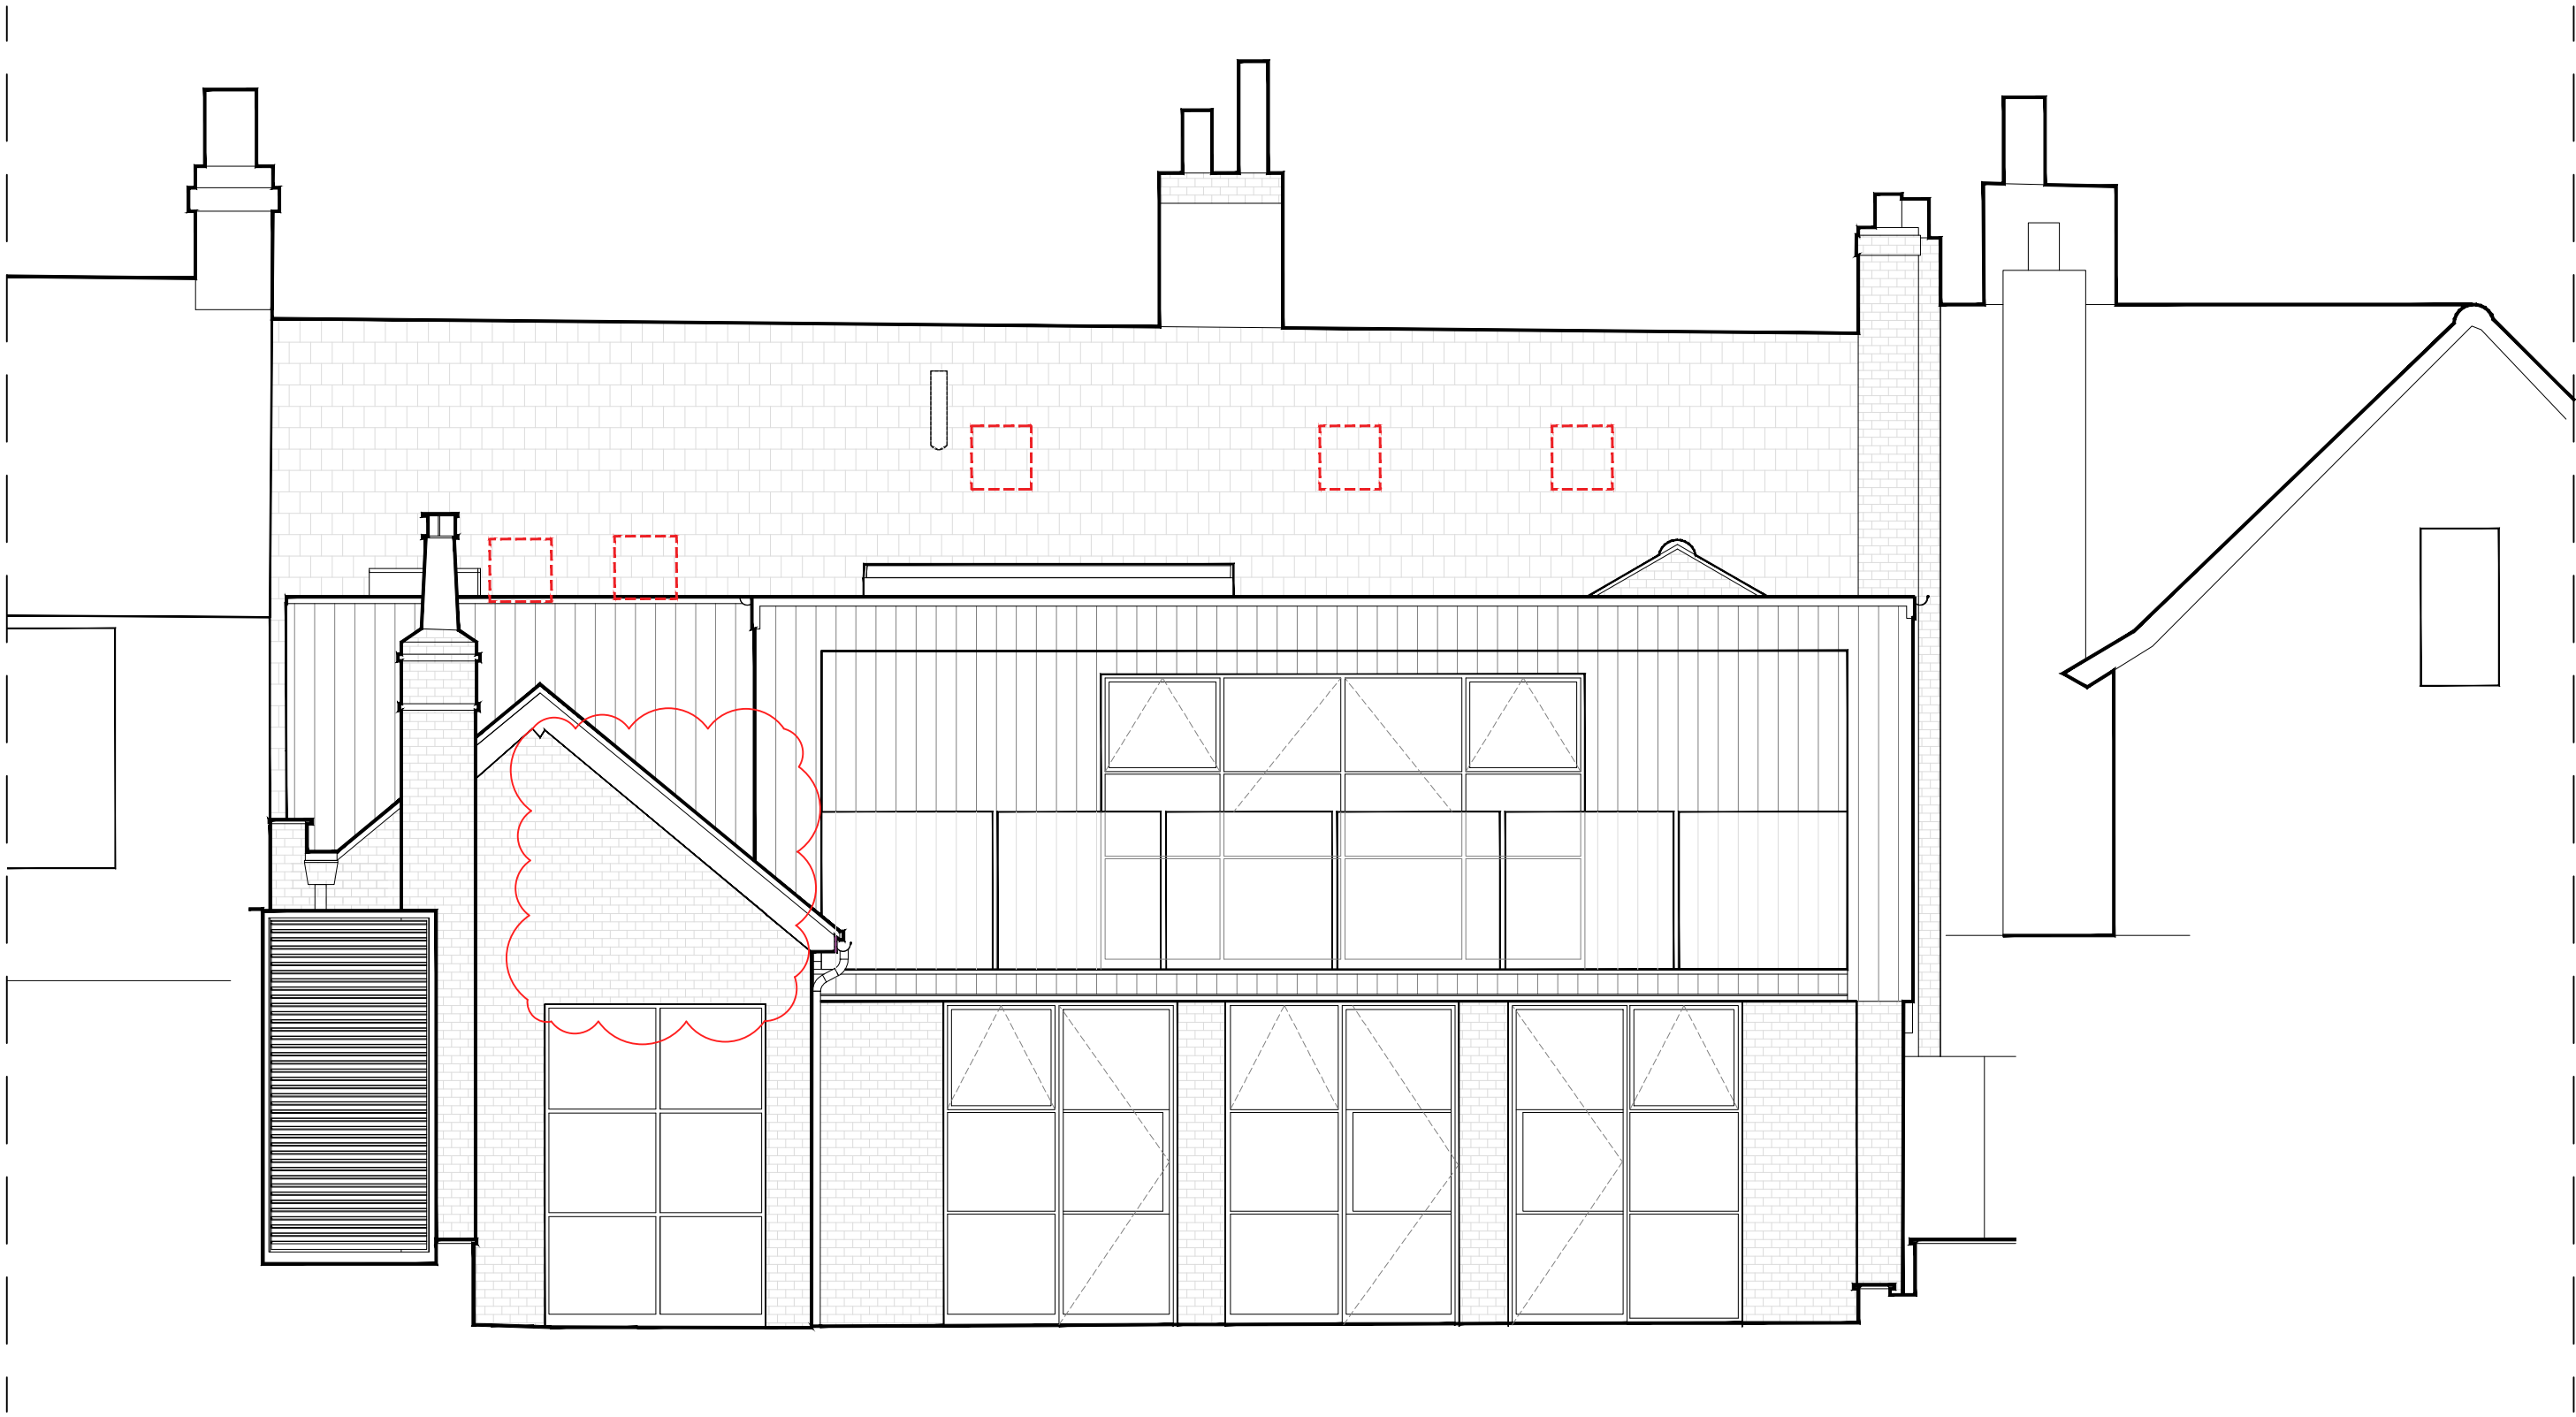

Proposed West Elevation
Scale 1:25@A1
1:50@A3

KEY:
Highlighted difference between Approved Scheme and 'As-Built'/Proposed Scheme

Rev.	Comments:	By:	Date:
A	Amendments as clouded.	KN	Nov 25

Do not scale this drawing All dimensions must be checked on site
All rights reserved. No reproduction in any material form is permitted without consent.

LISTED BUILDING
CONSENT

Client:
Mr. Simon Dougall

Project Title:
107 High St, Lindfield, Haywards Heath, West Sussex, RH16 2HR

Drawing Title:
Detail Drawings:
Removal of Rooflights

Scale:	Date:	Drawn:	Checked:
1:25@A1 1:50@A3	Apr 25	KN	KW



Studio
28 Scrutton Street
London
UK
EC2A 4RP

T: +44(0) 20 7247 2462
E: enquiries@kyson.co.uk
W: www.kyson.co.uk

Project No.:	Drawing No.:	Revision:
900-25	5019	A

kyson

