


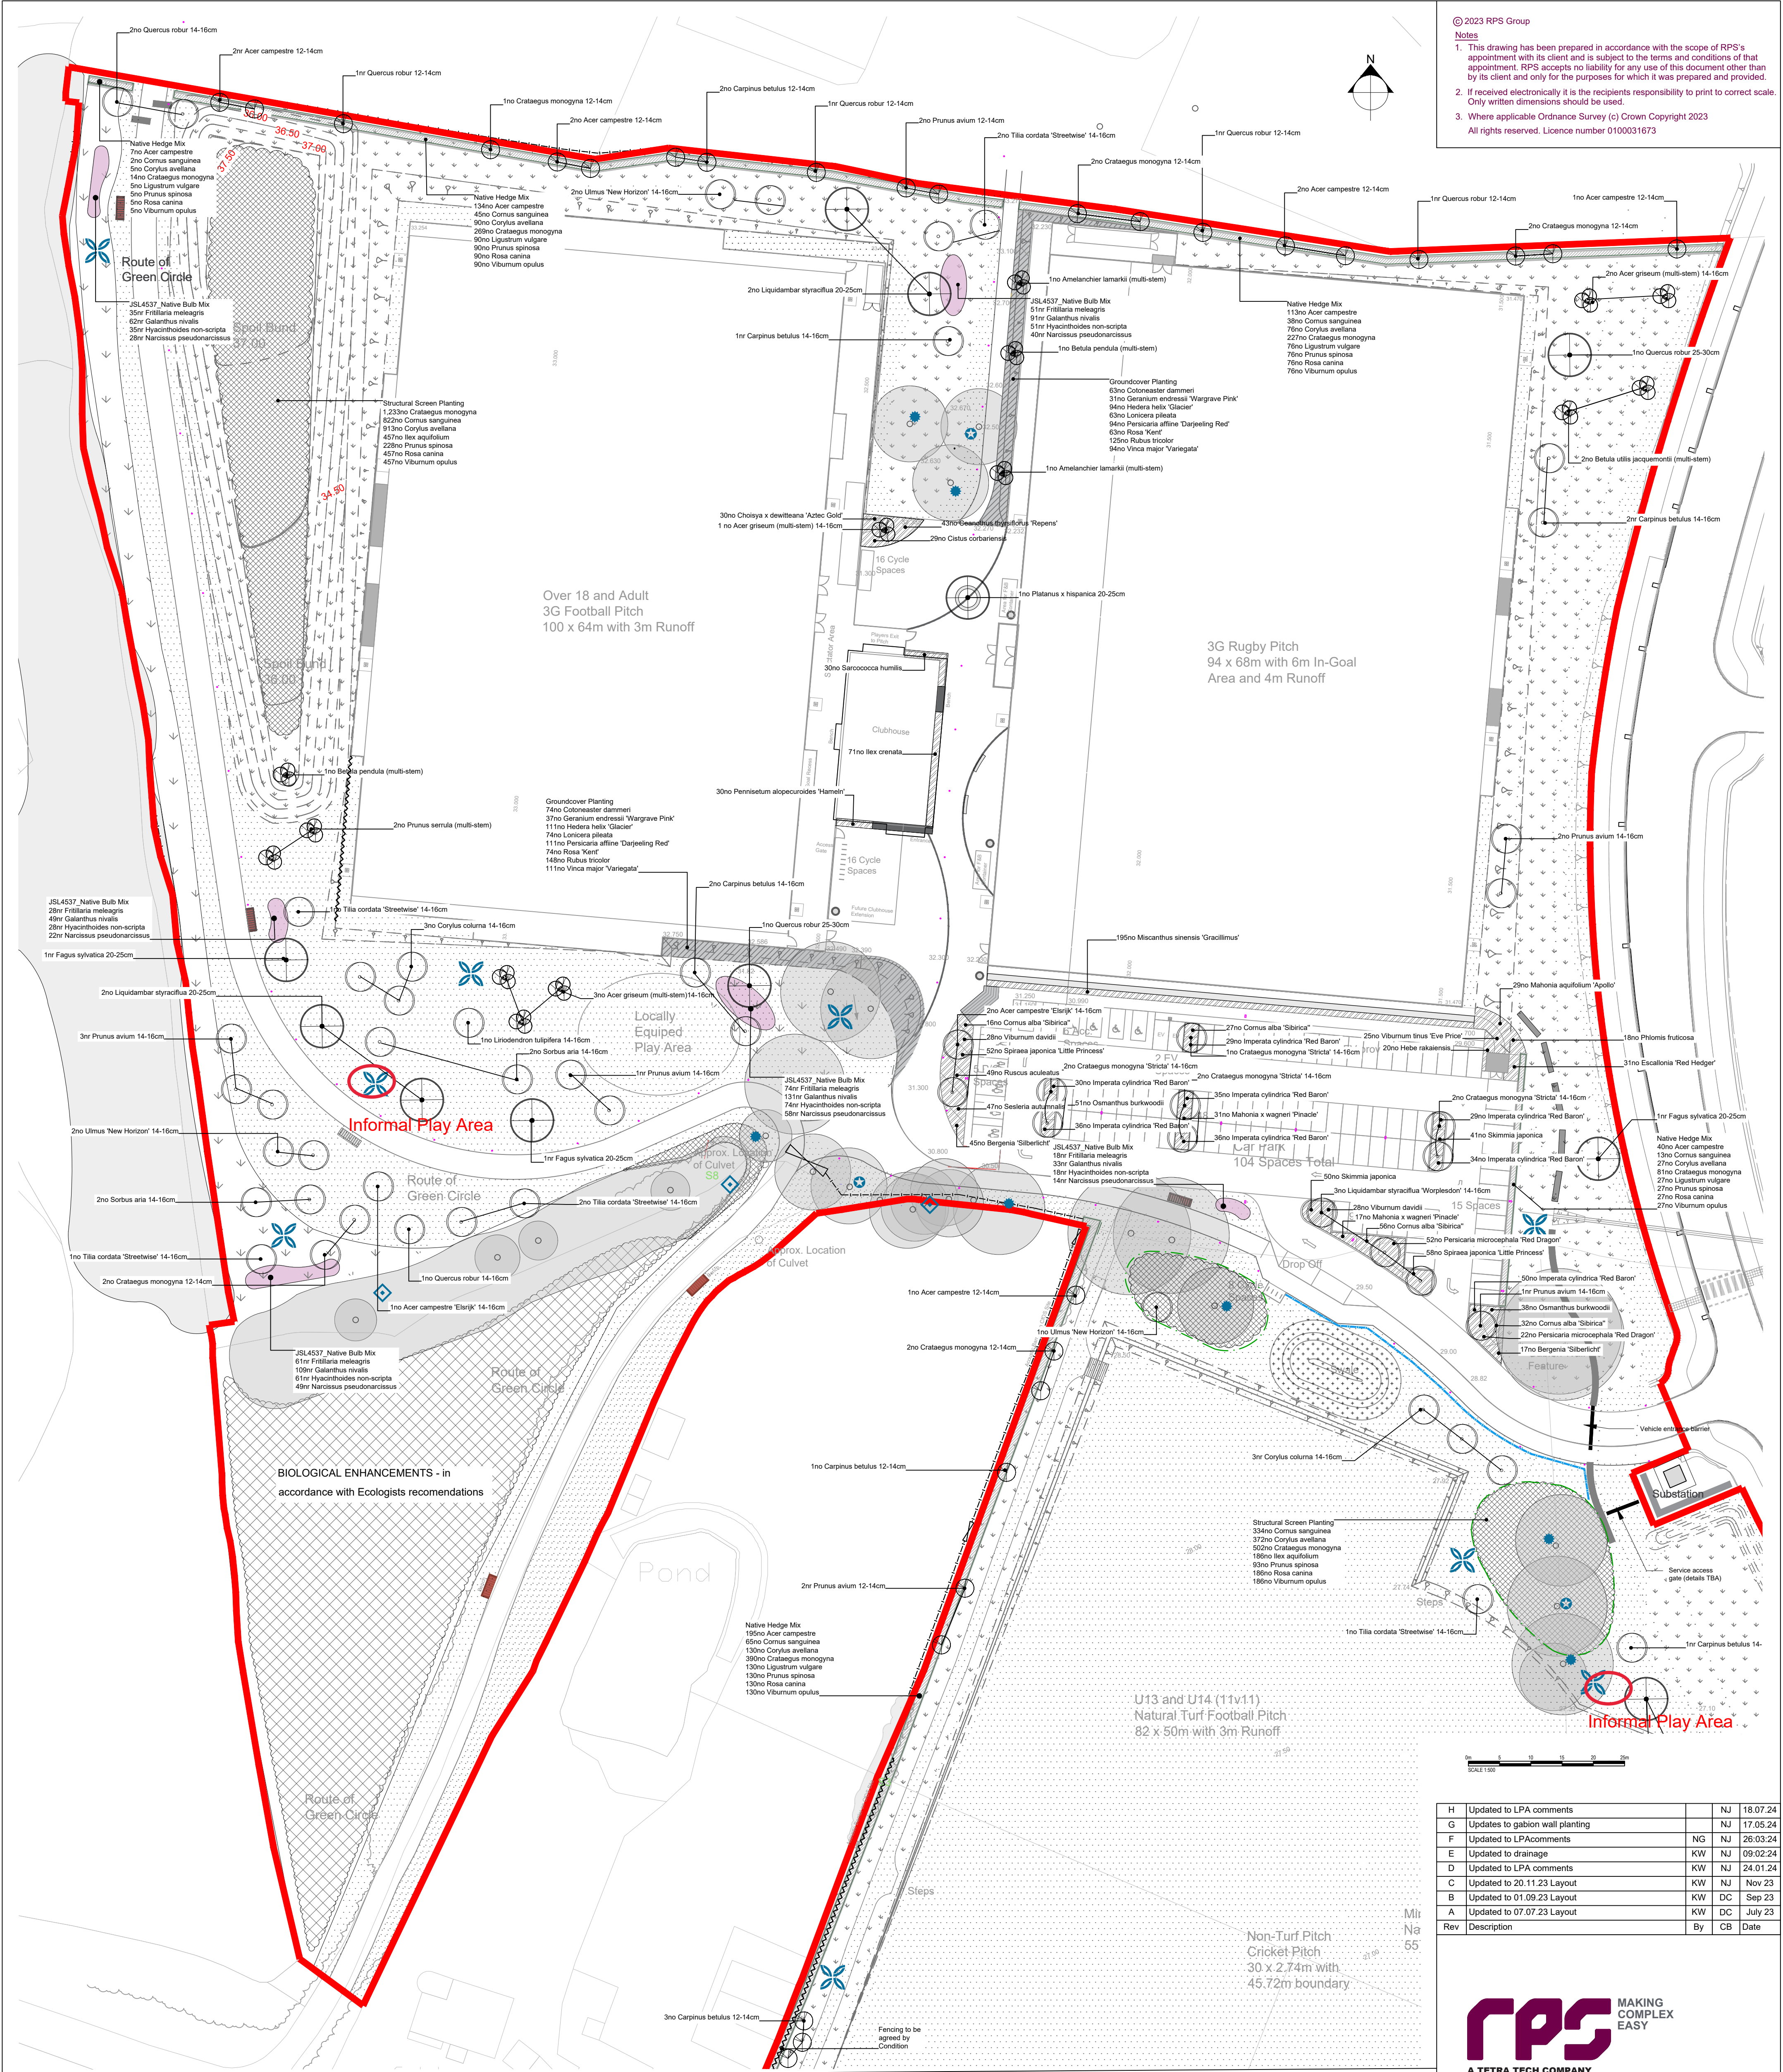

© 2023 RPS Group
Notes
1. This drawing has been prepared in accordance with the scope of RPS's appointment with its client and is subject to the terms and conditions of that appointment. RPS accepts no liability for any use of this document other than by its client and only for the purposes for which it was prepared and provided.
2. If received electronically it is the recipient's responsibility to print to correct scale. Only written dimensions should be used.
3. Where applicable Ordnance Survey (c) Crown Copyright 2023
All rights reserved. Licence number 0100031673

KEY

SITE BOUNDARY

TREES AND VEGETATION TO BE RETAINED

GROUPS OF TREES TO BE RETAINED & PROTECTED

SEMI MATURE TREE

EXTRA HEAVY STANDARD TREE

HEAVY STANDARD TREE inc Orchard and Hedging trees

MULTI-STEM TREE

NATIVE MIXED HEDGEROW

MOWN AMENITY GRASS

GENERAL MEADOW AREA

WET GRASSLAND MIX

BIOLOGICAL ENHANCEMENTS In accordance with ecologists recommendations

ORNAMENTAL SHRUB PLANTING

GROUND COVER PLANTING

STRUCTURAL SCREEN PLANTING

BULB PLANTING

MARGINAL PLANTING

FENCE DETAILS
Proposed elements

TIMBER POST & RAIL FENCE (1.2m high, 5-bar)

TIMBER STOCK FENCE (1.2m high, timber post, stock mesh and top wire)

RABBIT PROOF FENCE (1.0m high, timber post and rabbit mesh)

LOW LOG KNEE RAIL (700mm high, unpeeled log style)

ACOUSTIC BARRIER refer specialists proposals

Mark Up 2 May 2025 to show location of informal play structures comprising of Stepping Logs 200mm and Balance Slalom as shown on Q-33479-H8F7_Rev5_0225_Redacted.pdf.

3no. locations - west of play area, near site entrance, south east of turf pitches

2 May 2025

H	Updated to LPA comments		NJ	18.07.24
G	Updates to gabion wall planting		NJ	17.05.24
F	Updated to LPA comments		NG	26.03.24
E	Updated to drainage		KW	09.02.24
D	Updated to LPA comments		KW	24.01.24
C	Updated to 20.11.23 Layout		KW	Nov 23
B	Updated to 01.09.23 Layout		KW	DC Sep 23
A	Updated to 07.07.23 Layout		KW	DC July 23
Rev	Description		By	CB Date

MAKING COMPLEX EASY
A TETRA TECH COMPANY

Lakesbury House, Hiltingsbury Road, Chandlers Ford, Hampshire SO63 5SS
T: 02380 810 440 E: rpsso@rpsgroup.com

Client **S&C Slatter Ltd**

Project **Burgess Hill Centre for Outdoor Sports**

Title **Soft Landscape Proposals and Enclosures Plan 1 of 2**

Status **Planning** Drawn By **KW** PM/Checked by **NJ**

Job Ref **JSL4537** Scale @ **A1 1:500** Date Created **Dec 2023**

RPS Drawing / Figure Number **500** Rev **H**

rpsgroup.com