


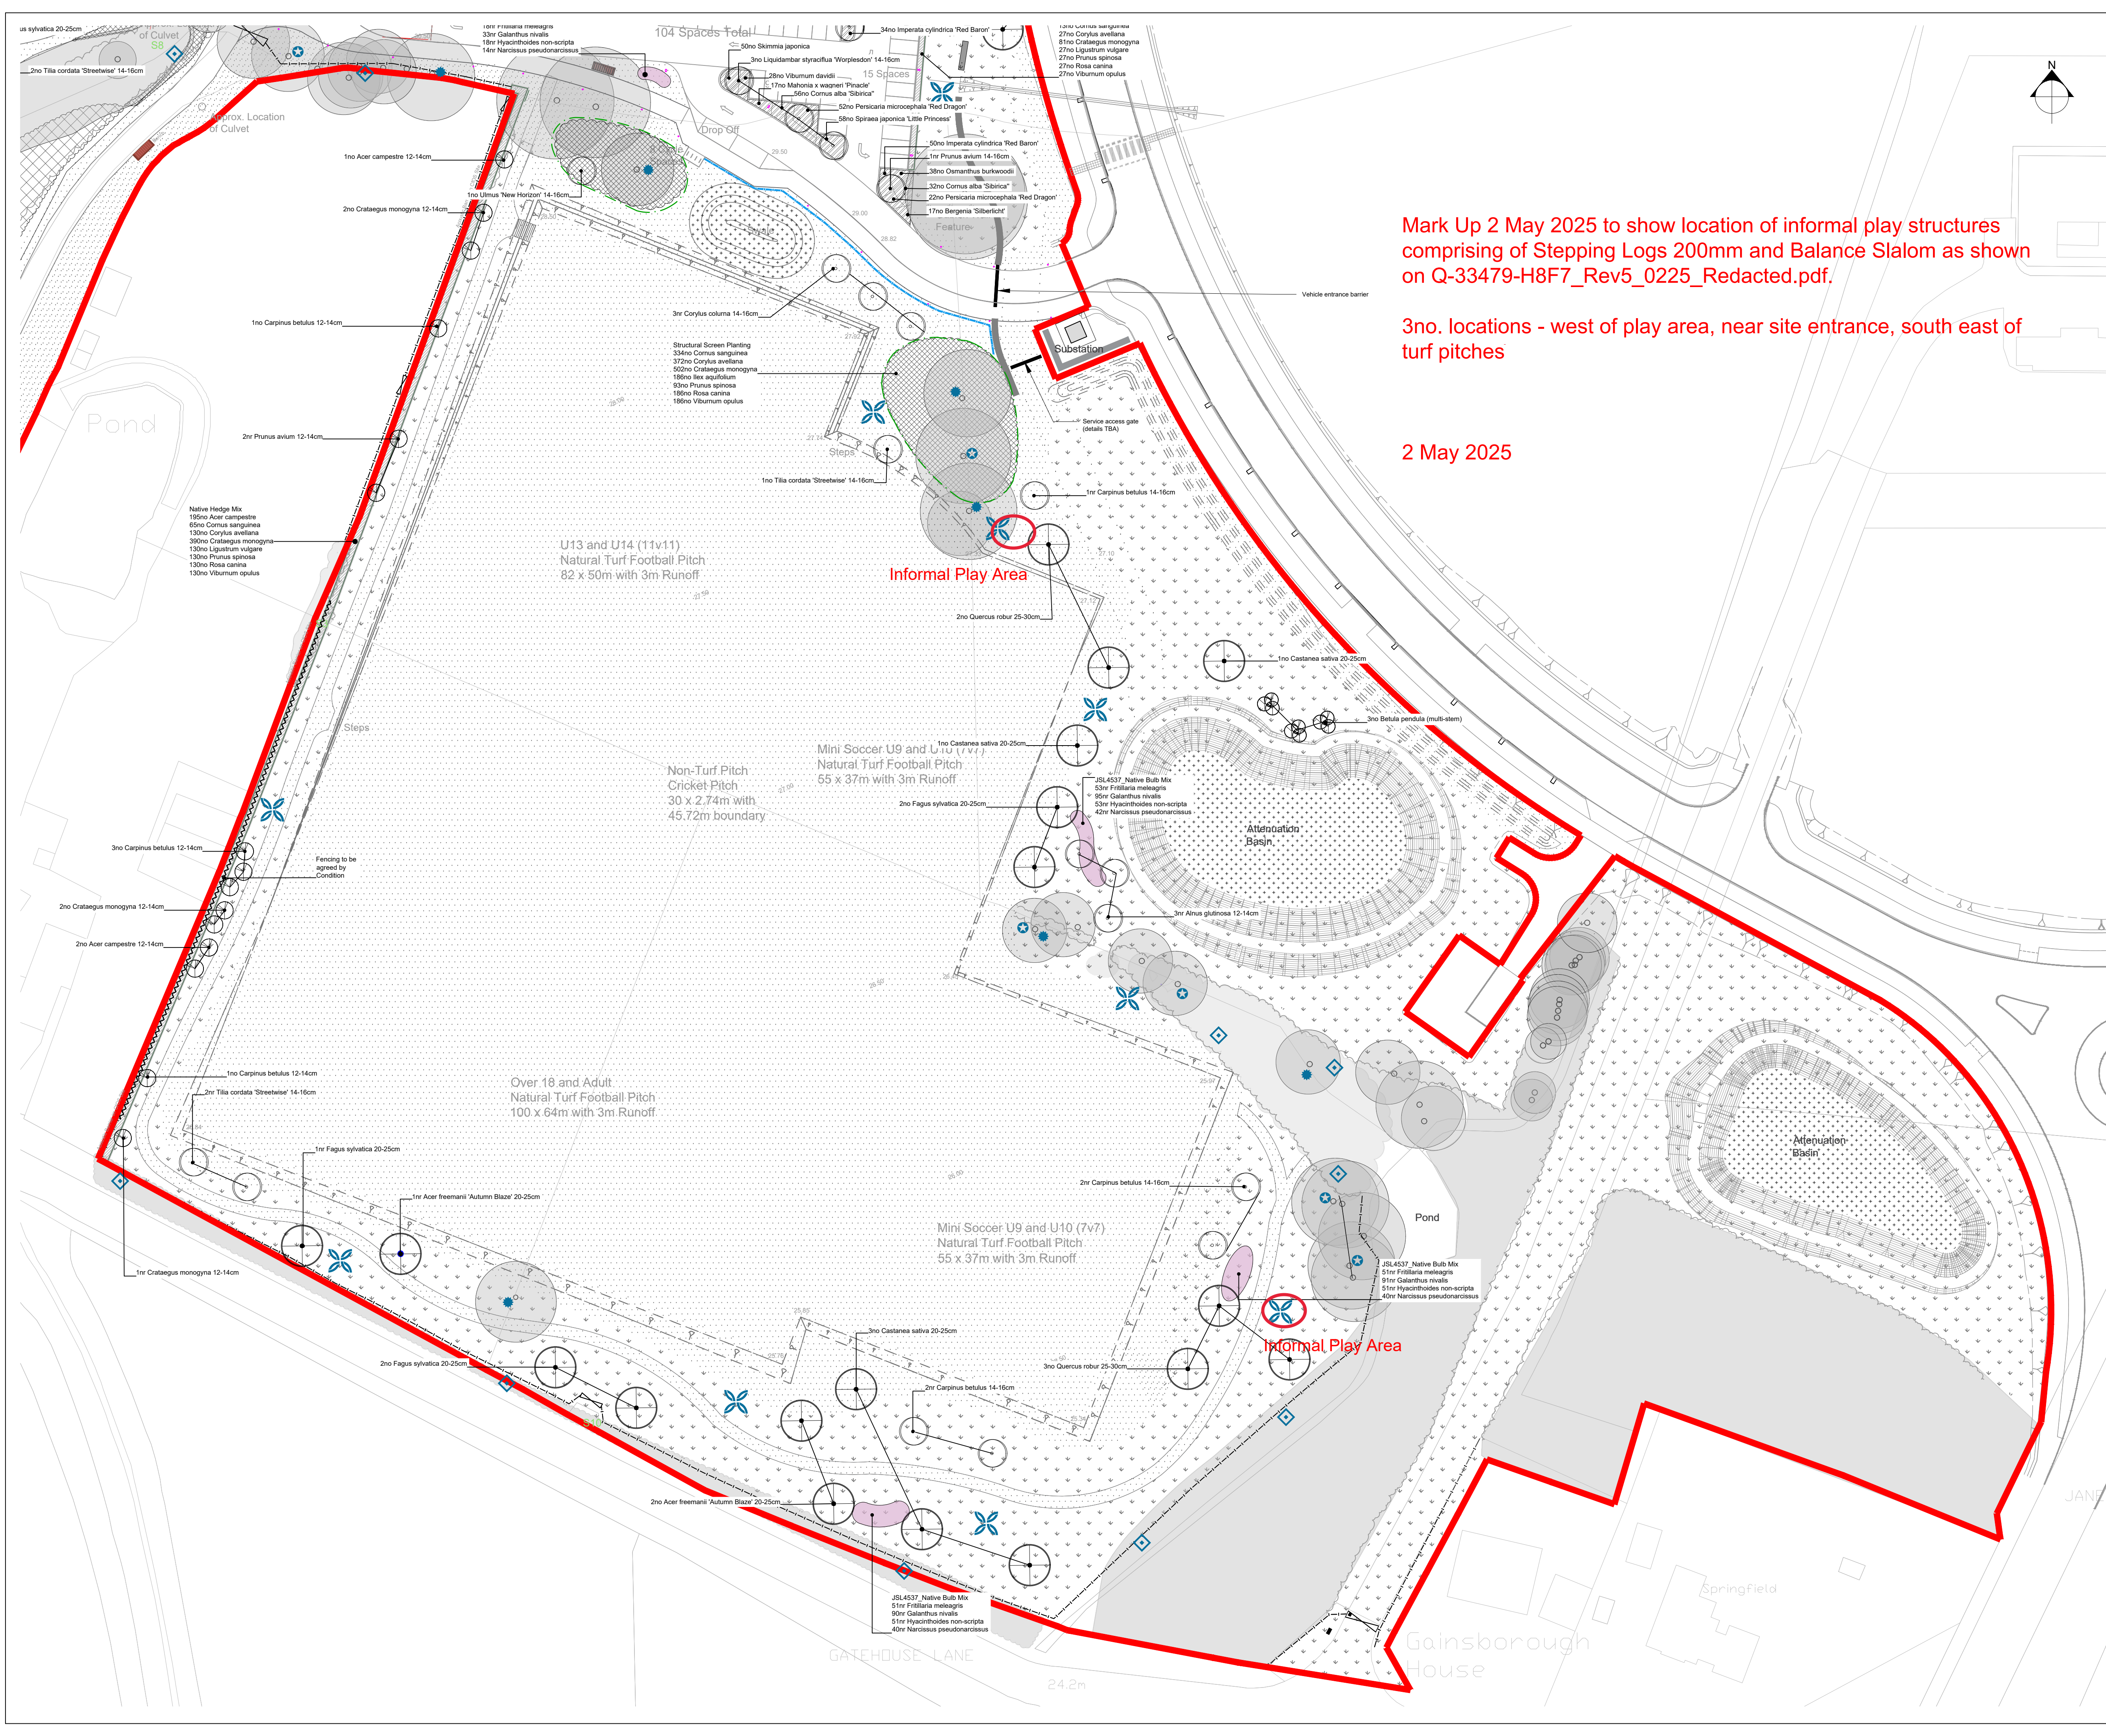

Mark Up 2 May 2025 to show location of informal play structures comprising of Stepping Logs 200mm and Balance Slalom as shown on Q-33479-H8F7_Rev5_0225_Redacted.pdf.

3no. locations - west of play area, near site entrance, south east of turf pitches

2 May 2025

© 2023 RPS Group

Notes

1. This drawing has been prepared in accordance with the scope of RPS's appointment with its client and is subject to the terms and conditions of that appointment. RPS accepts no liability for any use of this document other than by its client and only for the purposes for which it was prepared and provided.

2. If received electronically it is the recipients responsibility to print to correct scale. Only written dimensions should be used.

3. Where applicable Ordnance Survey (c) Crown Copyright 2023

All rights reserved. Licence number 0100031673

KEY

- SITE BOUNDARY
- TREES AND VEGETATION TO BE RETAINED
- GROUPS OF TREES TO BE RETAINED & PROTECTED
- SEMI MATURE TREE
- EXTRA HEAVY STANDARD TREE
- HEAVY STANDARD TREE inc Orchard and Hedging trees
- MULTI-STEM TREE
- NATIVE MIXED HEDGEROW
- MOWN AMENITY GRASS
- GENERAL MEADOW AREA
- WET GRASSLAND MIX
- BIOLOGICAL ENHANCEMENTS In accordance to ecologists recommendations
- ORNAMENTAL SHRUB PLANTING
- GROUND COVER PLANTING
- STRUCTURAL SCREEN PLANTING
- BULB PLANTING
- MARGINAL PLANTING

FENCE DETAILS

Proposed elements

- TIMBER POST & RAIL FENCE (1.2m high, 5-bar)
- TIMBER STOCK FENCE (1.2m high, timber post, stock mesh and top wire)
- RABBIT PROOF FENCE (1.0m high, timber post and rabbit mesh)
- LOW LOG KNEE RAIL (700mm high, unpainted log style)
- ACOUSTIC BARRIER refer specialists proposals

SCALE 1:500

G	Updated to LPA comments		NJ	18.07.24
F	Updated to LPA comments	NG	NJ	26.03.24
E	Revised to drainage	KW	NJ	09.02.24
D	Updated to LPA comments	KW	NJ	24.01.24
C	Updated to 20.11.23 Layout	KW	NJ	Nov 23
B	Updated to 01.09.23 Layout	KW	DC	Sep 23
A	Updated to 07.07.23 Layout	KW	DC	July 23
Rev	Description	By	CB	Date

rps MAKING COMPLEX EASY

A TETRA TECH COMPANY

Lakesbury House, Hittingbury Road, Chandlers Ford, Hampshire SO53 5SS

T: 02380 810 440 E: rpsso@rpsgroup.com

Client **S&C Slatter Ltd**

Project **Burgess Hill Centre for Outdoor Sport**

Title **Soft Landscape Proposals and Enclosures Plan 2 of 2**

Status **Planning** Drawn By **KW** PM/Checked by **NJ**

Job Ref **JSL4537** Scale @ A1 **1:500** Date Created **Nov 2023**

RPS Drawing / Figure Number **501** Rev **G**

rpsgroup.com