



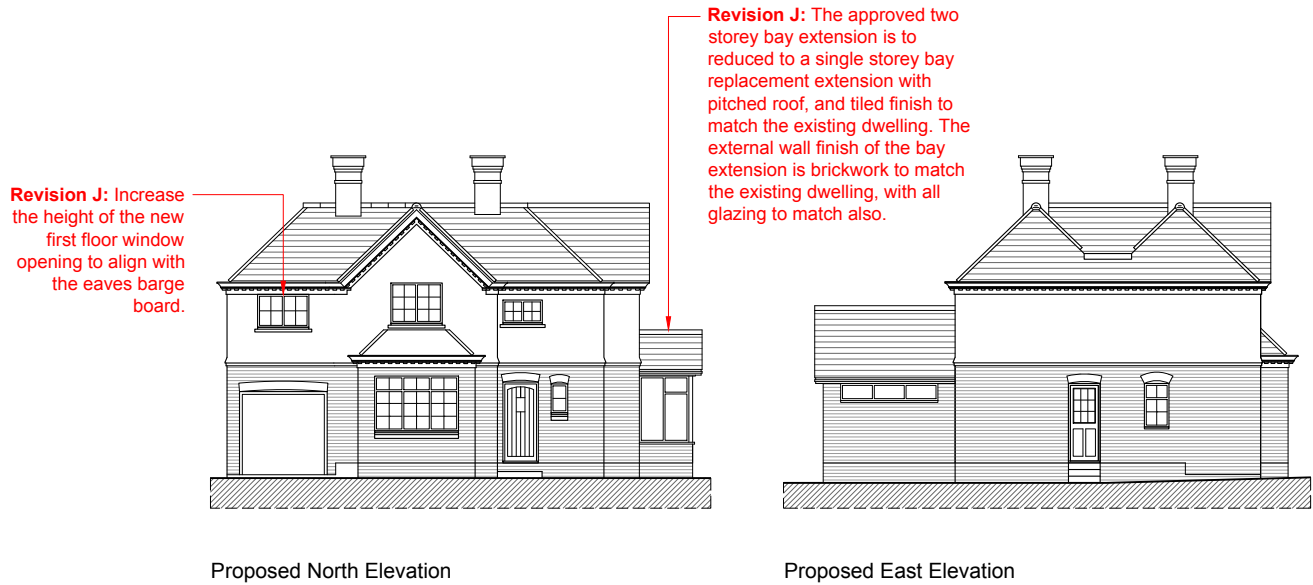

Proposed North Elevation

Proposed East Elevation

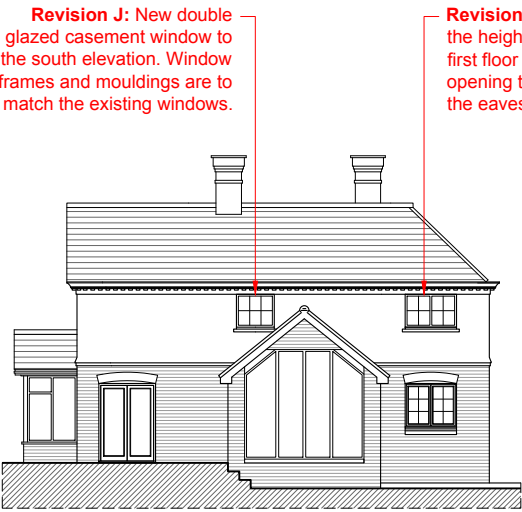

Proposed South Elevation



Proposed West Elevation


Proposed Elevations - Design Amendments Shown in Red
Scale: 1:200 [A3]

Drawing Key:

- Application Site
- Existing Structure[s]
- Proposed Structure



Proposed Ground Floor Plan - Design Amendments Shown in Red
Scale: 1:100 [A3]

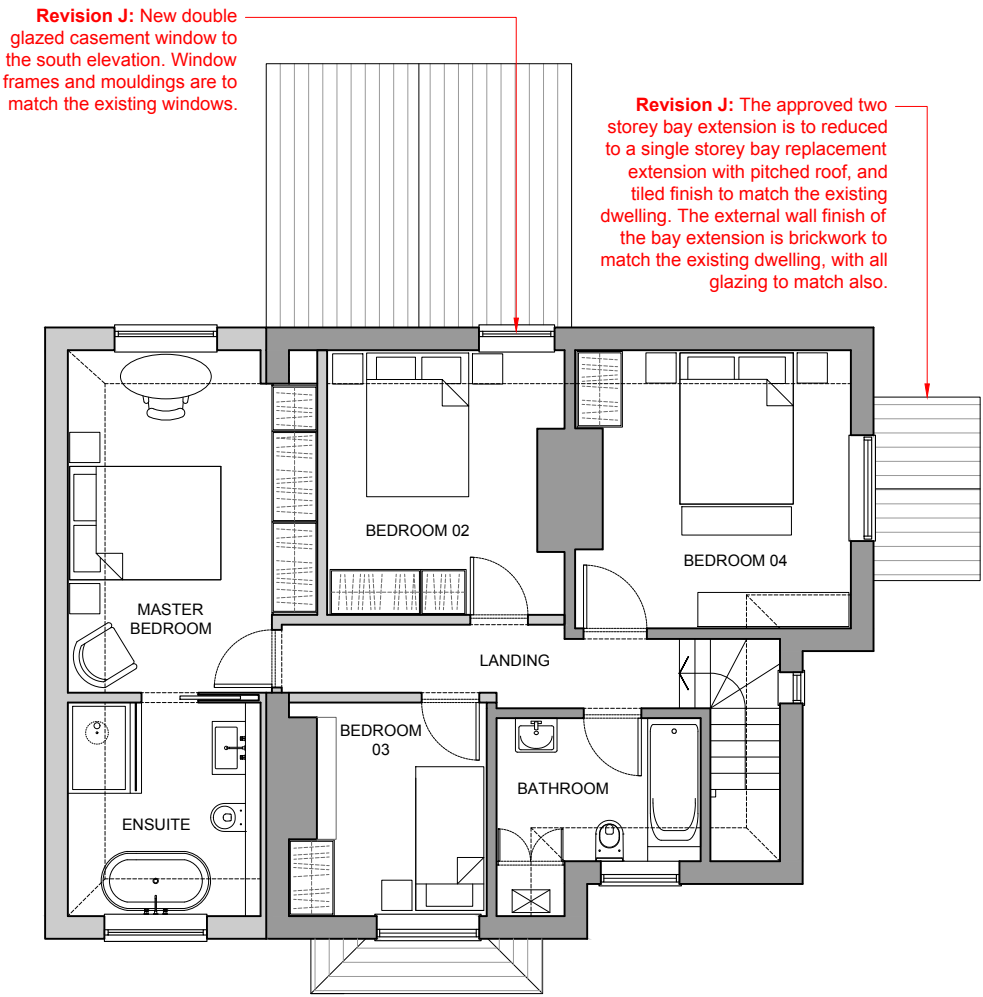


Proposed First Floor Plan - Design Amendments Shown in Red
Scale: 1:100 [A3]

J	13/04/26	Issued for PLANNING PERMISSION AMENDMENTS
Rev	Date	Description



Project		Project Reference	
2 By-Sunte, Lindfield		26002	
Client			
Private			
Date		Scale	
April 2026		1:100 @ A3 & 1:200 @ A3	

Drawn	Checked	Approved	Rev
NR	NR	NR	J
Title			
Proposed Floor & Elevation Plans			
Drawing Number			
4108-02			

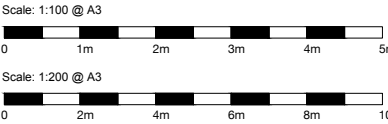

This drawing is copyright of Rose Chapman Architects. Do not scale from this drawing. All dimensions and levels to be checked on site by the contractor and such dimensions to be his responsibility. Report all drawing errors, omissions and discrepancies to the architect.

DISCLAIMER
This document may be issued in an editable digital CAD format to enable others to use it as background information to make alterations and/or additions. In that instance the file will be accompanied by a PDF version as a record of the original file. It is for those parties making such alterations and/or additions to ensure that they make use of current background information. Rose Chapman Architects accepts no liability for either: any such alterations and/or additions to the background information by others; or any other changes made by others to the architectural content of the background information itself.