




Elevation A

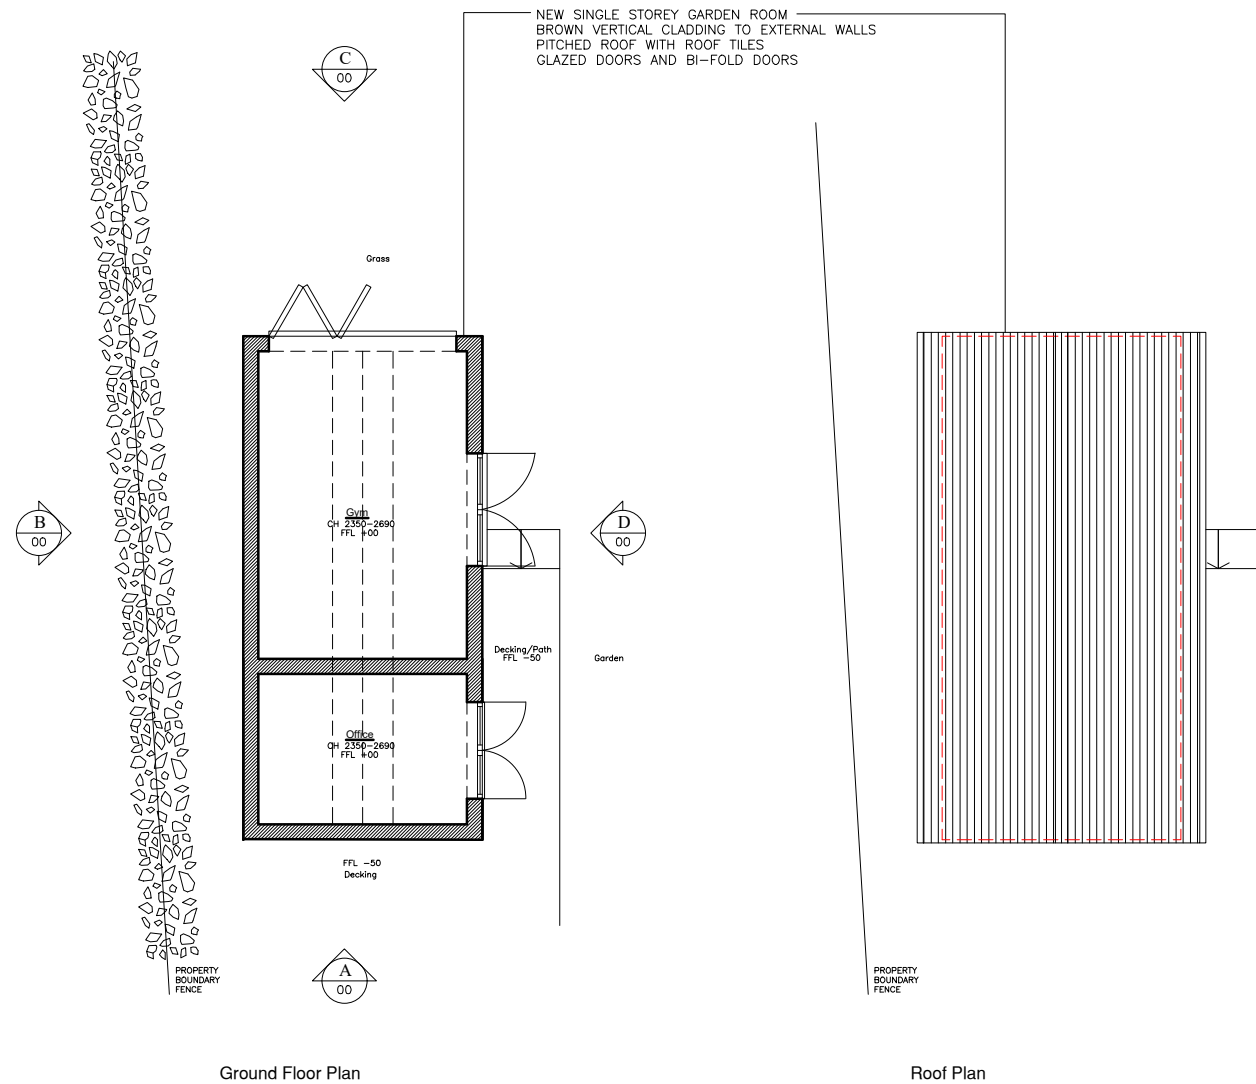

Elevation B

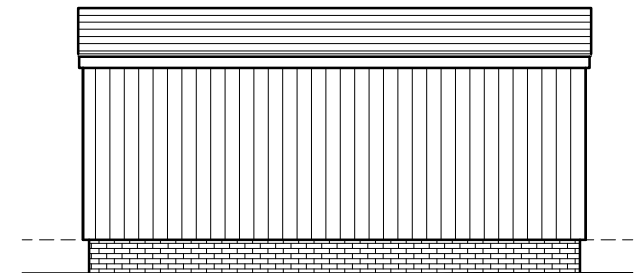

Elevation C

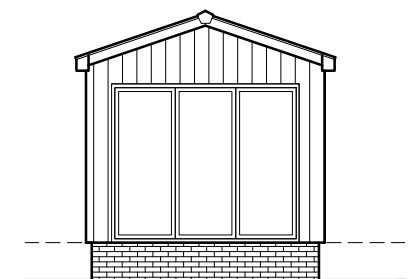


Elevation D

PROPOSED NEW INTERNAL &
EXTERNAL WALLS



N

**GARDEN ROOM
AS-BUILT DRAWINGS**

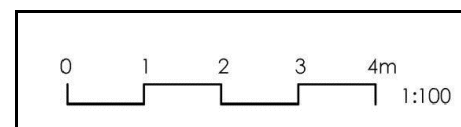

Title Proposed Floor & Roof Plans Proposed Elevations				SARAH BREEZE RIBA	
Drawn by SB		Checked by BC&FC		Client Brett & Fiona Carr	
Scale A3 @ 1:100		Date 28.08.26		Project 28 West Common Lindfield West Sussex RH16 2AH	
Project no.	Dwg. no.	Revision	Prelim.		
BA224	11	--			