


‘AS BUILT’ / EXISTING DRAWINGS
PLANS

- KEY
- Historic bake house
 - 15th Century timber- framed building
 - South gabled bay with vitrified blue headers c.1830
 - New rear extension
(deviation from planning approval
DM/22/3694 & DM/22/3695)

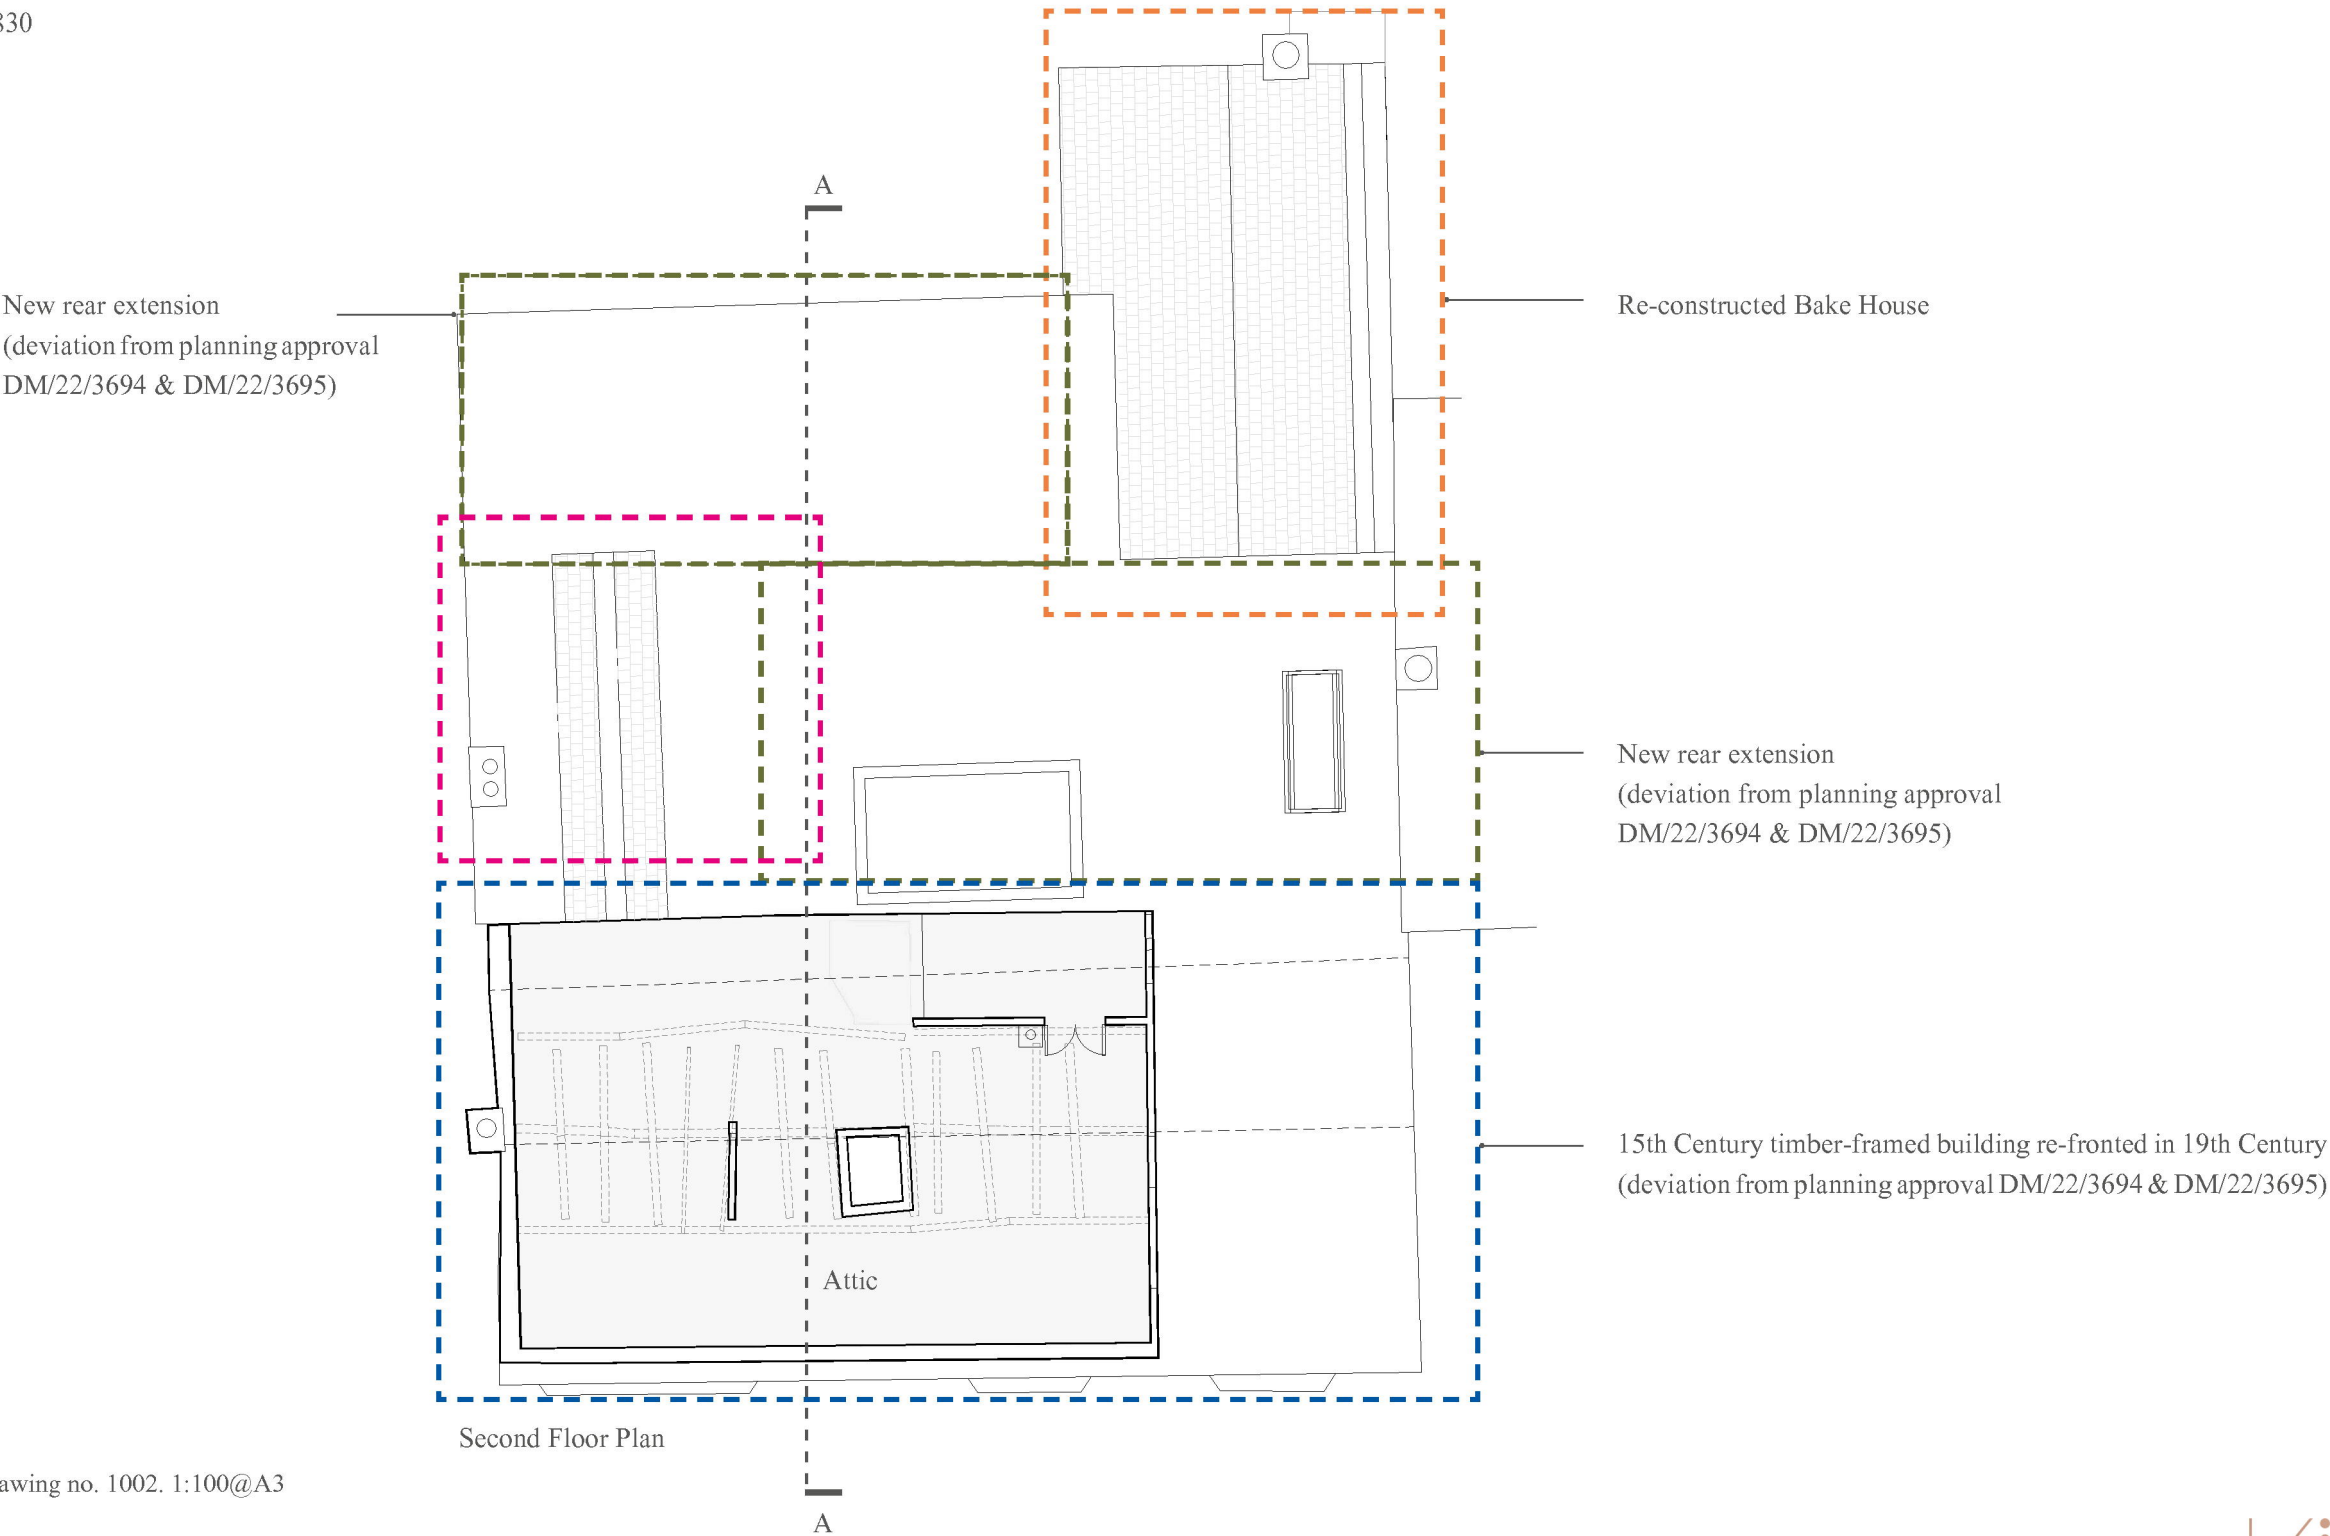

‘AS BUILT’/EXISTING SECOND FLOOR PLAN. 1:Drawing no. 1002. 1:100@A3

