


‘AS BUILT’ / EXISTING DRAWINGS
ELEVATIONS

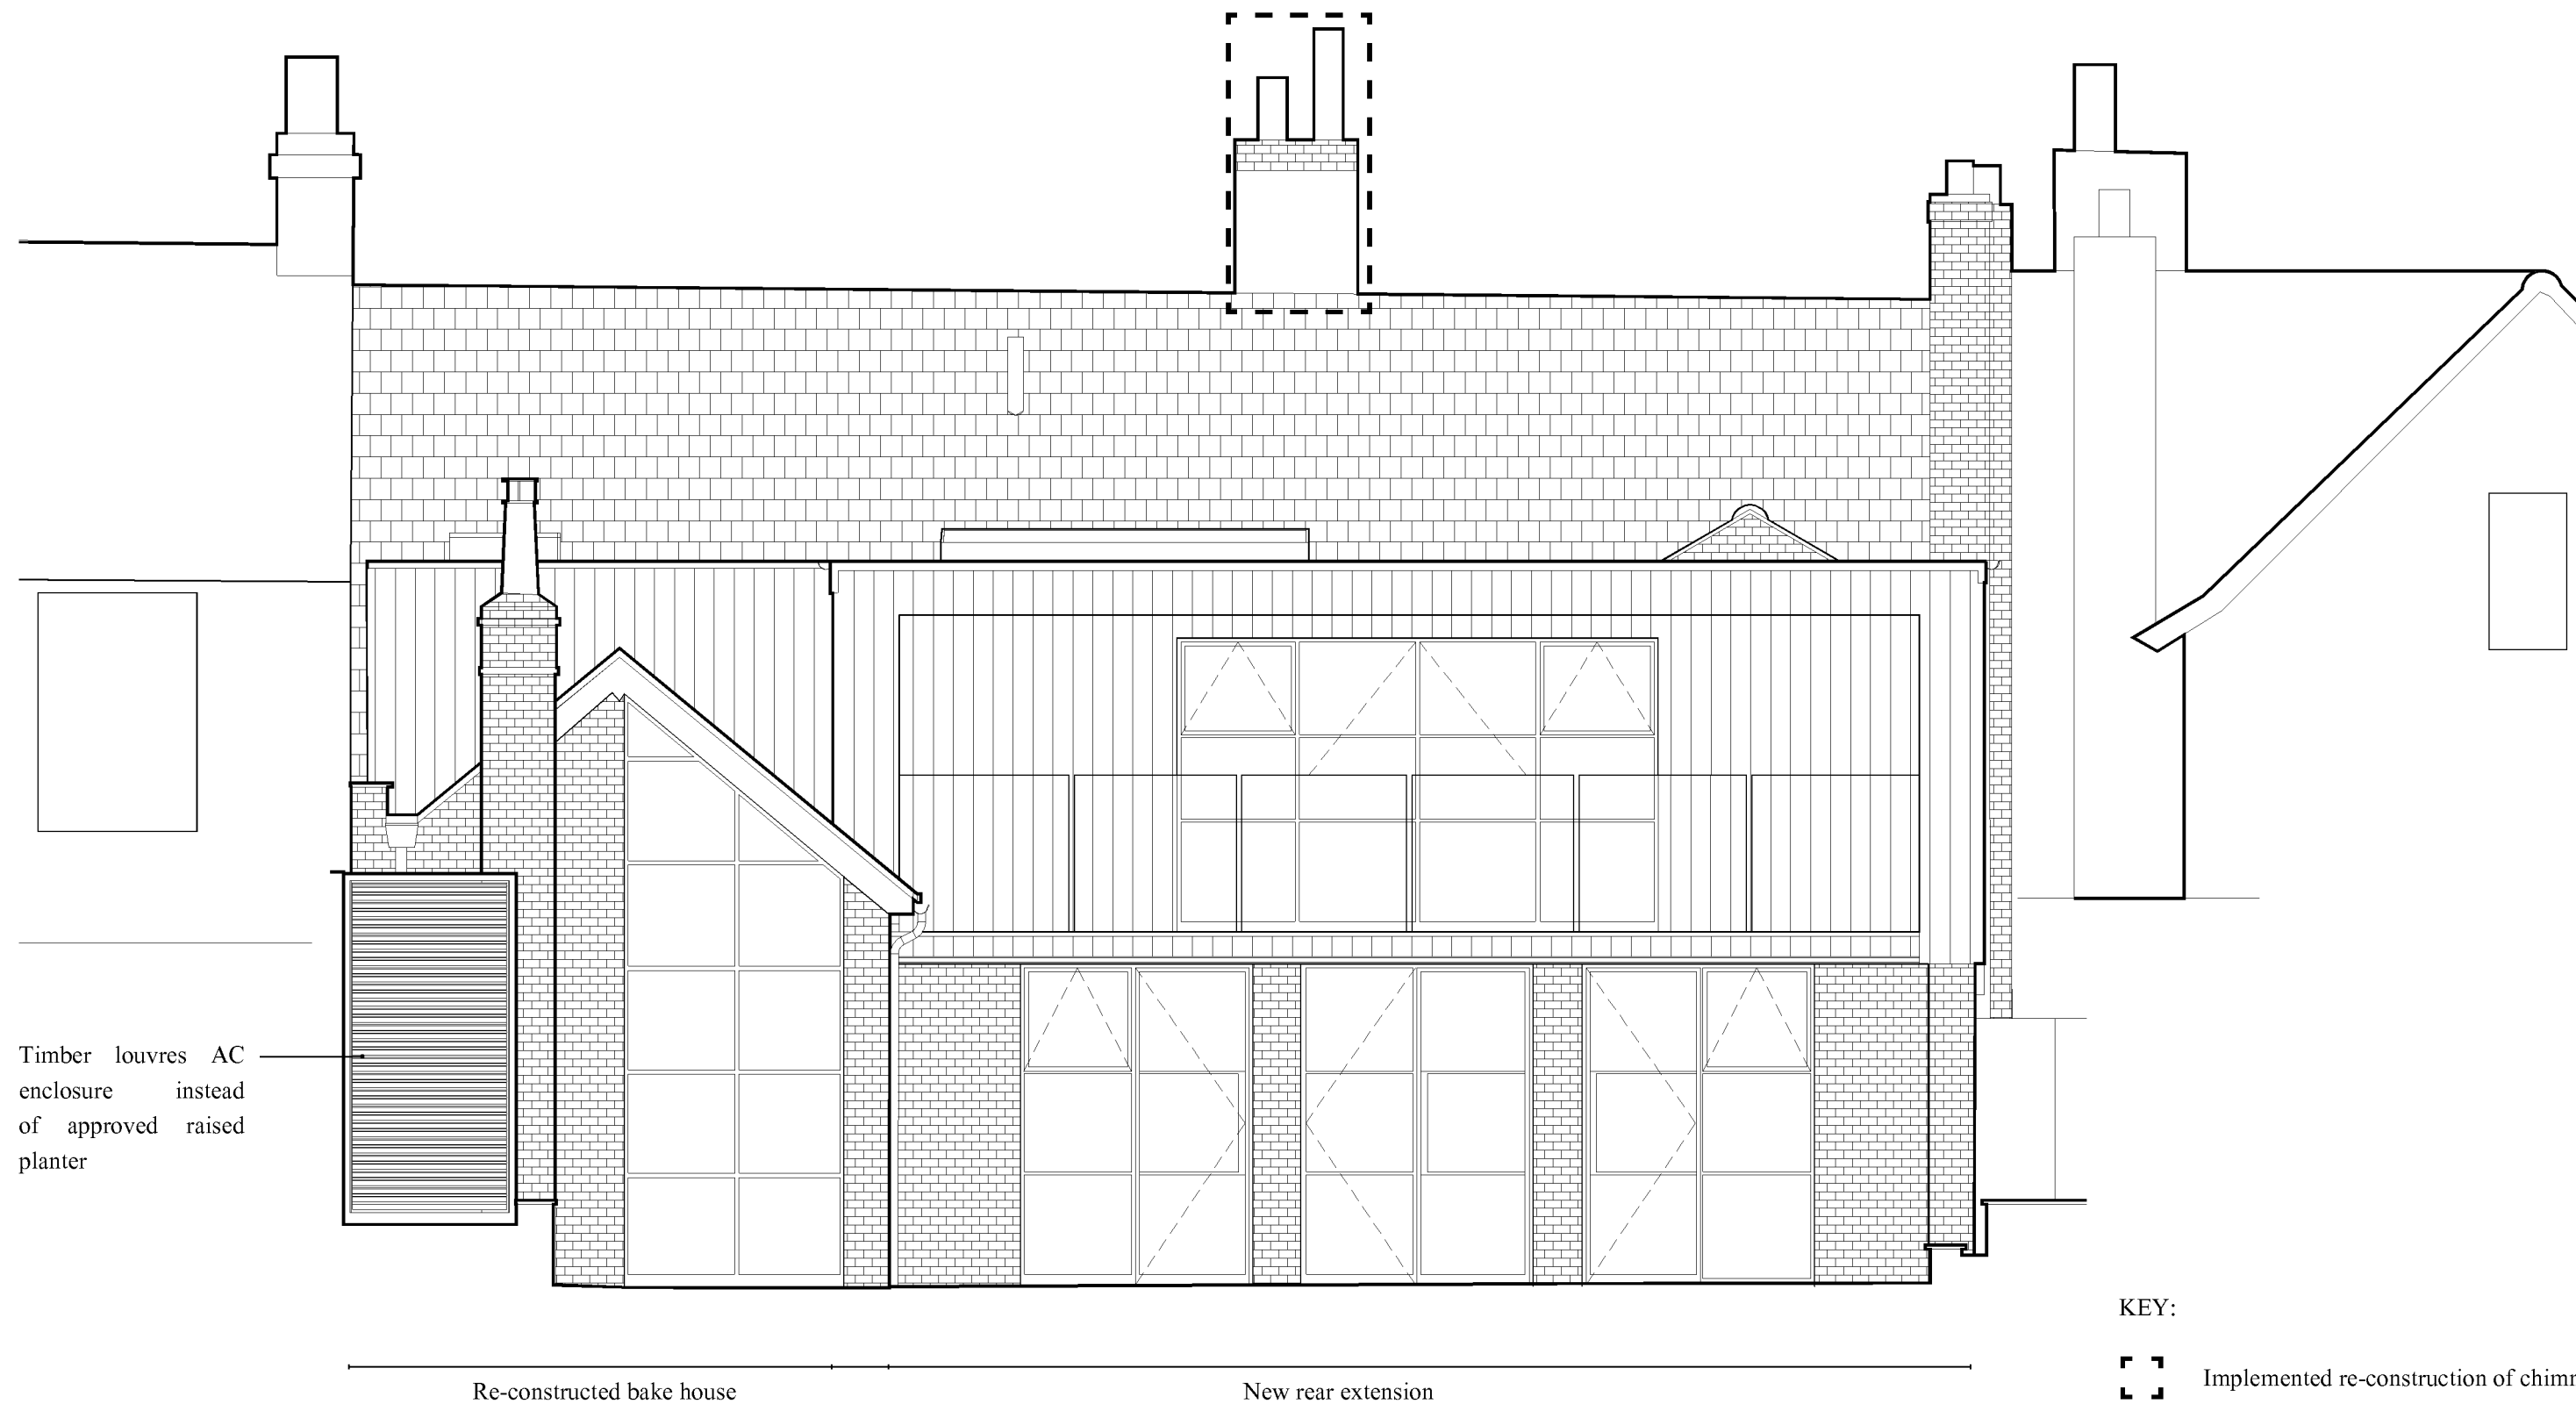

‘AS BUILT’/EXISTING WEST ELEVATION. Drawing no. 1101. 1:50@A3

