


‘AS BUILT’ / EXISTING DRAWINGS

ELEVATIONS

KEY:



Implemented re-construction of chimney approved under application DM/24/0987

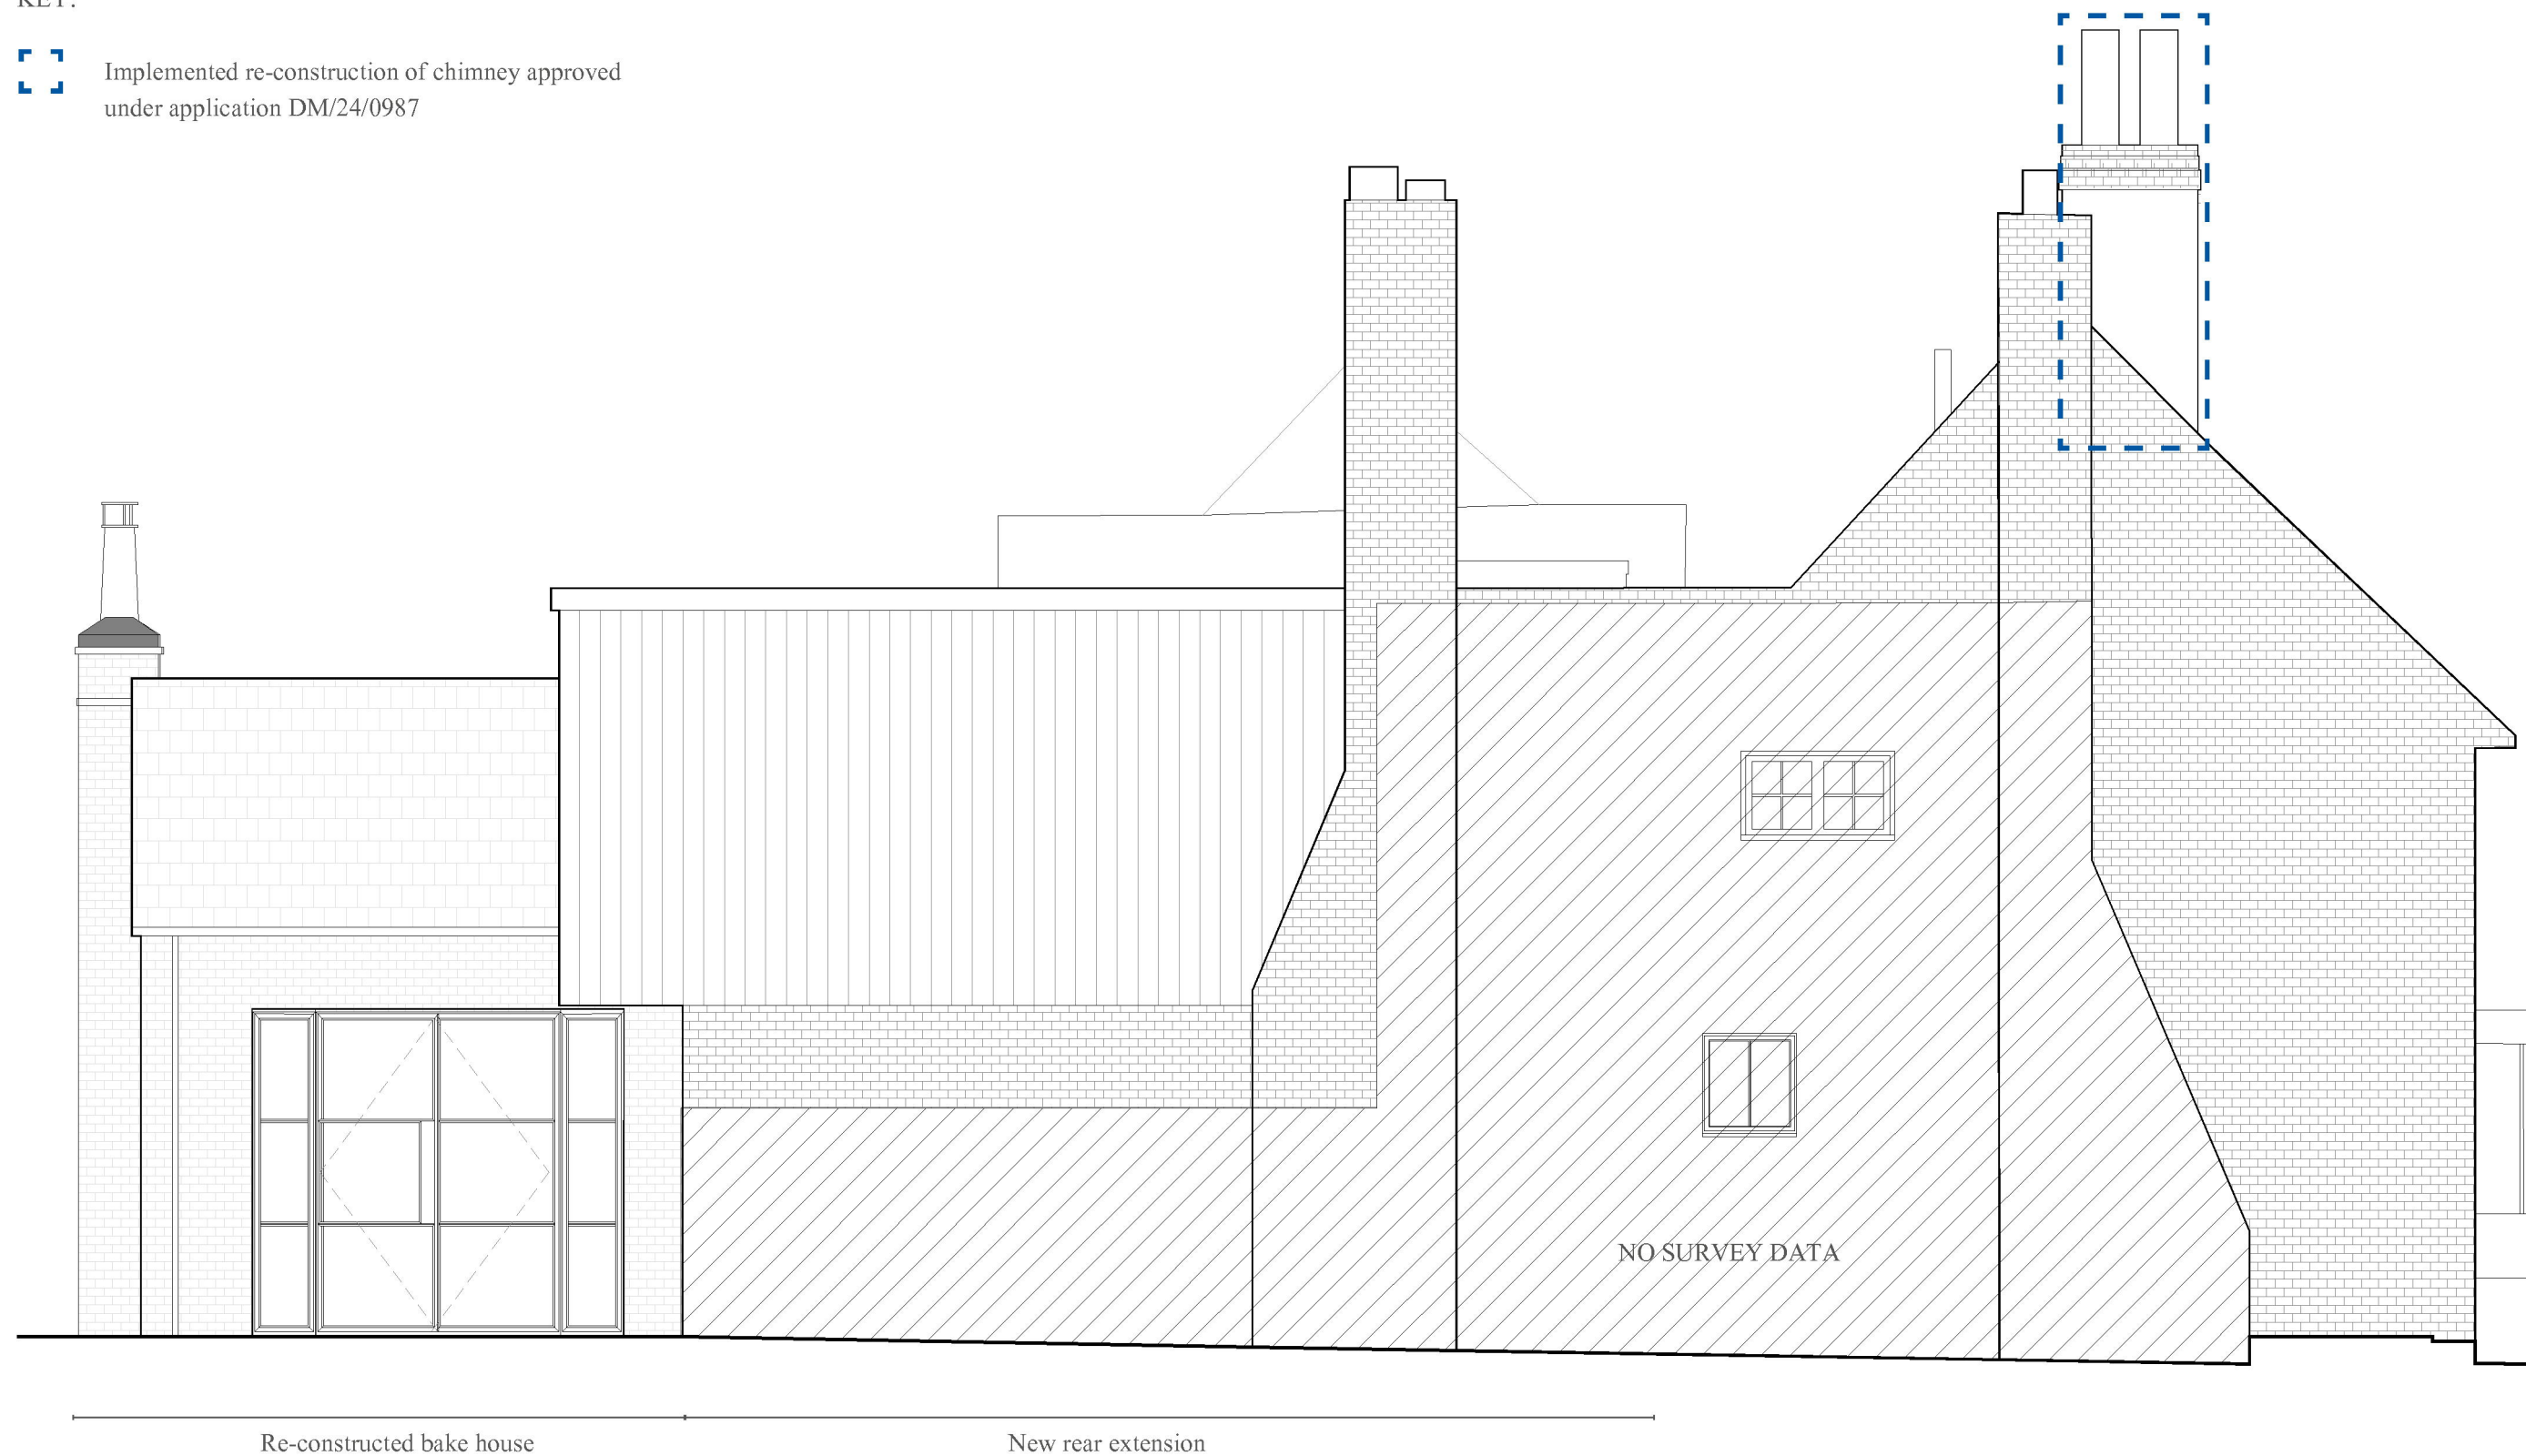

‘AS BUILT’/EXISTING SOUTH ELEVATION. Drawing no. 1102. 1:50@A3

