


‘AS BUILT’ / EXISTING DRAWINGS
ELEVATIONS

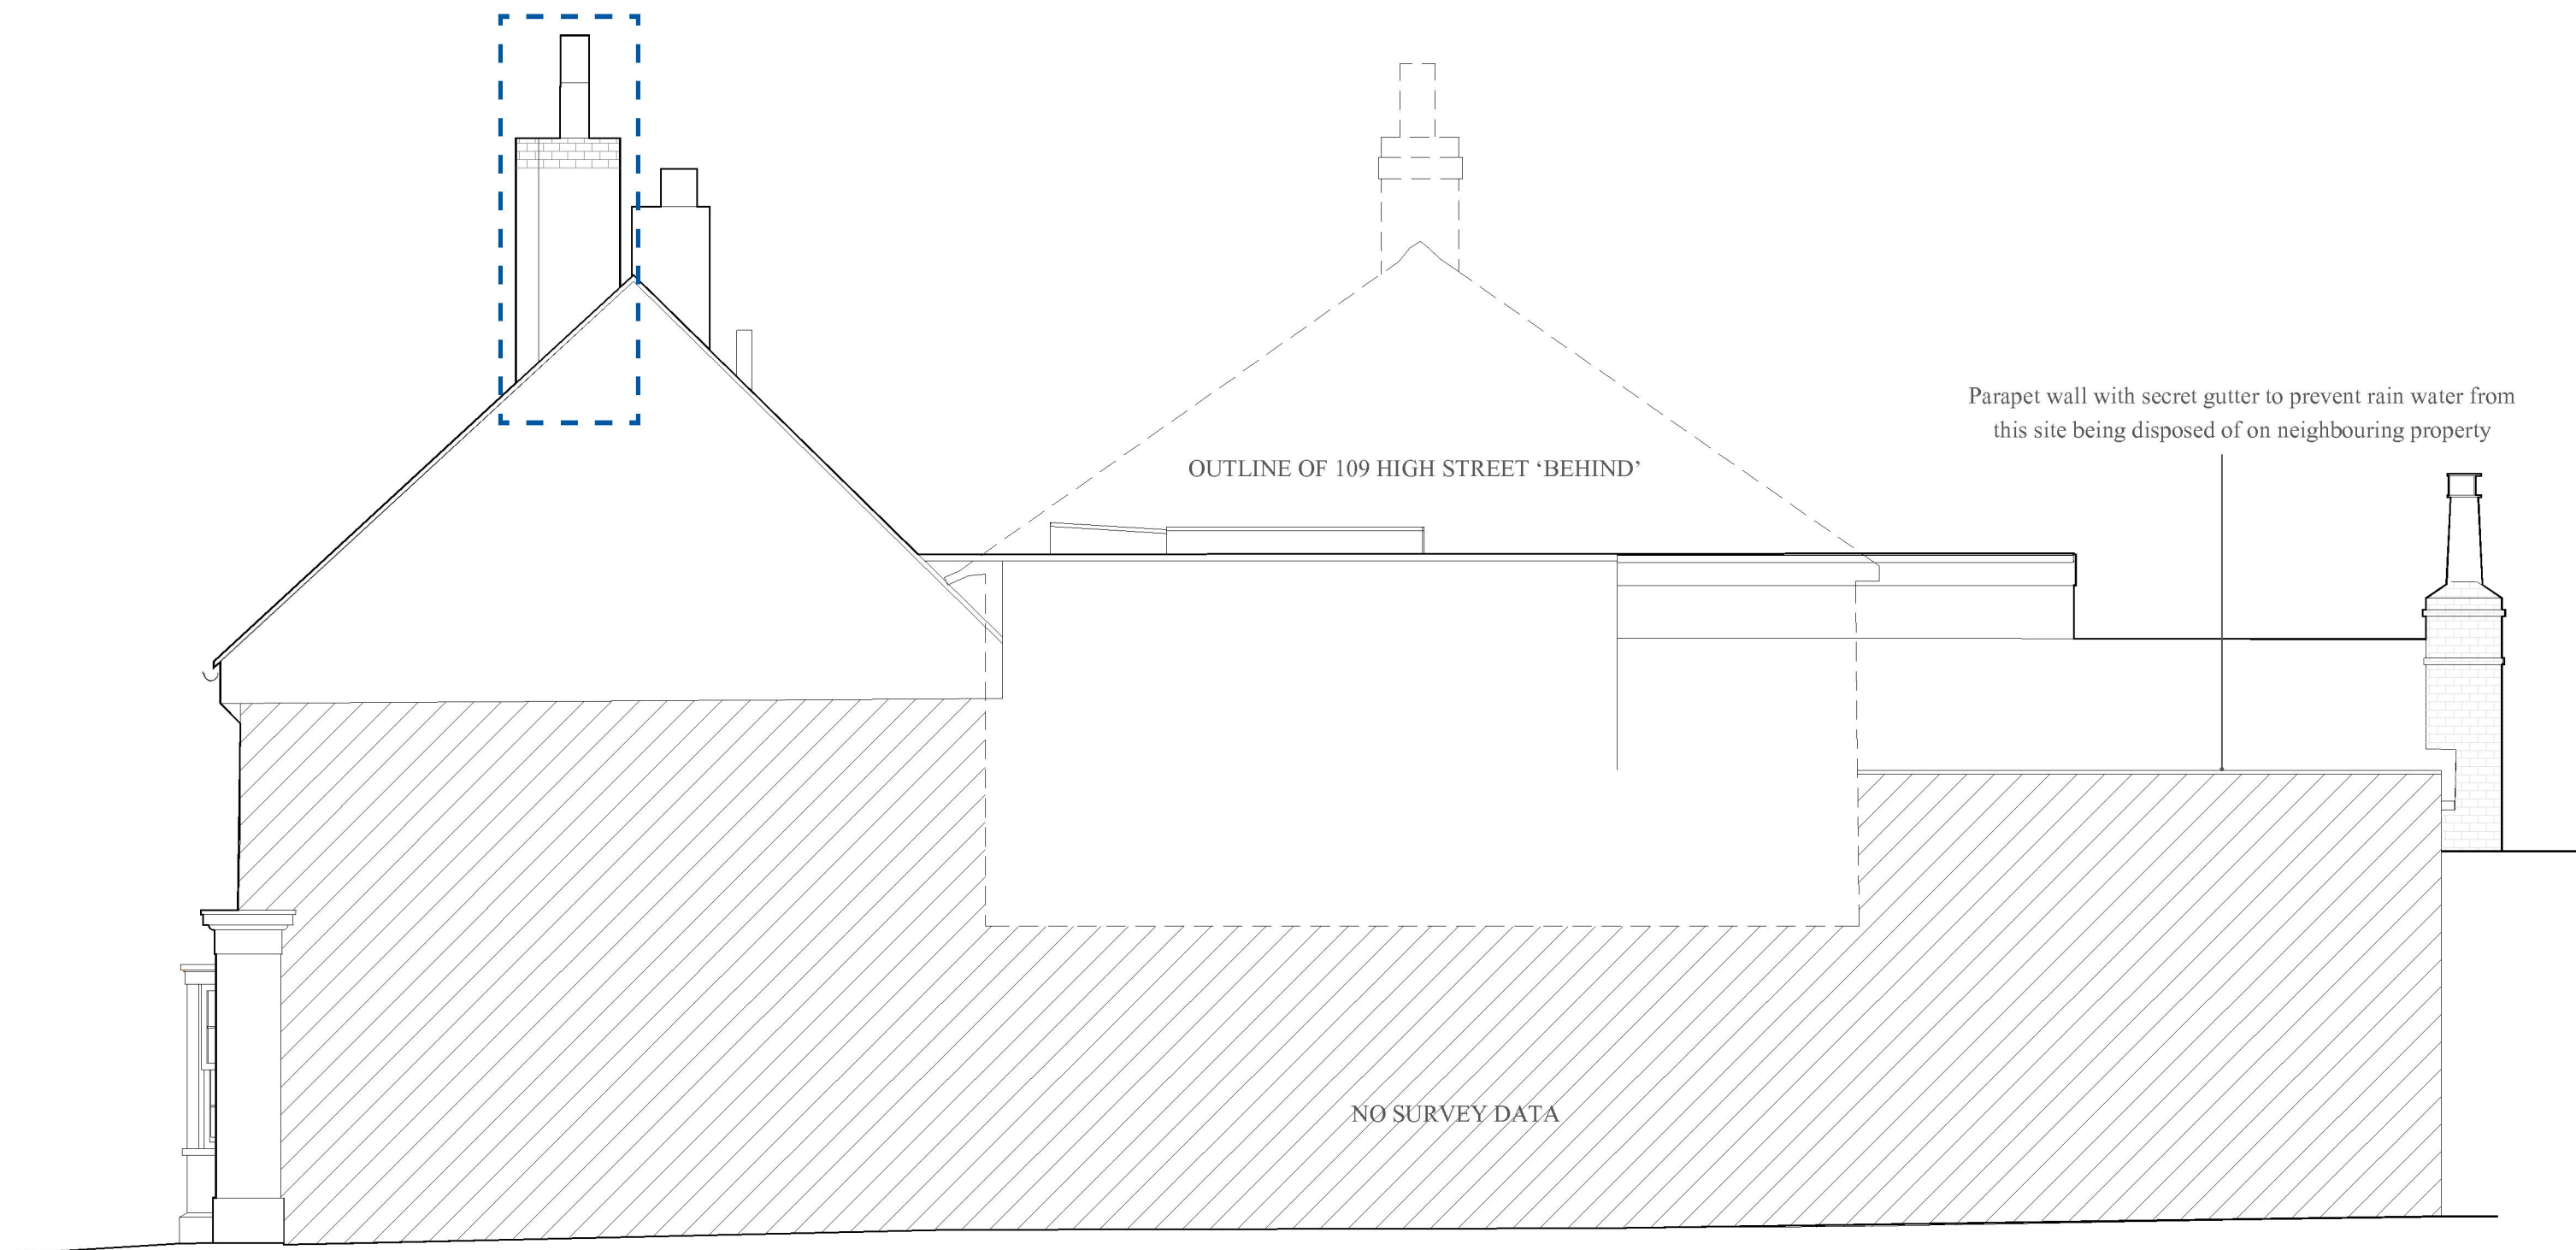

KEY:



Implemented re-construction of chimney approved
under application DM/24/0987

‘AS BUILT’/EXISTING NORTH ELEVATION. Drawing no. 1103. 1:50@A3

