


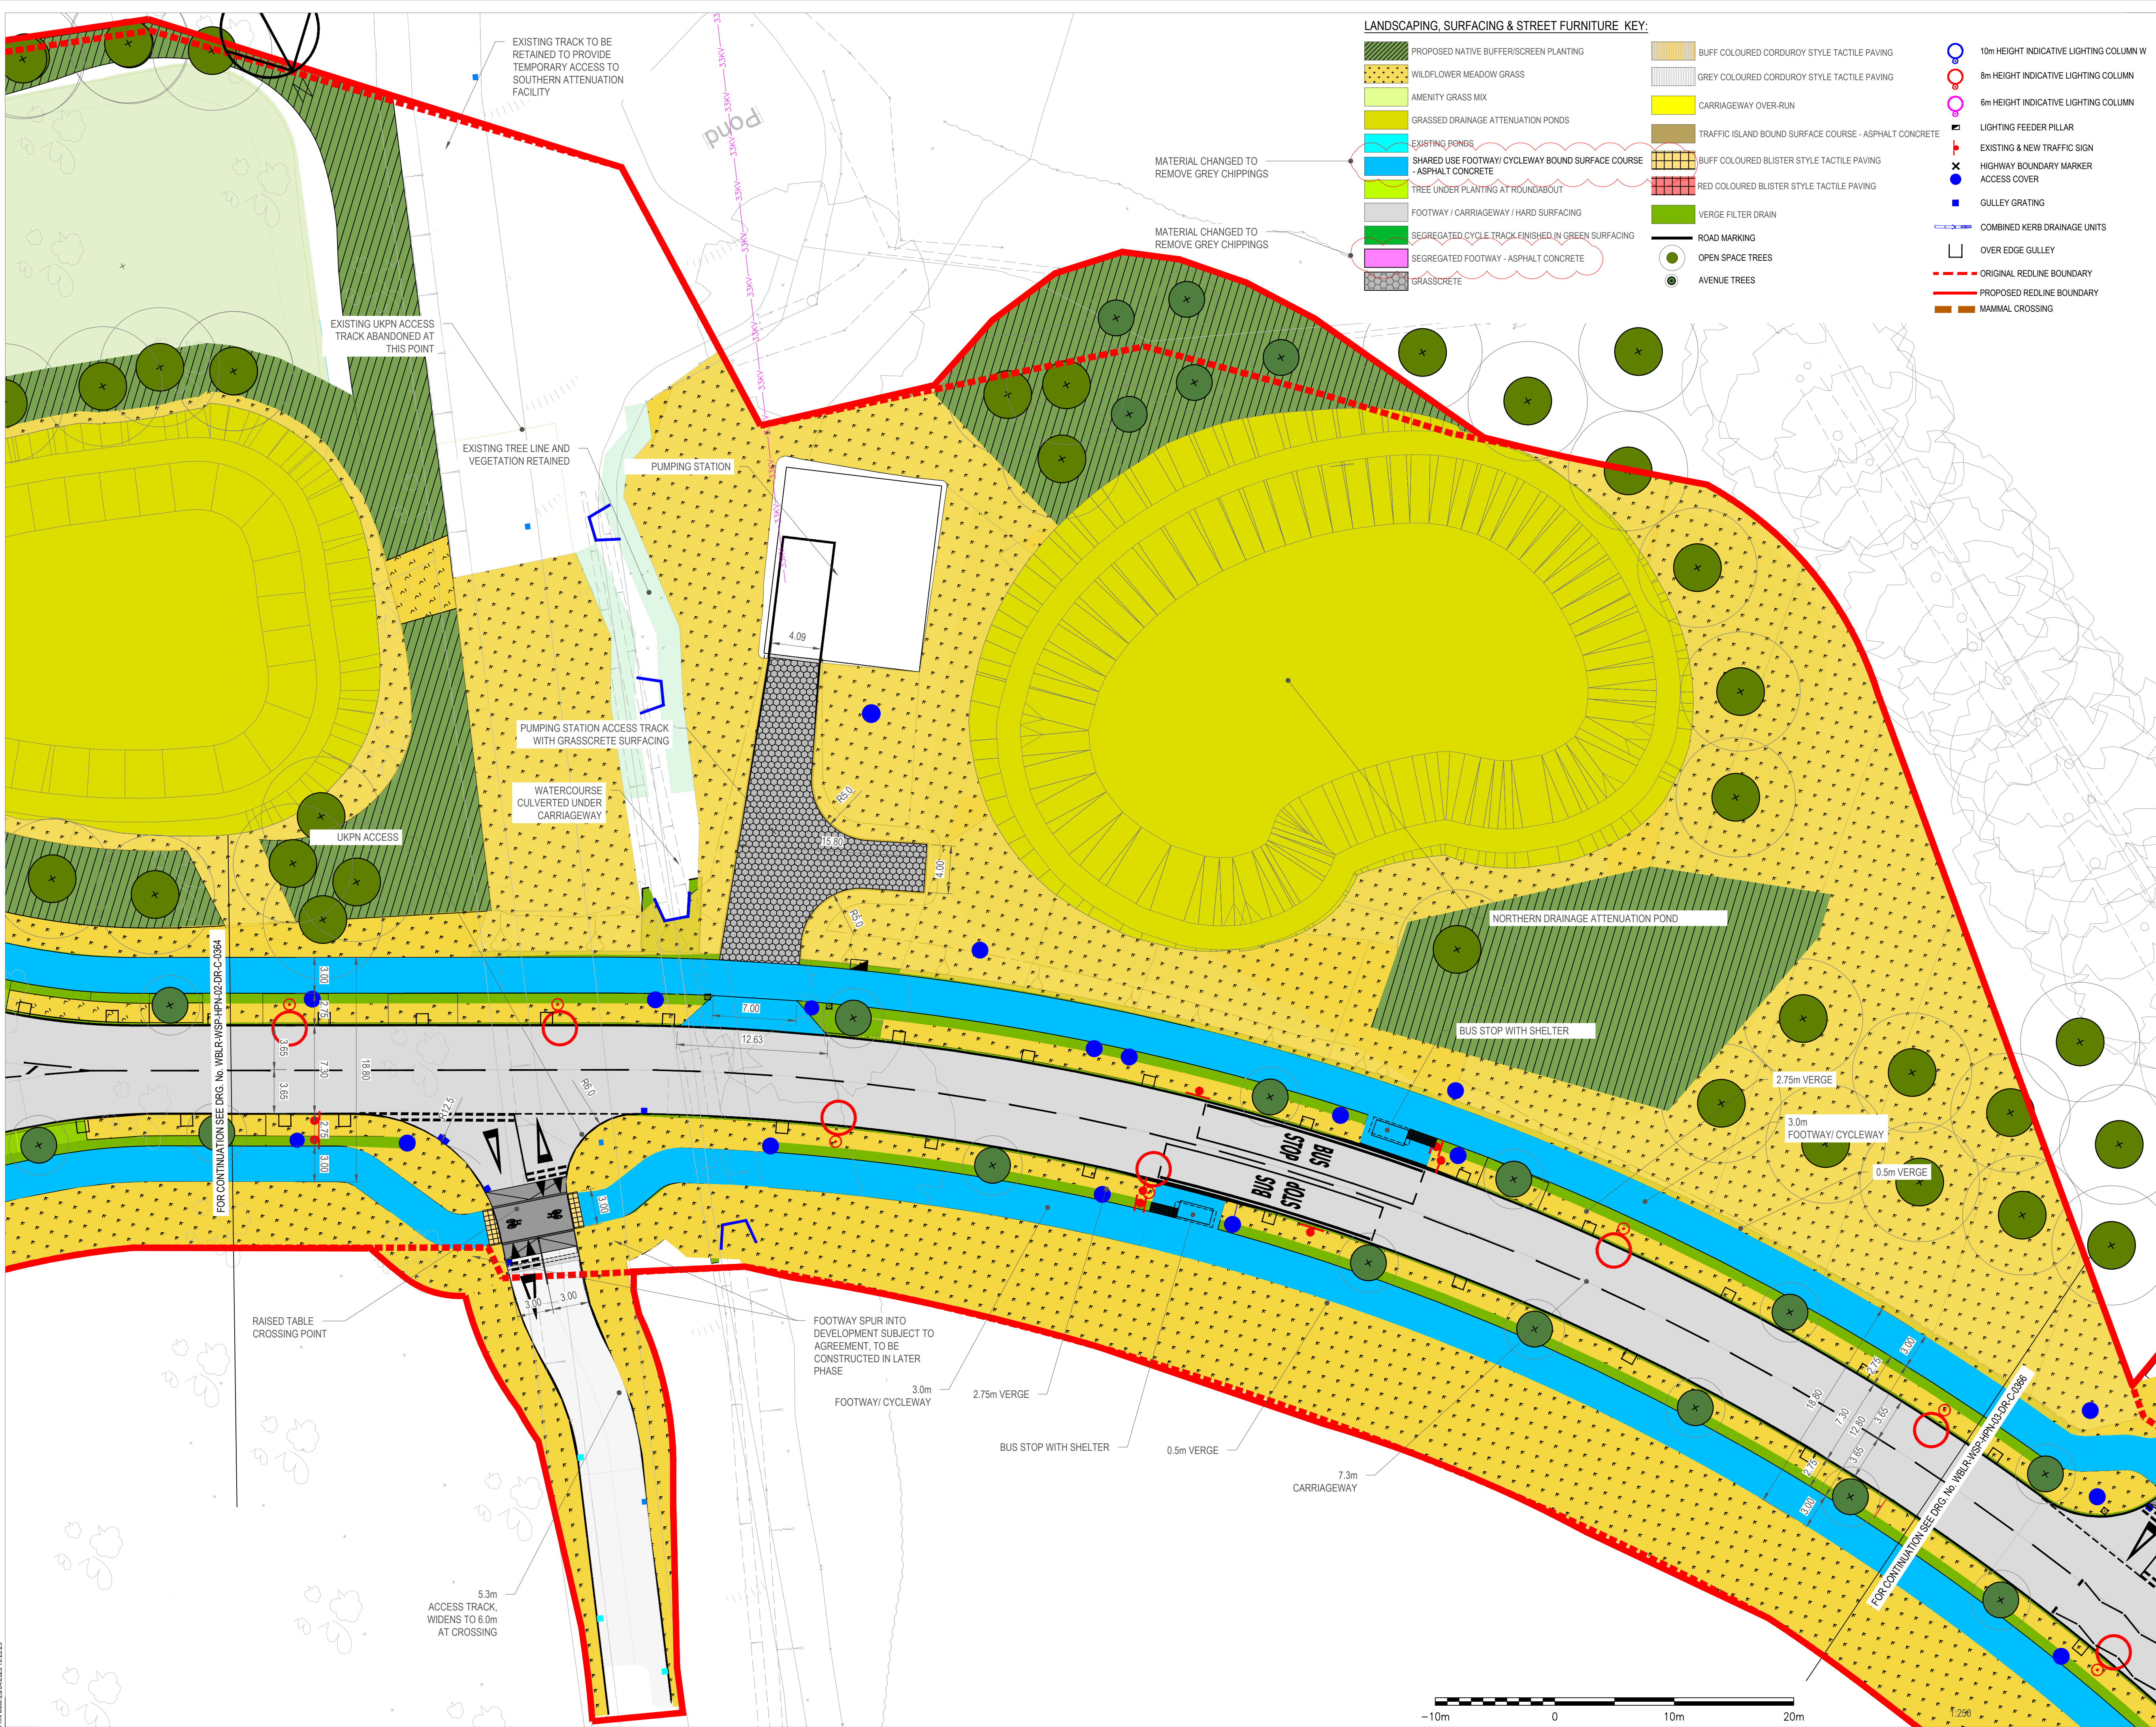


LANDSCAPING, SURFACING & STREET FURNITURE KEY:

- PROPOSED NATIVE BUFFERSCREEN PLANTING
- WILDFLOWER MEADOW GRASS
- AMENITY GRASS MIX
- GRASSED DRAINAGE ATTENUATION PONDS
- EXISTING PONDS
- SHARED USE FOOTWAY/CYCLEWAY BOUND SURFACE COURSE - ASPHALT CONCRETE
- TREE UNDER PLANTING AT ROUNDABOUT
- FOOTWAY / CARRIAGEWAY / HARD SURFACING
- SEGREGATED CYCLE TRACK FINISHED IN GREEN SURFACING
- SEGREGATED FOOTWAY - ASPHALT CONCRETE
- GRASSCRETE
- BUFF COLOURED CORDUROY STYLE TACTILE PAVING
- GREY COLOURED CORDUROY STYLE TACTILE PAVING
- CARRIAGEWAY OVER-RUN
- TRAFFIC ISLAND BOUND SURFACE COURSE - ASPHALT CONCRETE
- BUFF COLOURED BLISTER STYLE TACTILE PAVING
- RED COLOURED BLISTER STYLE TACTILE PAVING
- VERGE FILTER DRAIN
- ROAD MARKING
- OPEN SPACE TREES
- AVENUE TREES
- 10m HEIGHT INDICATIVE LIGHTING COLUMN W
- 8m HEIGHT INDICATIVE LIGHTING COLUMN
- 6m HEIGHT INDICATIVE LIGHTING COLUMN
- LIGHTING FEEDER PILLAR
- EXISTING & NEW TRAFFIC SIGN
- HIGHWAY BOUNDARY MARKER
- ACCESS COVER
- GULLEY GRATING
- COMBINED KERB DRAINAGE UNITS
- OVER EDGE GULLEY
- ORIGINAL REDLINE BOUNDARY
- PROPOSED REDLINE BOUNDARY
- MAMMAL CROSSING

- NOTES:
- ALL DIMENSIONS IN METRES UNLESS OTHERWISE STATED.
 - REFER TO DRAINAGE DRAWINGS FOR DETAILS OF ATTENUATION PONDS.

Location Key Plan (Not to Scale)

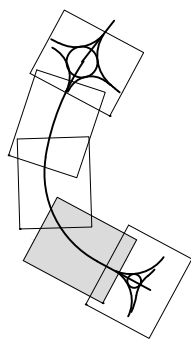

Rev	Drwn	Chkd	Appd	Description	Date
P05	AS	GL	AJB	REVISION EXPLANATORY NOTES ADDED	25.04.2025
P04	AS	GL	AJB	BRIDLEWAY REMOVED FROM KEY	16.04.2025
P03	AS	GL	AJB	FOOTWAY/CYCLEWAY NOTES AMENDED	24.03.2025
P02	AS	GL	AJB	GREY CHIPPINGS REMOVED FROM FOOTPATH FINISH	25.11.24
P01	PD	DAH	AJB	FIRST ISSUE	08.06.23

Purpose of Issue
For Planning
Status
S0

Classification
Public



Project
**Western Bridge Link Road
Burgess Hill**

Drawing
**S73
PLANNING AMENDMENTS
GENERAL ARRANGEMENT
SHEET 2 of 5**

Scale @ A1	Drawn	Checked	Approved
1:250	PD	DAH	AJB

Project No.	Date
CS100377	12-05-23

Drawing Identifier	BS1192 Compliant
Project - Originator - Zone - Level - File Type - Role - Number	revision
WBLR-WSP-HPN-03-DR-C-0365	P05

