


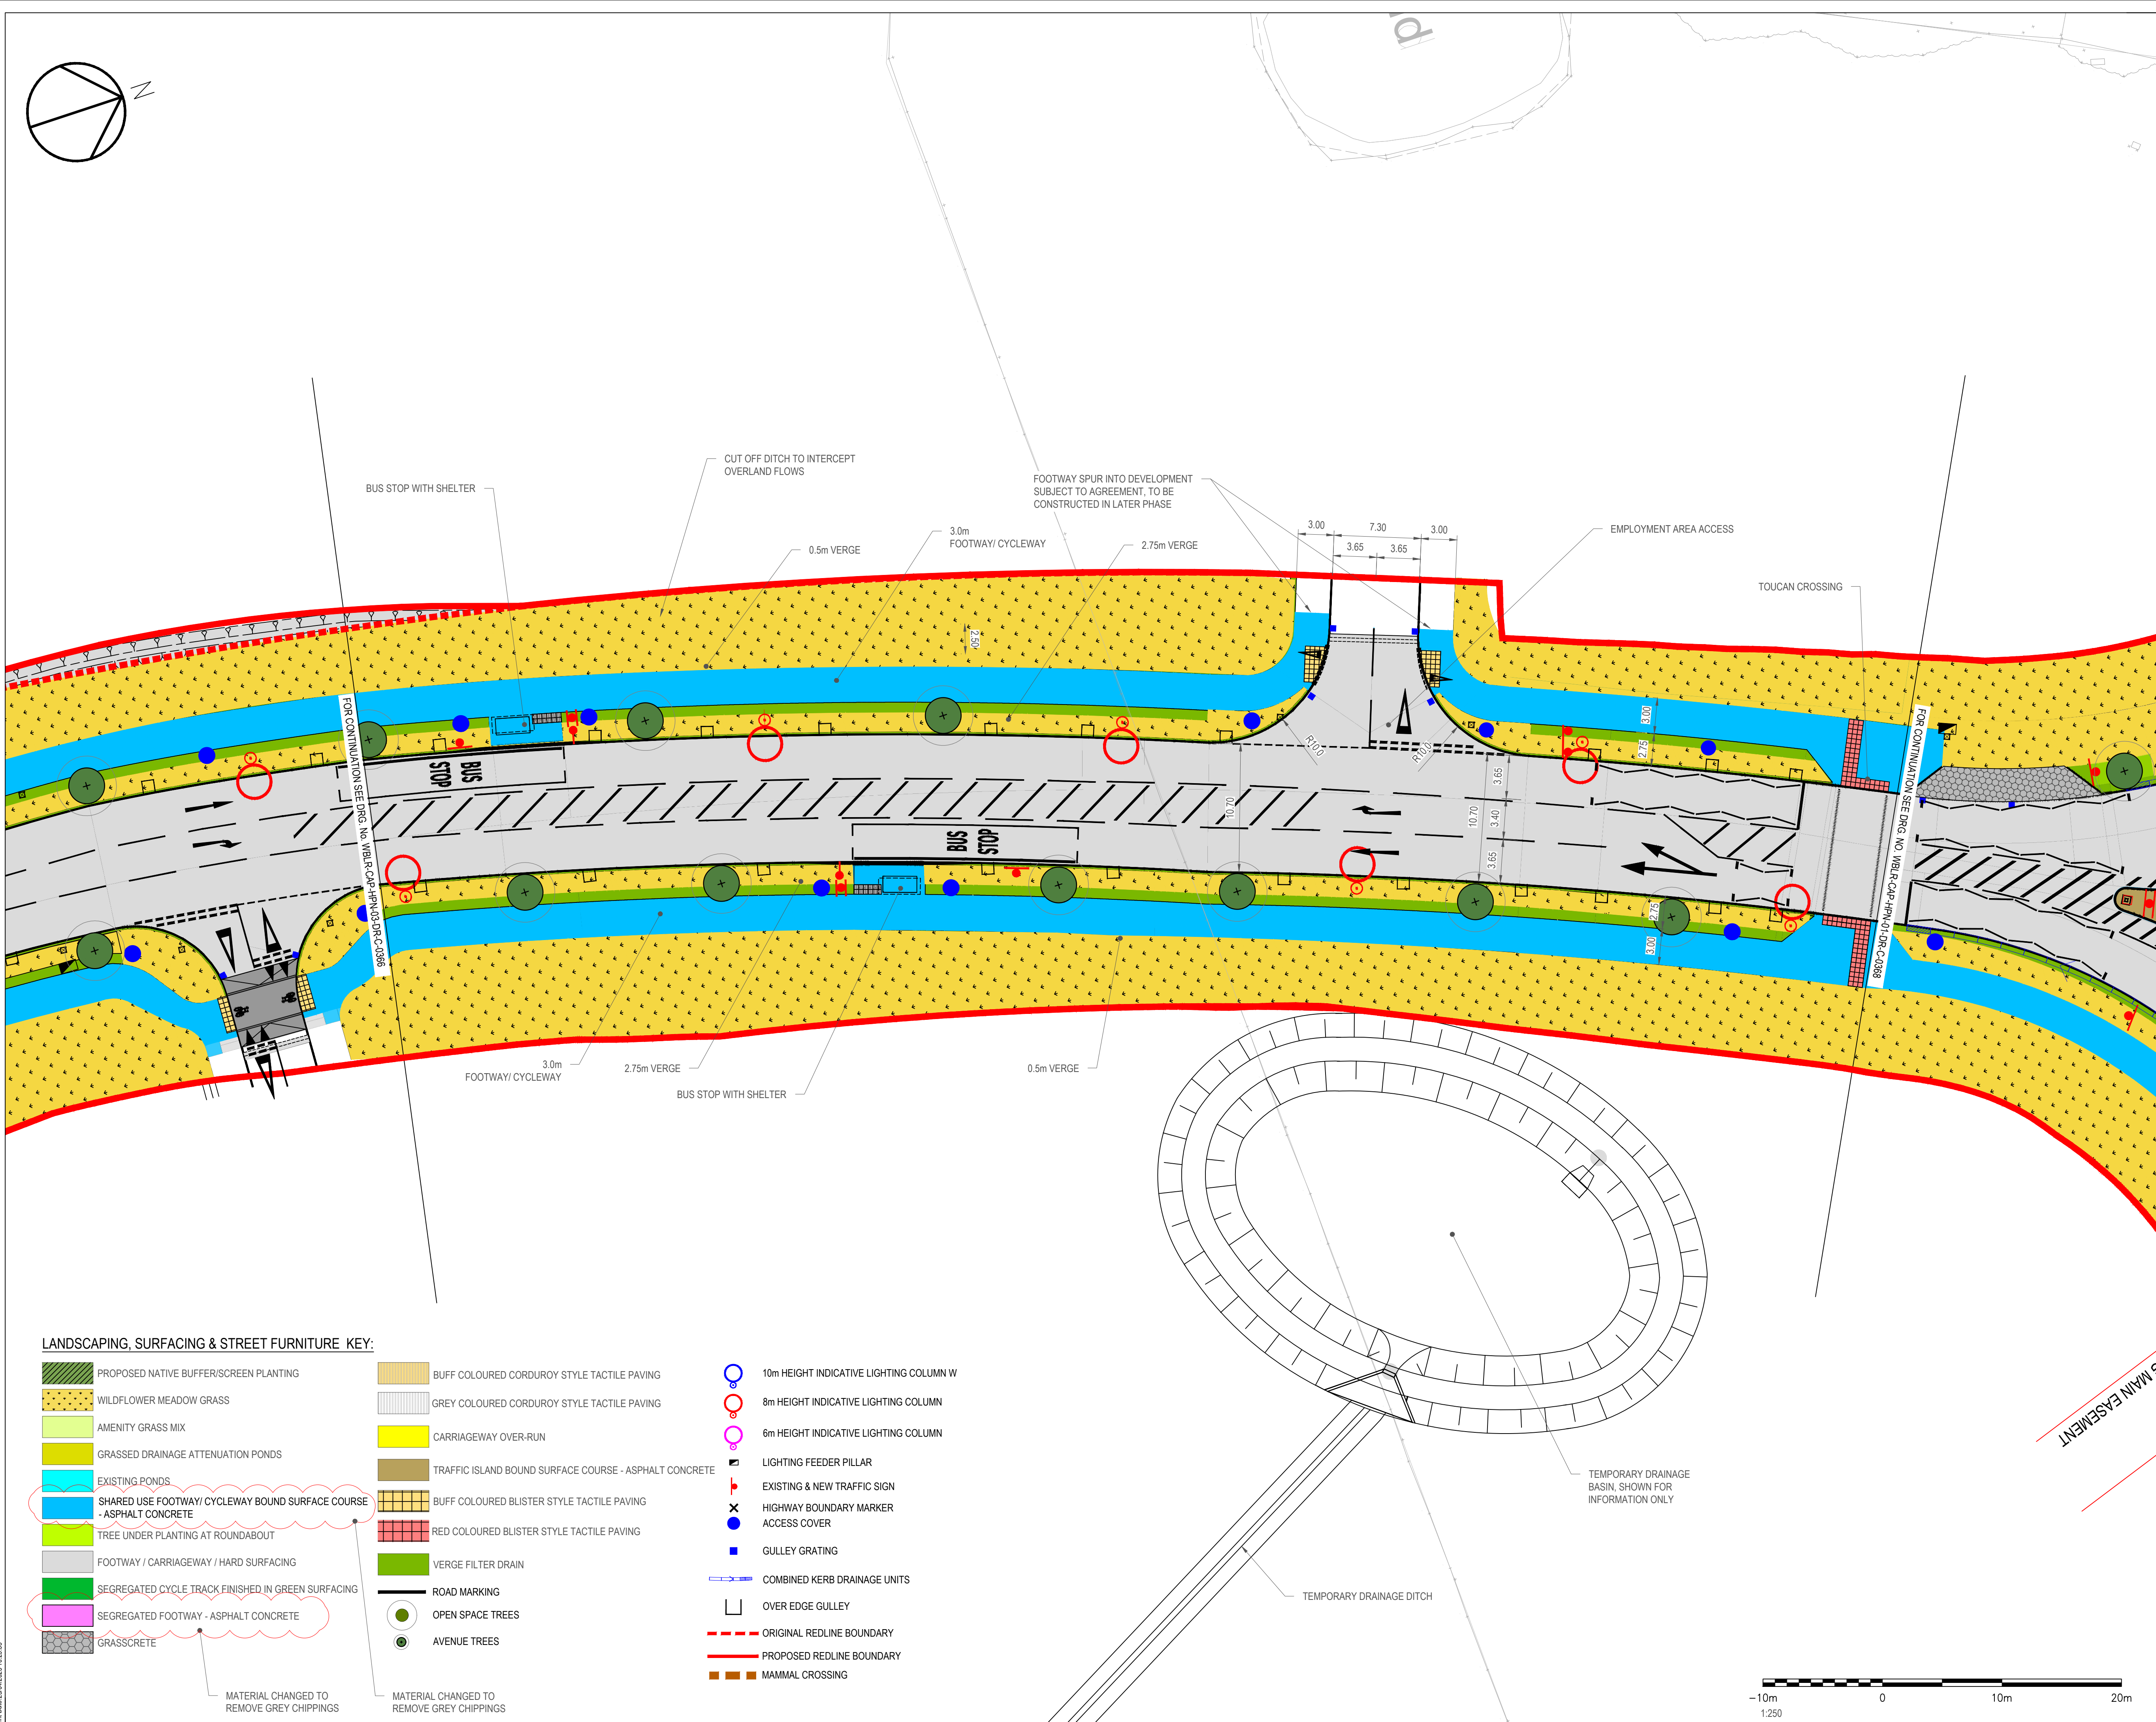

LANDSCAPING, SURFACING & STREET FURNITURE KEY:

- PROPOSED NATIVE BUFFER/SCREEN PLANTING

WILDFLOWER MEADOW GRASS

AMENITY GRASS MIX

GRASSED DRAINAGE ATTENUATION PONDS

EXISTING PONDS

SHARED USE FOOTWAY/ CYCLEWAY BOUND SURFACE COURSE - ASPHALT CONCRETE

TREE UNDER PLANTING AT ROUNDABOUT

FOOTWAY / CARRIAGEWAY / HARD SURFACING

SEGREGATED CYCLE TRACK FINISHED IN GREEN SURFACING

SEGREGATED FOOTWAY - ASPHALT CONCRETE

GRASSCRETE
- BUFF COLOURED CORDUROY STYLE TACTILE PAVING

GREY COLOURED CORDUROY STYLE TACTILE PAVING

CARRIAGEWAY OVER-RUN

TRAFFIC ISLAND BOUND SURFACE COURSE - ASPHALT CONCRETE

BUFF COLOURED BLISTER STYLE TACTILE PAVING

RED COLOURED BLISTER STYLE TACTILE PAVING

VERGE FILTER DRAIN

ROAD MARKING

OPEN SPACE TREES

AVENUE TREES
- 10m HEIGHT INDICATIVE LIGHTING COLUMN W

8m HEIGHT INDICATIVE LIGHTING COLUMN

6m HEIGHT INDICATIVE LIGHTING COLUMN

LIGHTING FEEDER PILLAR

EXISTING & NEW TRAFFIC SIGN

HIGHWAY BOUNDARY MARKER

ACCESS COVER

GULLEY GRATING

COMBINED KERB DRAINAGE UNITS

OVER EDGE GULLEY

ORIGINAL REDLINE BOUNDARY


PROPOSED REDLINE BOUNDARY

MAMMAL CROSSING

MATERIAL CHANGED TO REMOVE GREY CHIPPINGS

MATERIAL CHANGED TO REMOVE GREY CHIPPINGS

- NOTES:
1. ALL DIMENSIONS IN METRES UNLESS OTHERWISE STATED.
 2. REFER TO DRAINAGE DRAWINGS FOR DETAILS OF ATTENUATION PONDS.

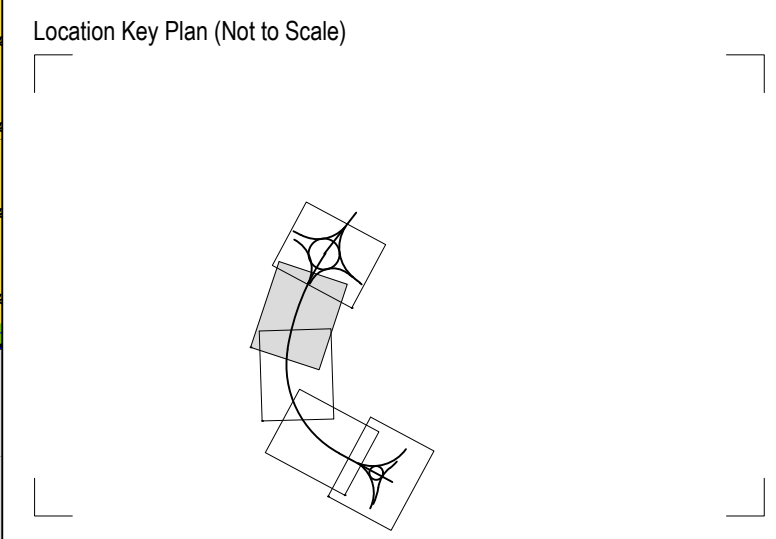

Rev	Drwn	Chkd	Appd	Description	Date
P05	AS	GL	AJB	REVISION EXPLANATORY NOTES ADDED	25.04.2025
P04	AS	GL	AJB	BRIDLEWAY REMOVED FROM KEY	16.04.2025
P03	AS	GL	AJB	FOOTWAY/CYCLEWAY MINUTES AMENDED	24.03.2025
P02	AS	GL	AJB	GREY CHIPPINGS REMOVED FROM FOOTPATH FINISH	26.11.24
P01	PD	DAH	AJB	FIRST ISSUE	08.06.23

Purpose of Issue
For Planning

Classification
Public

Client

Project
Western Bridge & Link Road
Burgess Hill

Drawing
SECTION 73
PLANNING AMENDMENTS
GENERAL ARRANGEMENT
SHEET 4 of 5

Scale @ A1	Drawn	Checked	Approved
SECTION 73	PD	DAH	AJB

Project No.	Date
CS100377	12-05-25

Drawing Identifier	BS1192 Compliant revision
Project - Originator - Zone - Level - File Type - Role - Number WBLR-CAP-HPN-03-DR-C-0367	P05

East Grinstead House,
Wood Street,
East Grinstead,
West Sussex,
RH19 1UU

www.wsp.com
WSP in the UK