





Approved West Elevation
Scale 1:25@A1
1:50@A3

Metal spindles balustrade

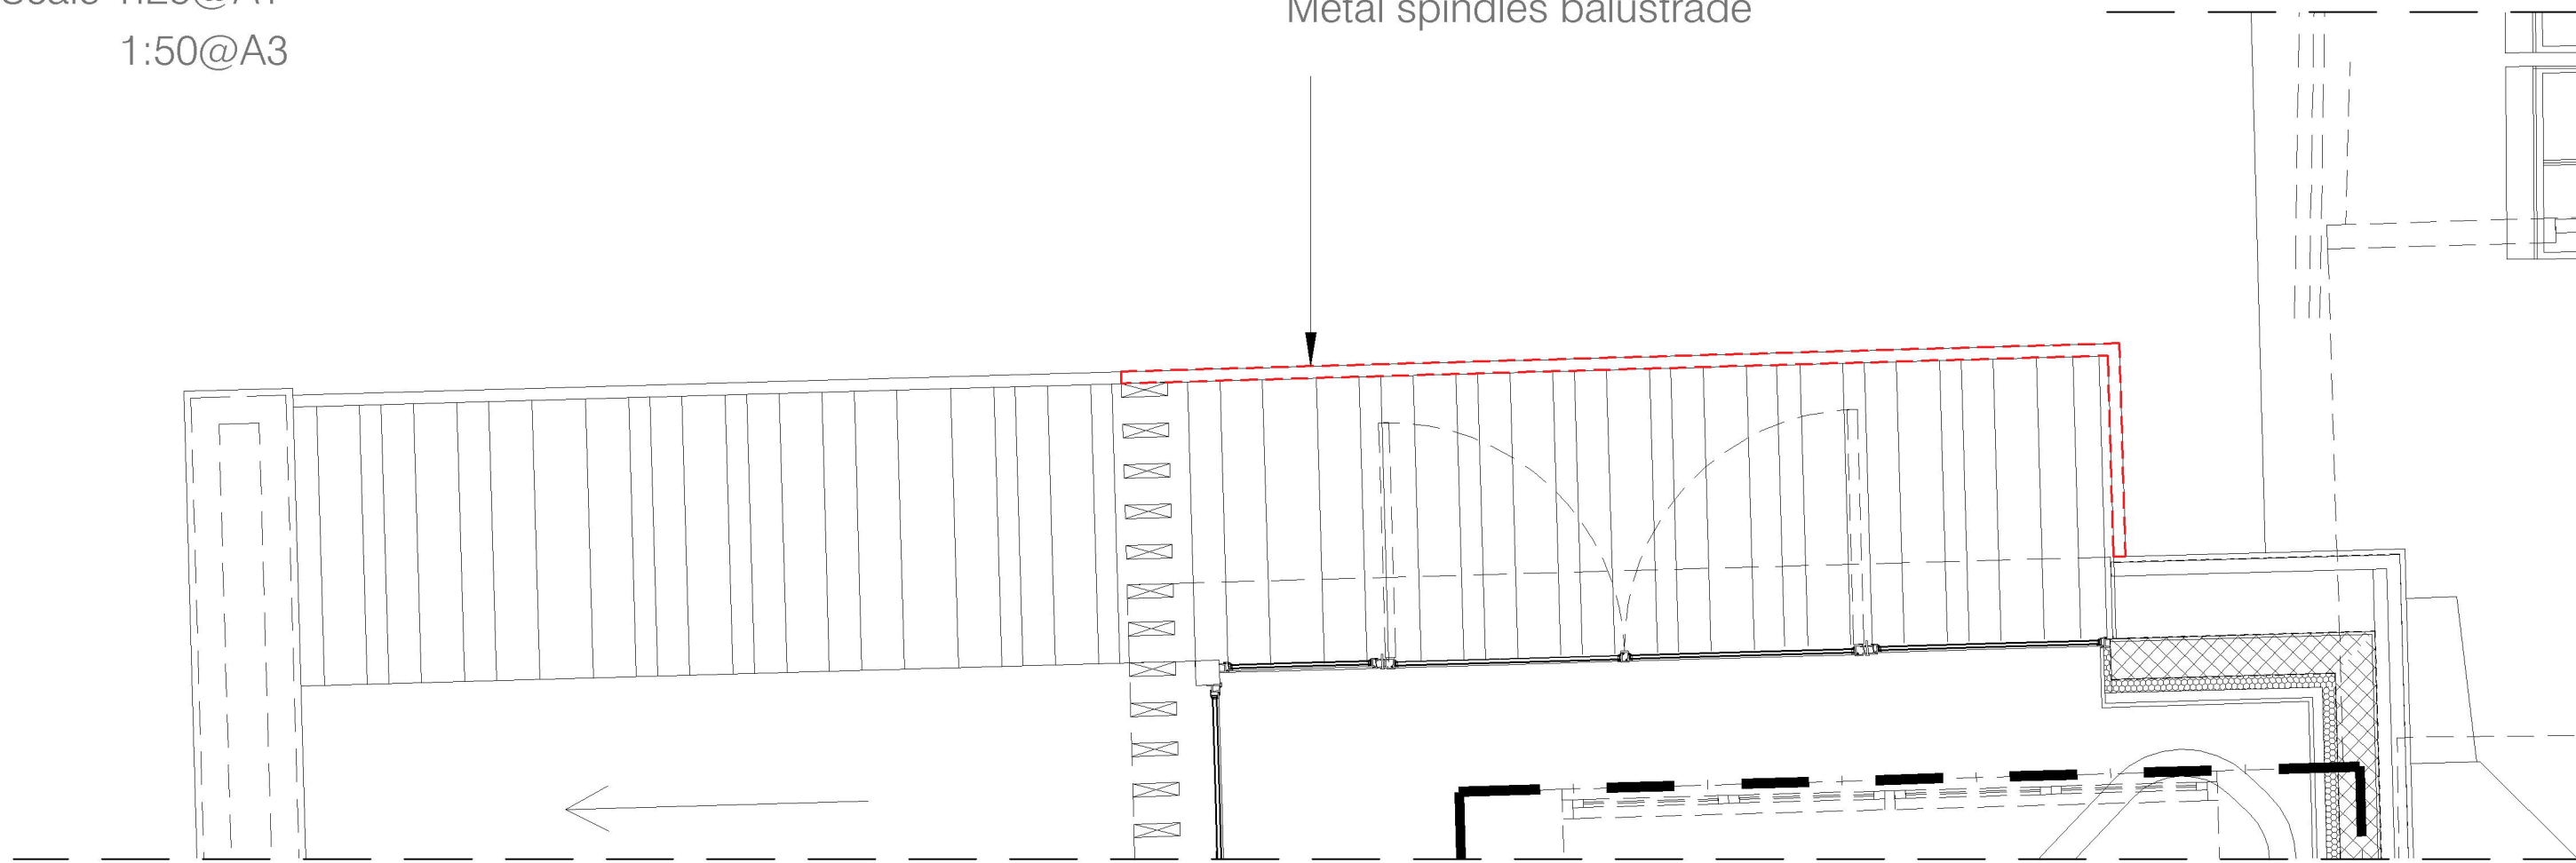


KEY
Approved First Floor Plan
Scale 1:25@A1
1:50@A3

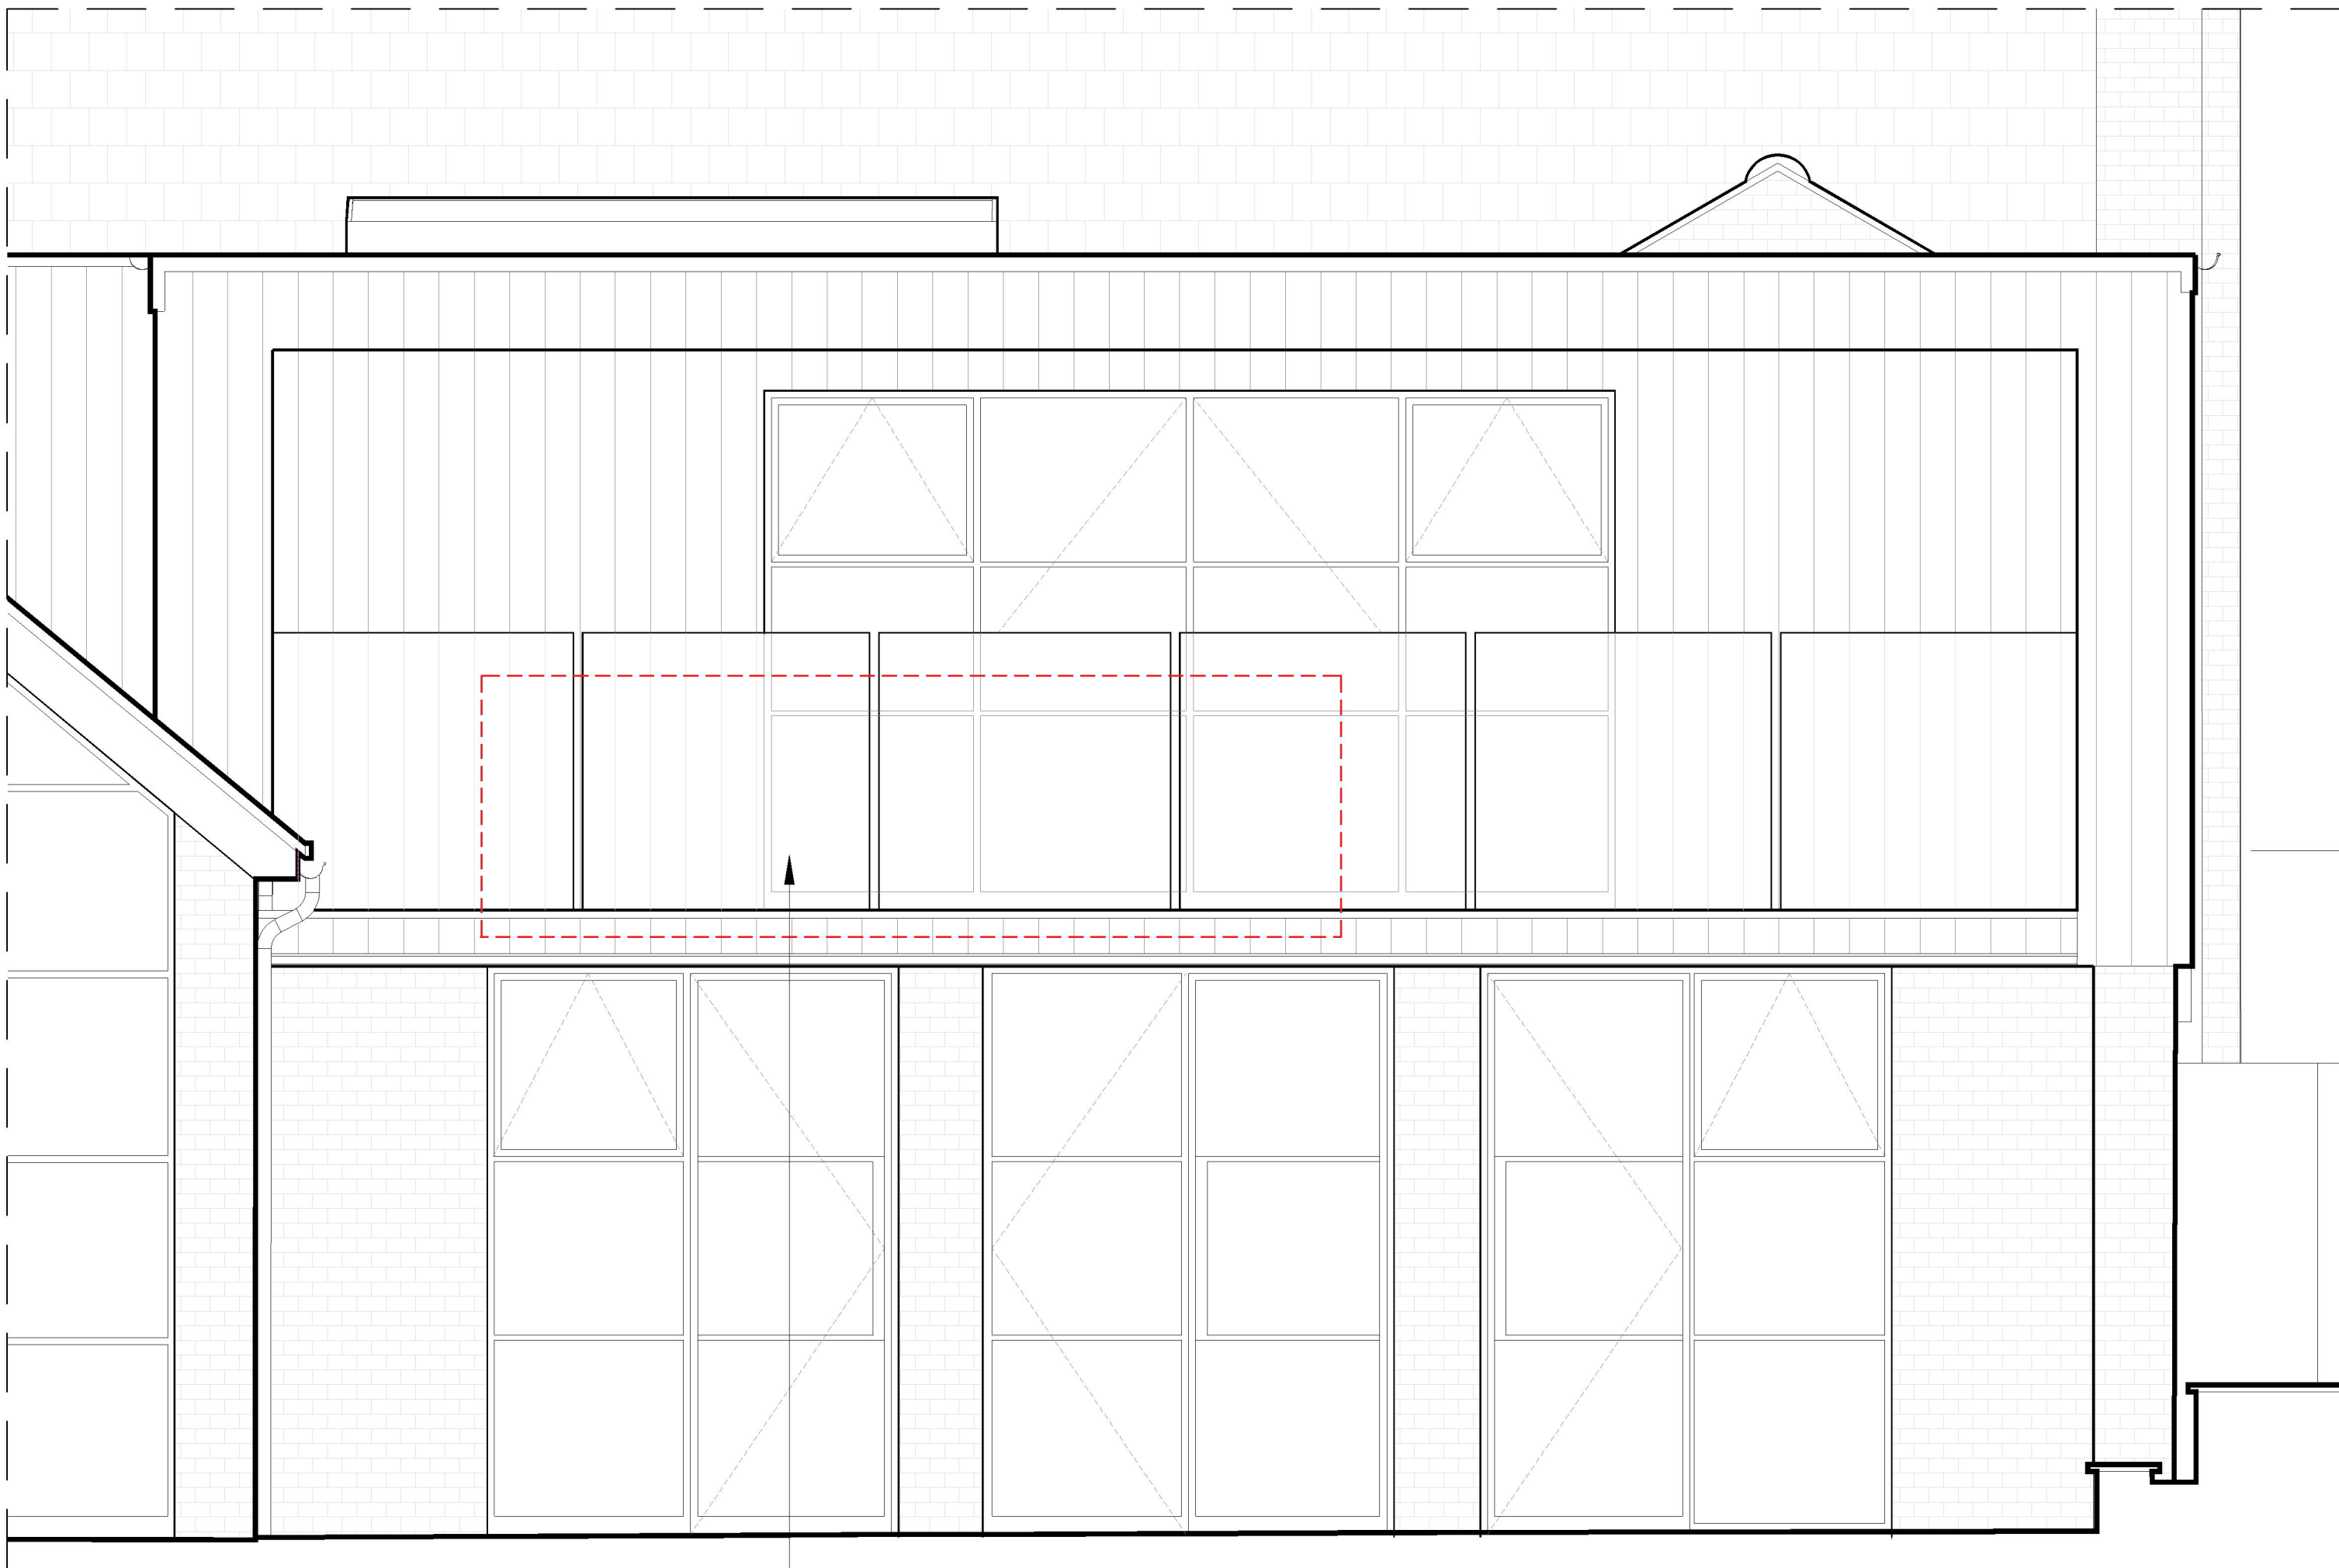

As Built / Proposed West Elevation
Scale 1:25@A1
1:50@A3

21.5mm toughened and laminated clear glass balustrade with bespoke fascia brackets and 50mm projection buttons by South Coast Steel Ltd. Refer to detail 5025.

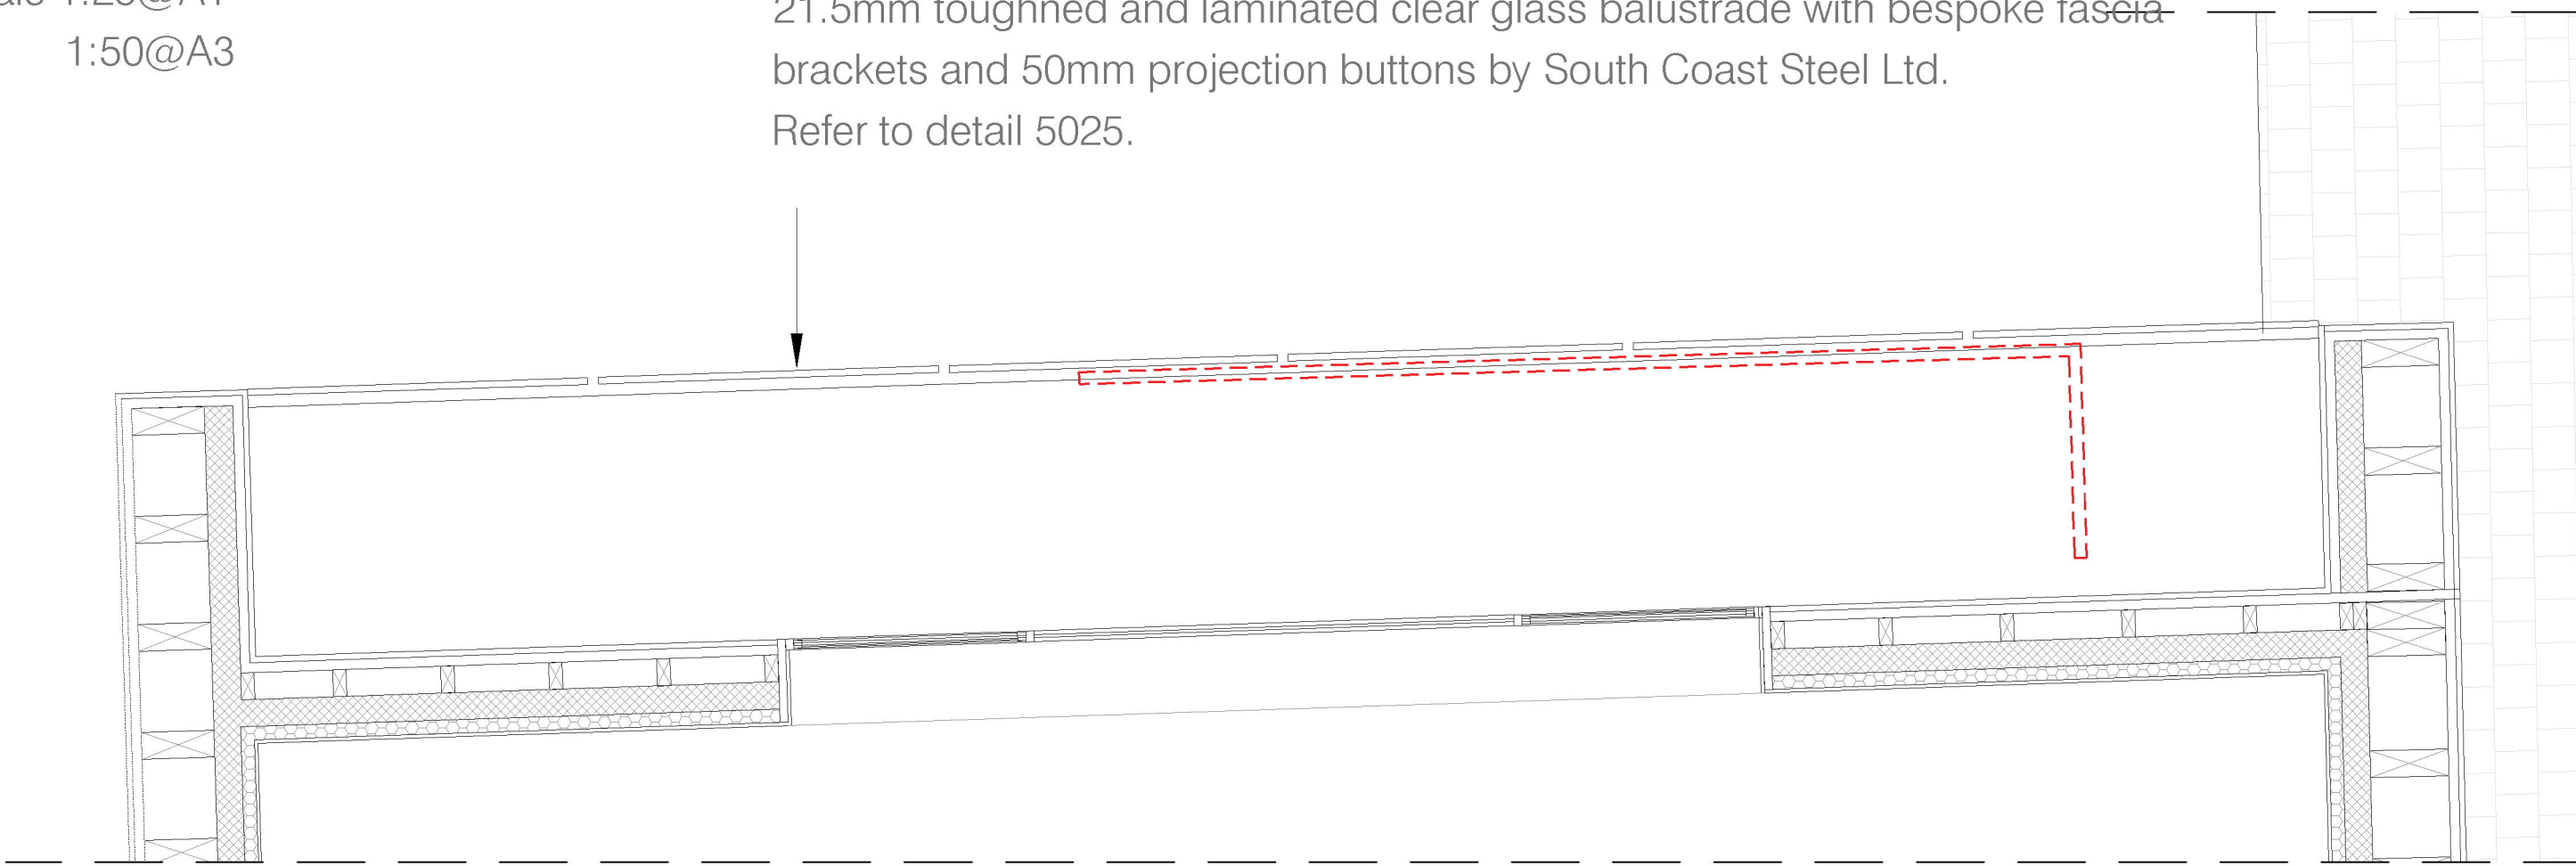

KEY
As Built / Proposed First Floor Plan
Scale 1:25@A1
1:50@A3

KEY:
Highlighted difference between Approved Scheme and 'As-Built'/Proposed Scheme

Rev: - Comments: - By: - Date: -				LISTED BUILDING CONSENT Client: Mr. Simon Dougall Project Title: 107 High St, Lindfield, Haywards Heath, West Sussex, RH16 2HR Drawing Title: Detail Drawings: Balustrade to terrace - Sheet 1 of 2 Scale: 1:25@A1 1:10@A1 1:50@A3				kyson Studio 28 Scrutton Street London UK EC2A 4RP T: +44(0) 20 7247 2462 E: enquiries@kyson.co.uk W: www.kyson.co.uk Project No.: 900-25			
Do not scale this drawing. All dimensions must be checked on site. All rights reserved. No reproduction in any material form is permitted without consent.				Date: Apr 25				Drawing No.: 5024			
				Drawn: KN				Checked: KW			
								Revision: -			