



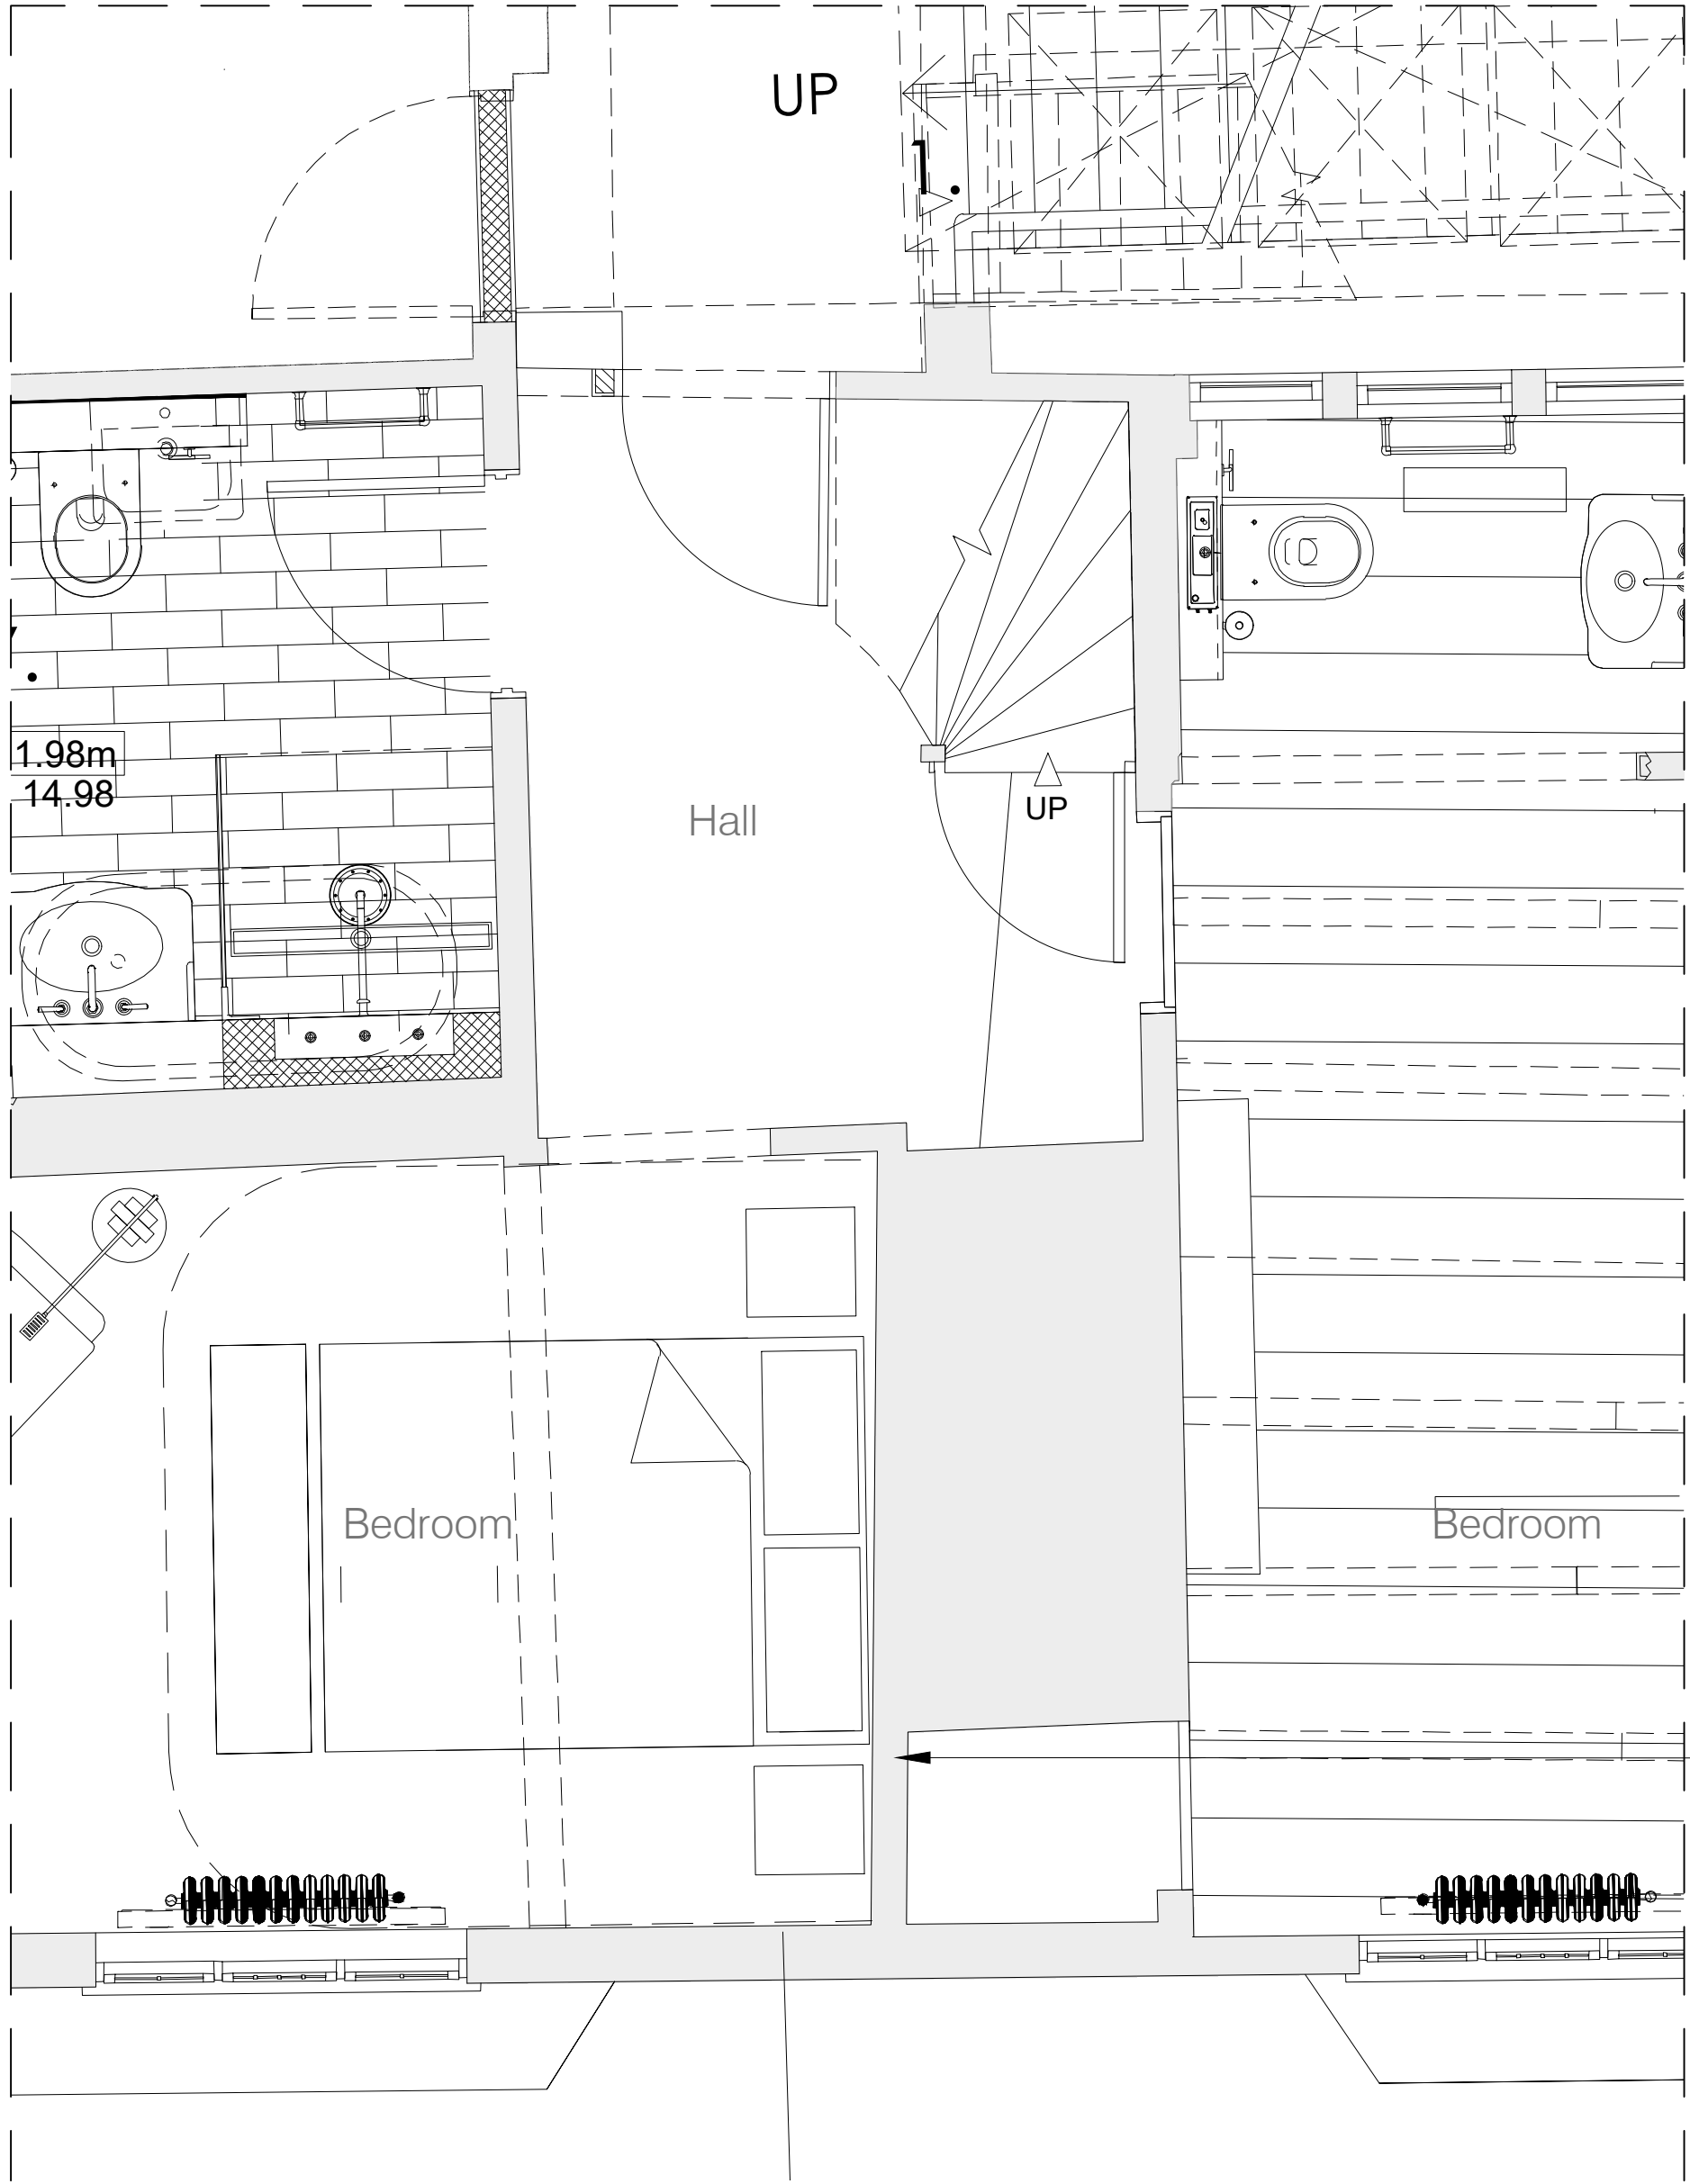

Approved Scheme First Floor Plan
Scale 1:25@A1
1:50@A3

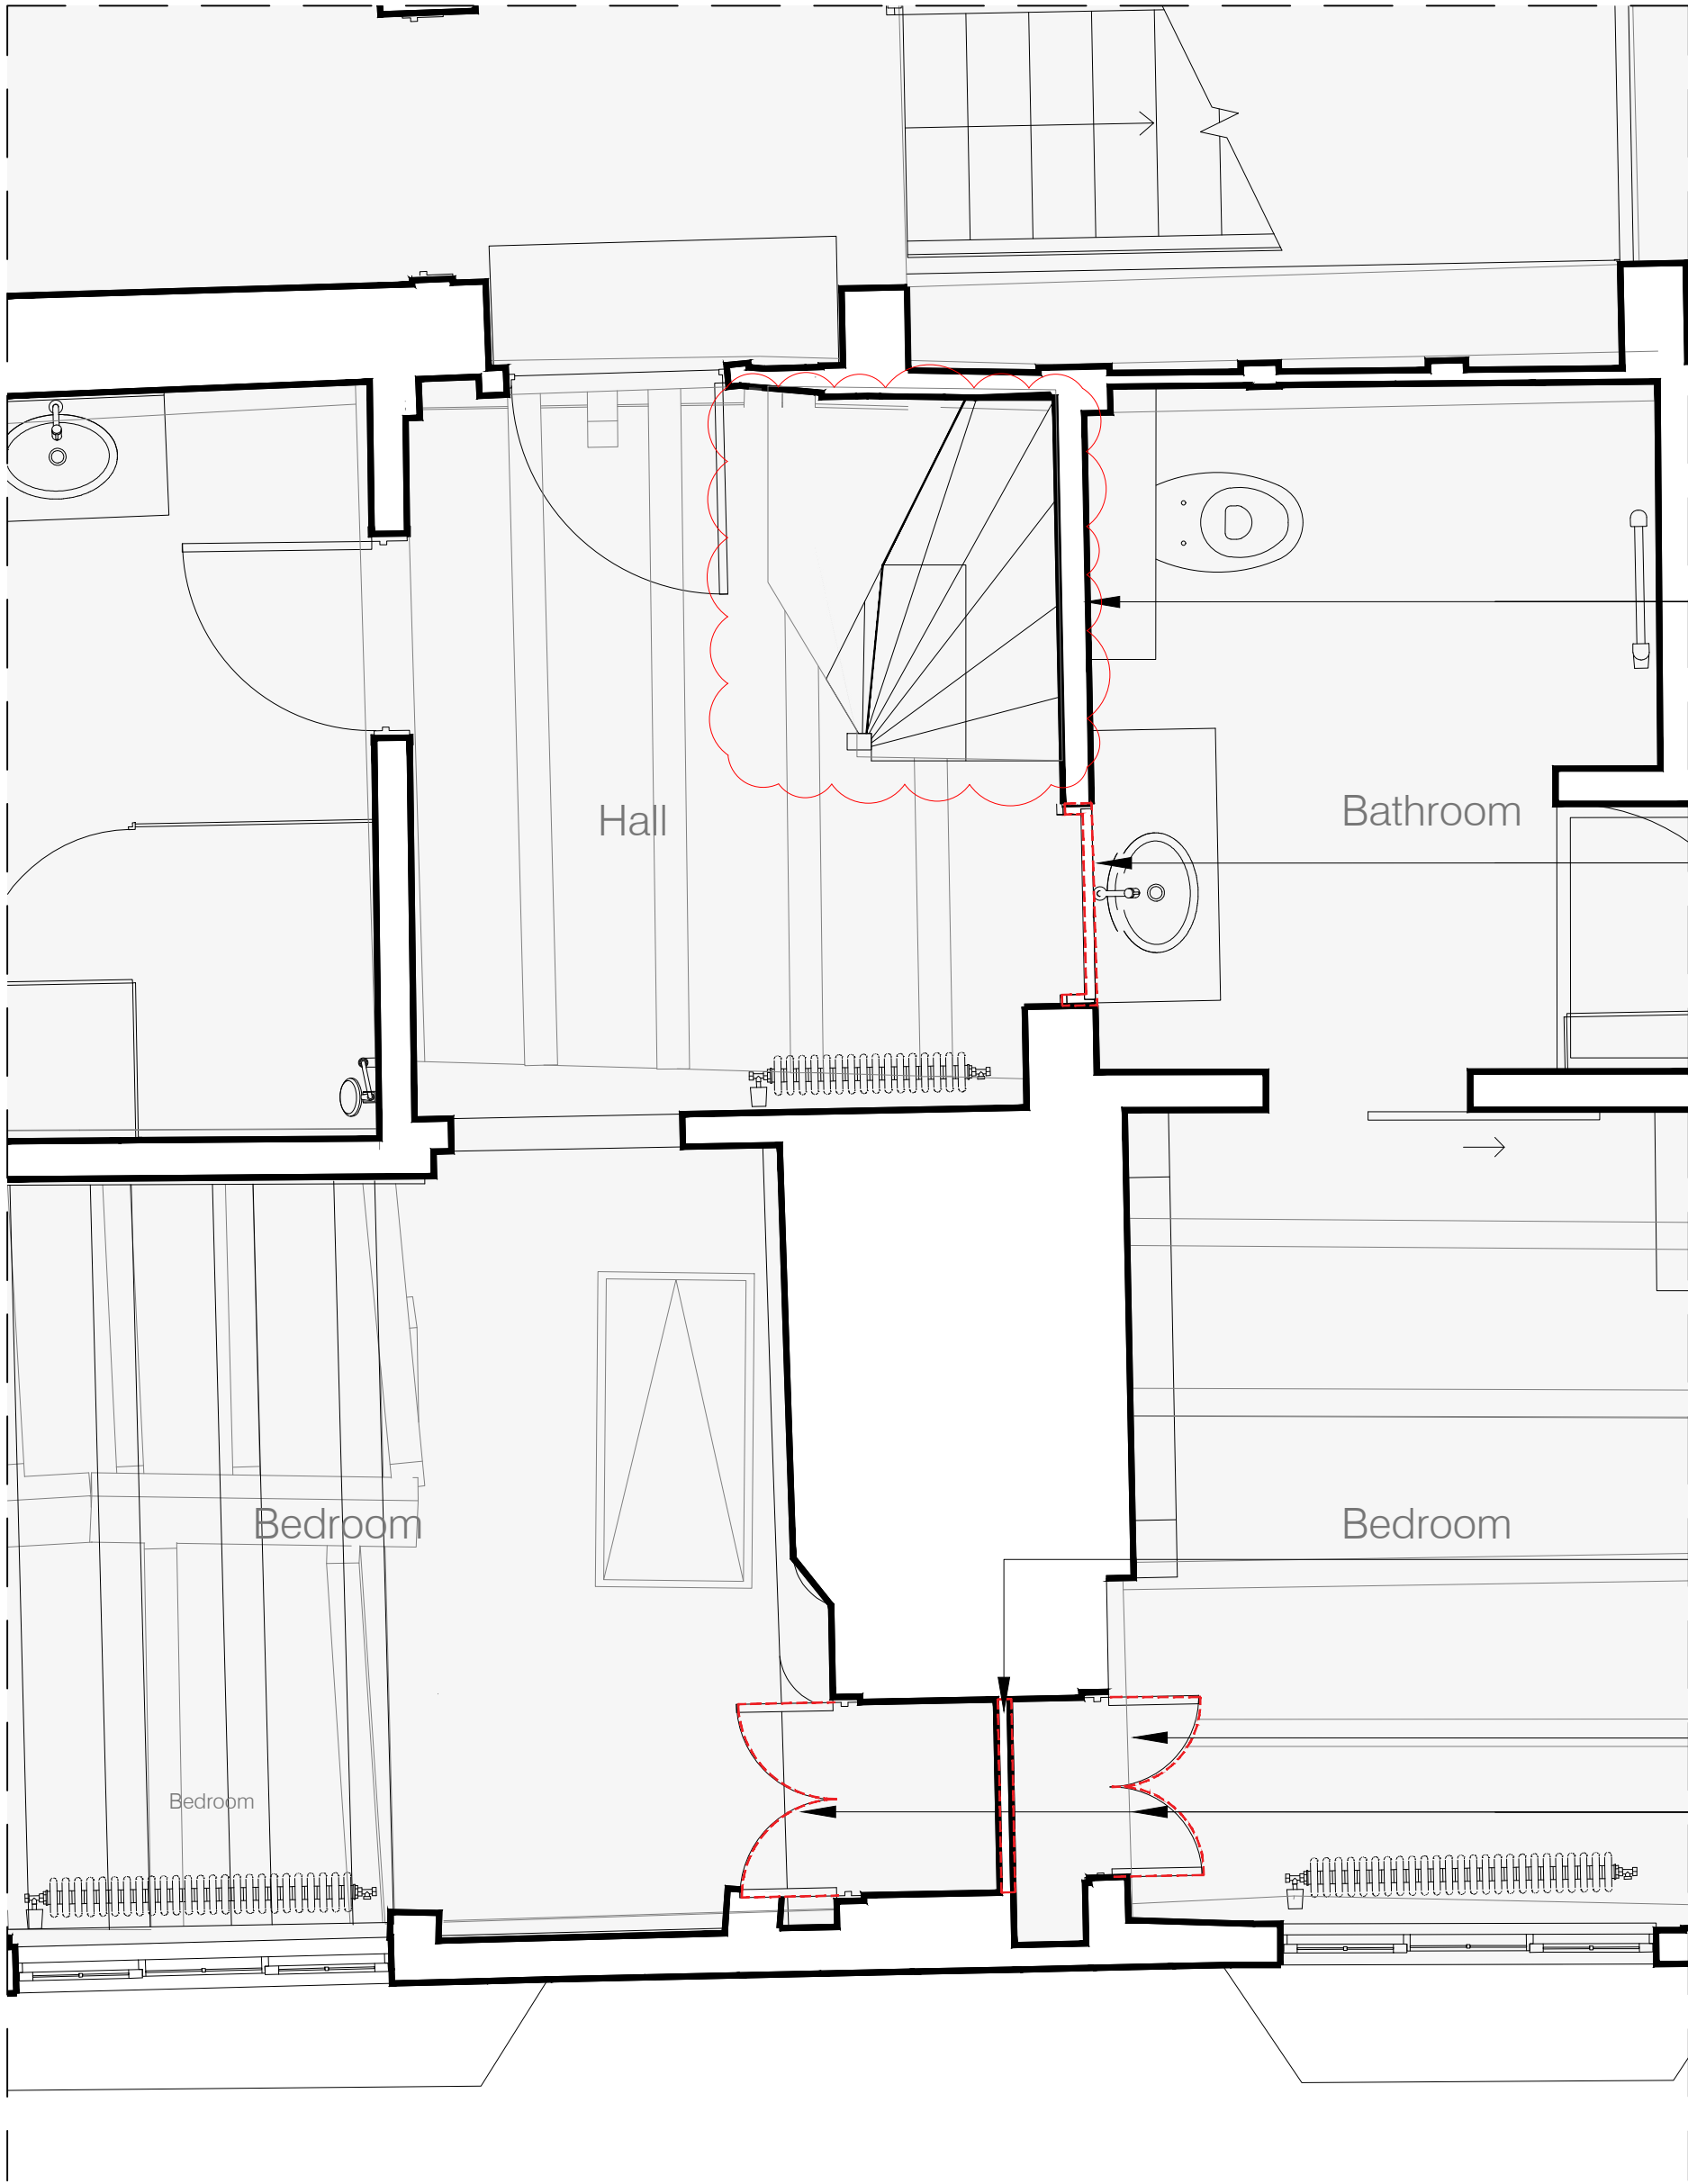


'As Built' / Proposed Scheme First Floor Plan
Scale 1:25@A1
1:50@A3



Fitted Wardrobe, view from North bedroom



Existing timber door to be re-instated and fixed shut

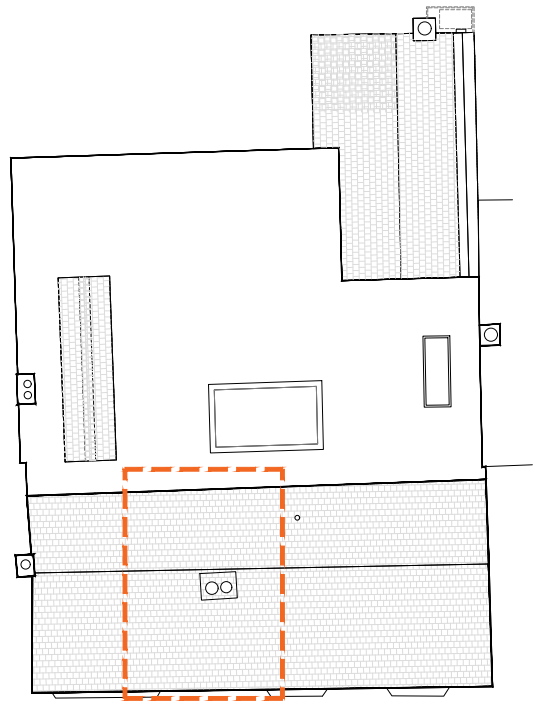

KEY PLAN
Scale 1:200@A1
1:400@A3

KEY:
Highlighted difference between Approved Scheme and 'As-Built'/Proposed Scheme

NOTE
DRAWINGS TO BE READ IN CONJUNCTION WITH SUBMITTED DESIGN&ACCESS STATEMENT AND HERITAGE STATEMENT MATERIALS INSTALLED IN ACCORDANCE WITH THOSE OUTLINED IN CONDITION #9 OF APPROVAL DM/23/1605

LISTED BUILDING
CONSENT

Rev.	Comments	By:	Date:
B	Amendments as clouded.	KN	Nov 25

Client:
Mr. Simon Dougall

Project Title:
107 High St, Lindfield, Haywards Heath, West Sussex, RH16 2HR

Drawing Title:
Fitted Wardrobes Joinery & Re-instated Door

Scale:	Date:	Drawn:	Checked:
1:25@A1 1:50@A3	Apr 25	KN	KW

kyson
Studio

28 Scrutton Street
London
UK
EC2A 4RP
T: +44(0) 20 7247 2462
E: enquiries@kyson.co.uk
W: www.kyson.co.uk

Project No.:	Drawing No.:	Revision:
900-25	5013	B

Do not scale this drawing. All dimensions must be checked on site.
All rights reserved. No reproduction in any material form is permitted without consent.

