



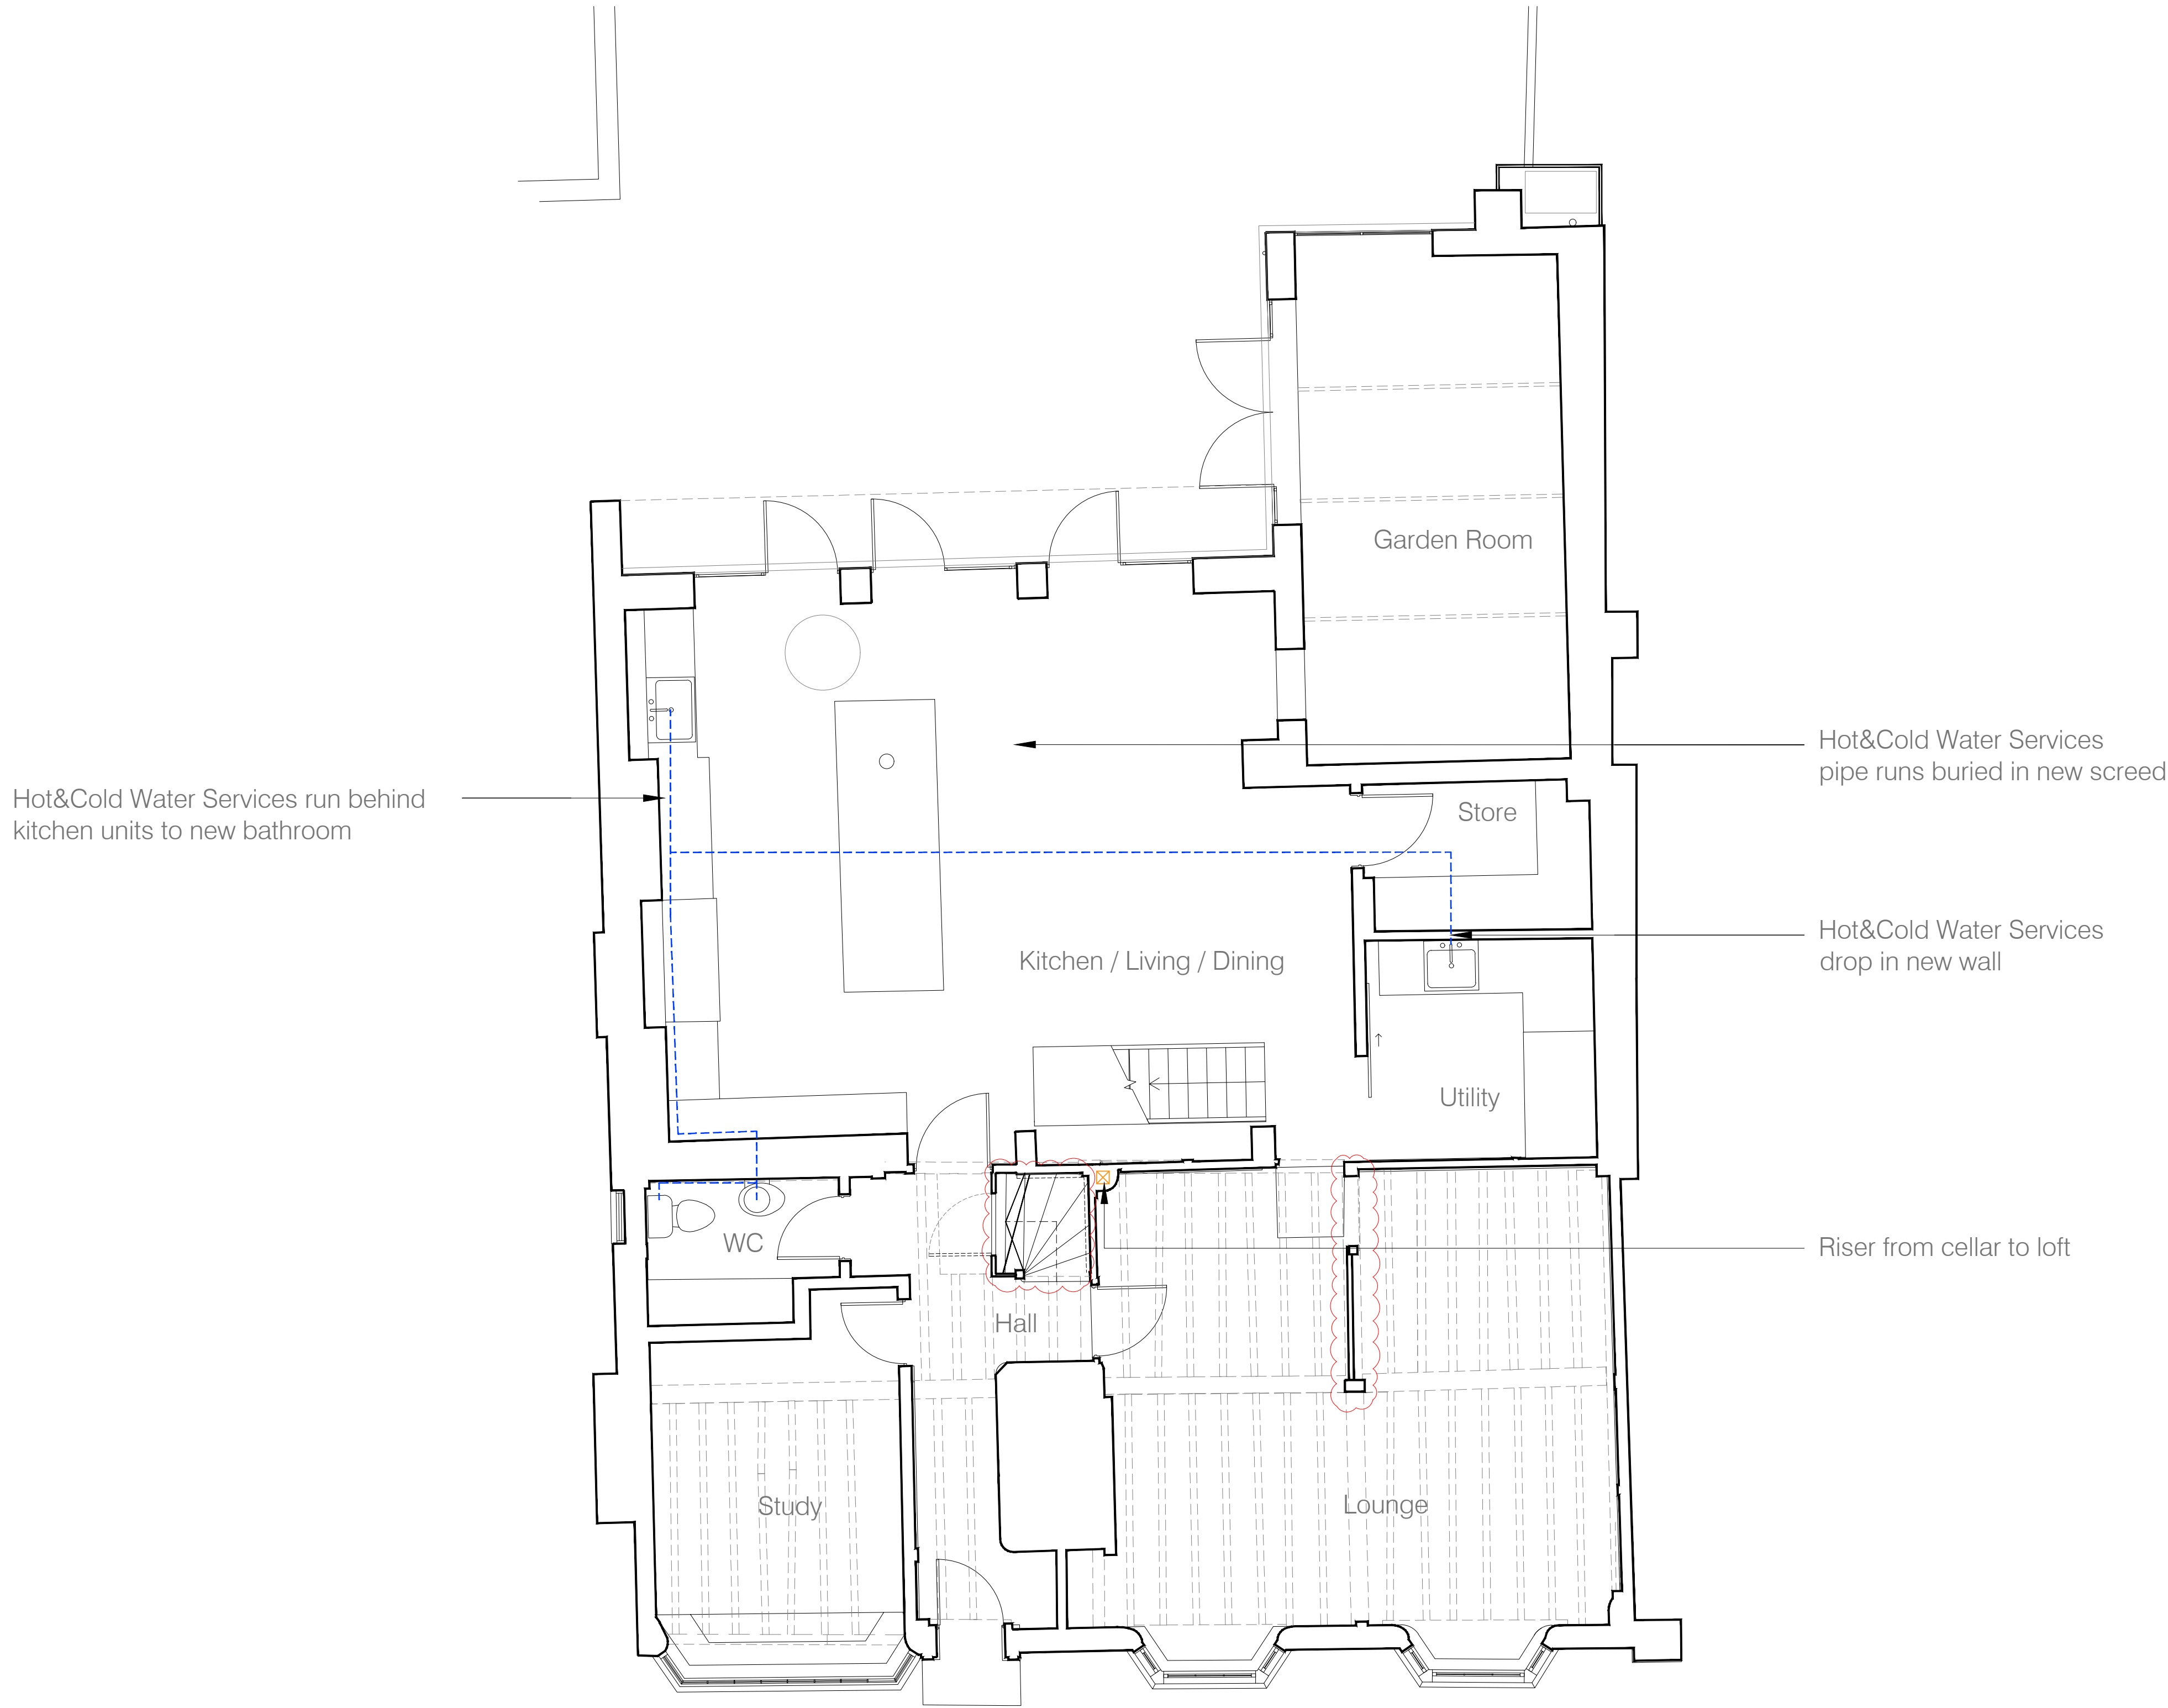


GROUND FLOOR PLAN
Scale 1:50@A1
1:100@A3

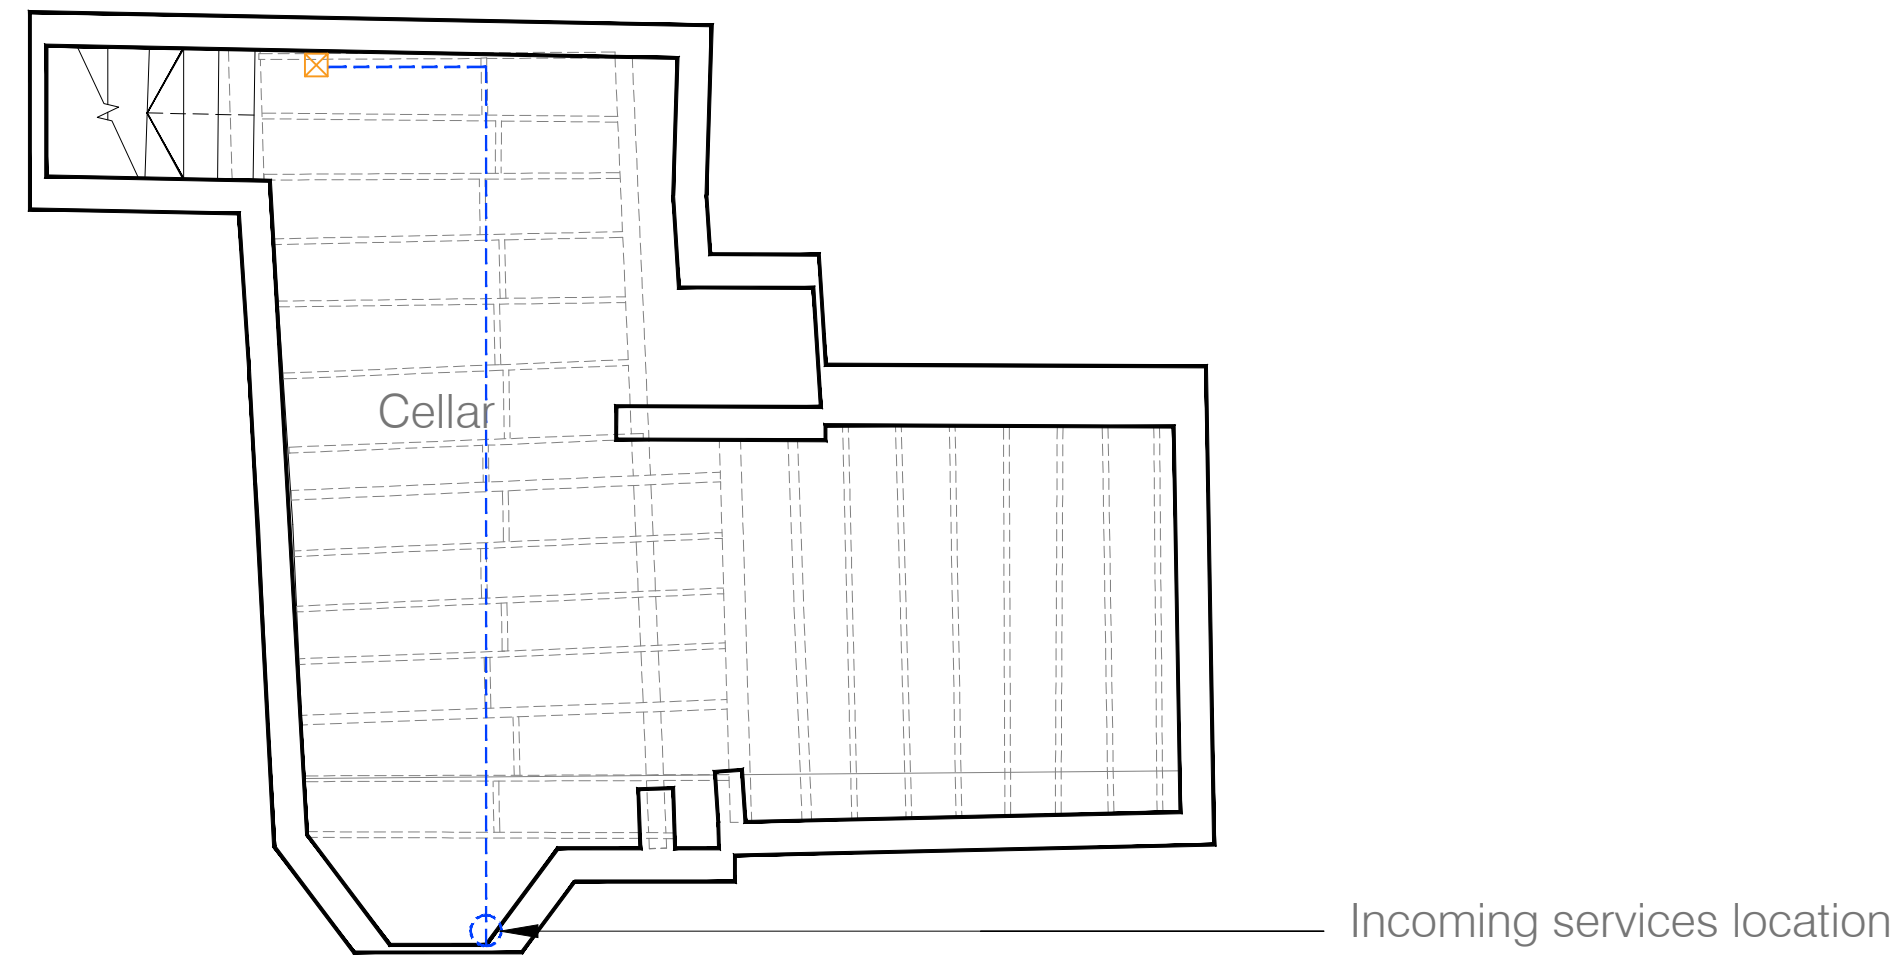

BASEMENT PLAN
Scale 1:50@A1
1:100@A3

NOTE
DRAWINGS TO BE READ IN CONJUNCTION WITH SUBMITTED
DESIGN&ACCESS STATEMENT AND HERITAGE STATEMENT

SERVICES INFORMATION OBTAINED FROM THE CONTRACTOR
WHO INSTALLED IT.

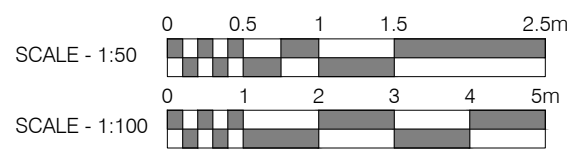

Rev: A Comments: Amendments as clouded. By: KN Date: Nov 25				LISTED BUILDING CONSENT Client: Mr. Simon Dougall Project Title: 107 High St, Lindfield, Haywards Heath, West Sussex, RH16 2HR Drawing Title: 'As-Built' Services: Basement and Ground Floor Scale: 1:50@A1 1:100@A3 Date: Sep 25 Drawn: KN Checked: KW				kyson Studio 28 Scrutton Street London UK EC2A 4RP T: +44(0) 20 7247 2462 E: enquiries@kyson.co.uk W: www.kyson.co.uk Project No.: 900-25 Drawing No.: 2400 Revision: A		
---	--	--	--	---	--	--	--	---	--	--