

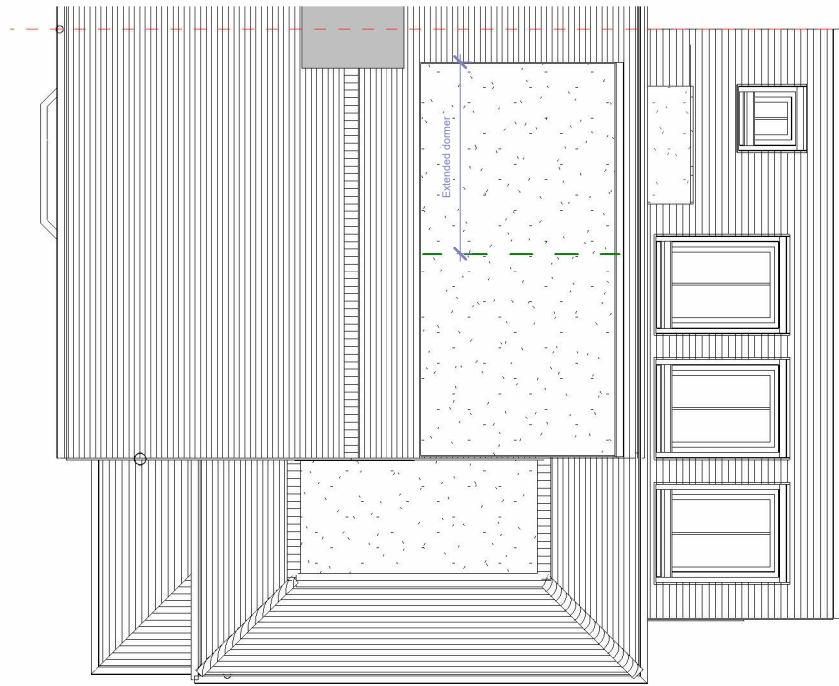


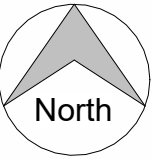

1 Proposed Roof
1 : 100

THESE DRAWINGS ARE FOR PLANNING PURPOSES ONLY AND ARE NOT INTENDED FOR ANY OTHER USE.
THESE DRAWINGS ARE NOT TO BE USED FOR CONSTRUCTION.
RED LINES ARE IN ACCORDANCE WITH LAND REGISTRY TITLE PLANS, M35 IS NOT LIABLE FOR ANY RED LINE DISCREPANCIES.

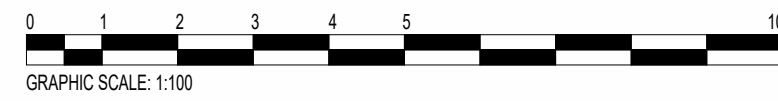

Horsgate View	Scale @ A3	Drawing number		No.	Description	Date
	1 : 100	052 08				
	Date	Rev				
Proposed Roof Plan	20.9.24					
	Drawn by					
	GMc					