


‘AS BUILT’ / EXISTING DRAWINGS

SECTIONAL ELEVATION

KEY:



Implemented re-construction of chimney approved under application DM/24/0987

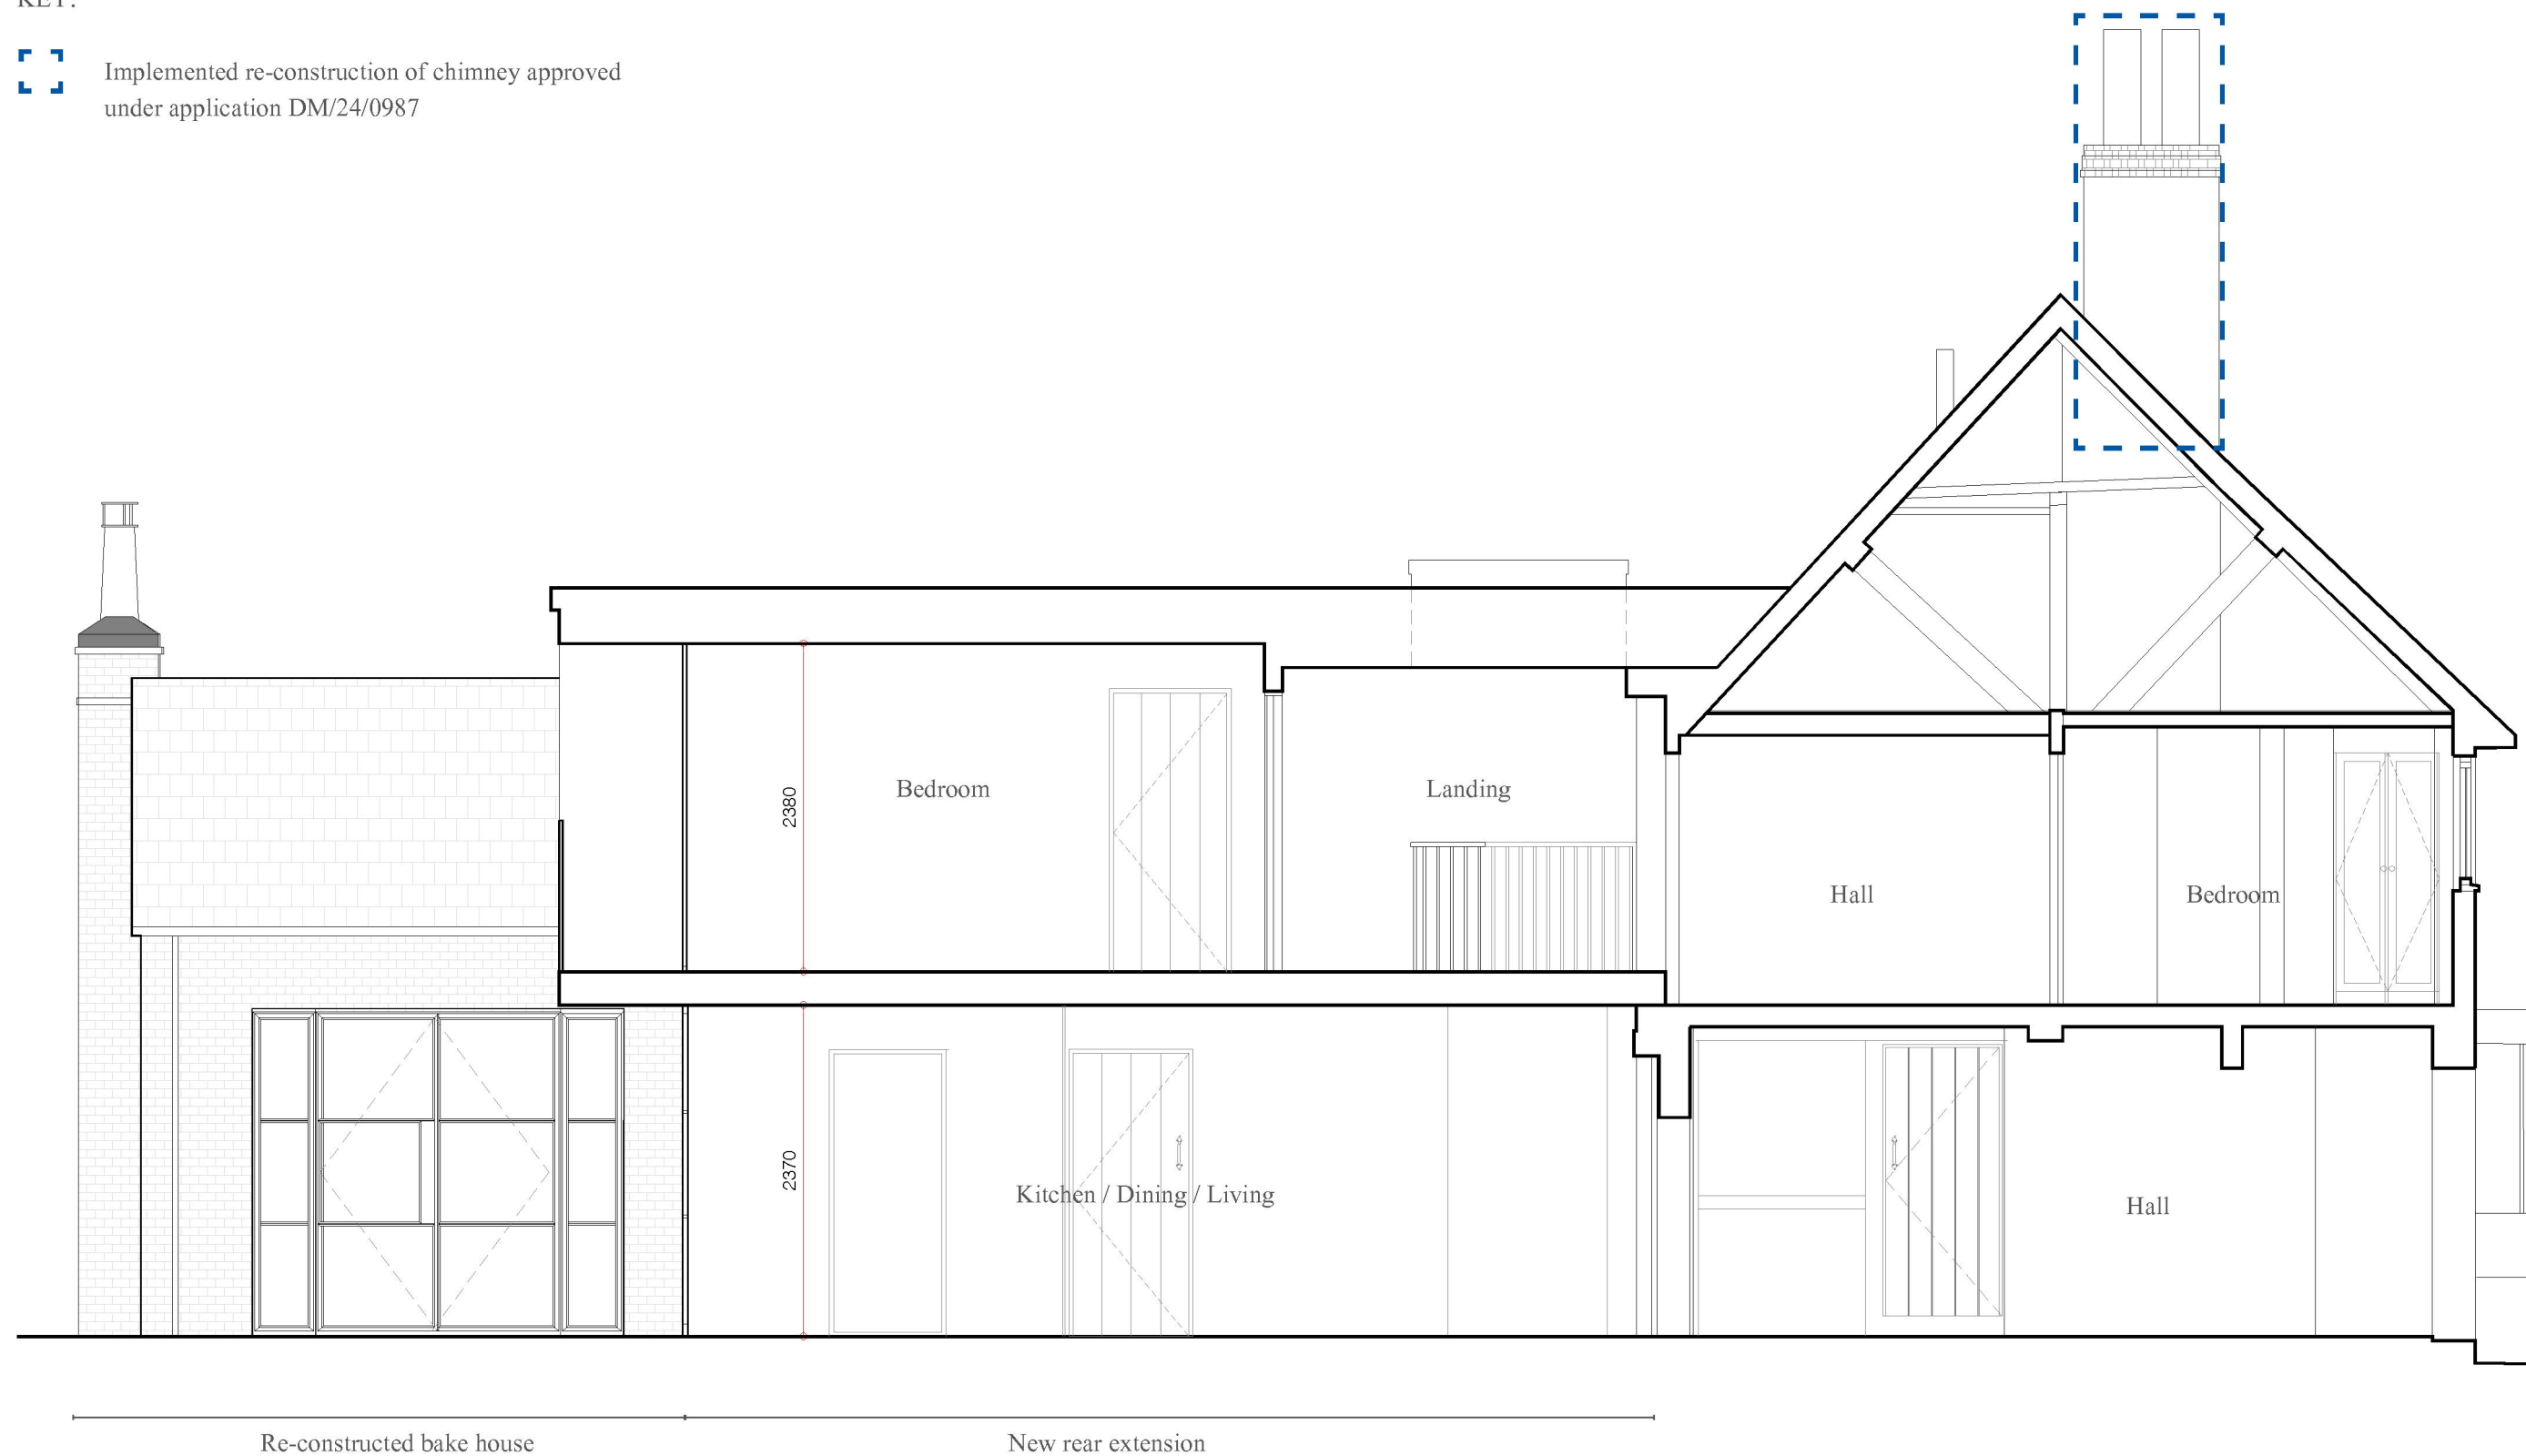

‘AS BUILT’/EXISTING SECTIONAL ELEVATION A-A. Drawing no. 1200. 1:50@A3

