




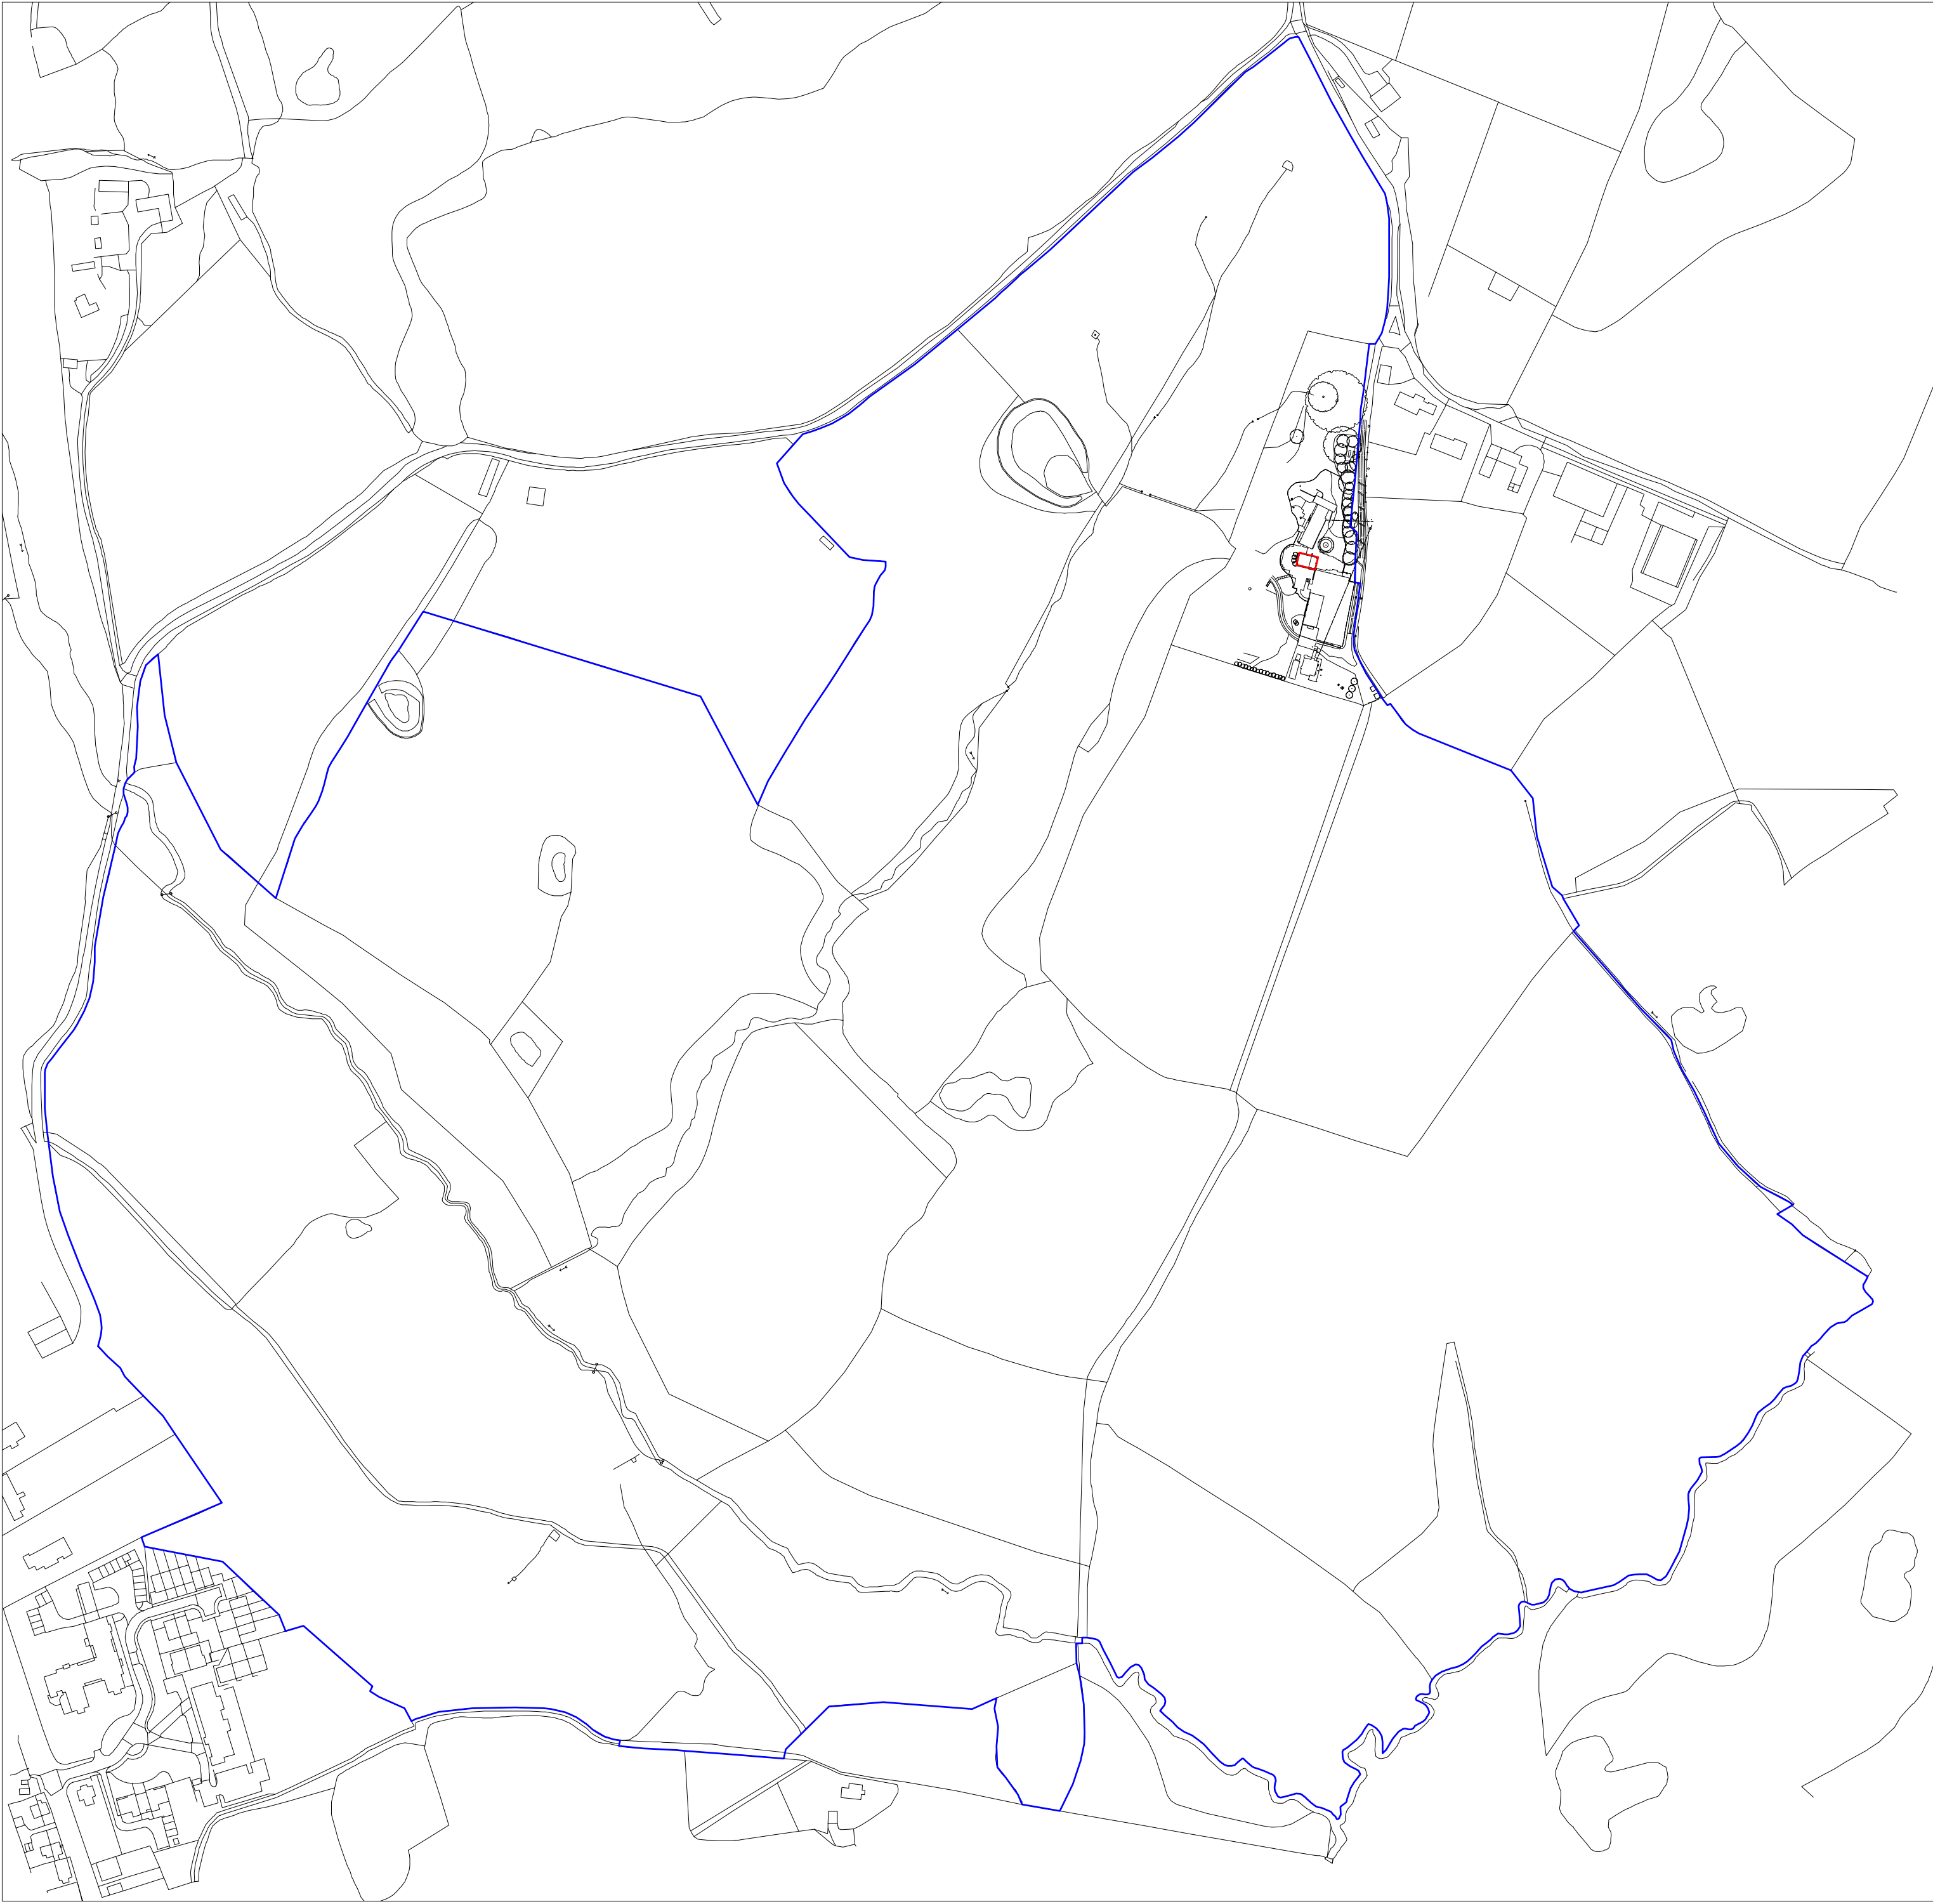

1 EXISTING - SITE LOCATION PLAN
Scale - 1:2500 @ A1

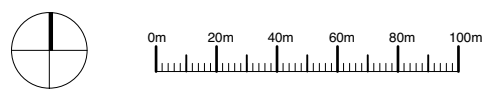

-  - Land associated with the application
-  - Land also owned by the applicant

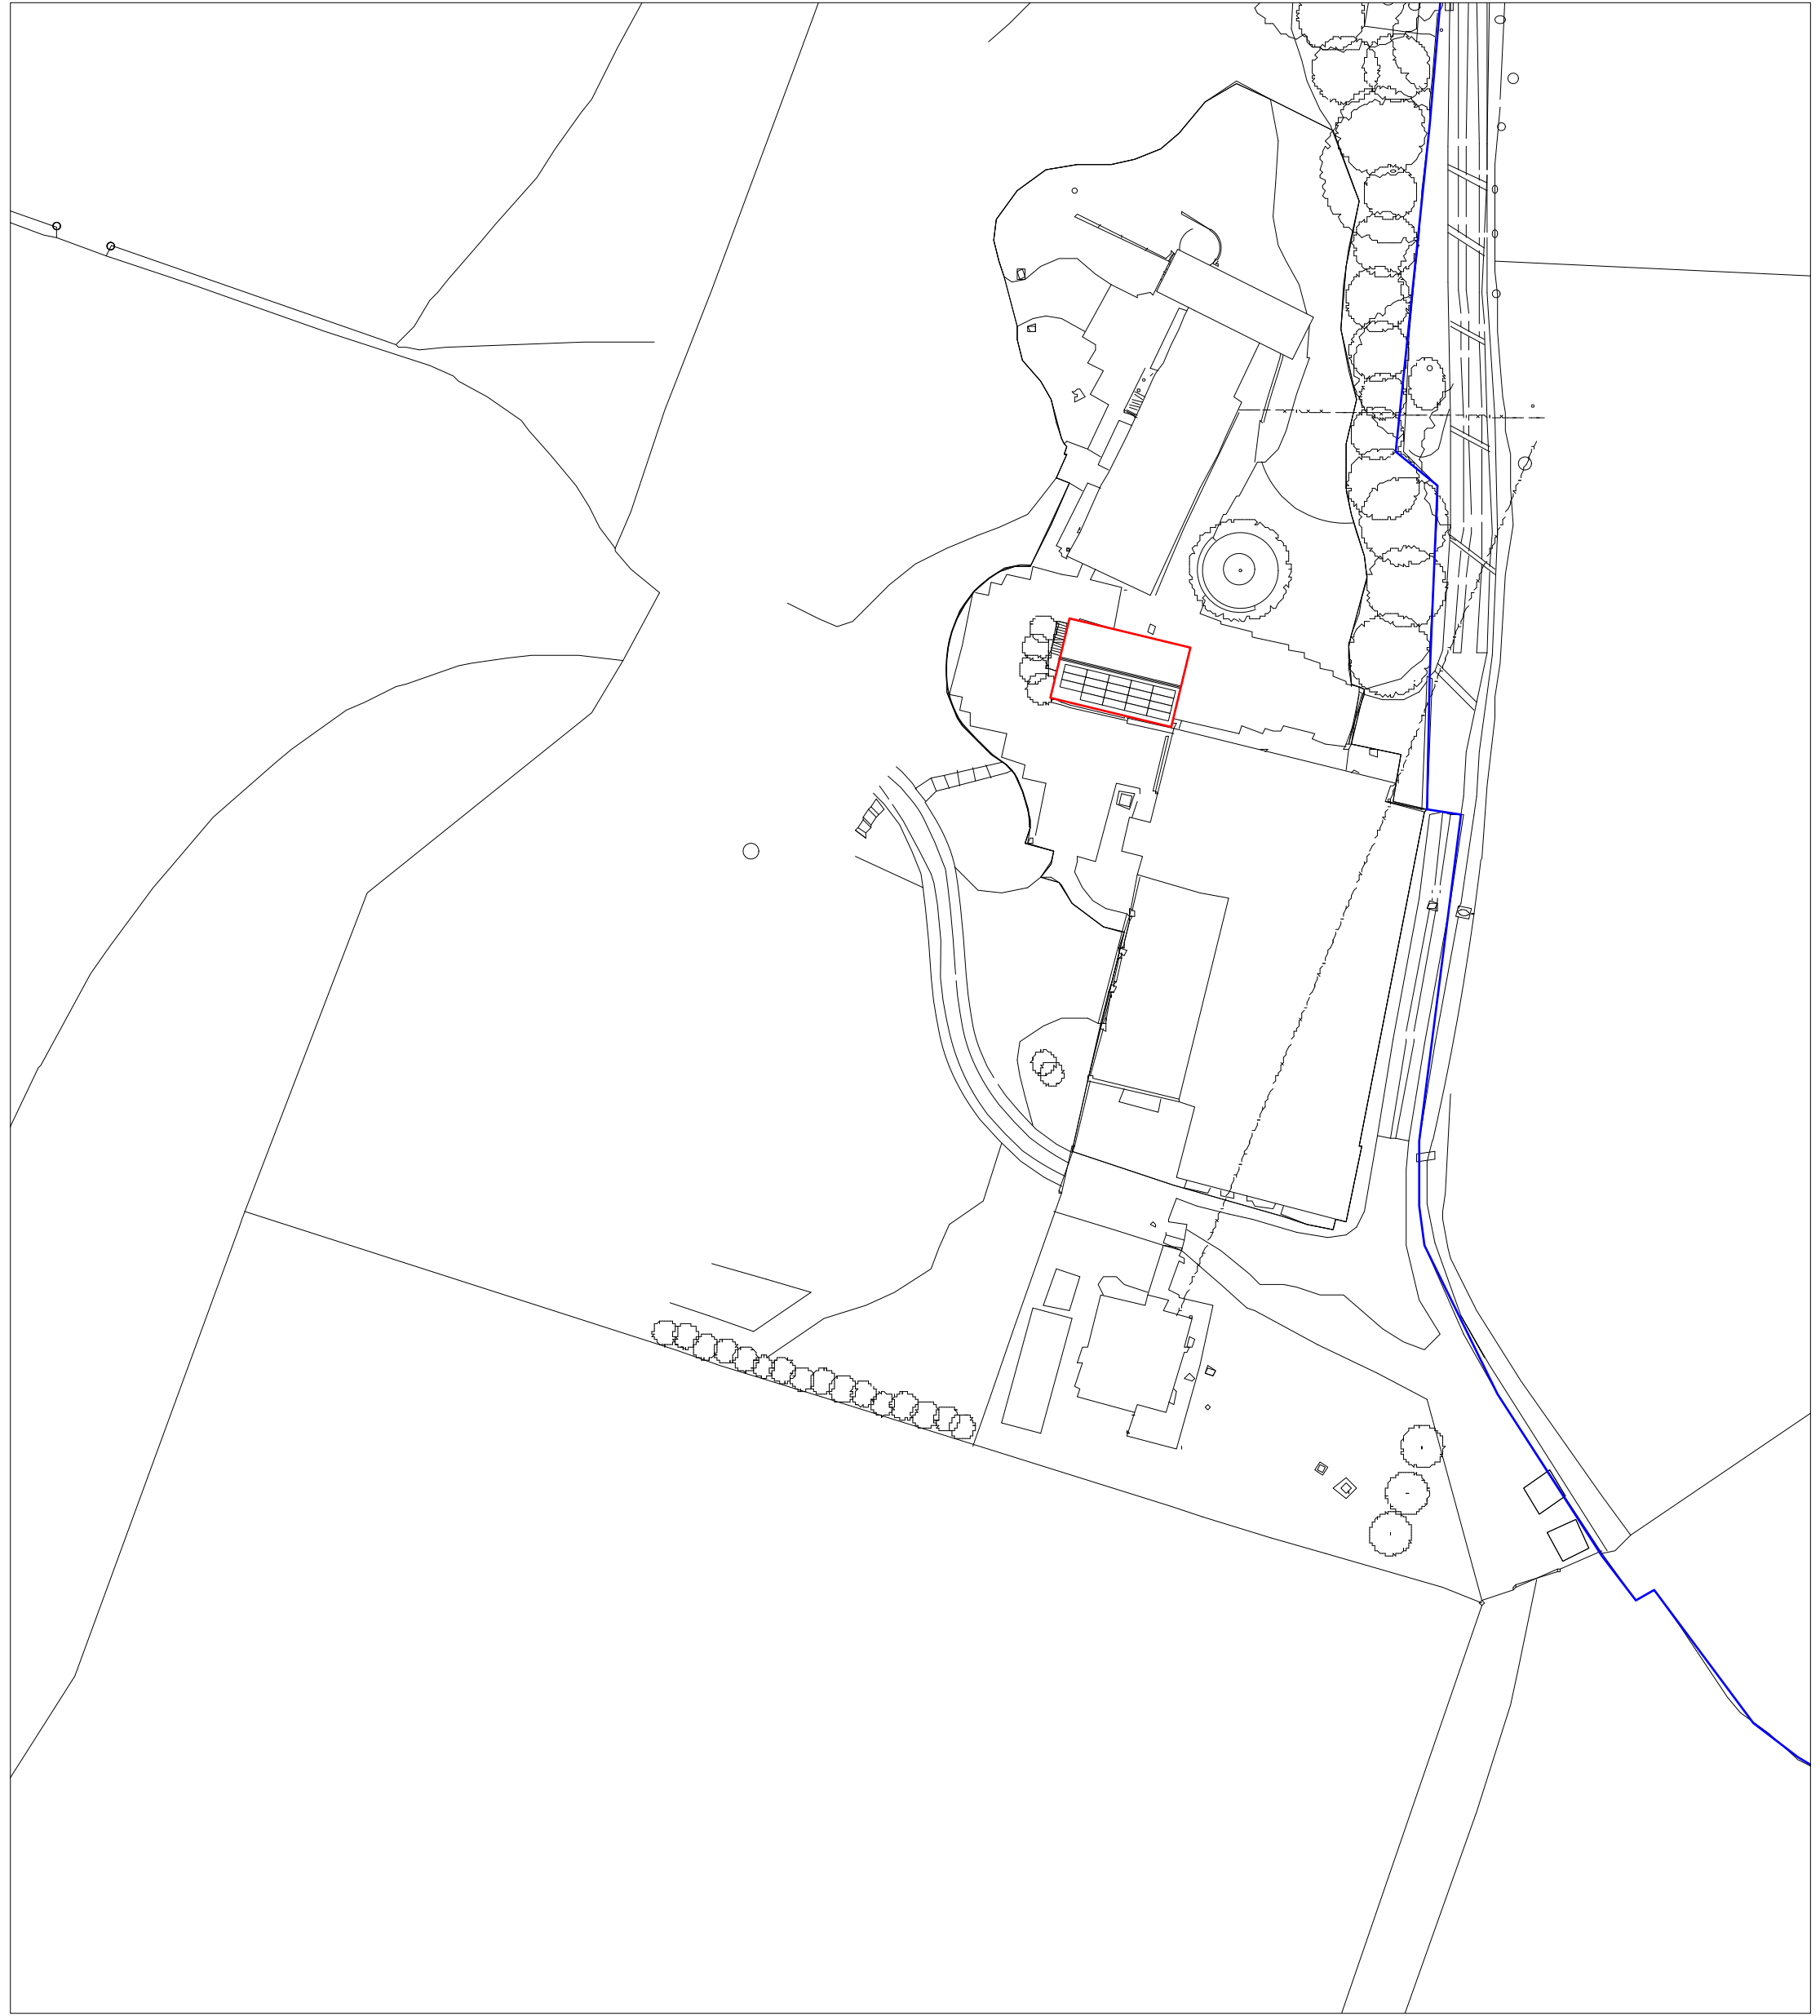

1 AS BUILT - BLOCK PLAN
Scale - 1:500 @ A1



HAPA ARCHITECTS			
Job Name Pickeridge Farm, Cob Ln, Ardingly, Haywards Heath, RH17 6ST			
Task PLANNING	Drawing Title SITE LOCATION PLAN		
Date JUL '25	Scale 1:2500 @ A1	Job Ref 0355	
© All rights reserved. Do not scale off drawings. All dimensions to be checked on site. HAPA Architects Ltd. // www.hapa-architects.co.uk			Drawing Number AL-001