





1 **EXISTING - North elevation**
Scale: 1:100

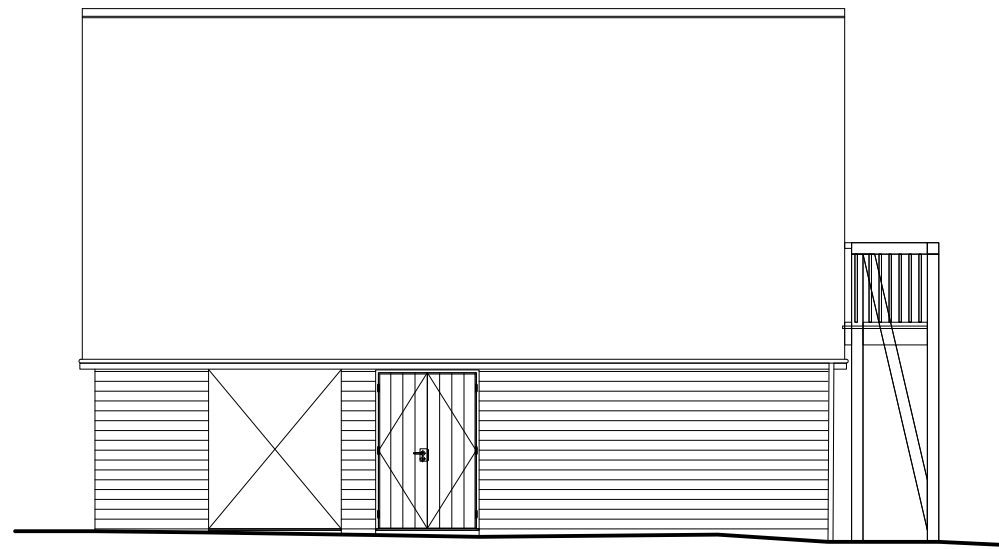


2 **EXISTING - East elevation**
Scale: 1:100

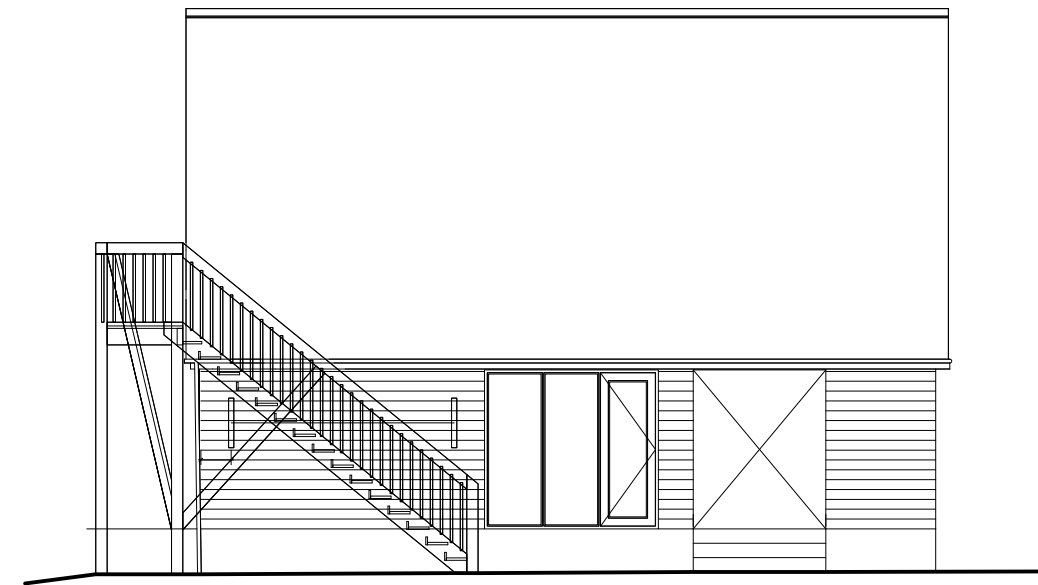

3 **EXISTING - South elevation**
Scale: 1:100




4 **EXISTING - West elevation**
Scale: 1:100

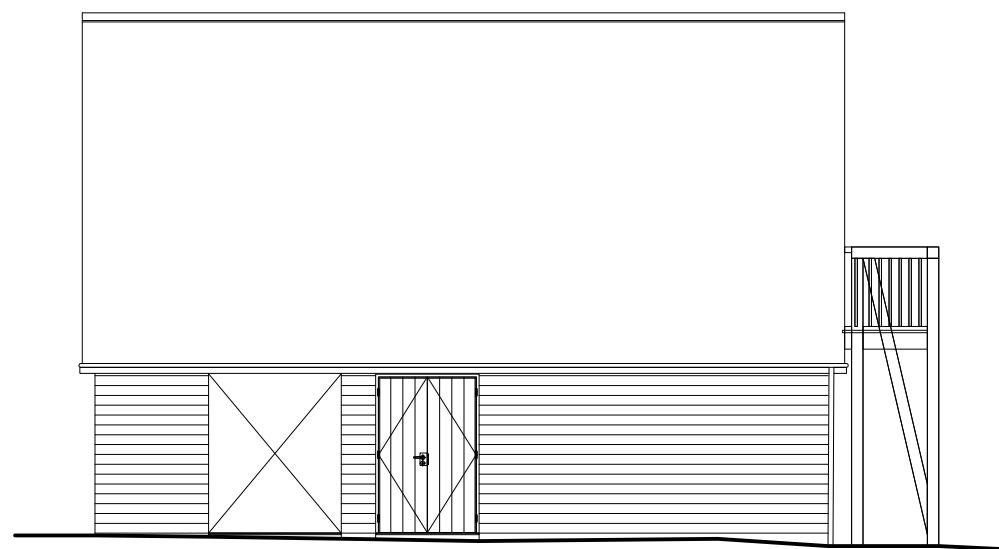

5 **PROPOSED (AS BUILT) - North elevation**
Scale: 1:100




6 **PROPOSED (AS BUILT) - East elevation**
Scale: 1:100

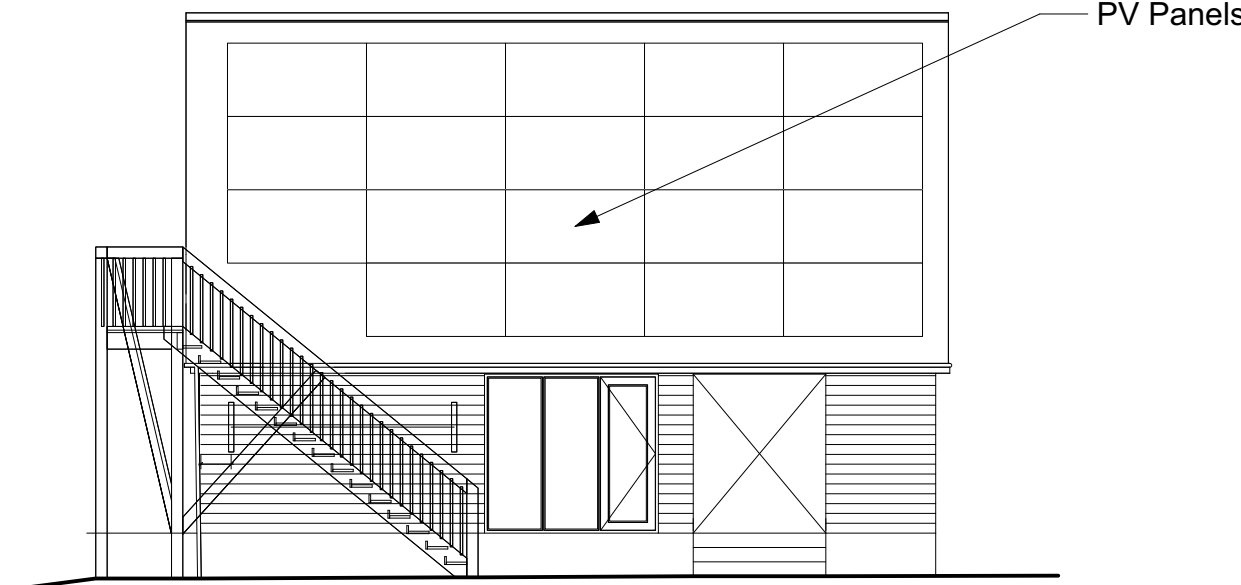


7 **PROPOSED (AS BUILT) - South elevation**
Scale: 1:100





8 **PROPOSED (AS BUILT) - West elevation**
Scale: 1:100

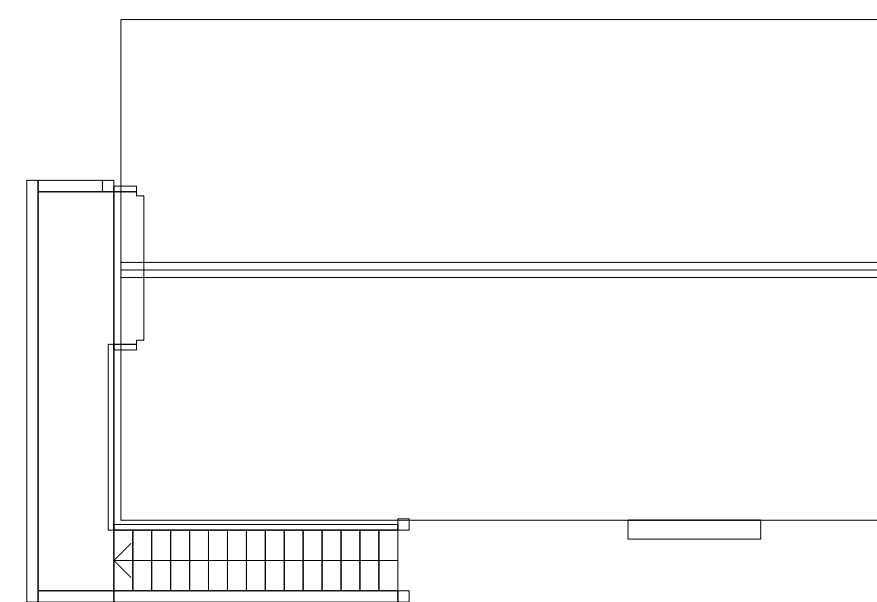

9 **EXISTING - Roof plan**
Scale: 1:100

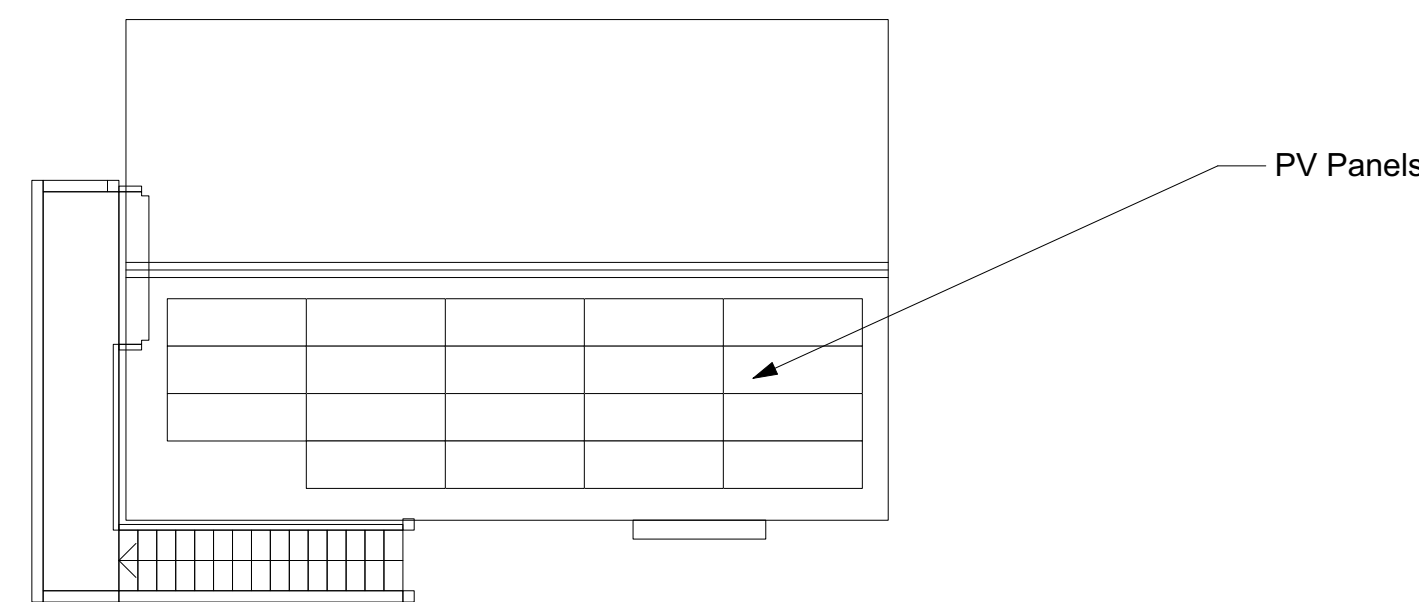

10 **PROPOSED (AS BUILT) - Roof plan**
Scale: 1:100

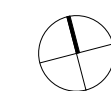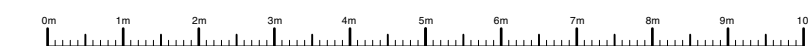

HAPA ARCHITECTS			
PICKERIDGE BARN			
Task	EXISTING AND PROPOSED ELEVATIONS and PLANS	Job Ref	0355
DATE	APR '26	Scale	1:100 @ A1
By (to create, amend or for final check-off drawing)		Drawing Number	AL-100
HAPA Architects Ltd. // www.hapa-architects.co.uk			