




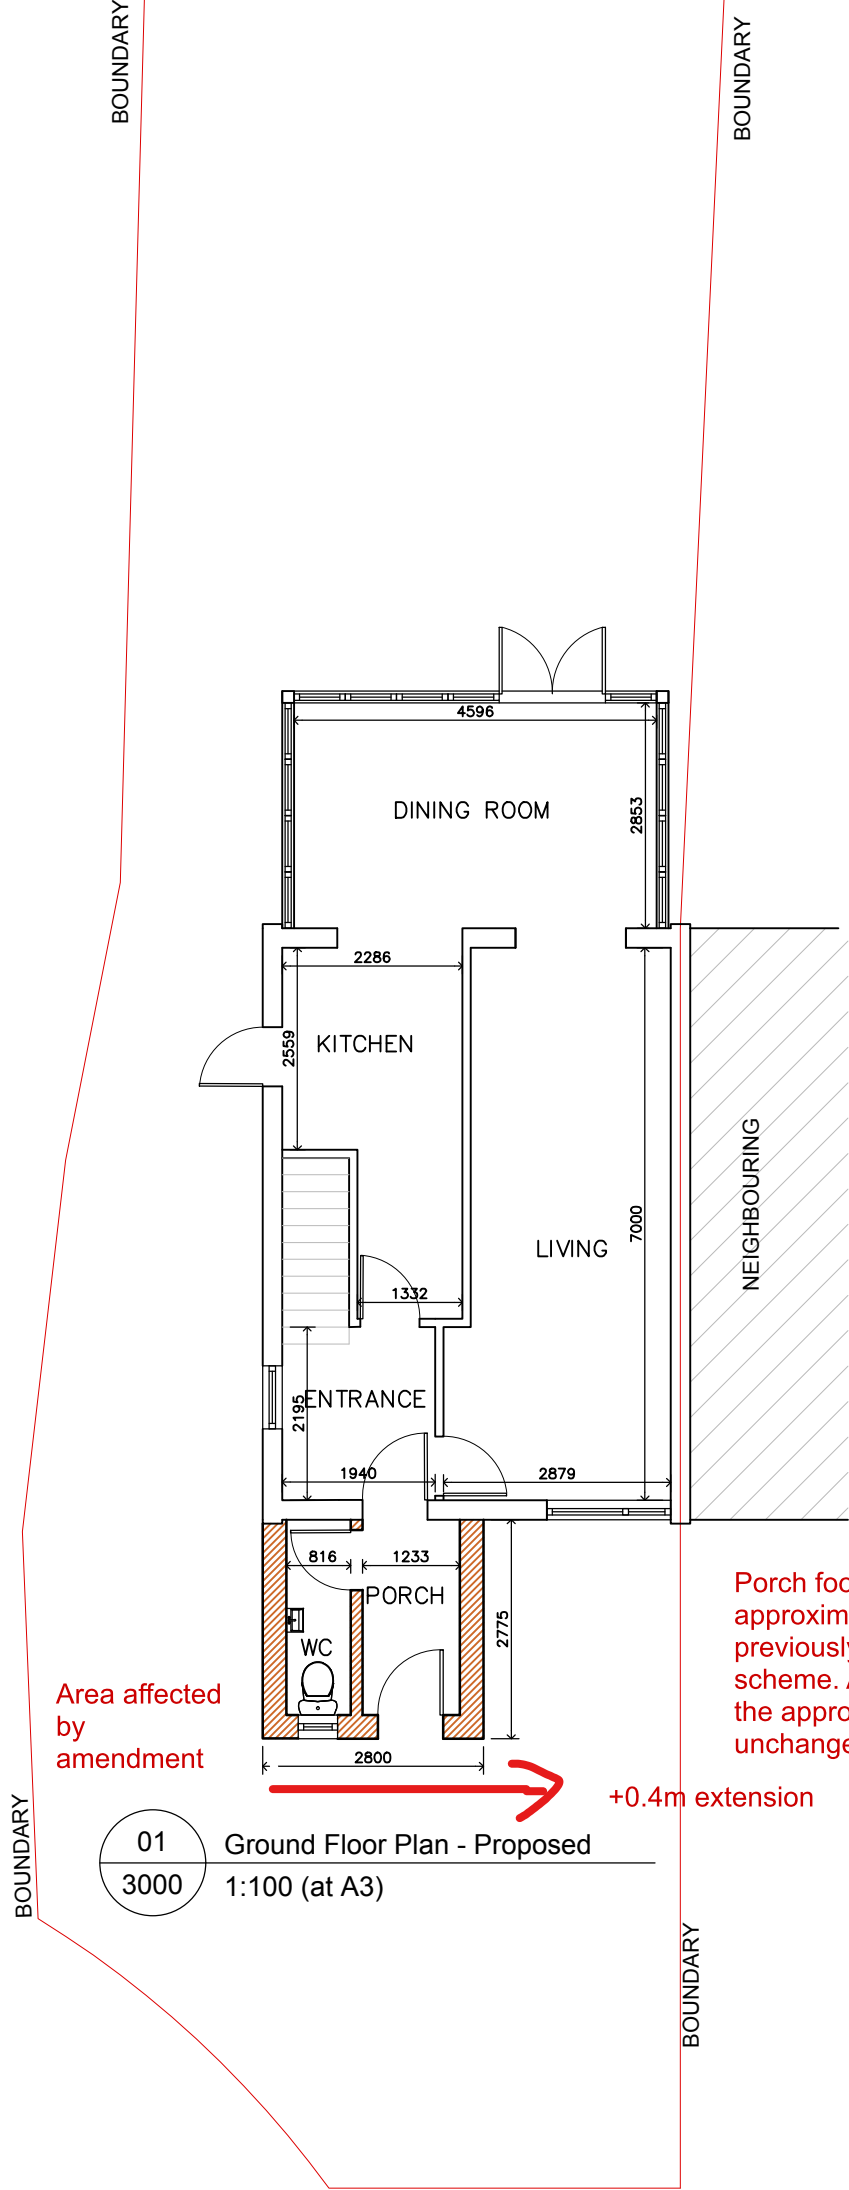

01
3000
Ground Floor Plan - Proposed
1:100 (at A3)

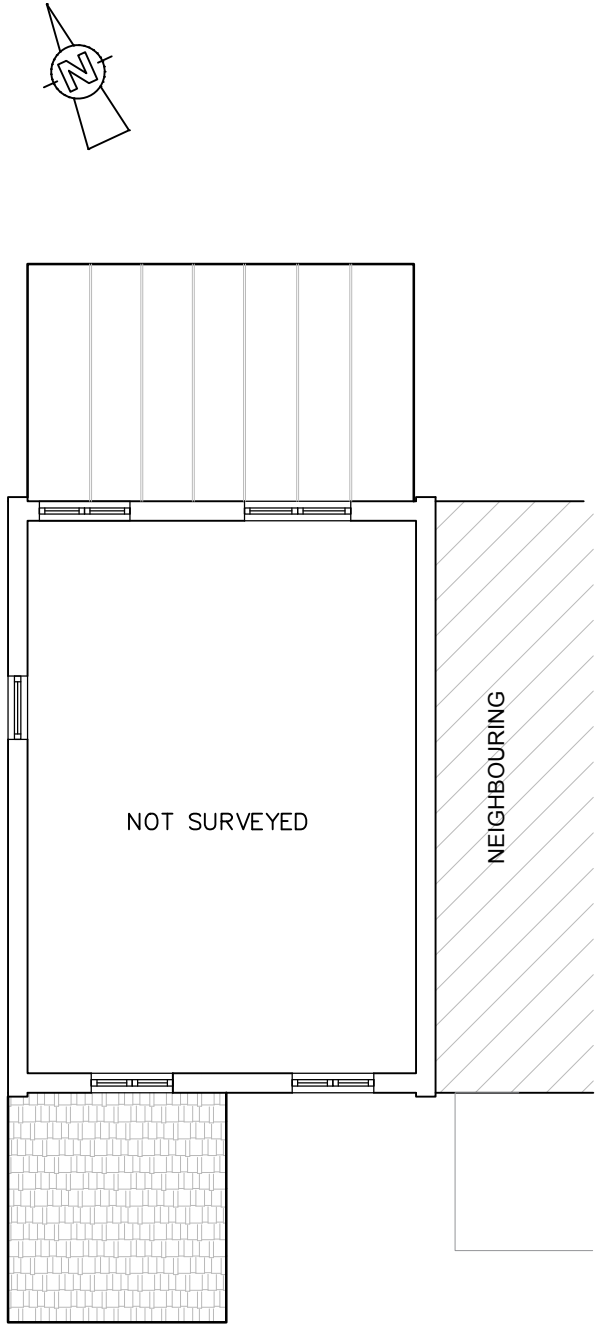


02
3000
First Floor Plan - Proposed
1:100 (at A3)

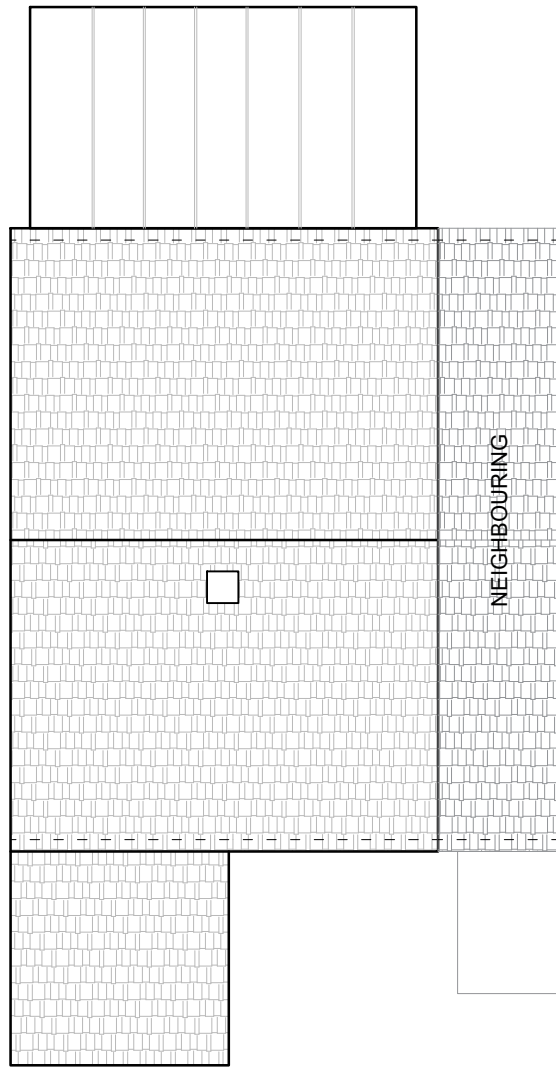

03
3000
Roof Plan - Proposed
1:100 (at A3)

Revision C: Amended porch footprint (+0.4m)

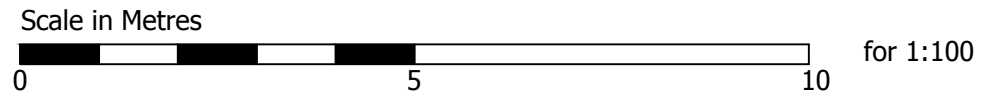

Drawing Specific Notes:

Red lines indicates boundary of property.

Blue line indicates site boundary of the proposed works .

All dimensions and particulars are to be checked on site before work commences and any discrepancy to be reported to PM Home Consultants.

This drawing can be scaled for Planning purposes. **DO NOT SCALE** this drawing for setting out, use written dimensions only. Any work commenced before Council approval is at the Clients risk



Proteus Management
Architectural Services
07921693510
www. ProteusManagement.co.uk

Project:
Proposed porch at 12 Heather Close,
Cophthorne, RH10 3PZ

Drawing Title:
Proposed Floor Plans

Drawing Number: 3000	Date: 17/06/2026	Revision: C
-------------------------	---------------------	----------------

Scale: (at A3) 1:100	Status: Planning Permission
-------------------------	--------------------------------

Client:
Mr & Mrs Harris