





Approved Scheme Roof Plan
Scale 1:25@A1
1:50@A3

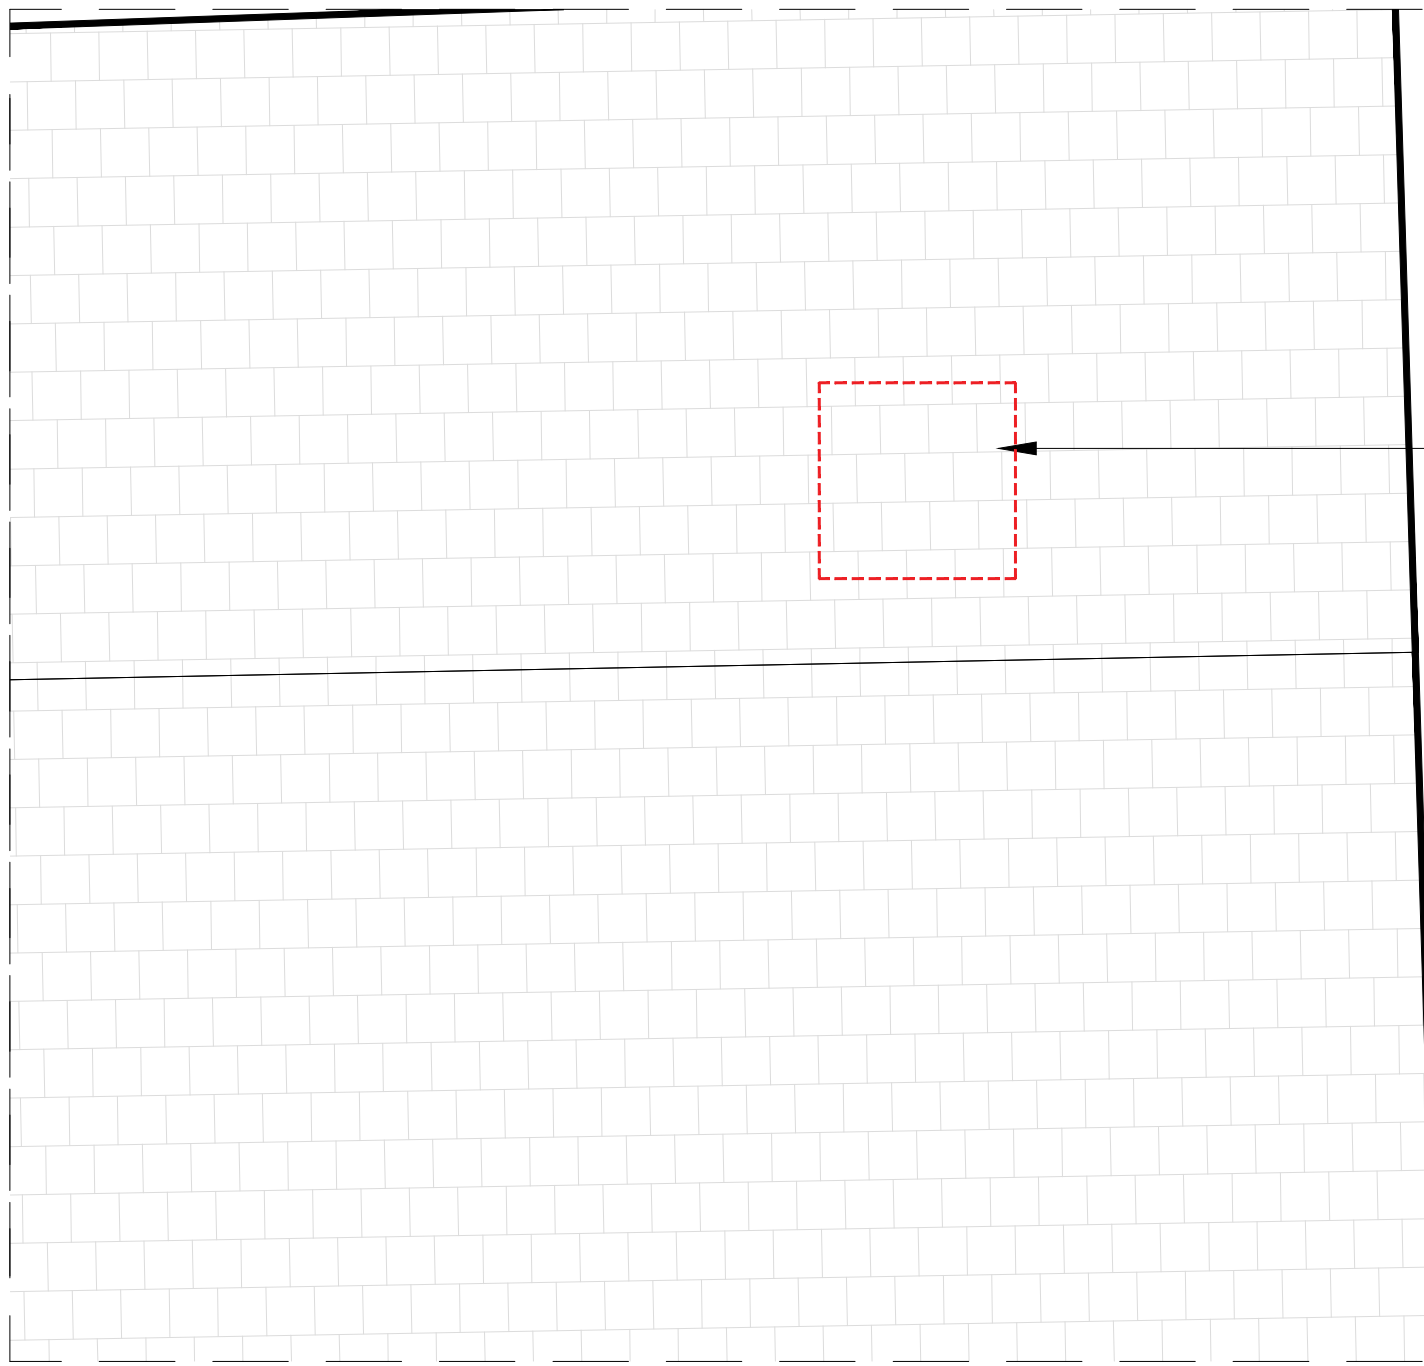


'As Built' / Proposed Roof Plan
Scale 1:25@A1
1:50@A3

19th century chimney stack removed,
roof made good with tiles matching
existing slate roof

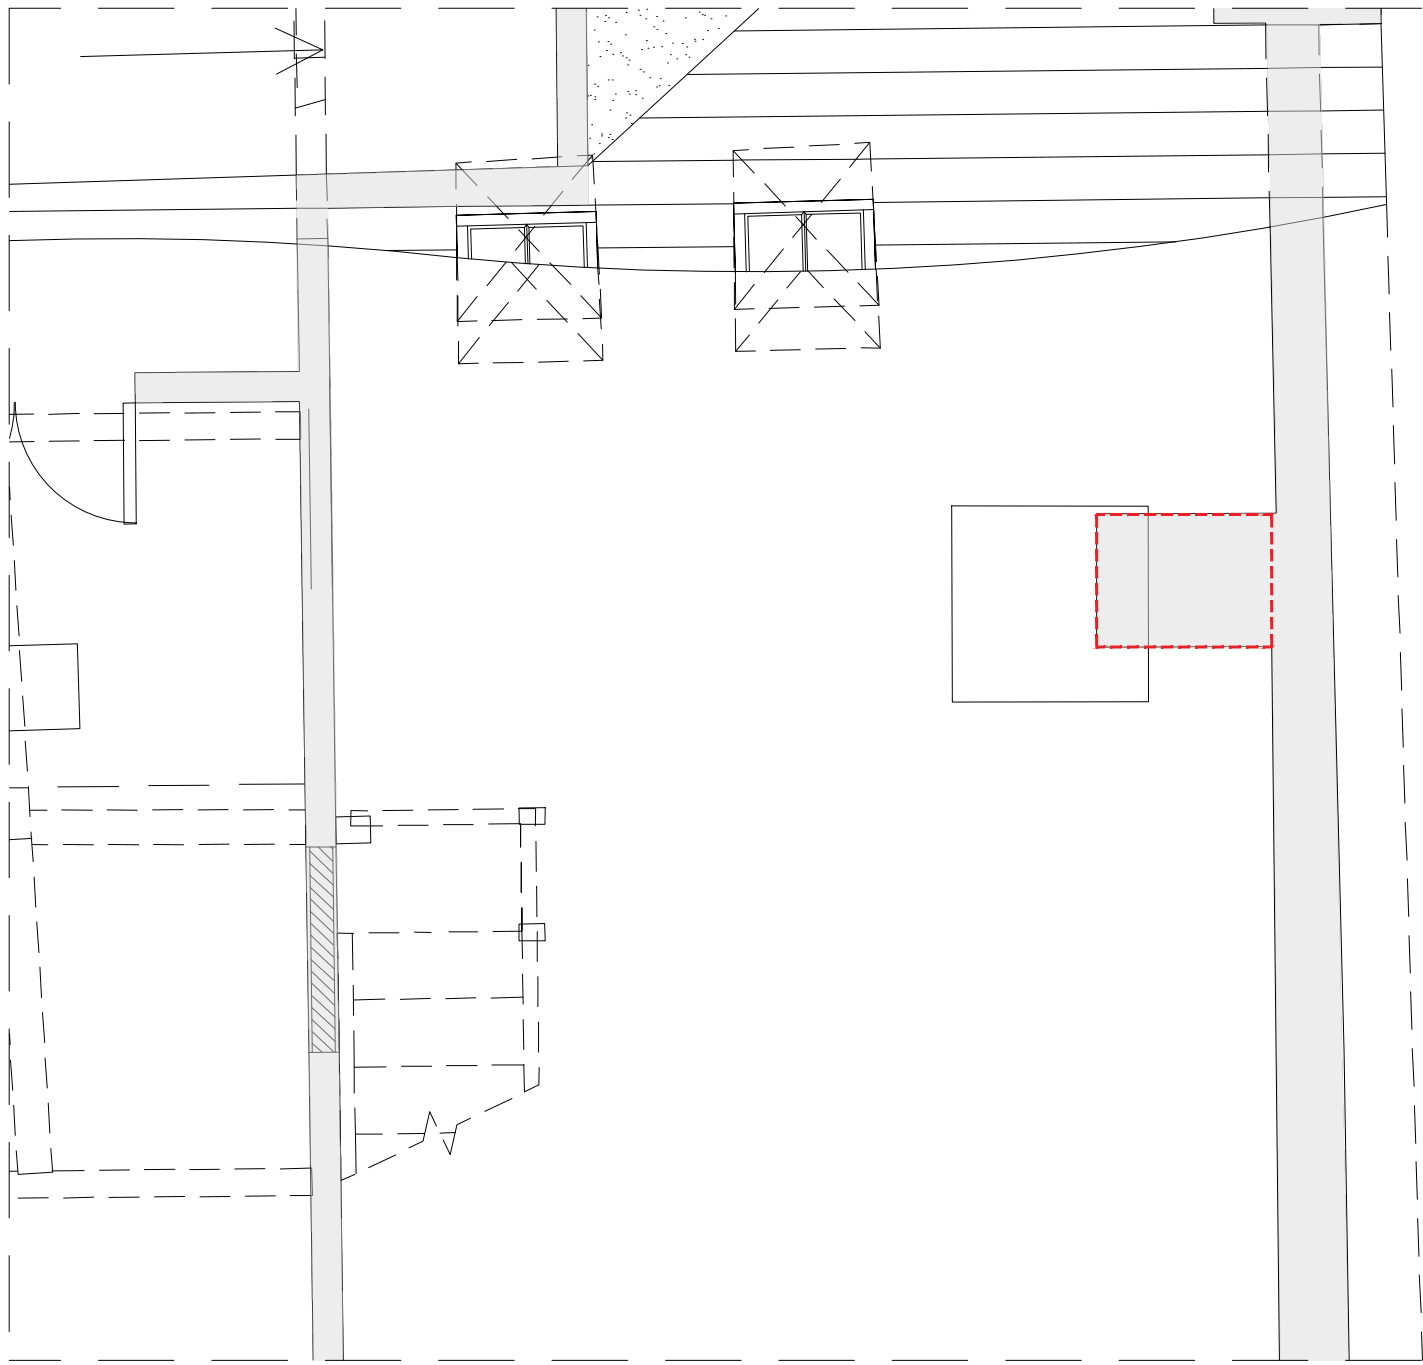


Approved Scheme Second Floor Plan
Scale 1:25@A1
1:50@A3

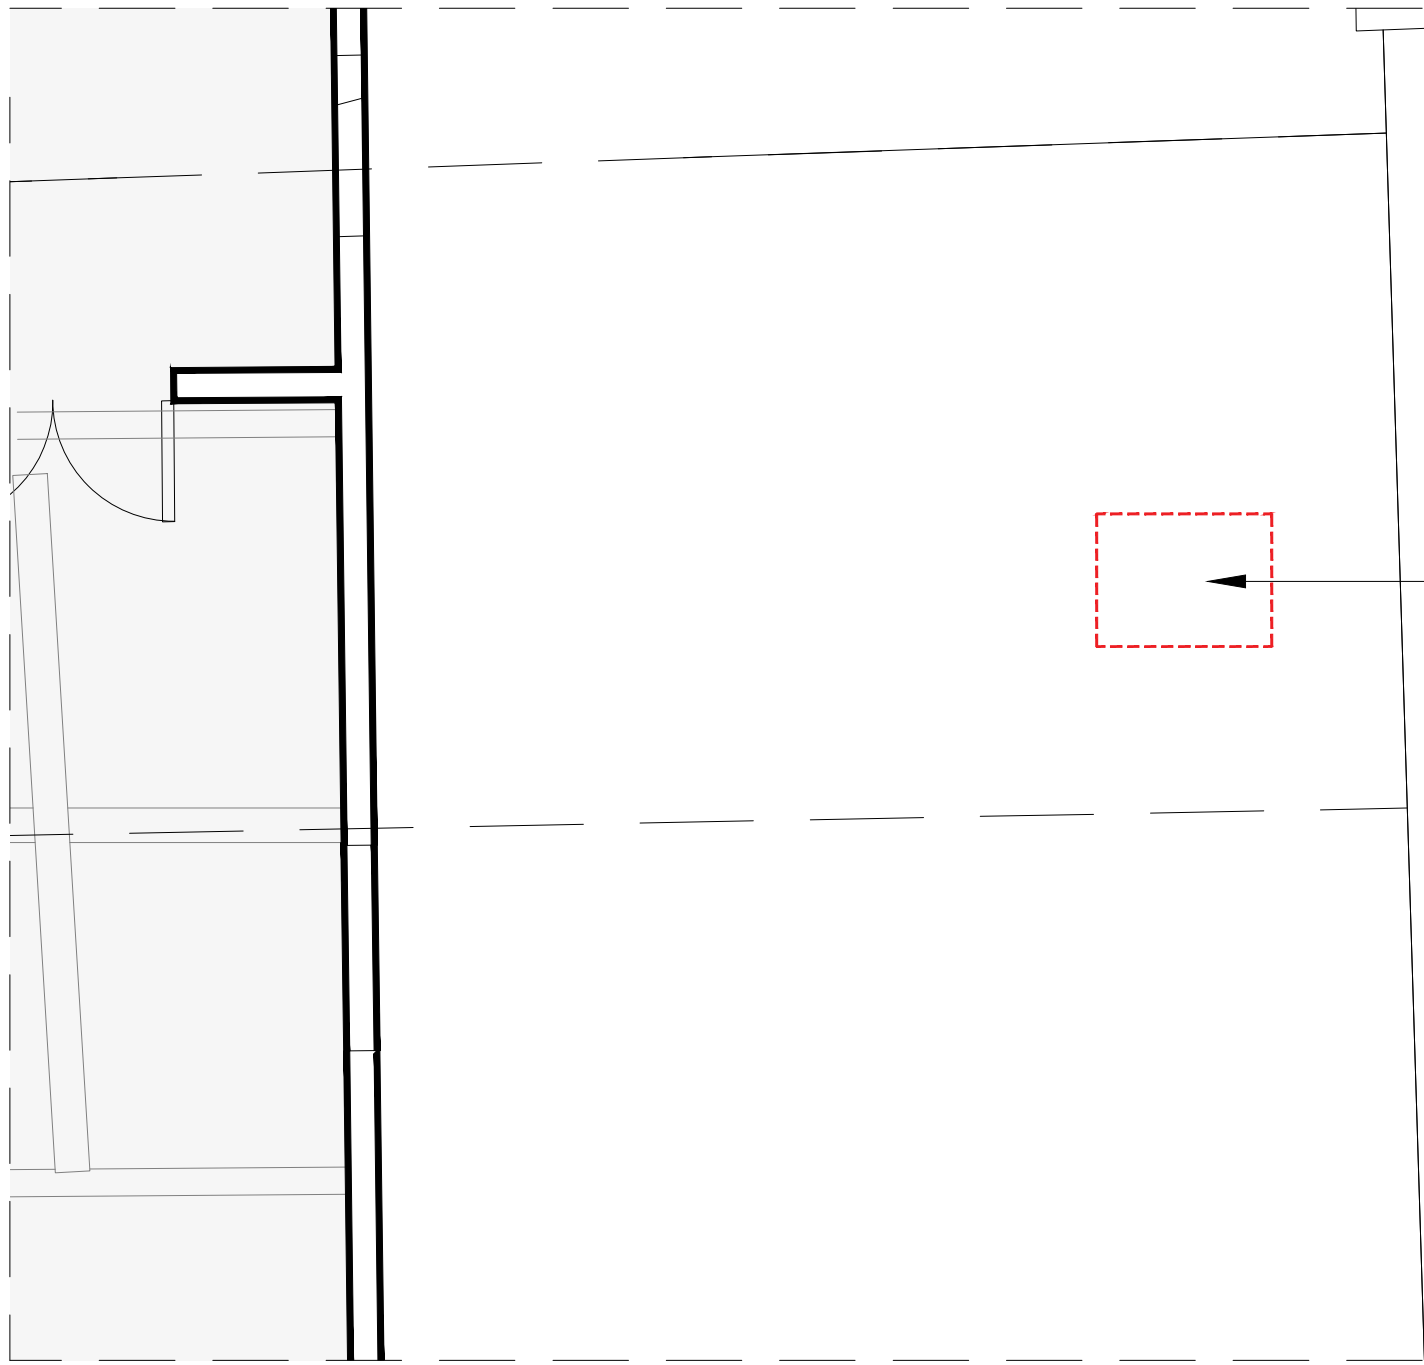

'As Built' / Proposed Second Floor Plan
Scale 1:25@A1
1:50@A3


19th century chimney stack removed,
roof made good with tiles matching
existing slate roof

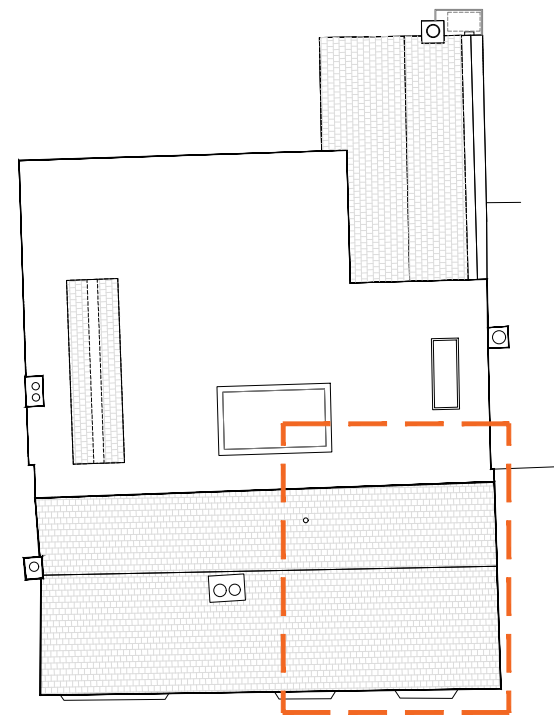

Key Plan 1:200@A1, 1:400@A3

KEY:
Highlighted difference between Approved
Scheme and 'As-Built'/Proposed Scheme

NOTE
DRAWINGS TO BE READ IN CONJUNCTION WITH SUBMITTED
DESIGN&ACCESS STATEMENT AND HERITAGE STATEMENT
MATERIALS INSTALLED IN ACCORDANCE WITH THOSE
OUTLINED IN CONDITION #9 OF APPROVAL DM/23/1605

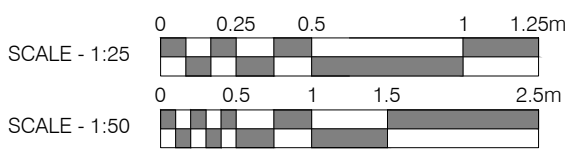

Do not scale this drawing All dimensions must be checked on site
All rights reserved. No reproduction in any material form is permitted
without consent.

LISTED BUILDING
CONSENT

Client:
Mr. Simon Dougall
Project Title:
107 High St, Lindfield, Haywards Heath, West Sussex, RH16 2HR
Drawing Title:
Detail Drawings:
Removal of chimney - Sheet 2 of 2

Scale: 1:25@A1 1:50@A3
Date: Apr 25
Drawn: KN
Checked: KW

kyson
Studio
28 Scrutton Street
London
UK
EC2A 4RP
T: +44(0) 20 7247 2462
E: enquiries@kyson.co.uk
W: www.kyson.co.uk

Project No.: 900-25
Drawing No.: 5006
Revision: -