

Revision J: Increase the height of the new first floor window opening to align with the eaves barge board.




Proposed North Elevation



Proposed East Elevation

Revision J: New double glazed casement window to the south elevation. Window frames and mouldings are to match the existing windows.

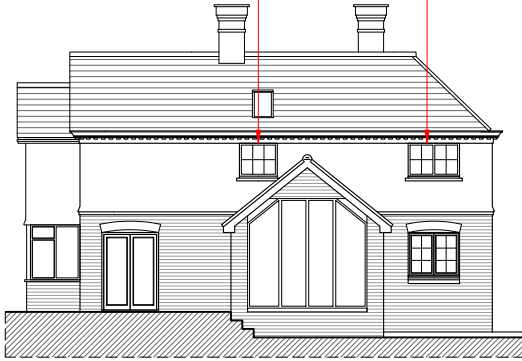

Proposed South Elevation

Revision J: Increase the height of the new first floor window opening to align with the eaves barge board.



Proposed West Elevation

Proposed Elevations - Design Amendments Shown in Red
Scale: 1:200 [A3]

Drawing Key:

- Application Site
- Existing Structure[s]
- Proposed Structure

J	13/04/26	Issued for PLANNING PERMISSION AMENDMENTS
Rev	Date	Description



PLANNING

Project	2 By-Sunte, Lindfield	Project Reference	26002
Client	Private		
Date	April 2026	Scale	1:100 @ A3 & 1:200 @ A3

Drawn	Checked	Approved	Rev
NR	NR	NR	J
Title			
Proposed Floor & Elevation Plans			
Drawing Number			
4108-02			

Scale: 1:100 @ A3


0 1m 2m 3m 4m 5m

Scale: 1:200 @ A3


0 2m 4m 6m 8m 10m

This drawing is copyright of Rose Chapman Architects. Do not scale from this drawing. All dimensions and levels to be checked on site by the contractor and such dimensions to be his responsibility. Report all drawing errors, omissions and discrepancies to the architect.

DISCLAIMER
This document may be issued in an editable digital CAD format to enable others to use it as background information to make alterations and/or additions. In that instance the file will be accompanied by a PDF version as a record of the original file. It is for those parties making such alterations and/or additions to ensure that they make use of current background information. Rose Chapman Architects accepts no liability for either: any such alterations and/or additions to the background information by others; or any other changes made by others to the architectural content of the background information itself.

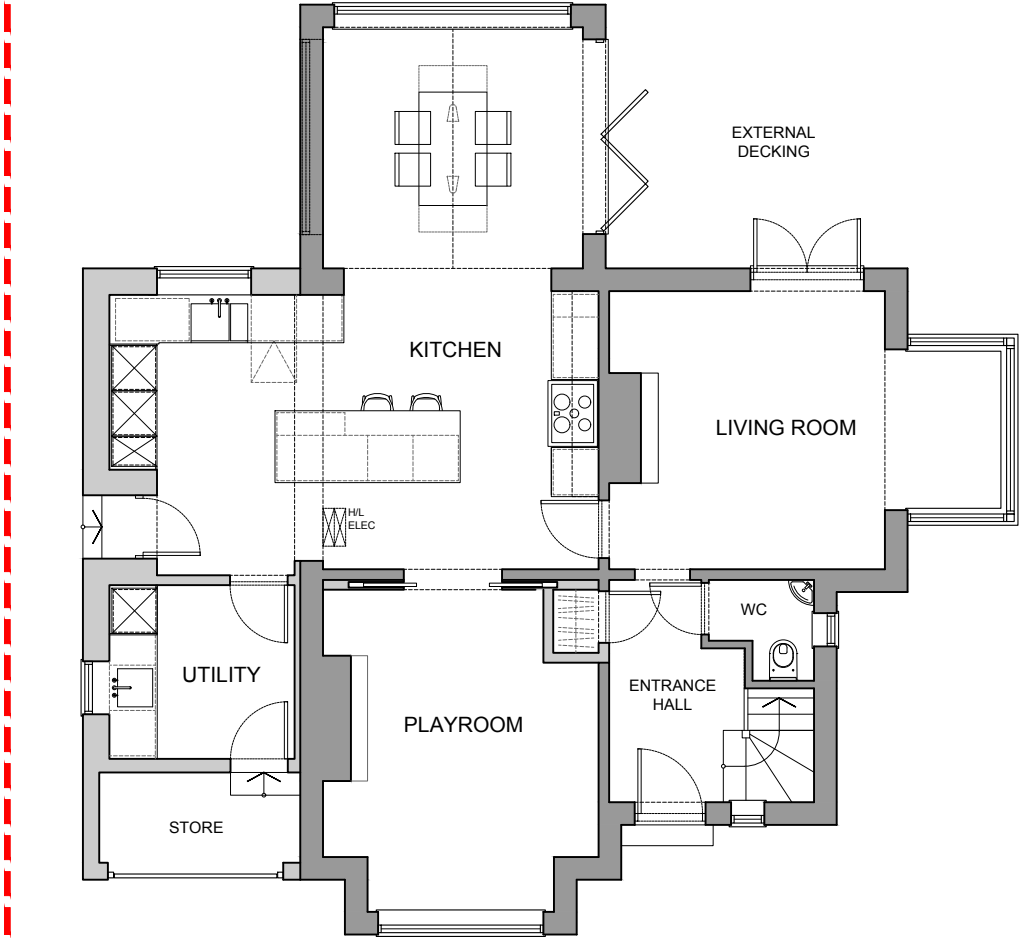

Proposed Ground Floor Plan - Design Amendments Shown in Red
Scale: 1:100 [A3]

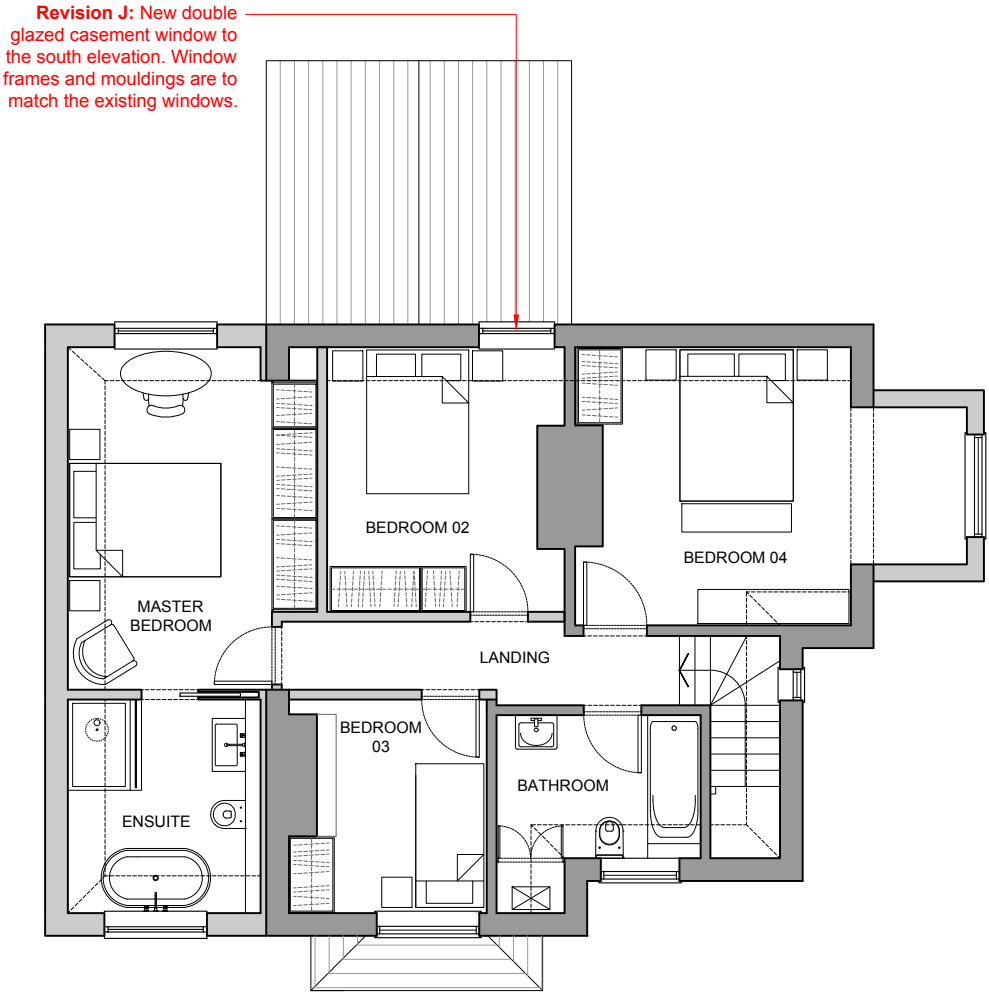

Proposed First Floor Plan - Design Amendments Shown in Red
Scale: 1:100 [A3]