


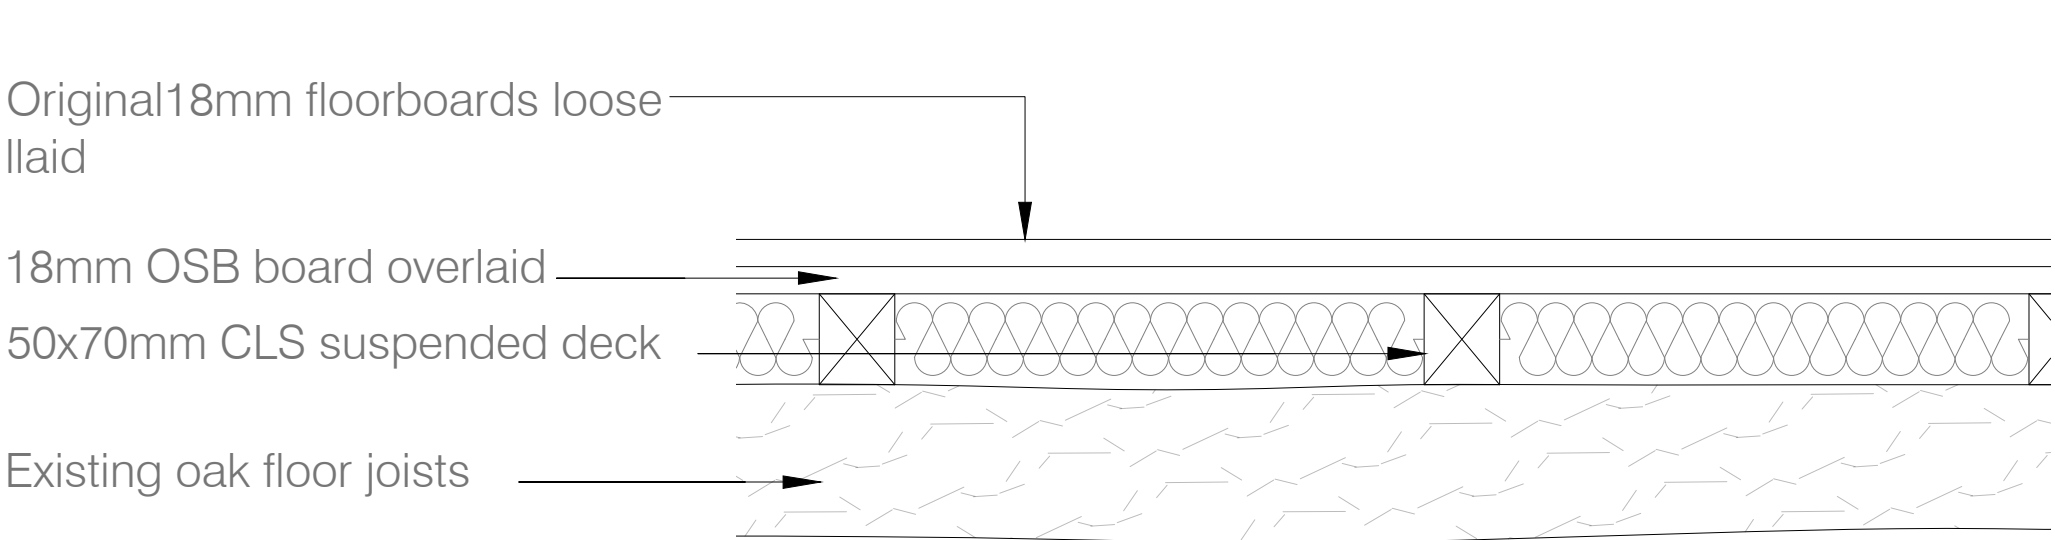


Detail 1
Existing Attic Floor Build-Up
Scale 1:5@A1
1:10@A3

Existing area of floor build-up finished with OSB board. Refer to detail 01 for existing build-up.




Key Plan
Existing Attic Plan
Scale 1:25@A1
1:50@A3

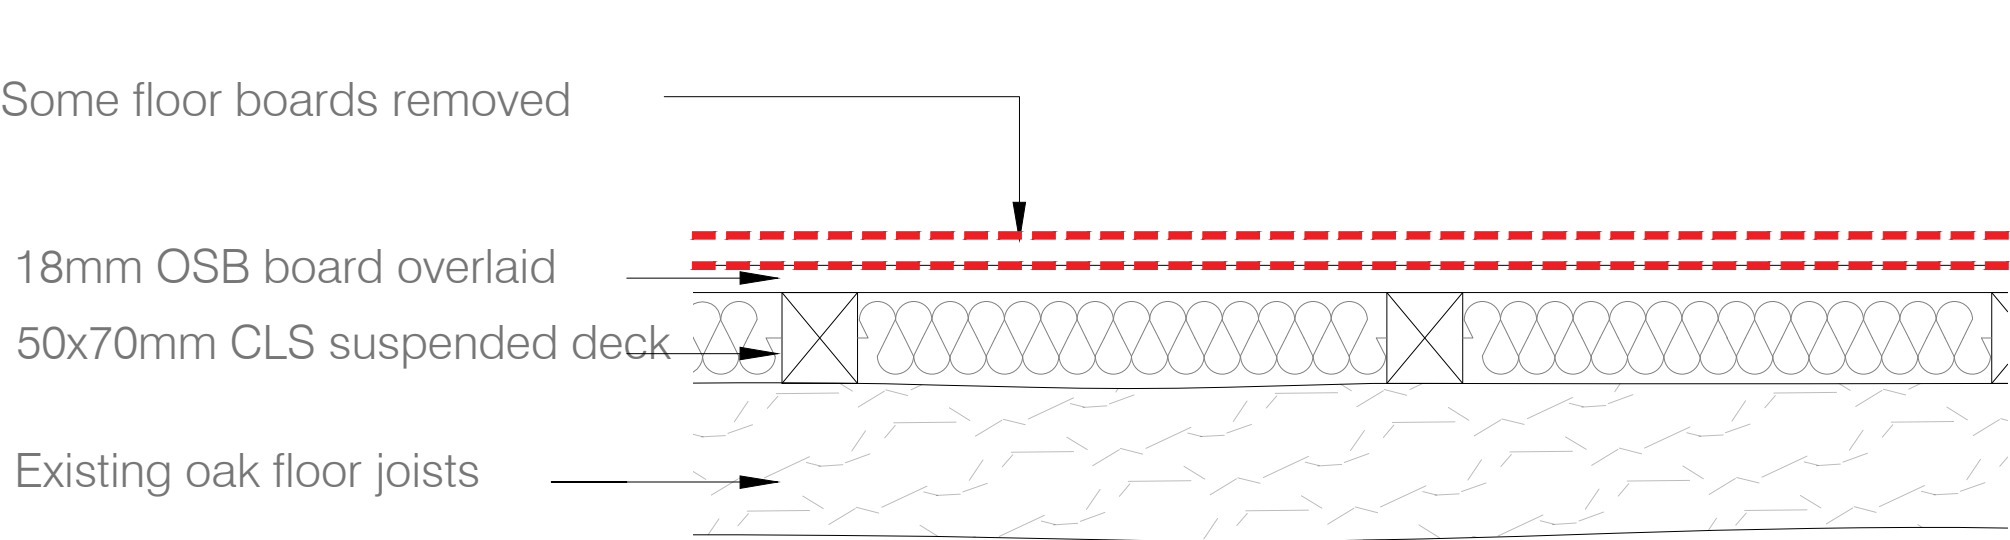


Detail 2
'As Built' Attic Floor Build-Up
Scale 1:5@A1
1:10@A3

'As-built' some floor boards removed from the attic. Refer to Detail 2 for proposed build-up

Implemented vaulted ceiling above bedroom

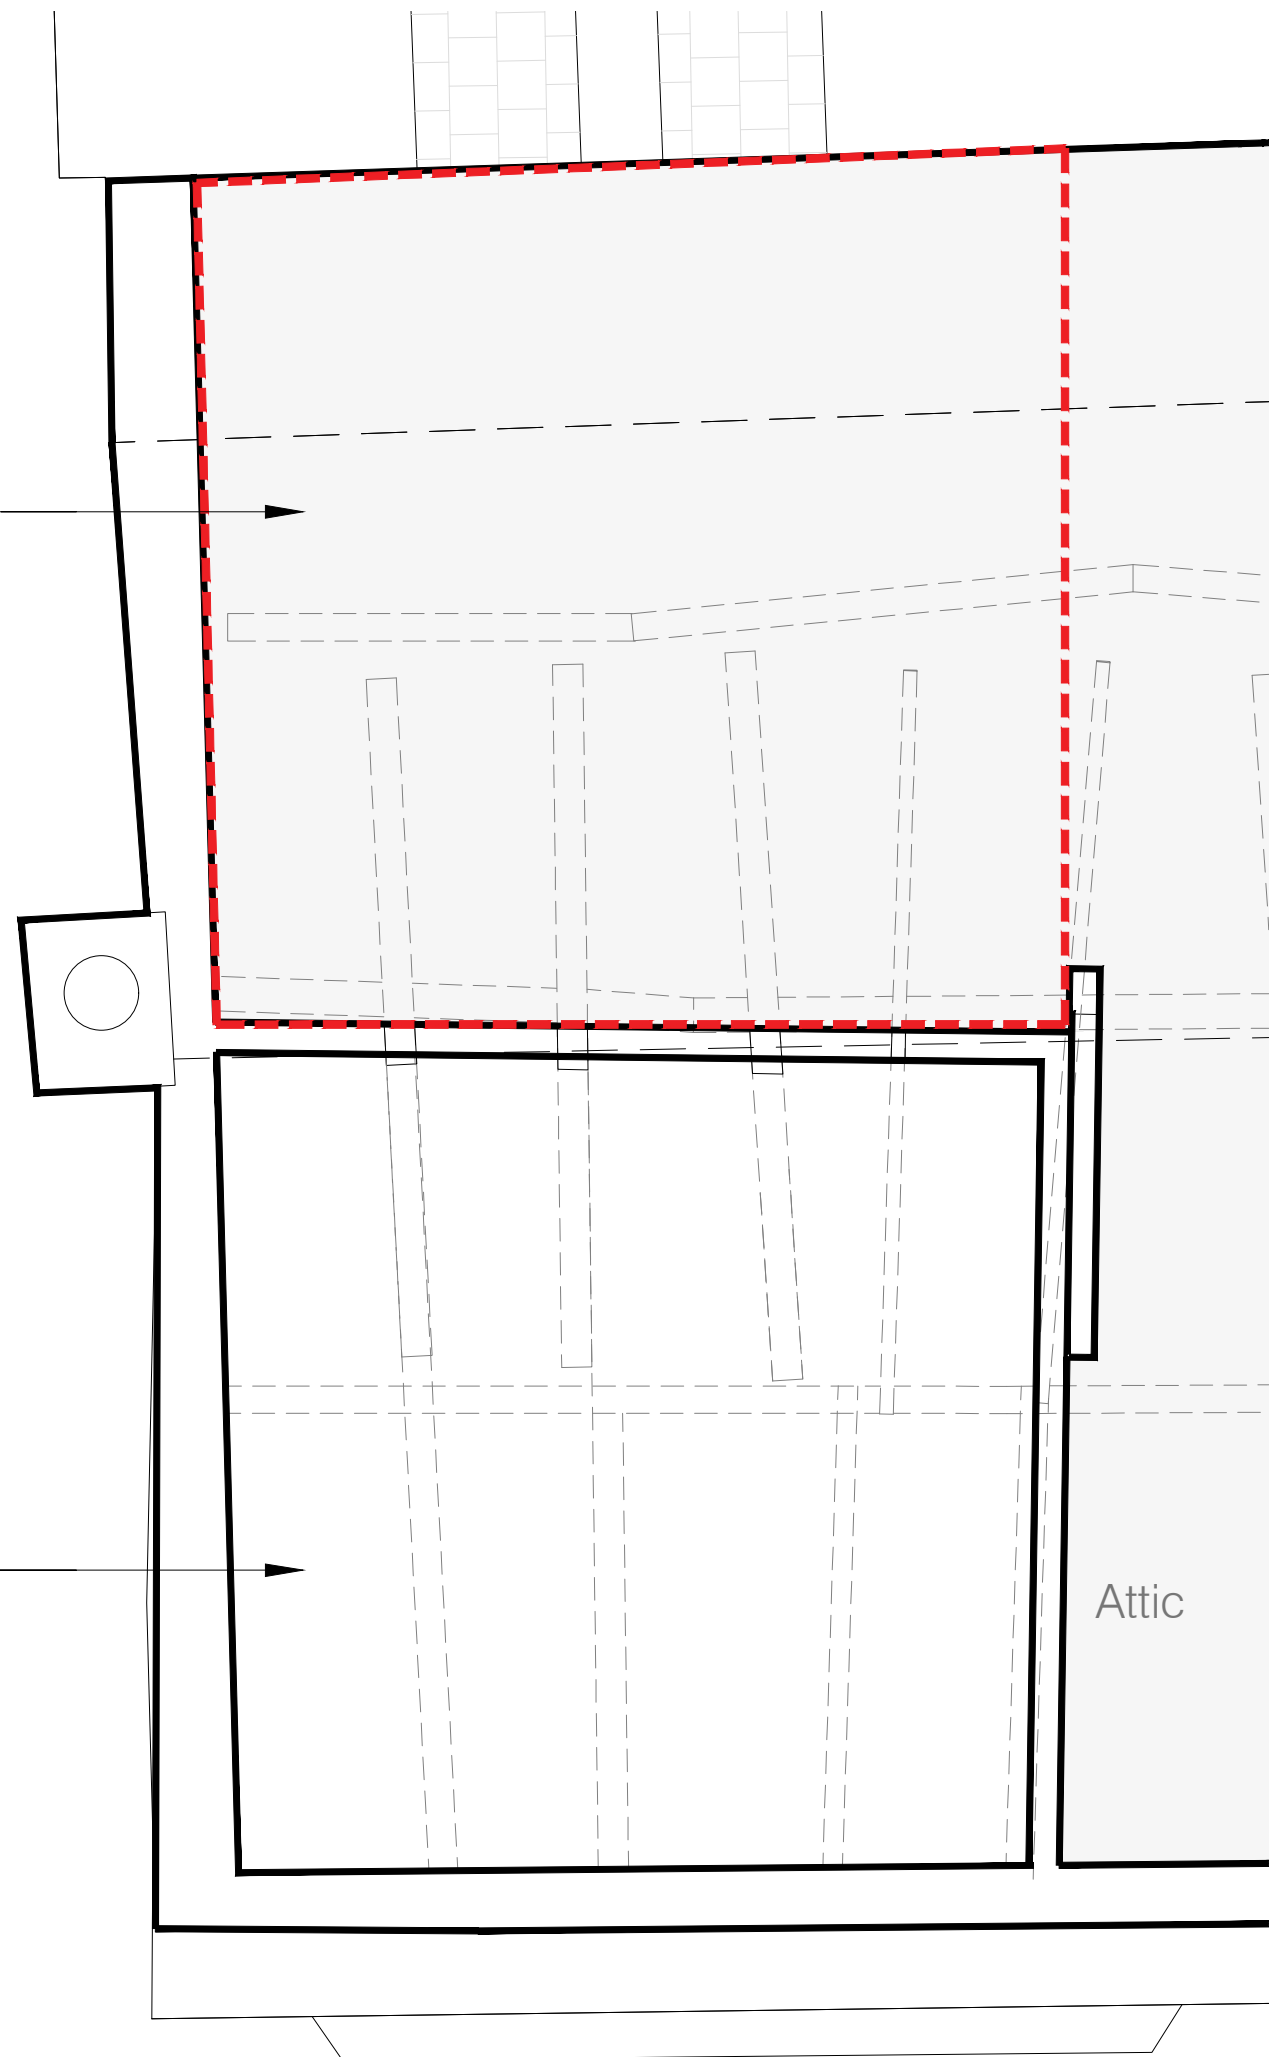


Key Plan
'As-Built' Attic Plan
Scale 1:25@A1
1:50@A3

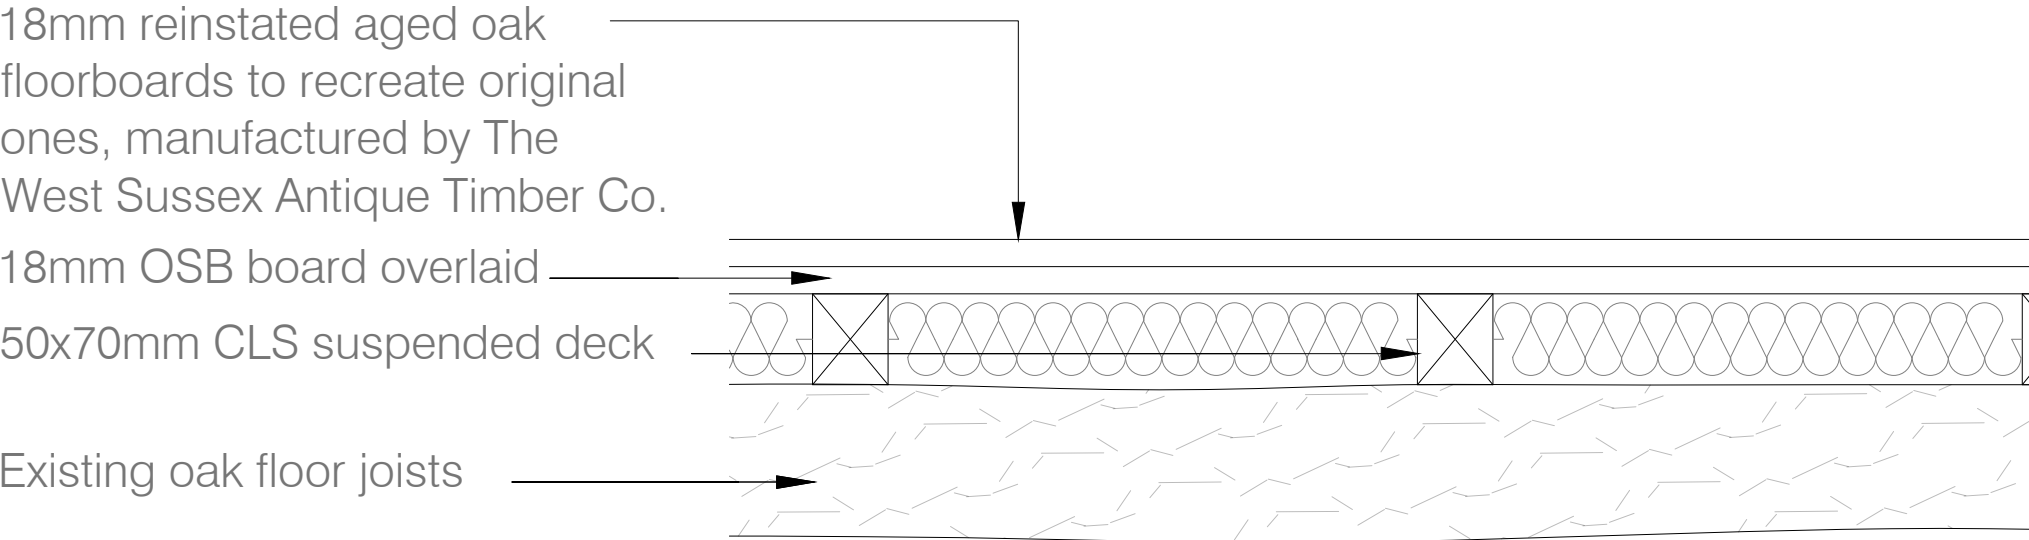


Detail 3
Proposed Attic Floor Build-Up
Scale 1:5@A1
1:10@A3

Proposed aged oak floor boards reinstated in this area. Refer to Detail 3 for proposed build-up


Implemented vaulted ceiling above bedroom.

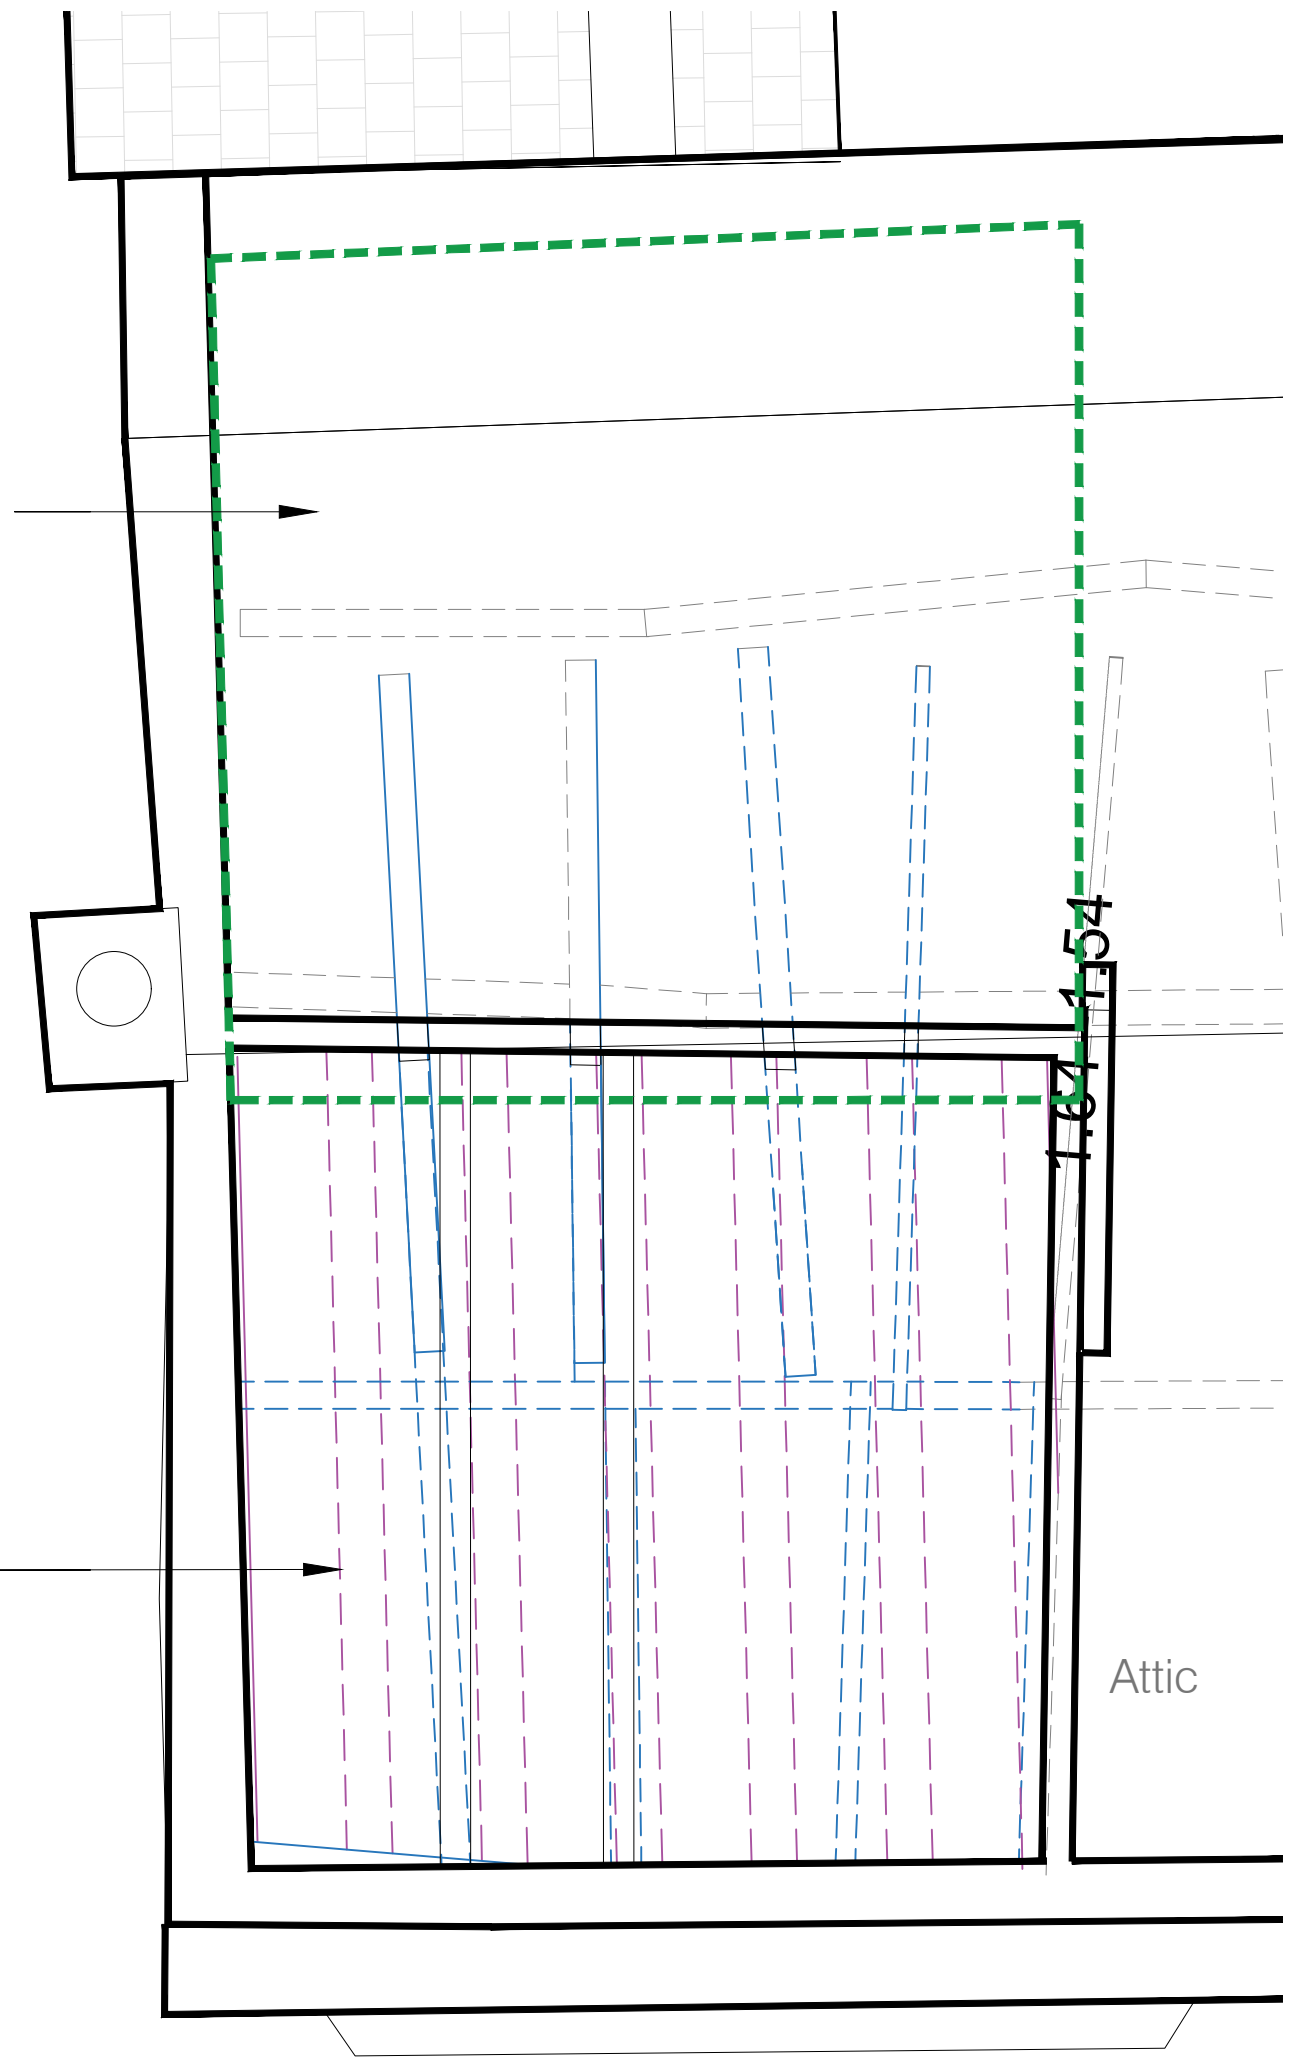

Key Plan
Proposed Attic Plan
Scale 1:25@A1
1:50@A3

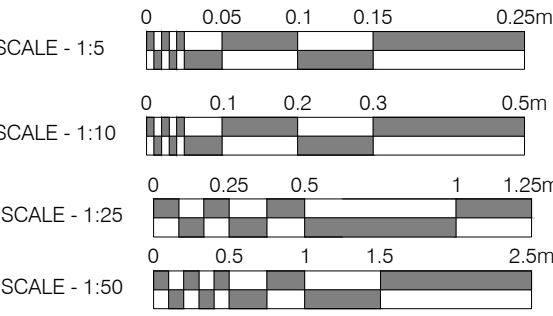

Pre-construction photographs of the existing attic floor boards in poor condition

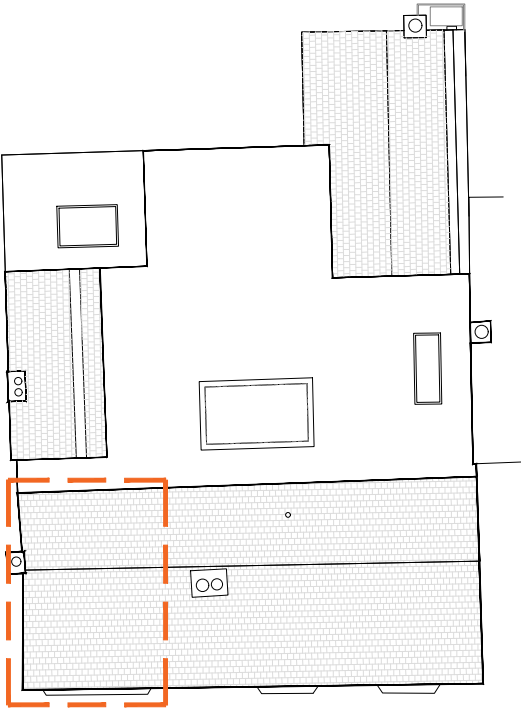

Key Plan 1:200@A1, 1:400@A3

NOTE
DRAWINGS TO BE READ IN CONJUNCTION WITH SUBMITTED DESIGN&ACCESS STATEMENT AND HERITAGE STATEMENT.

INFORMATION ON THE EXISTING AND PROPOSED MATERIALS AND BUILD-UPS WERE OBTAINED FROM THE CONTRACTOR.

PLANNING CONDITION DISCHARGE

Client:
Mr. Simon Dougall

Project Title:
107 High St, Lindfield, Haywards Heath, West Sussex, RH16 2HR

Drawing Title:
Detail Drawings:
Attic Floor Boards

Scale: 1:25@A1 1:50@A3 1:10@A3

Date: Aug 26

Drawn: KN

Checked: KW

Attic Floorboards Reinstatement:
The attic floorboards will be reinstated using high-quality aged oak to match the existing boards in species, character, appearance and finish. Timber selection, preparation and installation shall be undertaken exclusively by the specialist heritage contractor, The West Sussex Antique Timber Company.

kyson
Studio

28 Scrutton Street
London
UK
EC2A 4RP

T: +44(0) 20 7247 2462
E: enquiries@kyson.co.uk
W: www.kyson.co.uk

Project No.: 900-25
Drawing No.: 5029
Revision: -