
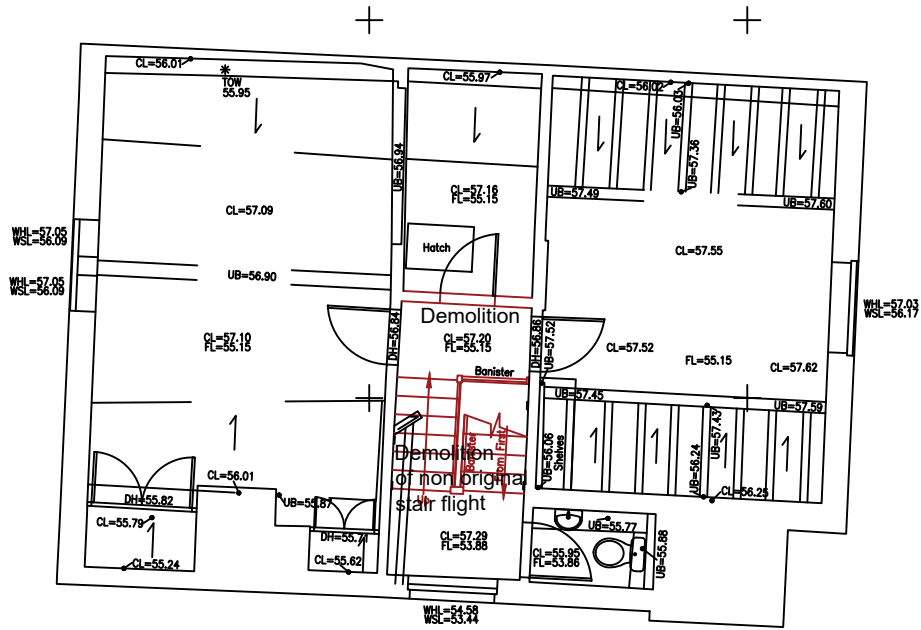
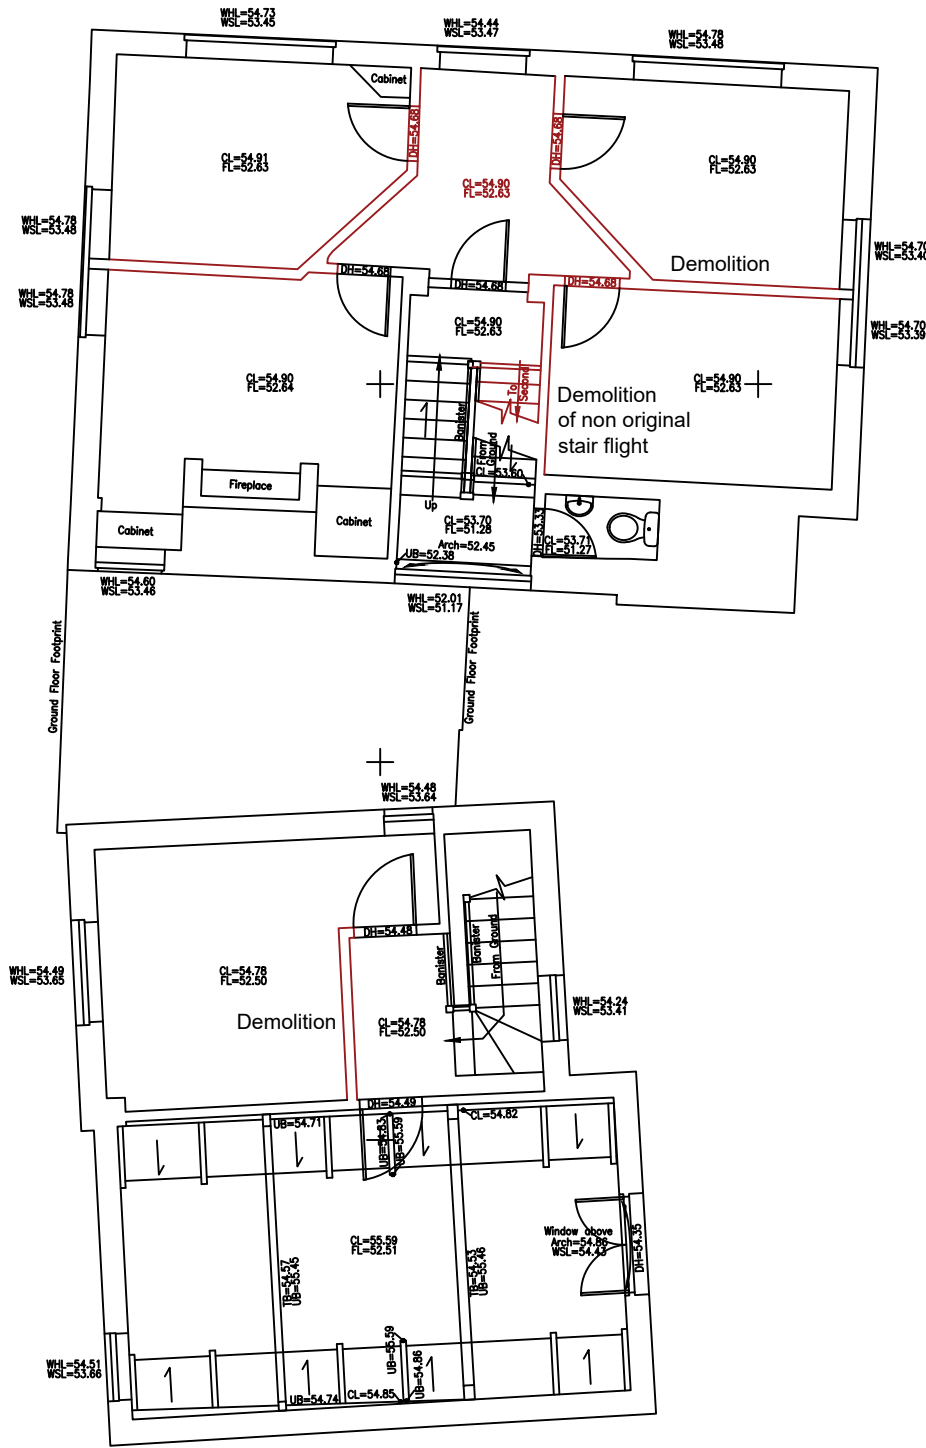


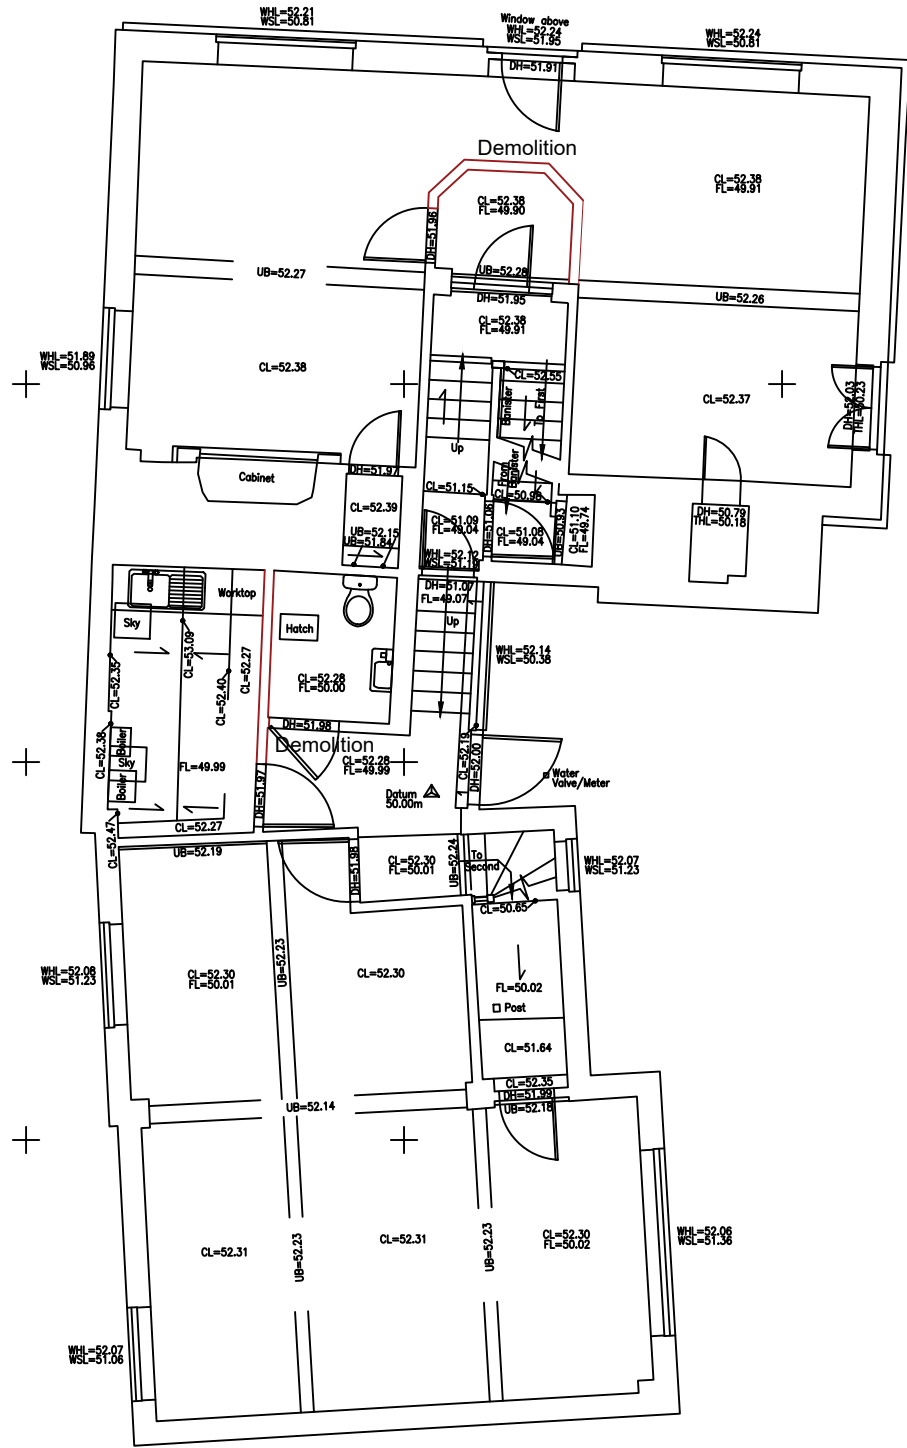

KEY

RED LINE INDICATES PROPOSED
DEMOLITION

ALL WALLS AND SECTION OF STAIRS
PROPOSED TO BE REMOVED ARE ALL
NONE ORIGINAL TO THE BUILDING

PROJECT :
hampton house, judges close,
east grinstead, rh19 3ap

DRAWING :
floor plans proposed demolition

DRAWING STATUS :
planning submission

JOB NO :
den - 324

DRAWING NO :
710

SCALE :
1/100 @ A2

DATE :
august 2025

DRAWN BY :
pc

REVISIONS :
none



SCALE :
0 1m 2m 4m

1. THIS DRAWING IS THE COPYRIGHT OF B+C ARCHITECTURE. IT IS NOT TO BE REPRODUCED IN ANY MANNER WITHOUT THE WRITTEN CONSENT OF B+C ARCHITECTURE. 2. DO NOT SCALE FROM THIS DRAWING FOR DIMENSIONS. 3. ALL DIMENSIONS TO BE VERIFIED ON SITE PRIOR TO WORK. 4. THIS DRAWING IS TO BE USED IN CONJUNCTION WITH THE SPECIFICATION AND THE SCHEDULE OF WORKS. 5. ALL WORKS TO BE COMPLETED IN ACCORDANCE WITH THE BUILDING REGULATIONS. 6. ALL WORKS TO BE COMPLETED IN ACCORDANCE WITH THE BUILDING REGULATIONS.