
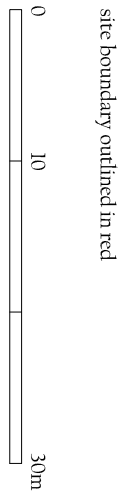
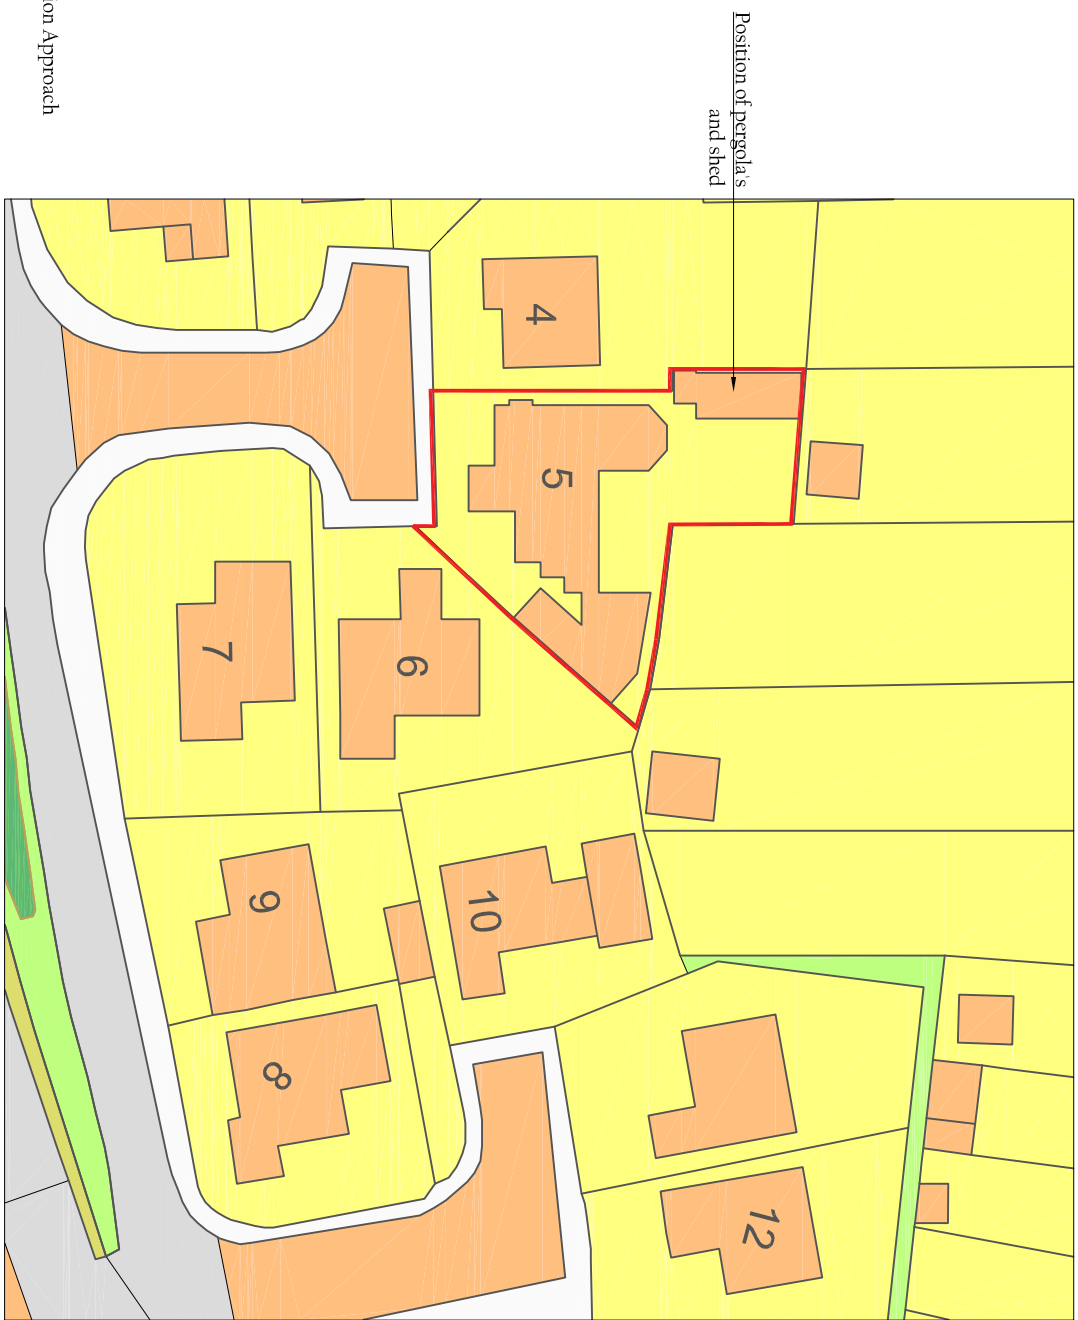



5 CLAYTON PARK, HASSOCKS, WEST SUSSEX, BN6 8JQ

Retrospective application for a pergola with operable louvre panels. Fabric blinds to north and east side and glass sliding panels facing the garden on the east side of the pergola and a bespoke wooden shed with door opening into garden. All in a sunken garden, lower than main back garden.



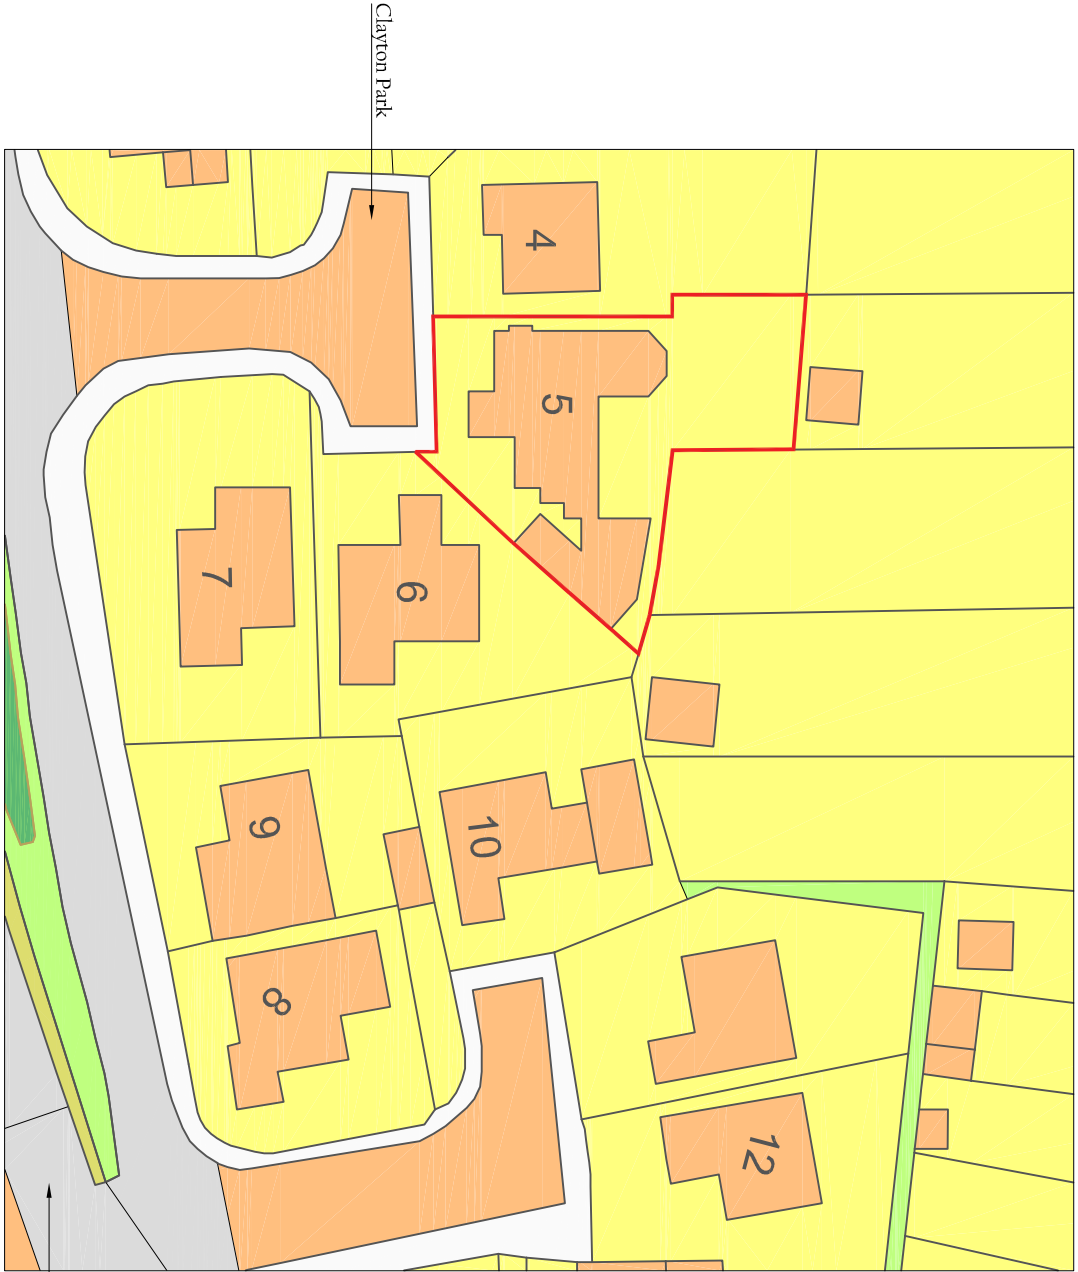


SCALE BAR 1:500

NB: Location plan and block plan are based on Ordnance Survey information

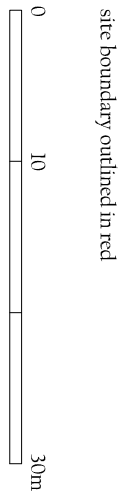

SCALE BAR 1:500

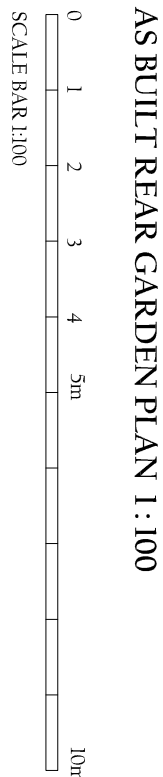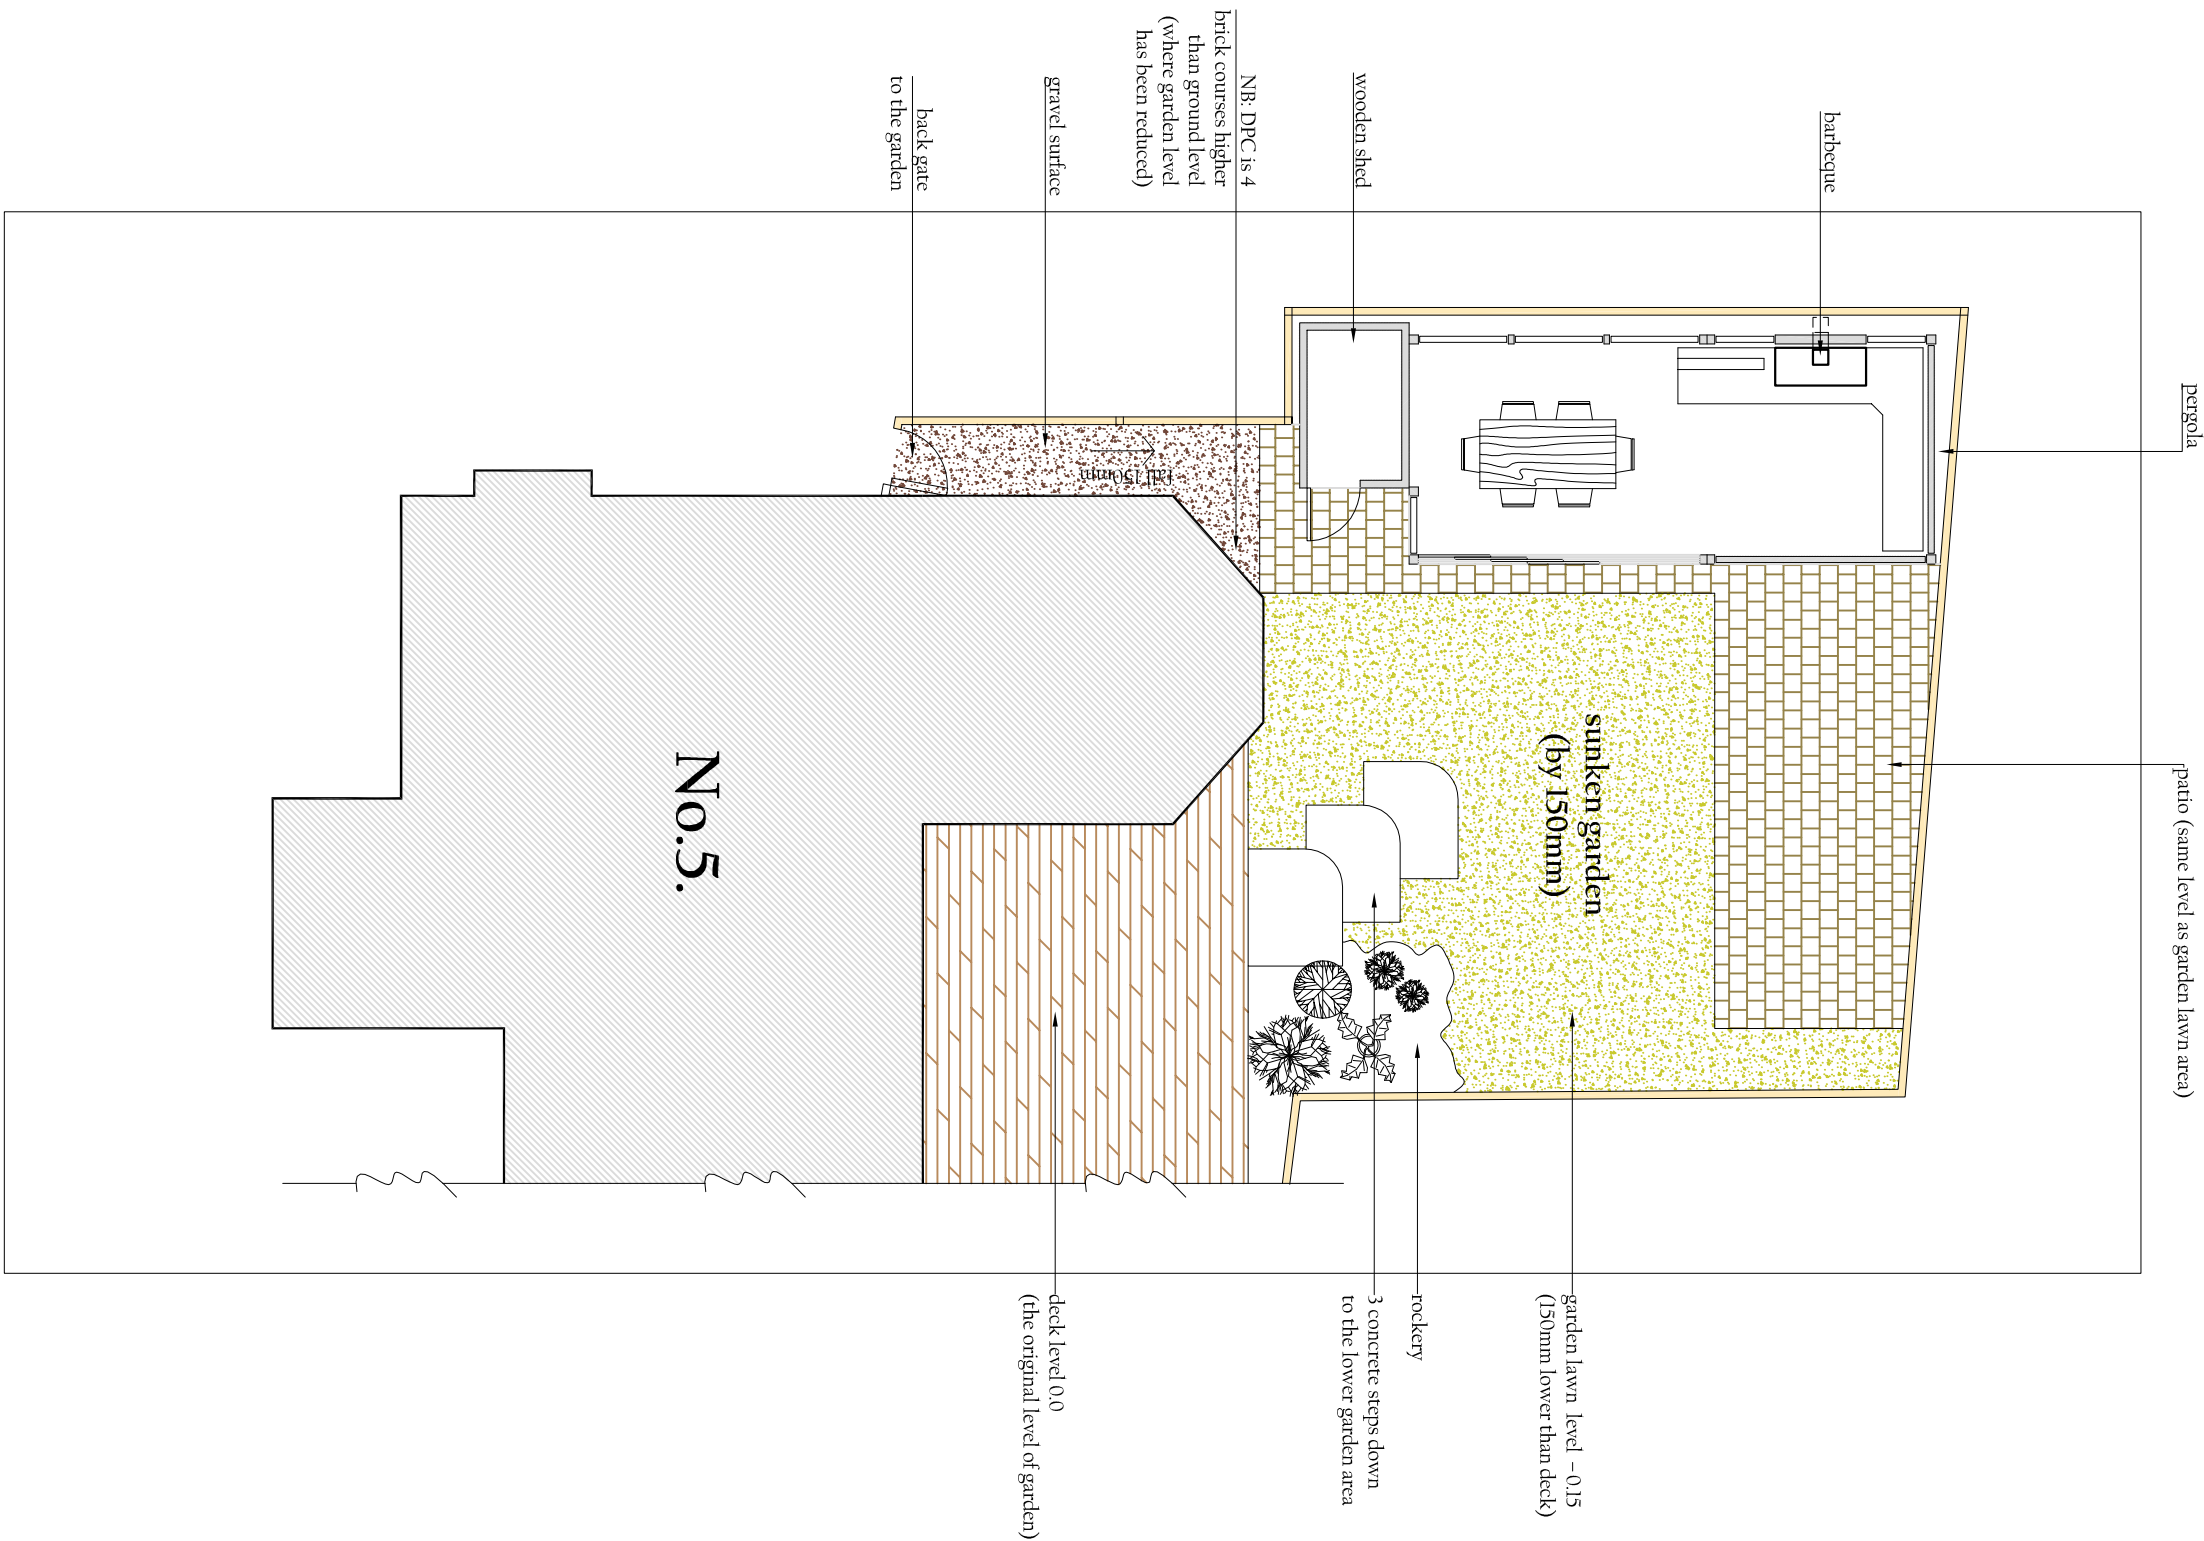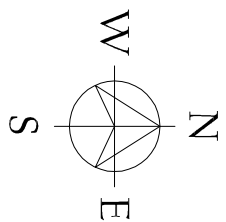

AS BUILT REAR GARDEN PLAN 1 : 100

SCALE BAR 1:100