




Retrospective application for a pergola with operable louvre panels. Fabric blinds to north and east side and glass sliding panels facing the garden on the east side of the pergola and a bespoke wooden shed with door opening into garden. All in a sunken garden, lower than main back garden.

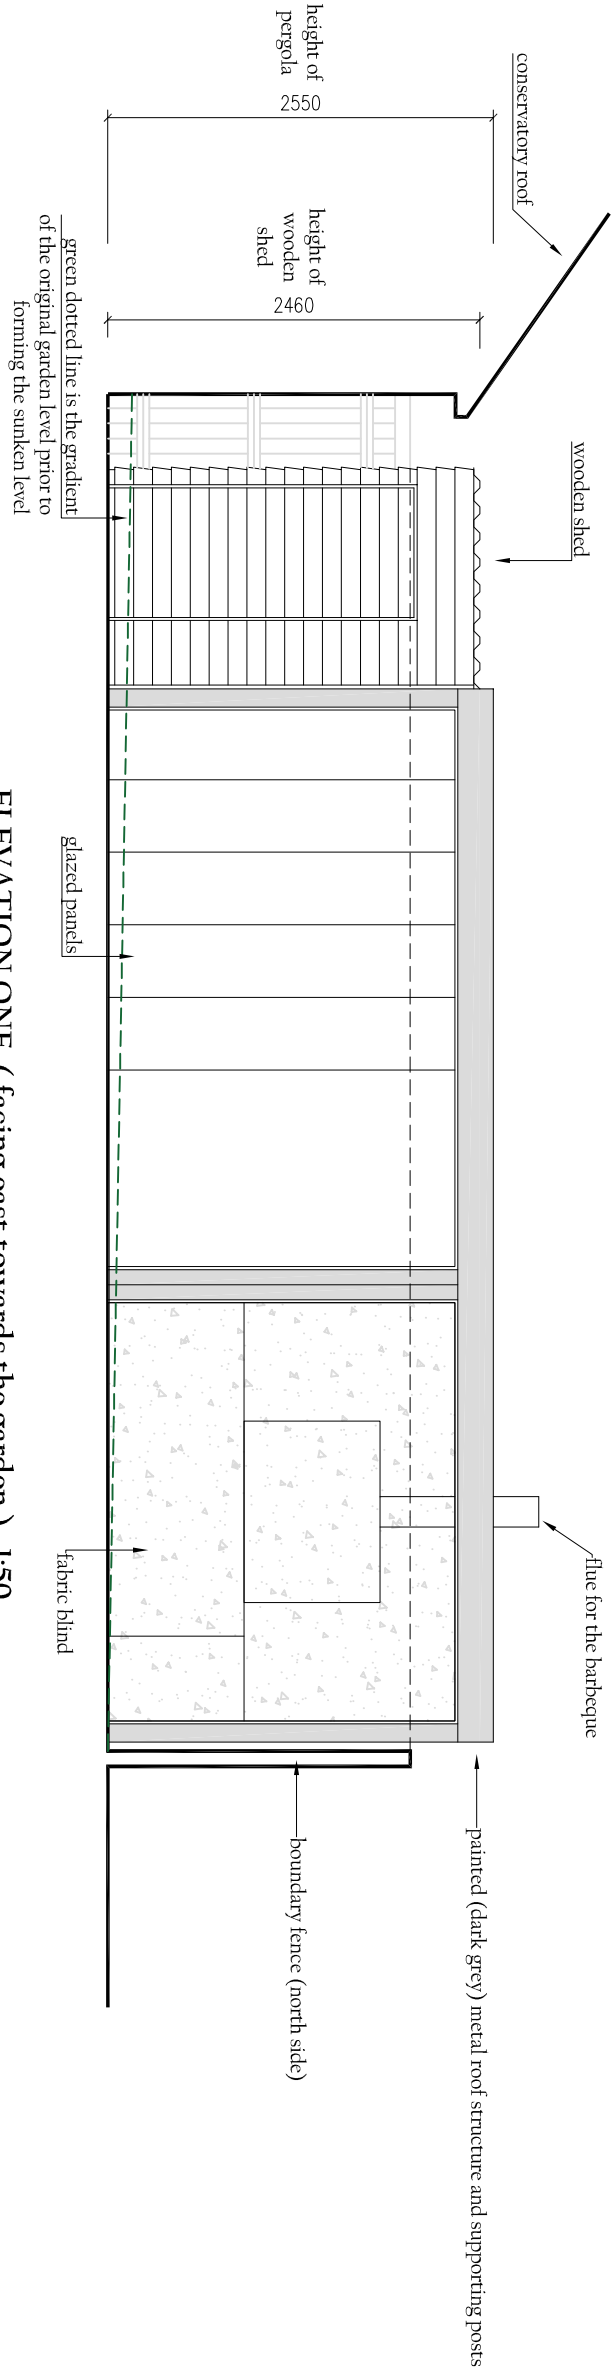


ELEVATION ONE (facing east towards the garden) 1:50

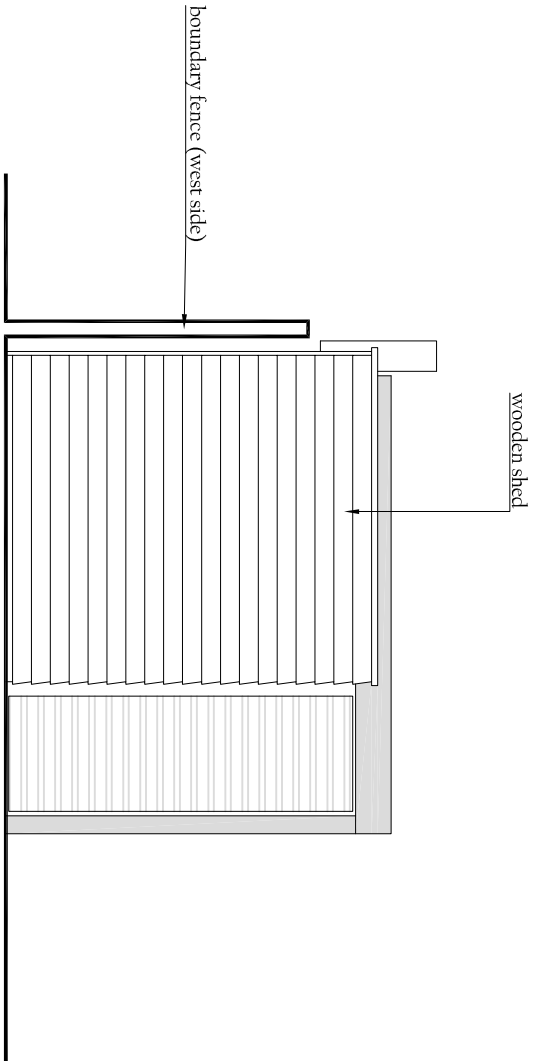


ELEVATION THREE (facing south) 1:50

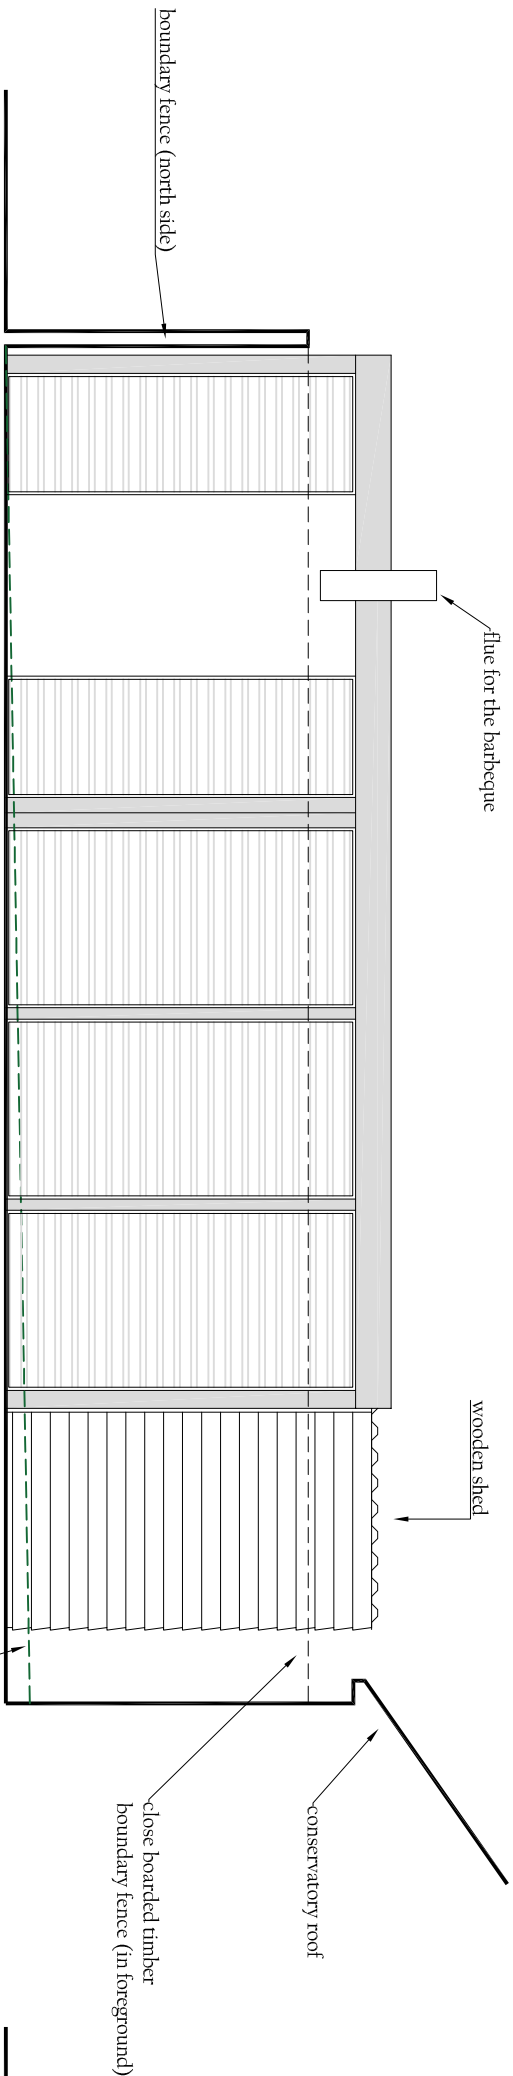

ELEVATION TWO (facing west towards the boundary fence) 1:50

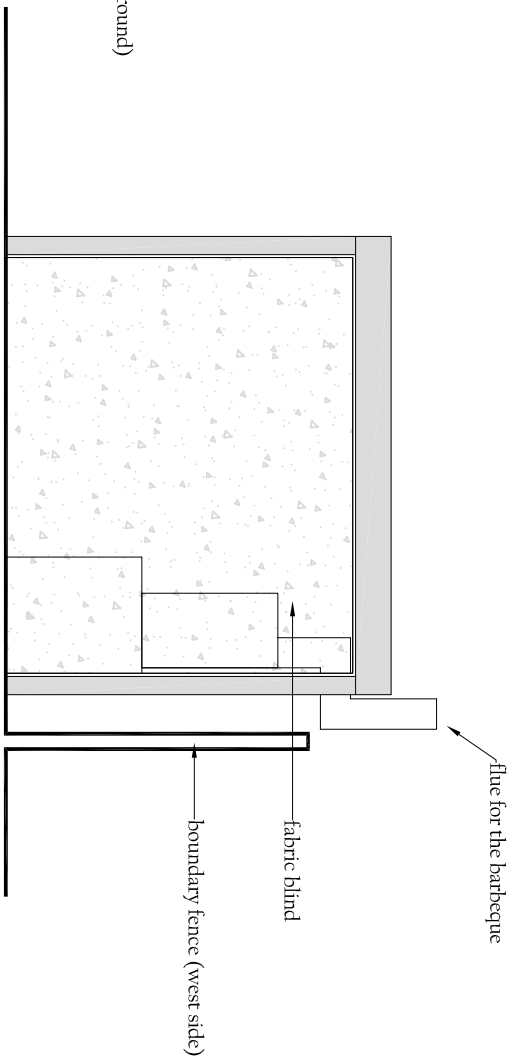

ELEVATION FOUR (facing north) 1:50

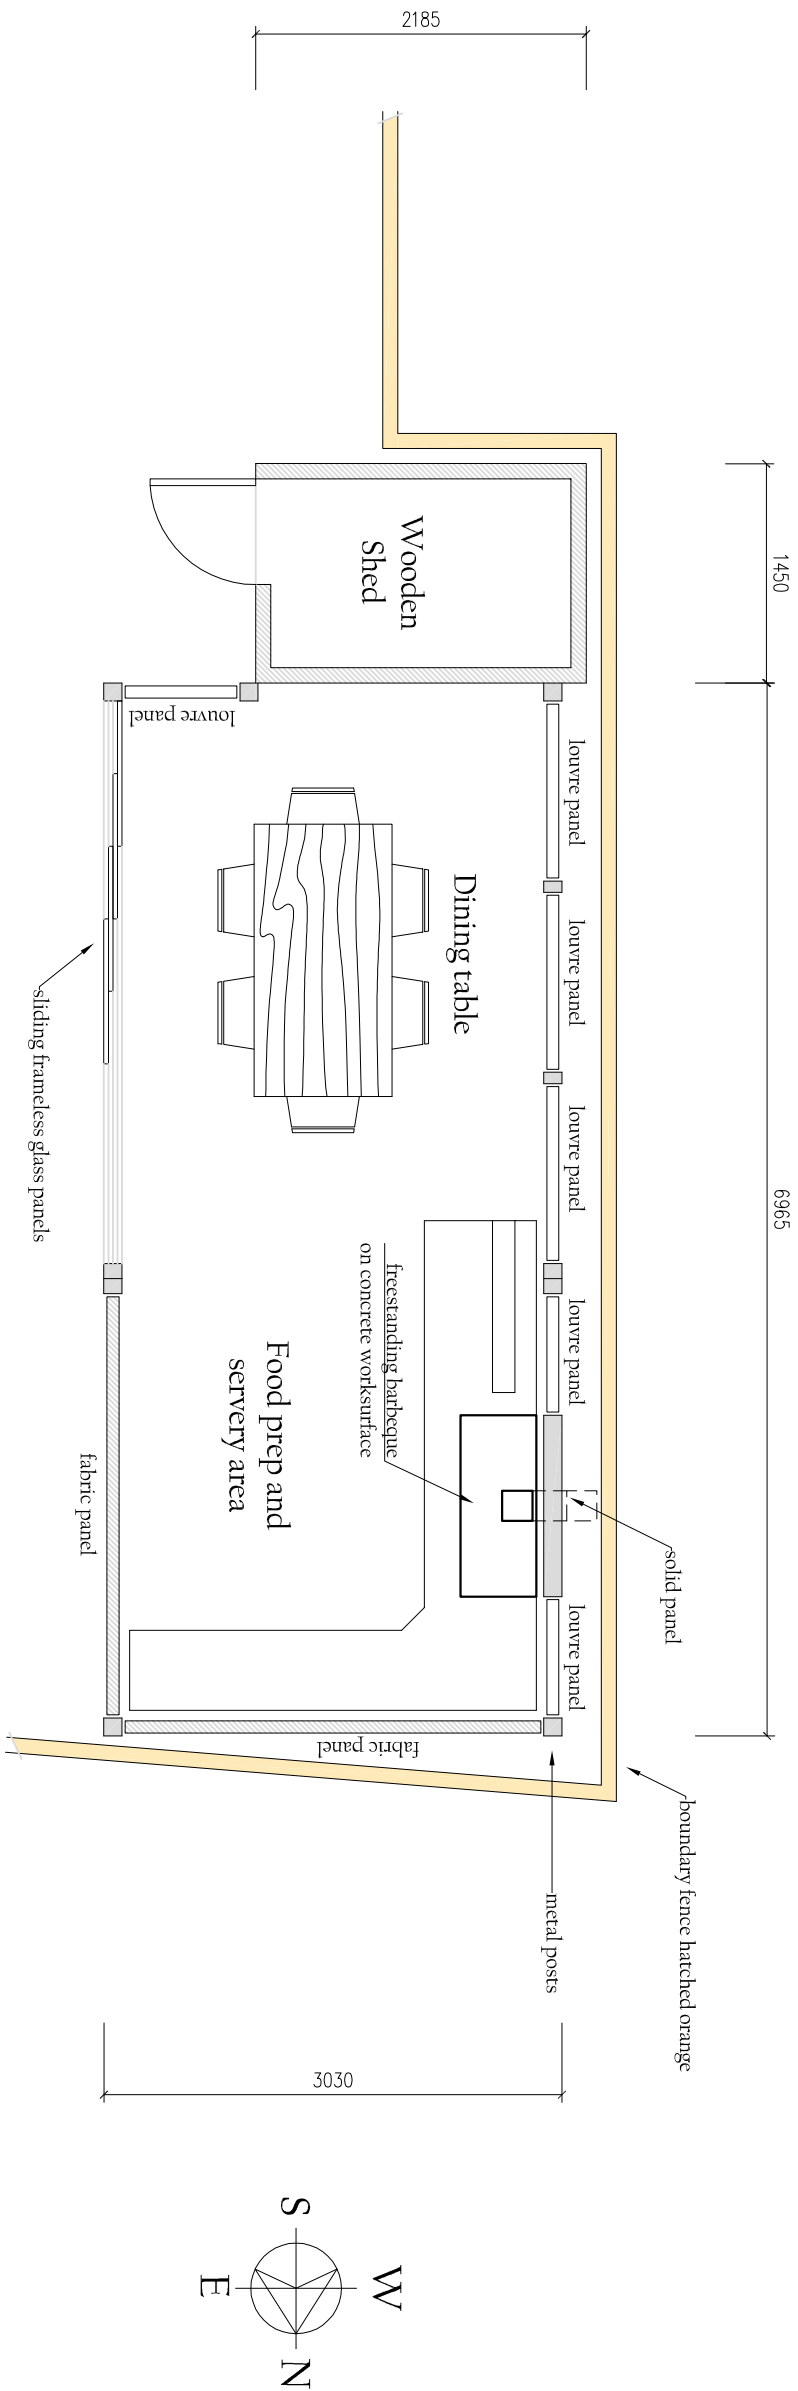

FLOOR PLAN 1:50

AS BUILT PLANS AND ELEVATIONS

JAMES BRECKELL : ARCHITECT : ARB : RIBA

89 Old Fort Road, Shoreham by Sea, West Sussex, BN43 5HA Tel 07733 268 297, Email: james@breckell.co.uk

