





Approved Scheme
First Floor Plan
Scale 1:25:A1
1:50@A3

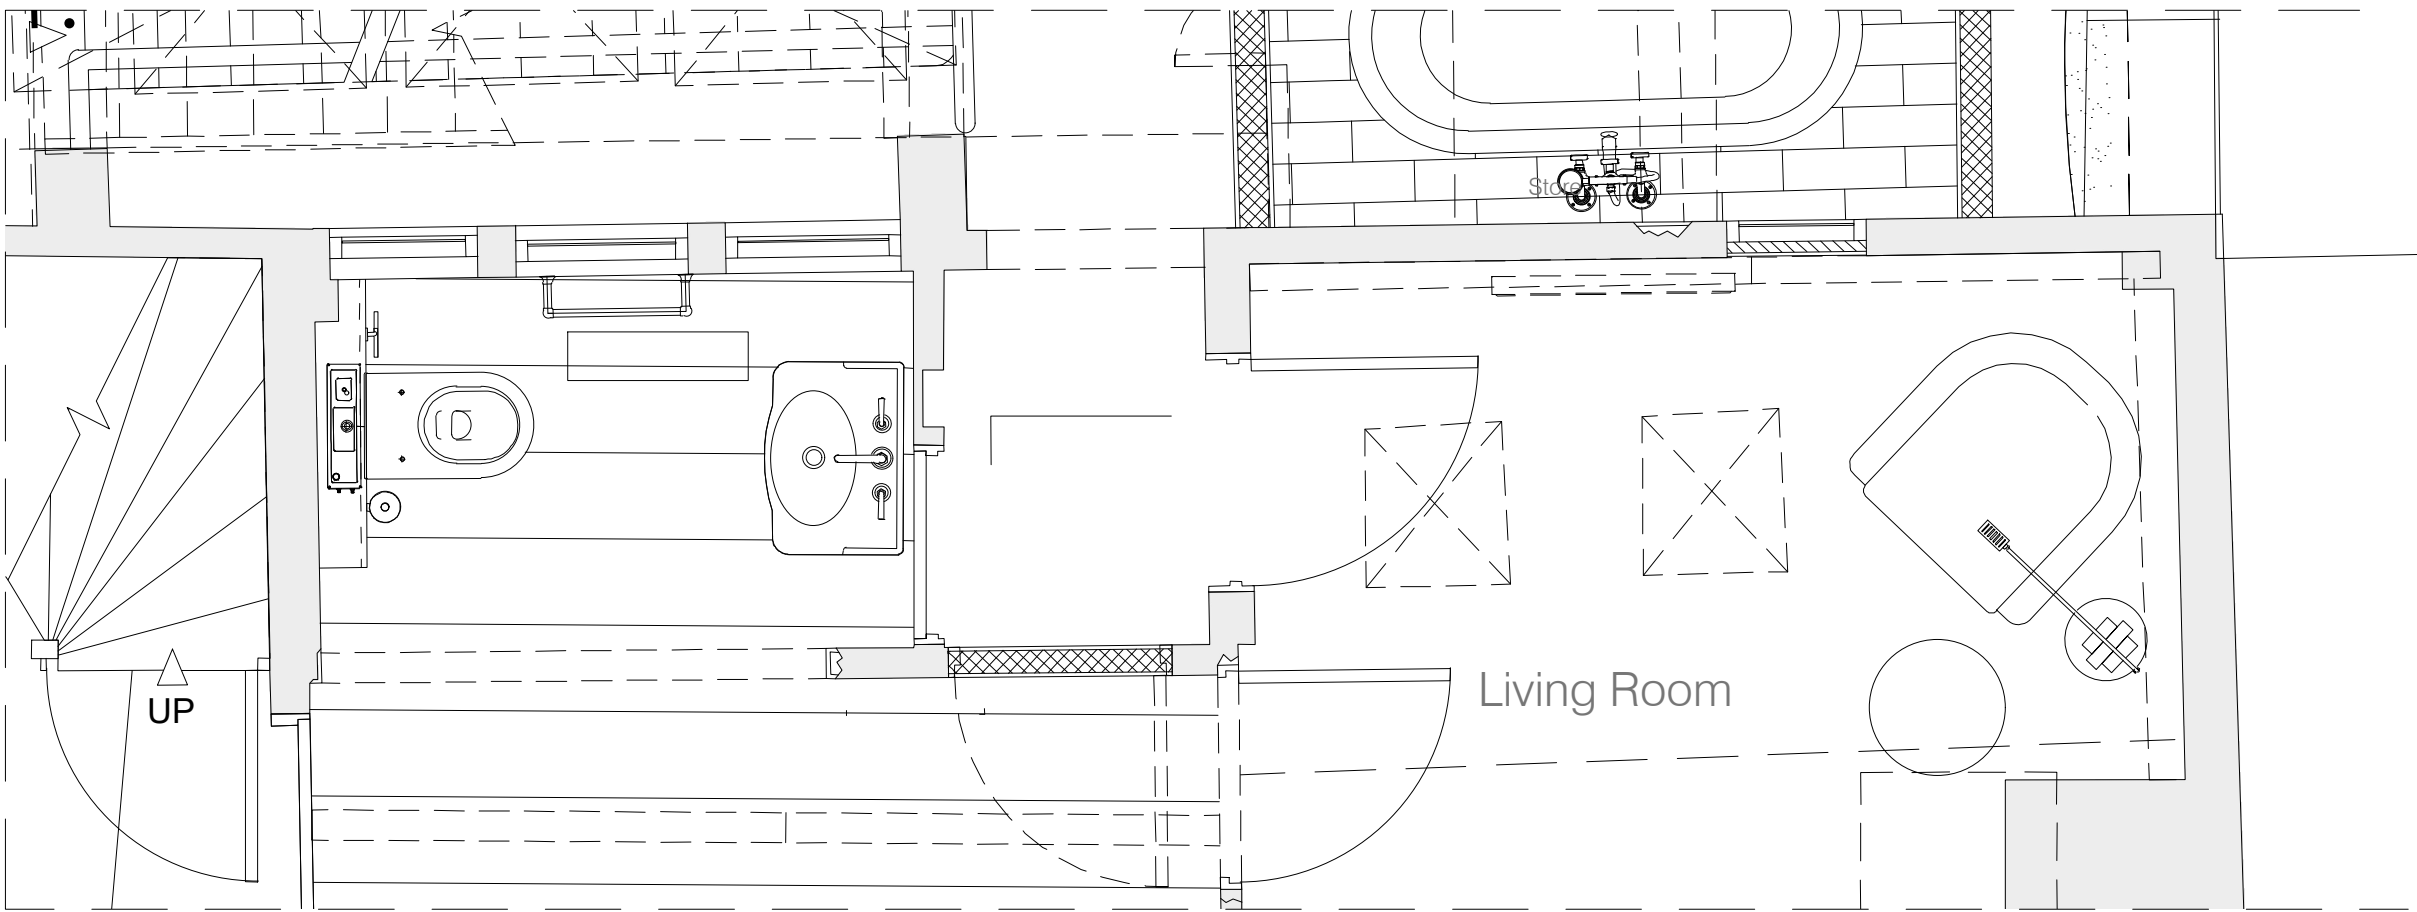


Proposed
First Floor Plan
Scale 1:25:A1
1:50@A3

Existing, not original, casement windows to box framing of 15th century west wall removed. Openings filled in with timber stud framing, wood wool boards and lime plaster.

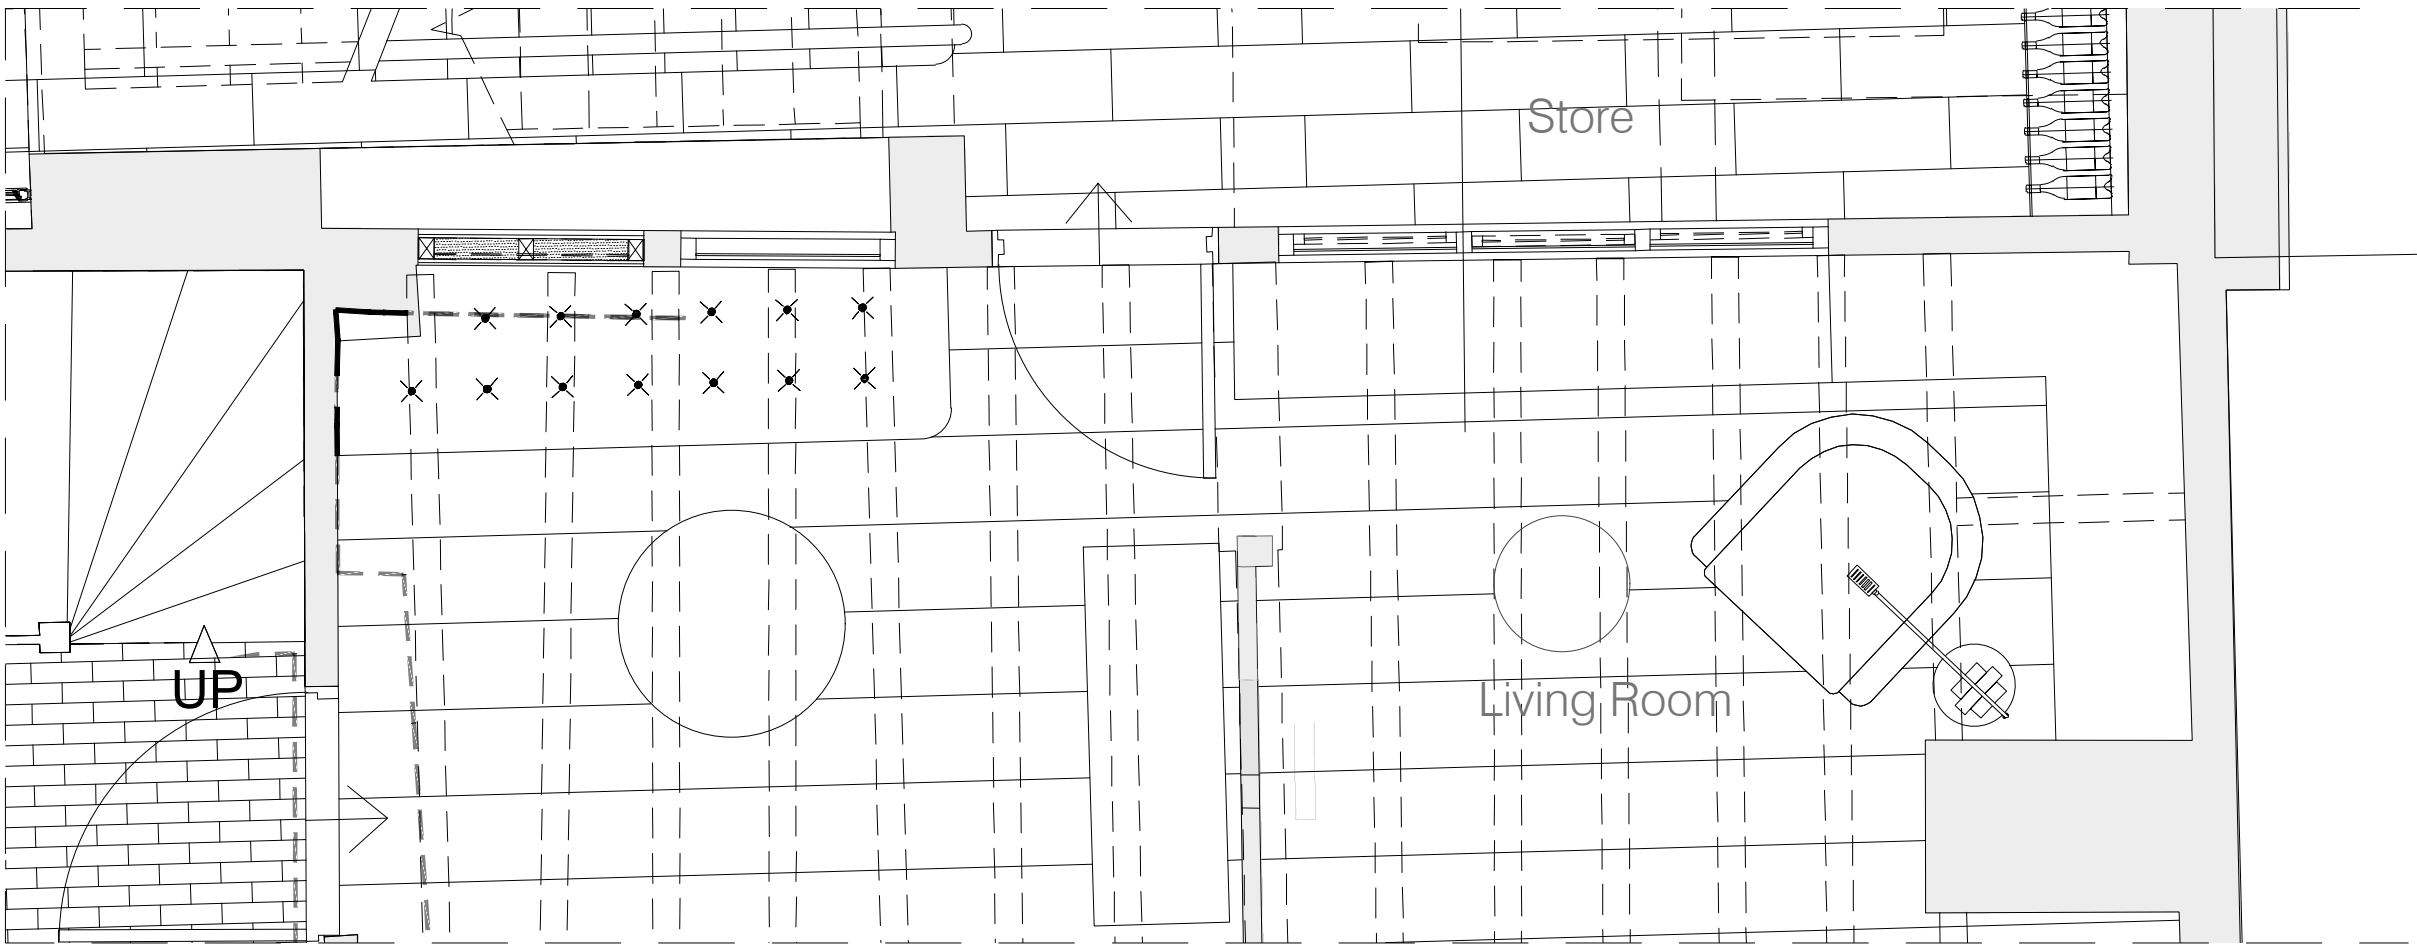


Approved Scheme
Ground Floor Plan
Scale 1:25:A1
1:50@A3

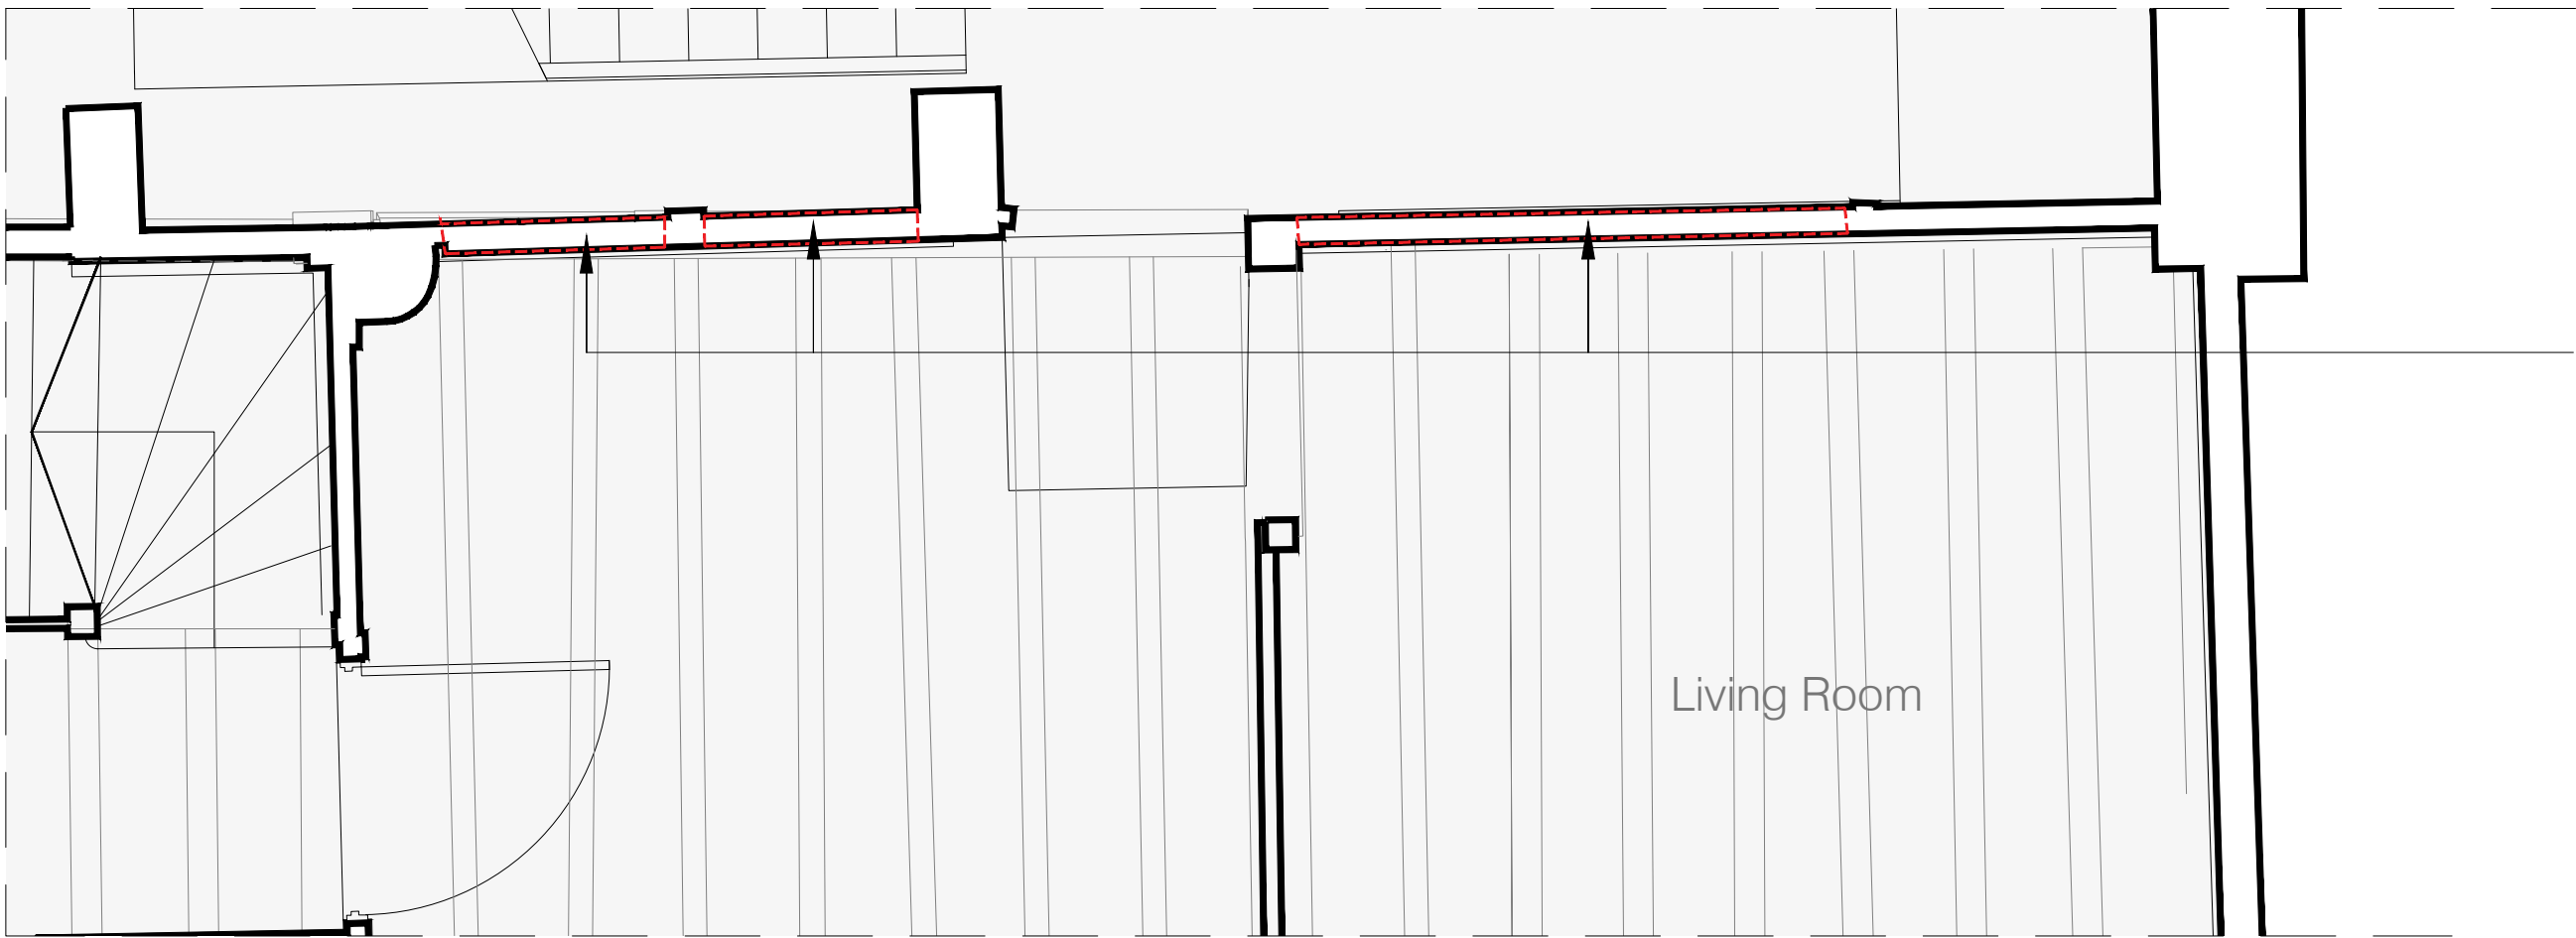

Proposed
Ground Floor Plan
Scale 1:25:A1
1:50@A3

Existing, not original, casement windows to box framing of 15th century west wall removed. Openings filled in with timber stud framing, wood wool boards and lime plaster.

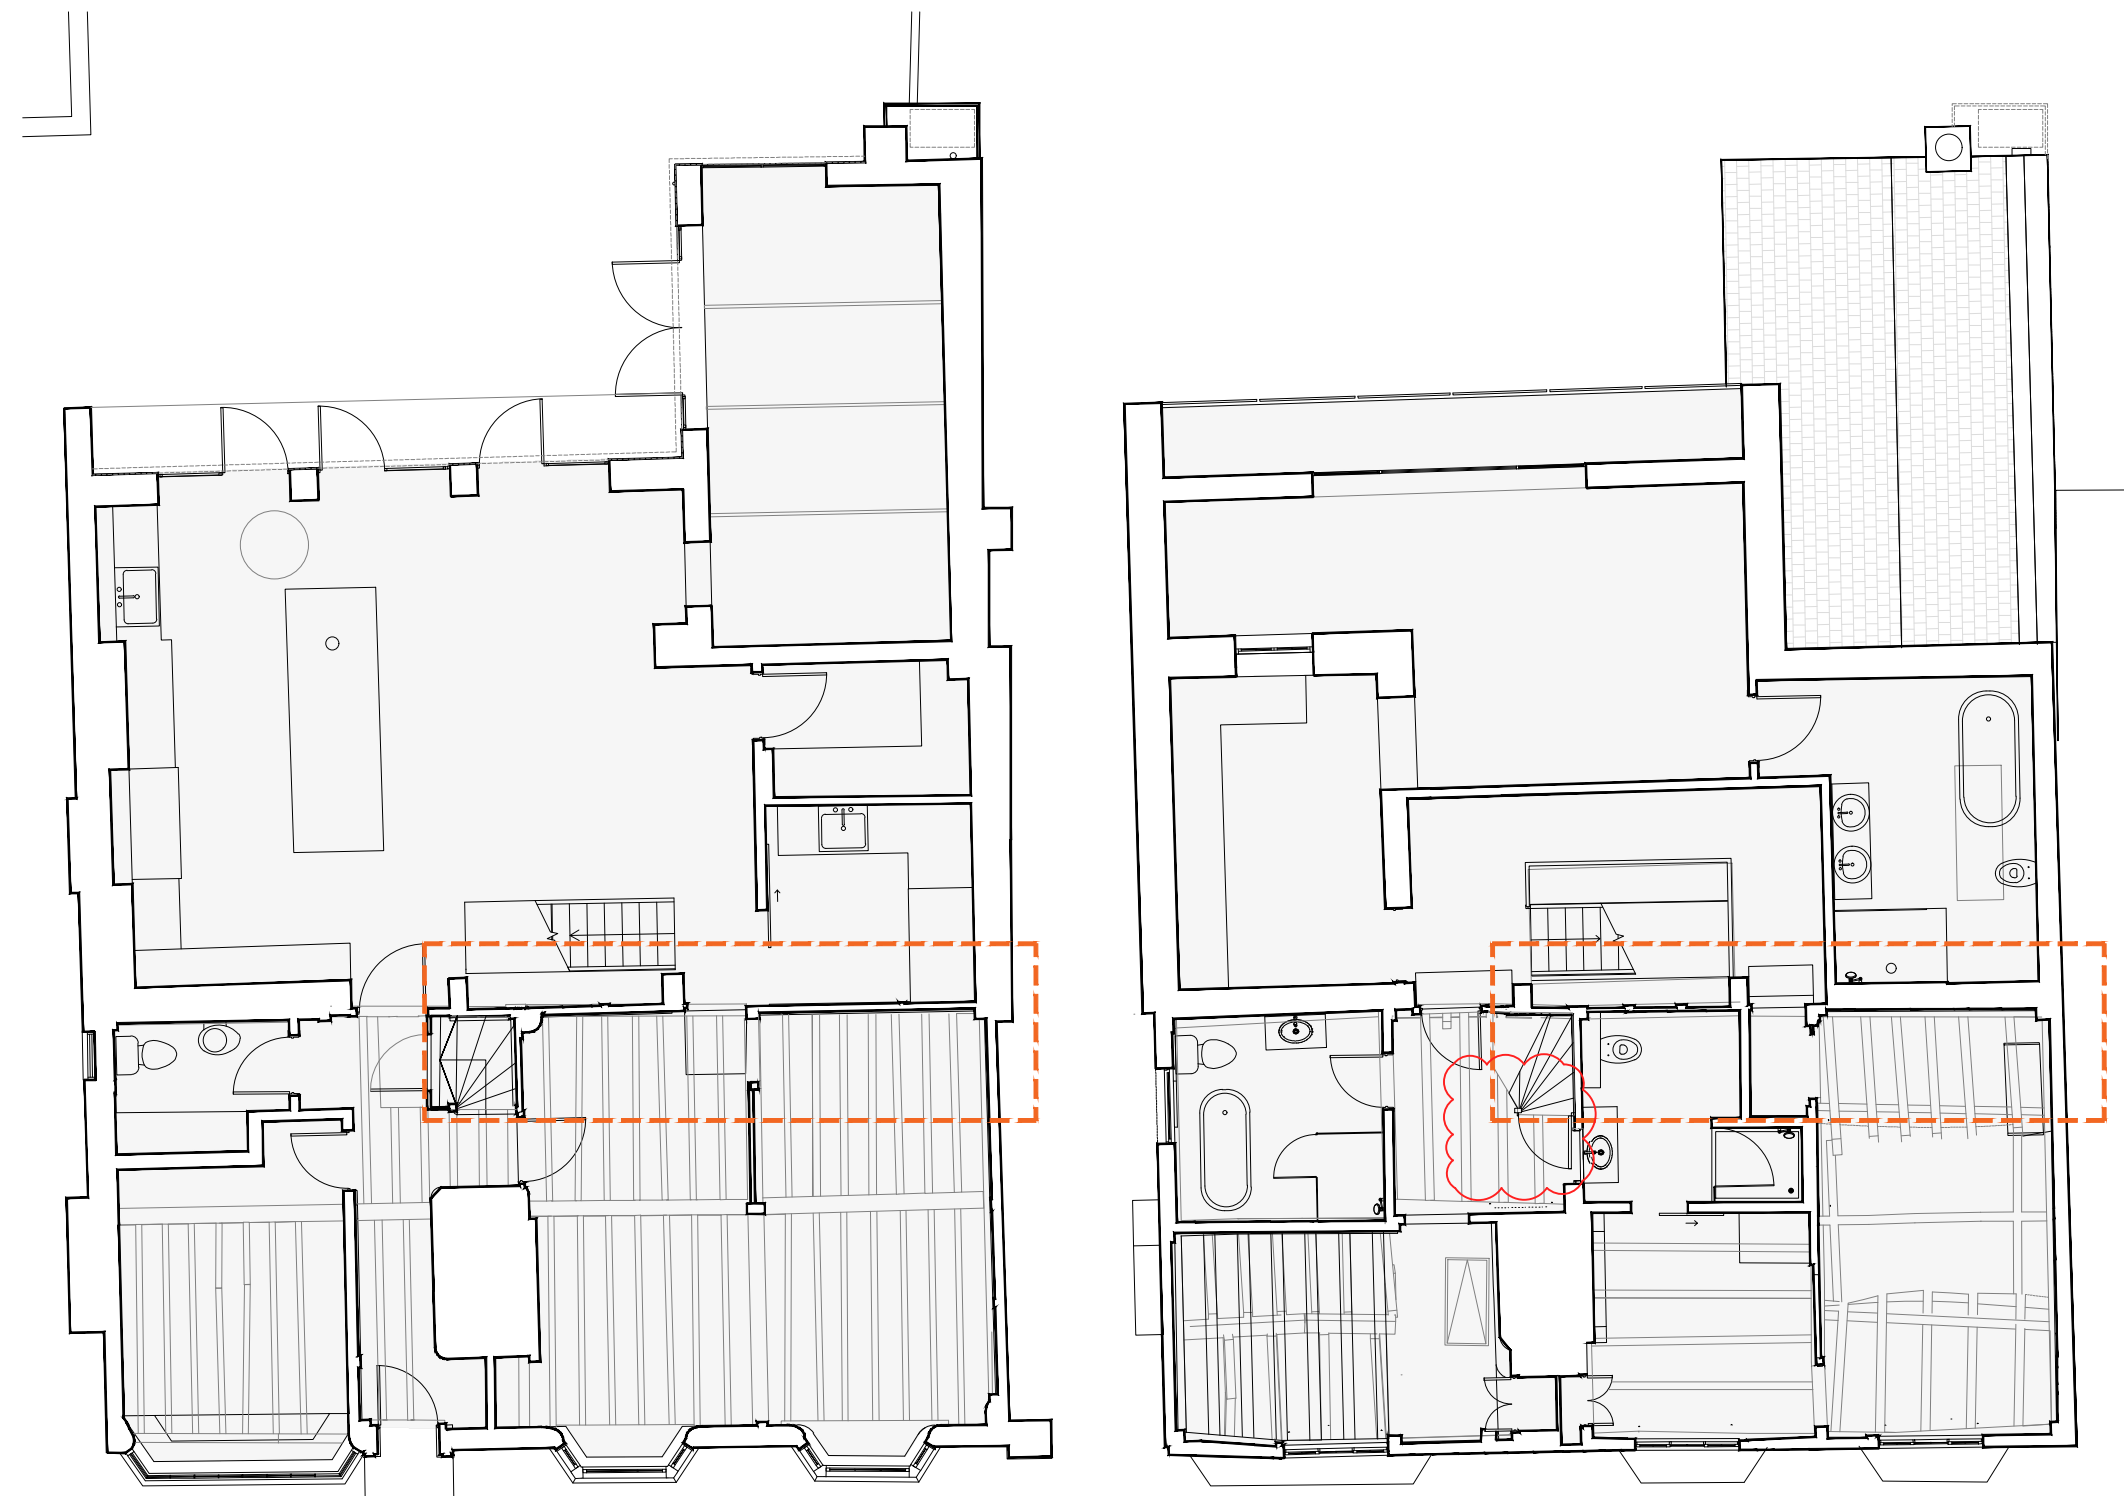

KEY Ground Floor Plan

KEY First Floor Plan



Before: uPVC casement windows before removal



After: Infilled west wall, view from new extension living room

KEY:

Highlighted difference between Approved Scheme and 'As-Built'/Proposed Scheme

Rev.				Comments				By:				Date:			
A				Amendments as clouded.				KN				Nov 25			
B				First floor staircase access door reinstated				KN				Feb 25			

Scale:				Date:				Drawn:				Checked:			
1:25@A1				Apr 25				KN				KW			
1:50@A3															

Project No.:			Drawing No.:			Revision:		
900-25			5020			B		

LISTED BUILDING
CONSENT

Client:
Mr. Simon Dougall

Project Title:
107 High St, Lindfield, Haywards Heath, West Sussex, RH16 2HR

Drawing Title:
Detail Drawings:
Removal of Internal Casement Windows

Scale:
1:25@A1
1:50@A3

Date:
Apr 25

Drawn:
KN

Checked:
KW

kyson
Studio

28 Scrutton Street
London
UK
EC2A 4RP

T: +44(0) 20 7247 2462
E: enquiries@kyson.co.uk
W: www.kyson.co.uk