




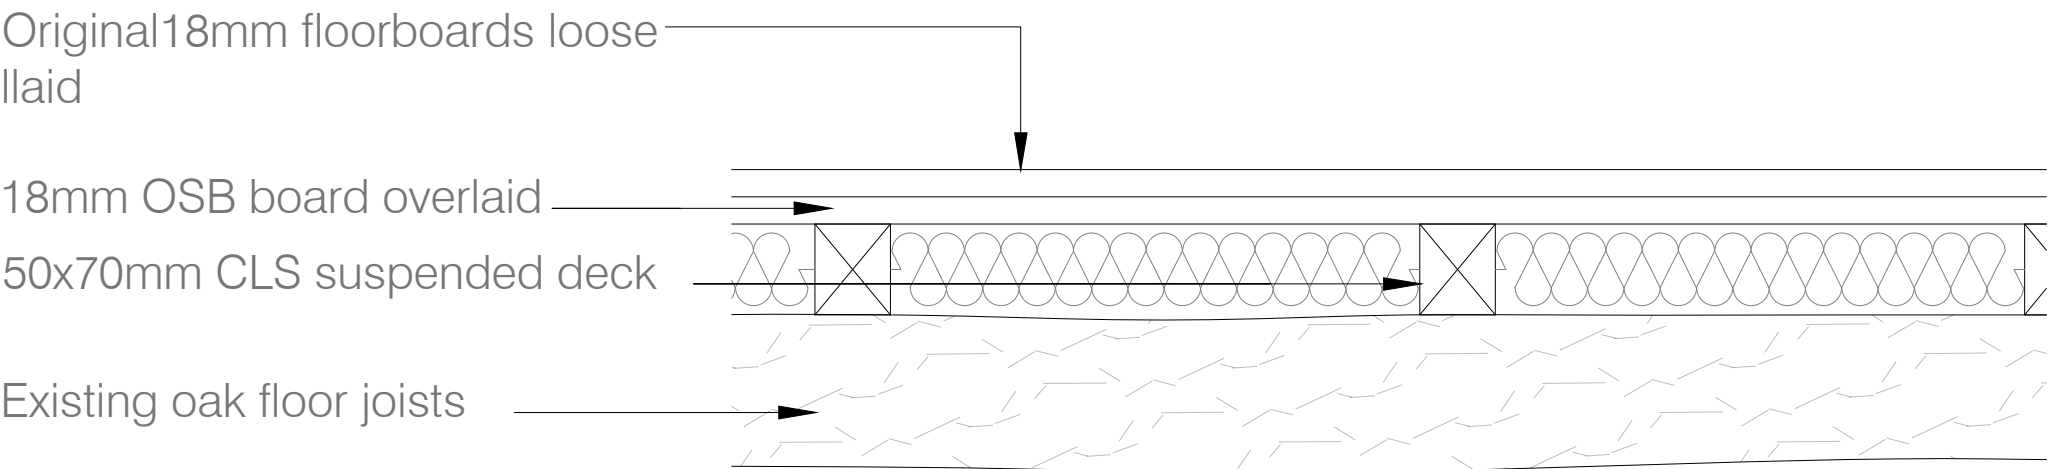

Detail 1
Existing Attic Floor Build-Up
Scale 1:5@A1
1:10@A3

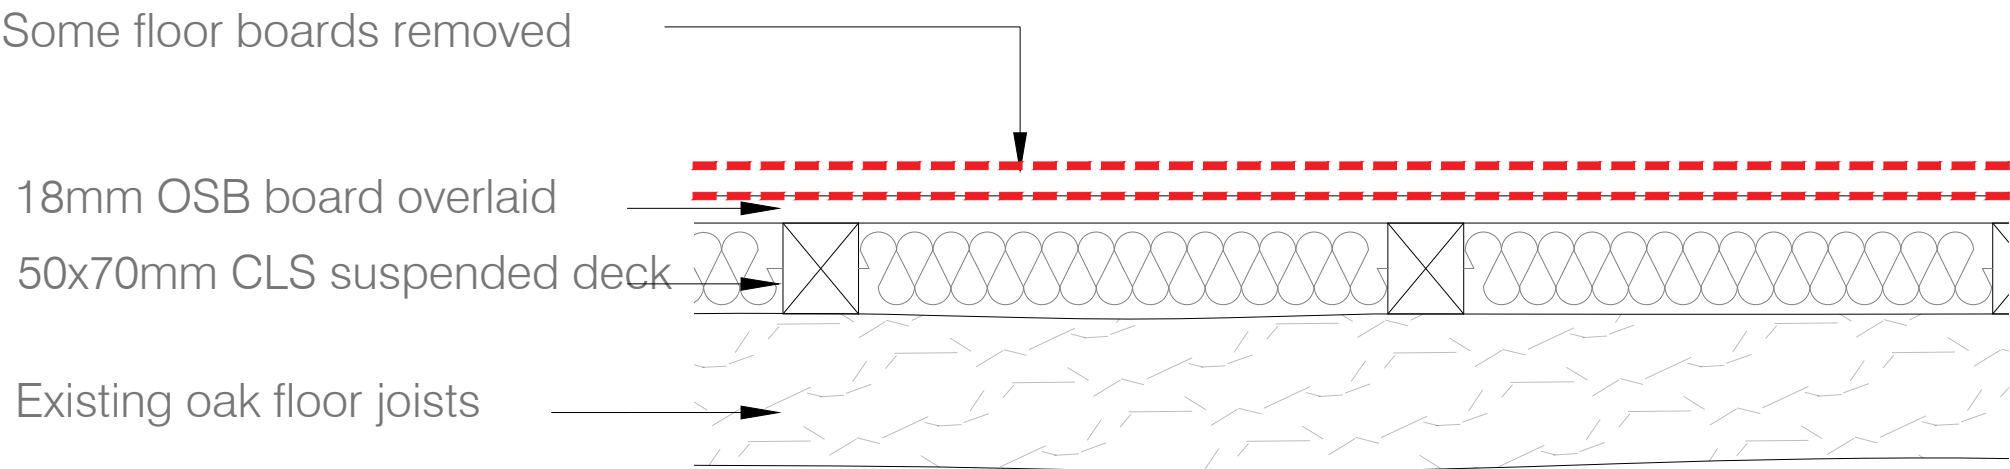


Detail 2
'As Built' Attic Floor Build-Up
Scale 1:5@A1
1:10@A3

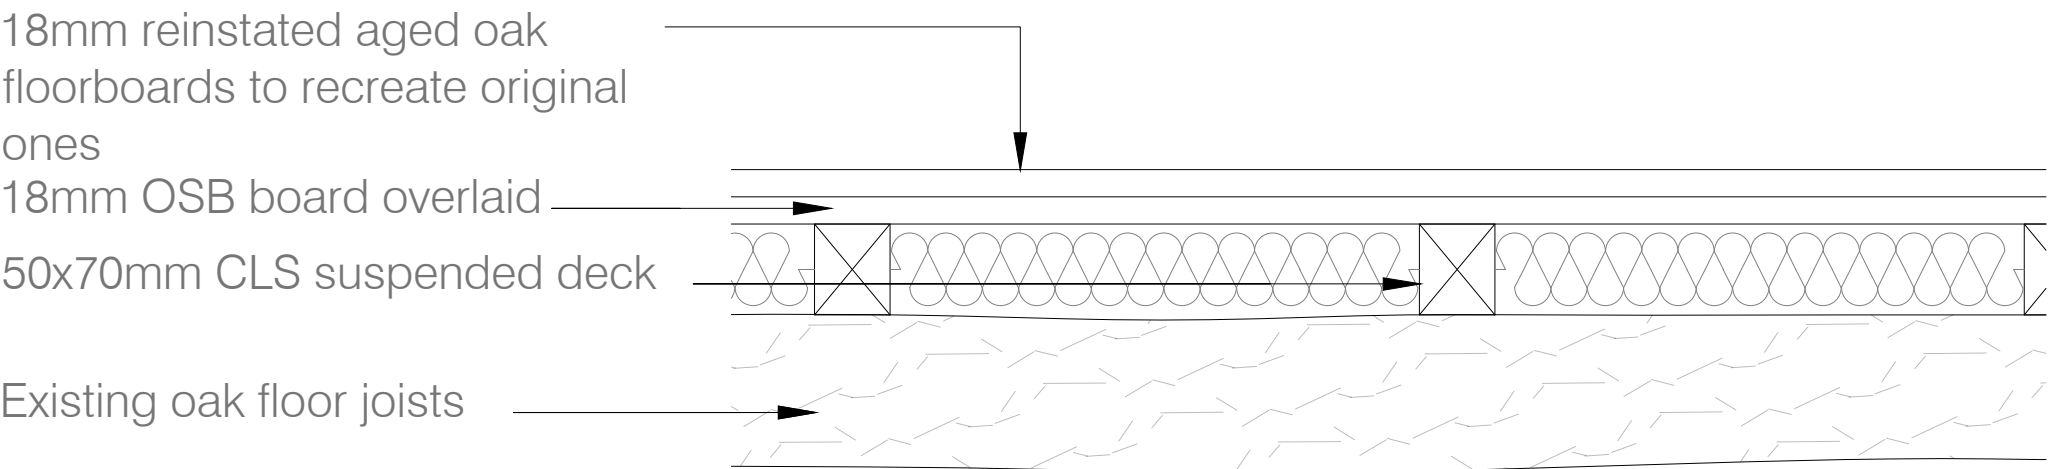


Detail 3
Proposed Attic Floor Build-Up
Scale 1:5@A1
1:10@A3

Existing area of floor build-up finished with OSB board. Refer to detail 01 for existing build-up.

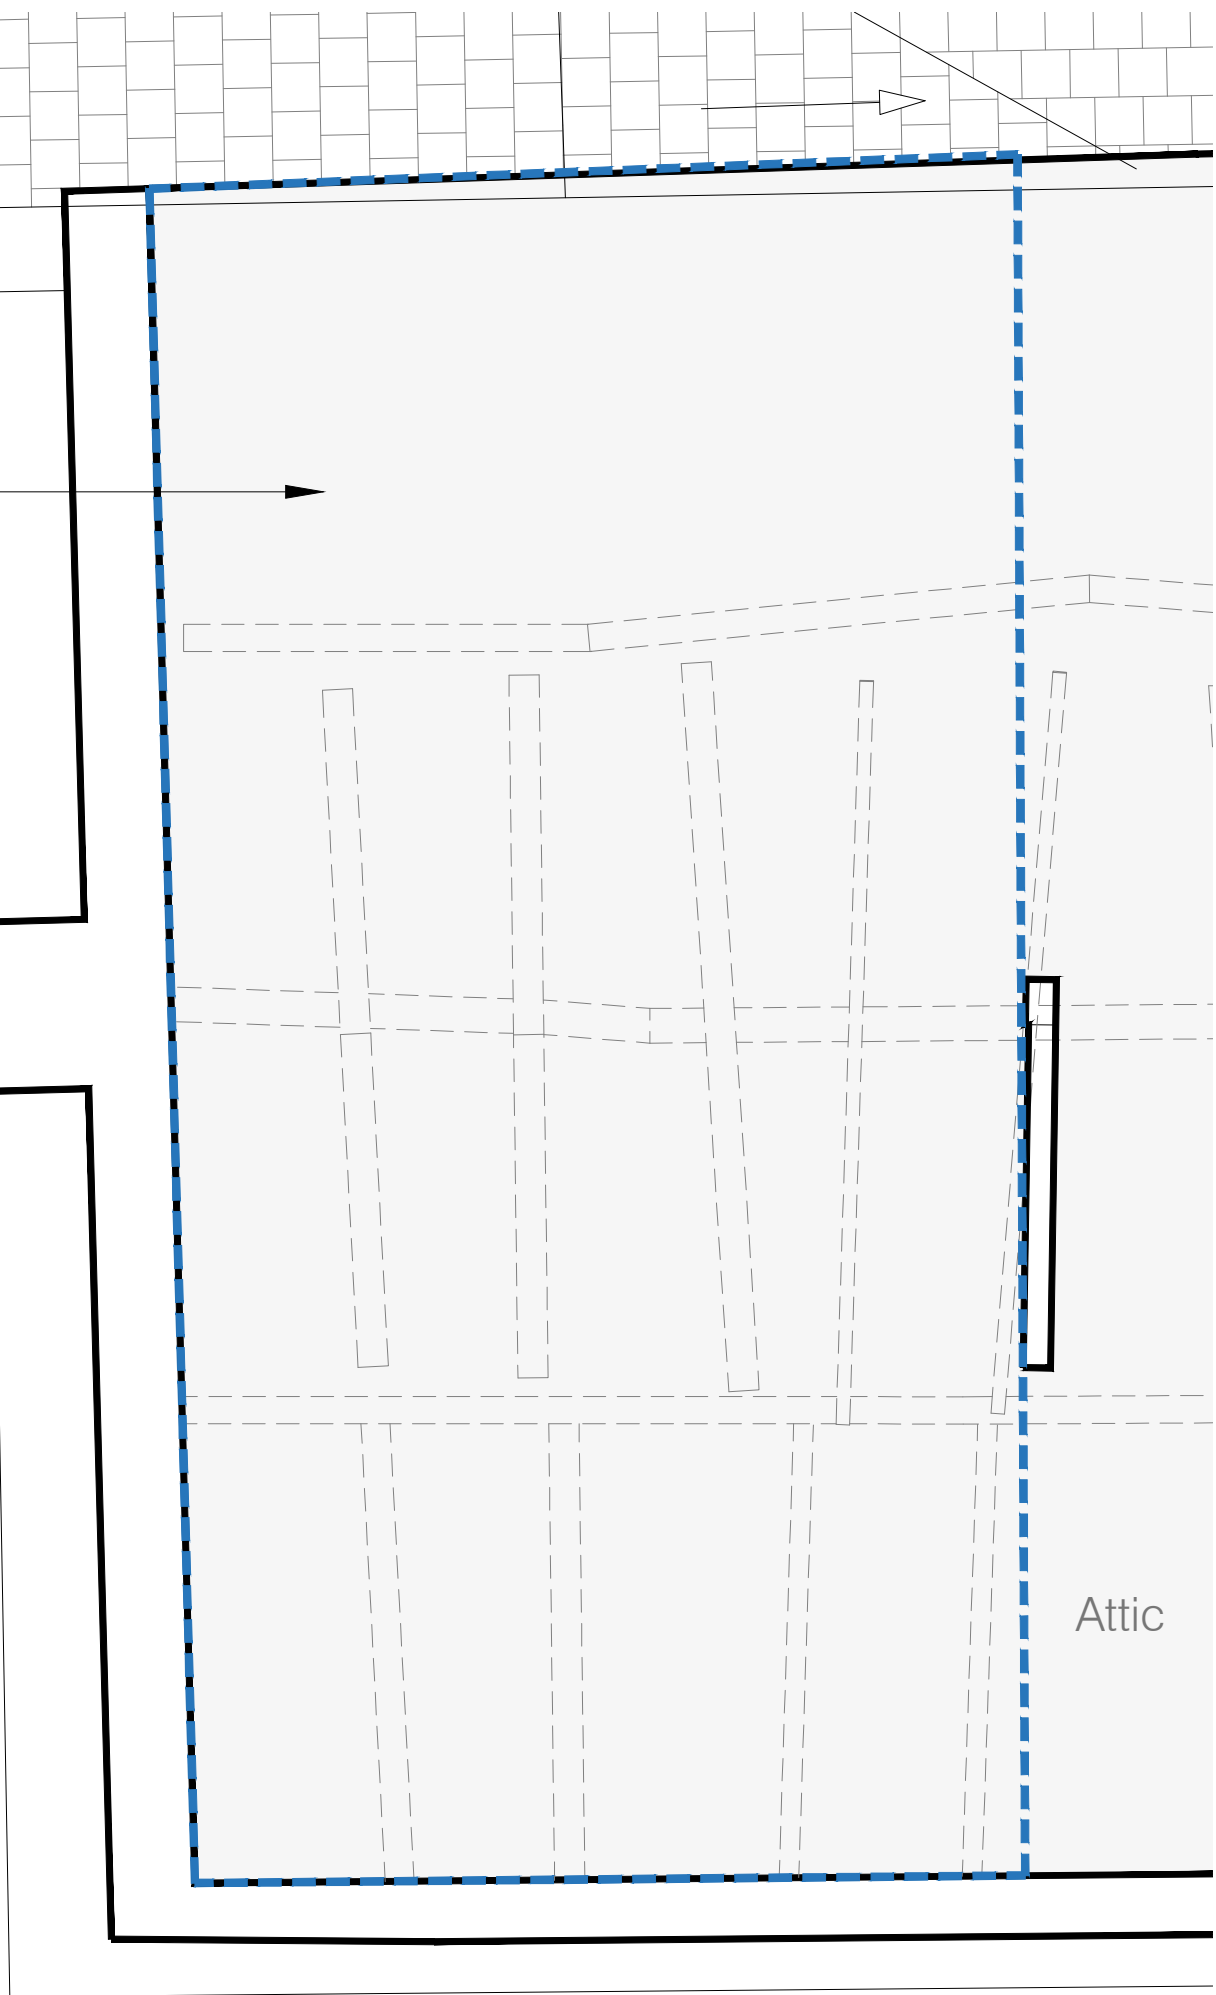


Key Plan
Existing Attic Plan
Scale 1:25@A1
1:50@A3

'As-built' some floor boards removed from the attic. Refer to Detail 2 for proposed build-up

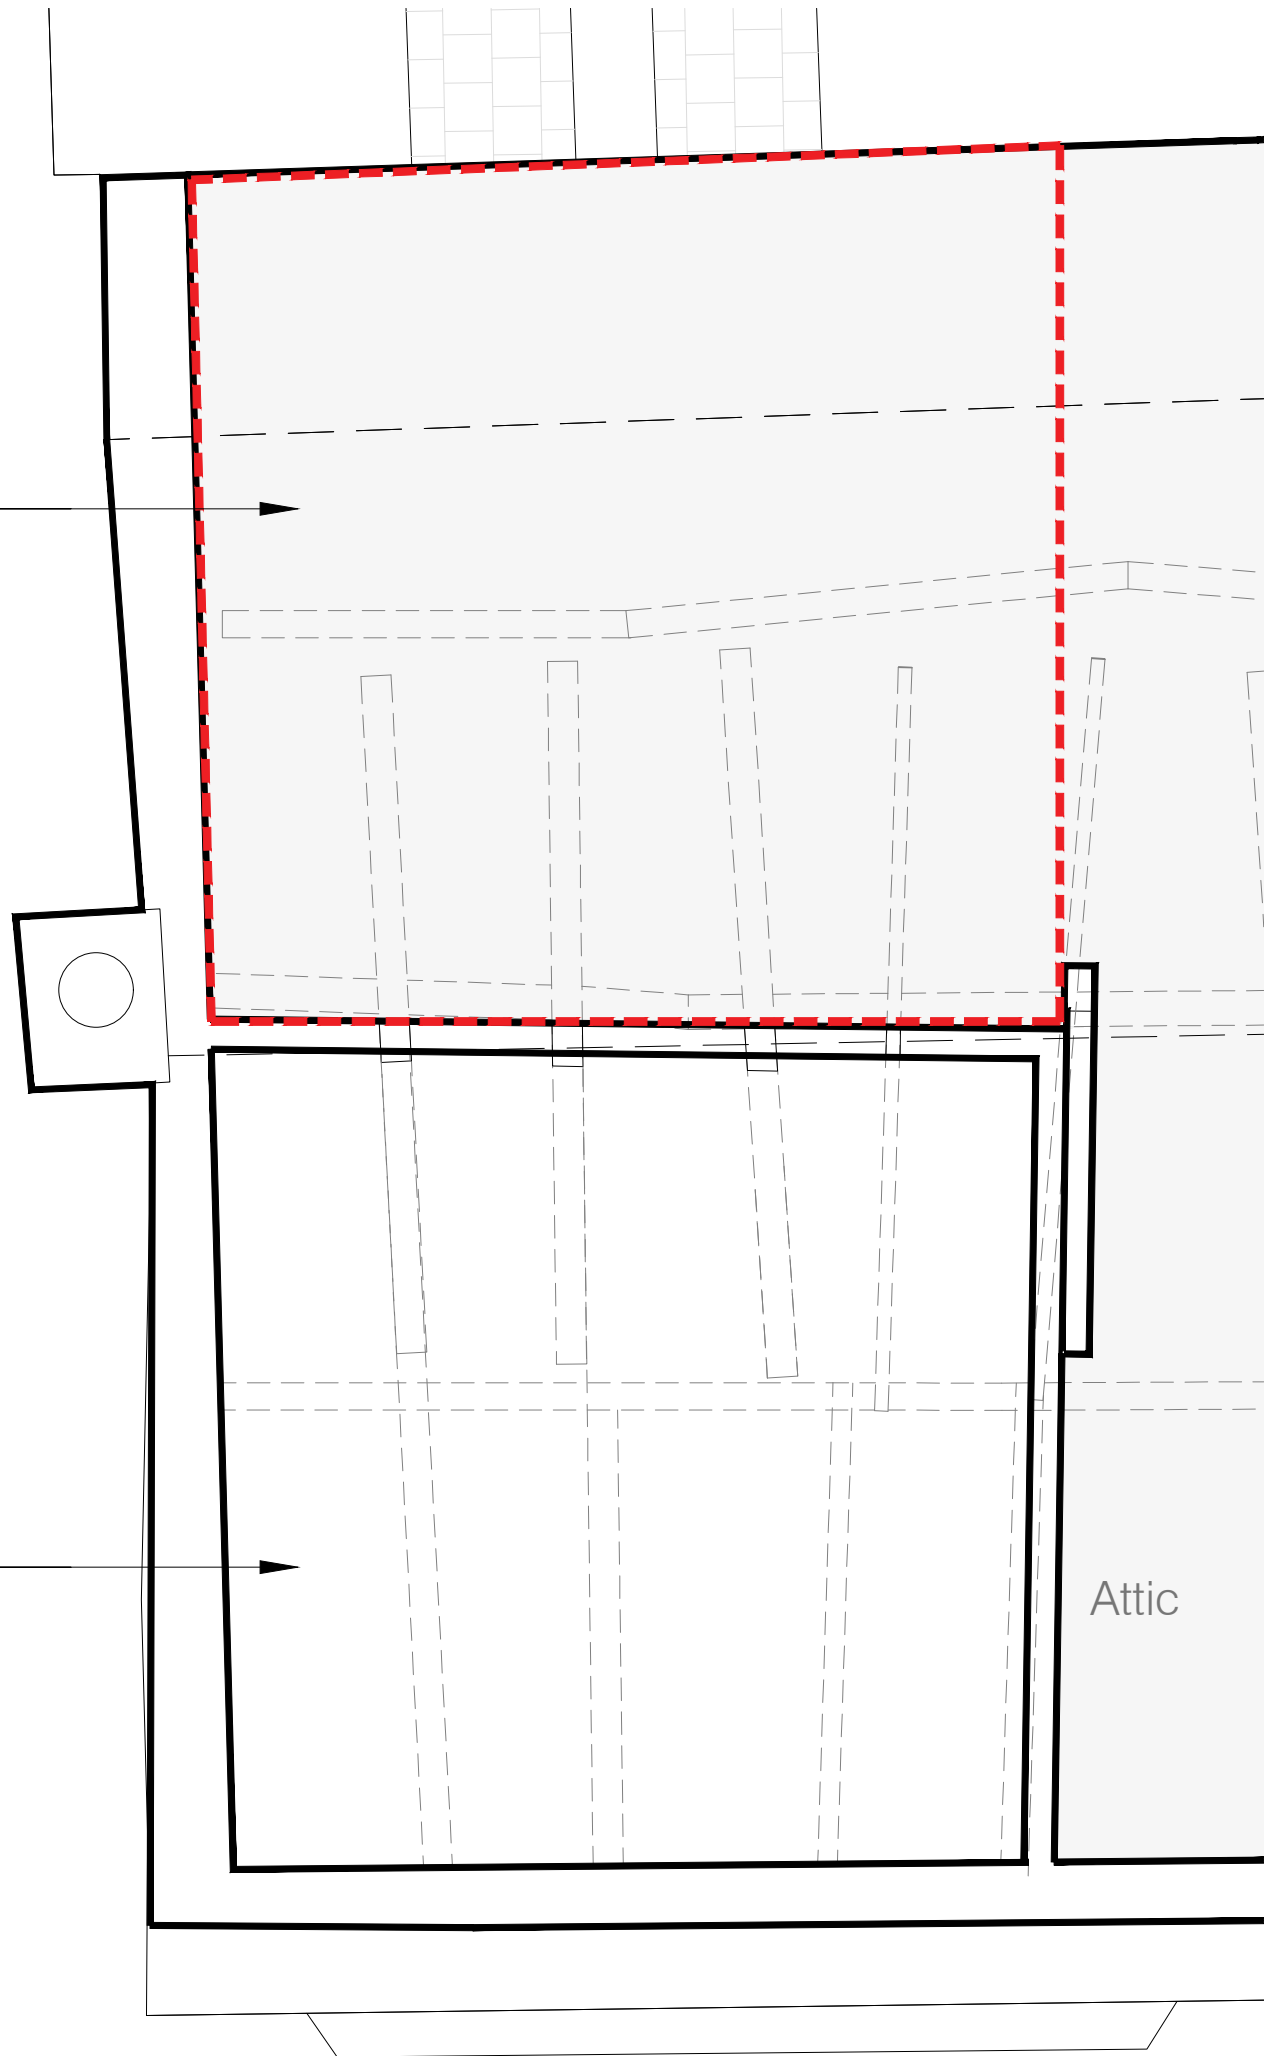

Key Plan
'As-Built' Attic Plan
Scale 1:25@A1
1:50@A3

Proposed aged oak floor boards reinstated in this area. Refer to Detail 3 for proposed build-up

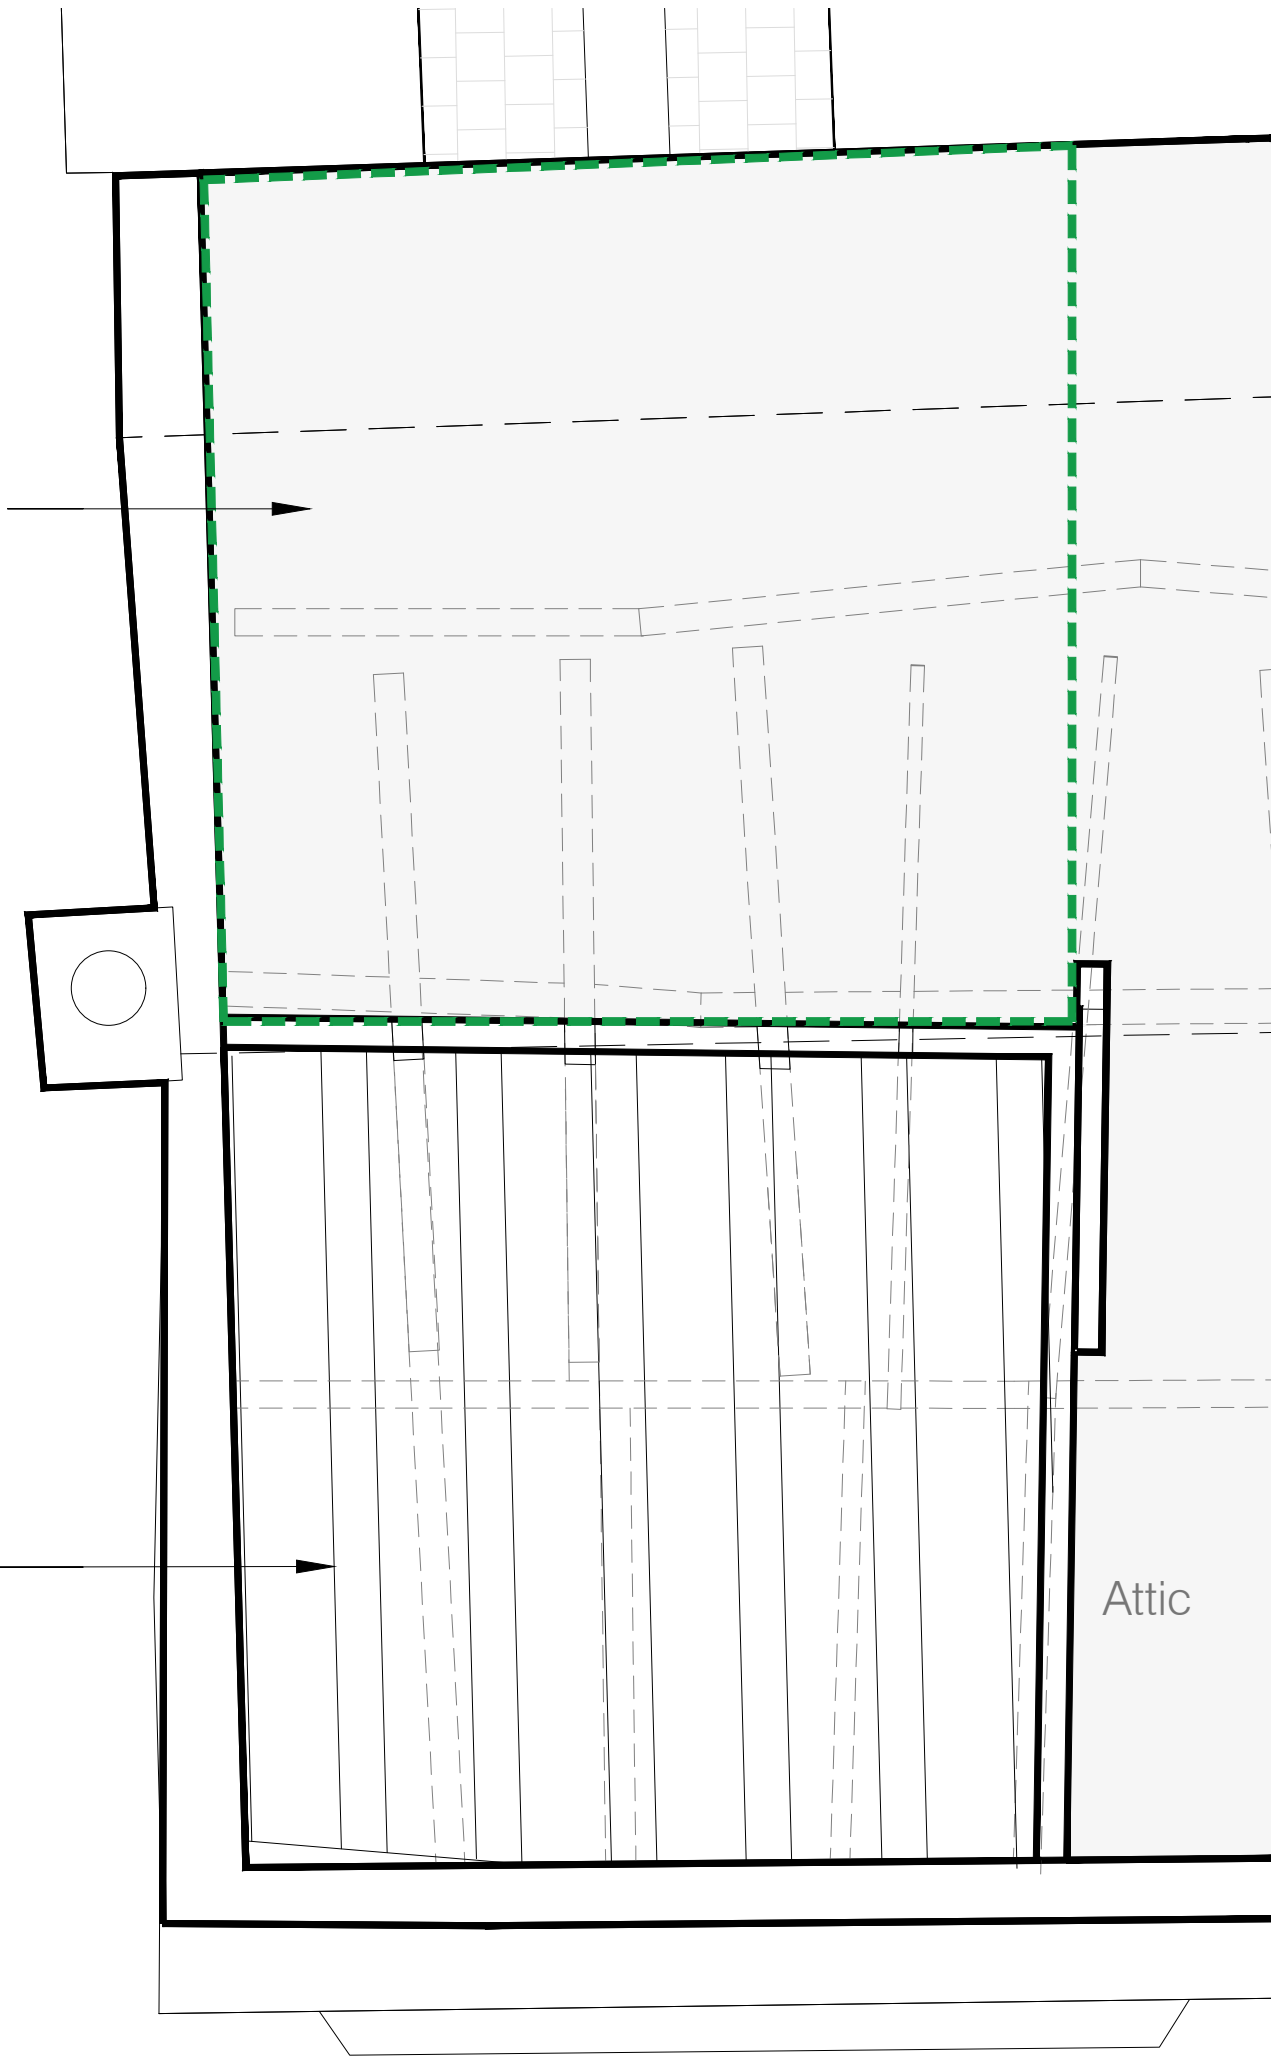

Key Plan
Proposed Attic Plan
Scale 1:25@A1
1:50@A3

Implemented vaulted ceiling above bedroom


Implemented vaulted ceiling above bedroom. Historic Timber joists to be removed.

Attic

Attic

NOTE
DRAWINGS TO BE READ IN CONJUNCTION WITH SUBMITTED DESIGN&ACCESS STATEMENT AND HERITAGE STATEMENT.

INFORMATION ON THE EXISTING AND PROPOSED MATERIALS AND BUILD-UPS WERE OBTAINED FROM THE CONTRACTOR.

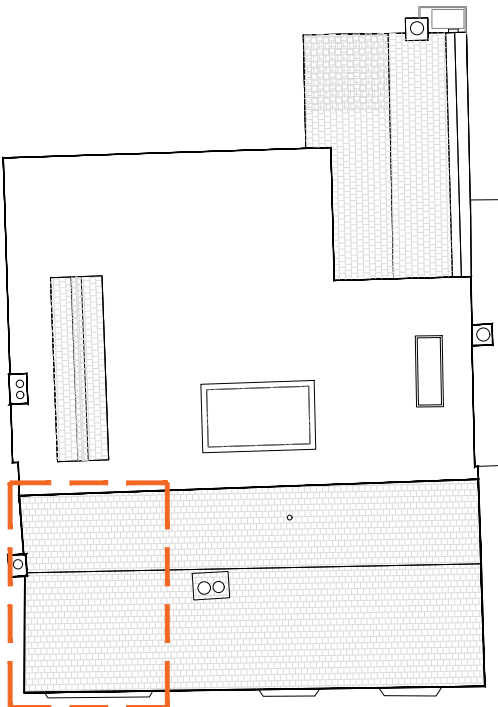

Key Plan 1:200@A1, 1:400@A3

Rev.	Comments.	By:	Date.
A	Amendments as clouded.	KN	Nov 25
B	Amendments as clouded.	JE	Apr 26

Do not scale this drawing All dimensions must be checked on site
All rights reserved. No reproduction in any material form is permitted without consent.

LISTED BUILDING CONSENT			
Client: Mr. Simon Dougall			
Project Title: 107 High St, Lindfield, Haywards Heath, West Sussex, RH16 2HR			
Drawing Title: Detail Drawings: Attic Floor Boards			
Scale:	Date:	Drawn:	Checked:
1:25@A1 1:50@A3	Sep 25	KN	KW

kyson		
Studio		
28 Scrutton Street London UK EC2A 4RP		
T: +44(0) 20 7247 2462 E: enquiries@kyson.co.uk W: www.kyson.co.uk		
Project No.:	Drawing No.:	Revision:
900-25	5029	B

