



The historical maps shown were reproduced from maps predominantly held at the scale adopted for England, Wales and Scotland in the 1840's. In 1854 the 1:2,500 scale was adopted for mapping urban areas; these maps were used to update the 1:10,560 maps. The published date given therefore is often some years later than the surveyed date. Before 1938, all OS maps were based on the Cassini Projection, with independent surveys of a single county or group of counties, giving rise to significant inaccuracies in outlying areas. In the late 1940's, a Provisional Edition was produced, which updated the 1:10,560 mapping from a number of sources. The maps appear unfinished - with all military camps and other strategic sites removed. These maps were initially overprinted with the National Grid. In 1970, the first 1:10,000 maps were produced using the Transverse Mercator Projection. The revision process continued until recently, with new editions appearing every 10 years or so for urban areas.

Map Name(s) and Date(s)

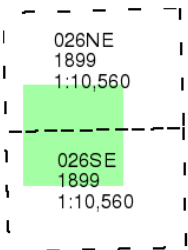

Historical Map - Slice A

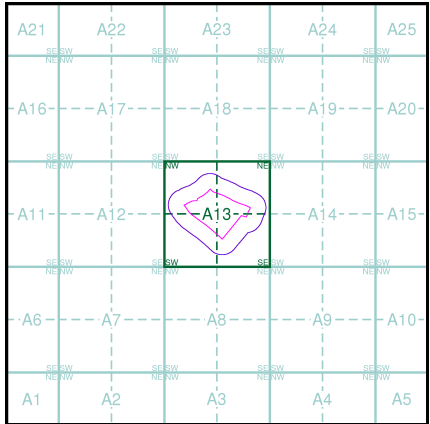


Order Details

Order Number: 334357177_1_1
Customer Ref: 6534
National Grid Reference: 535240, 124870
Slice: A
Site Area (Ha): 6.63
Search Buffer (m): 1000


Site Details

Scamps Hill, Lindfield, Haywards Heath, RH16 2GL

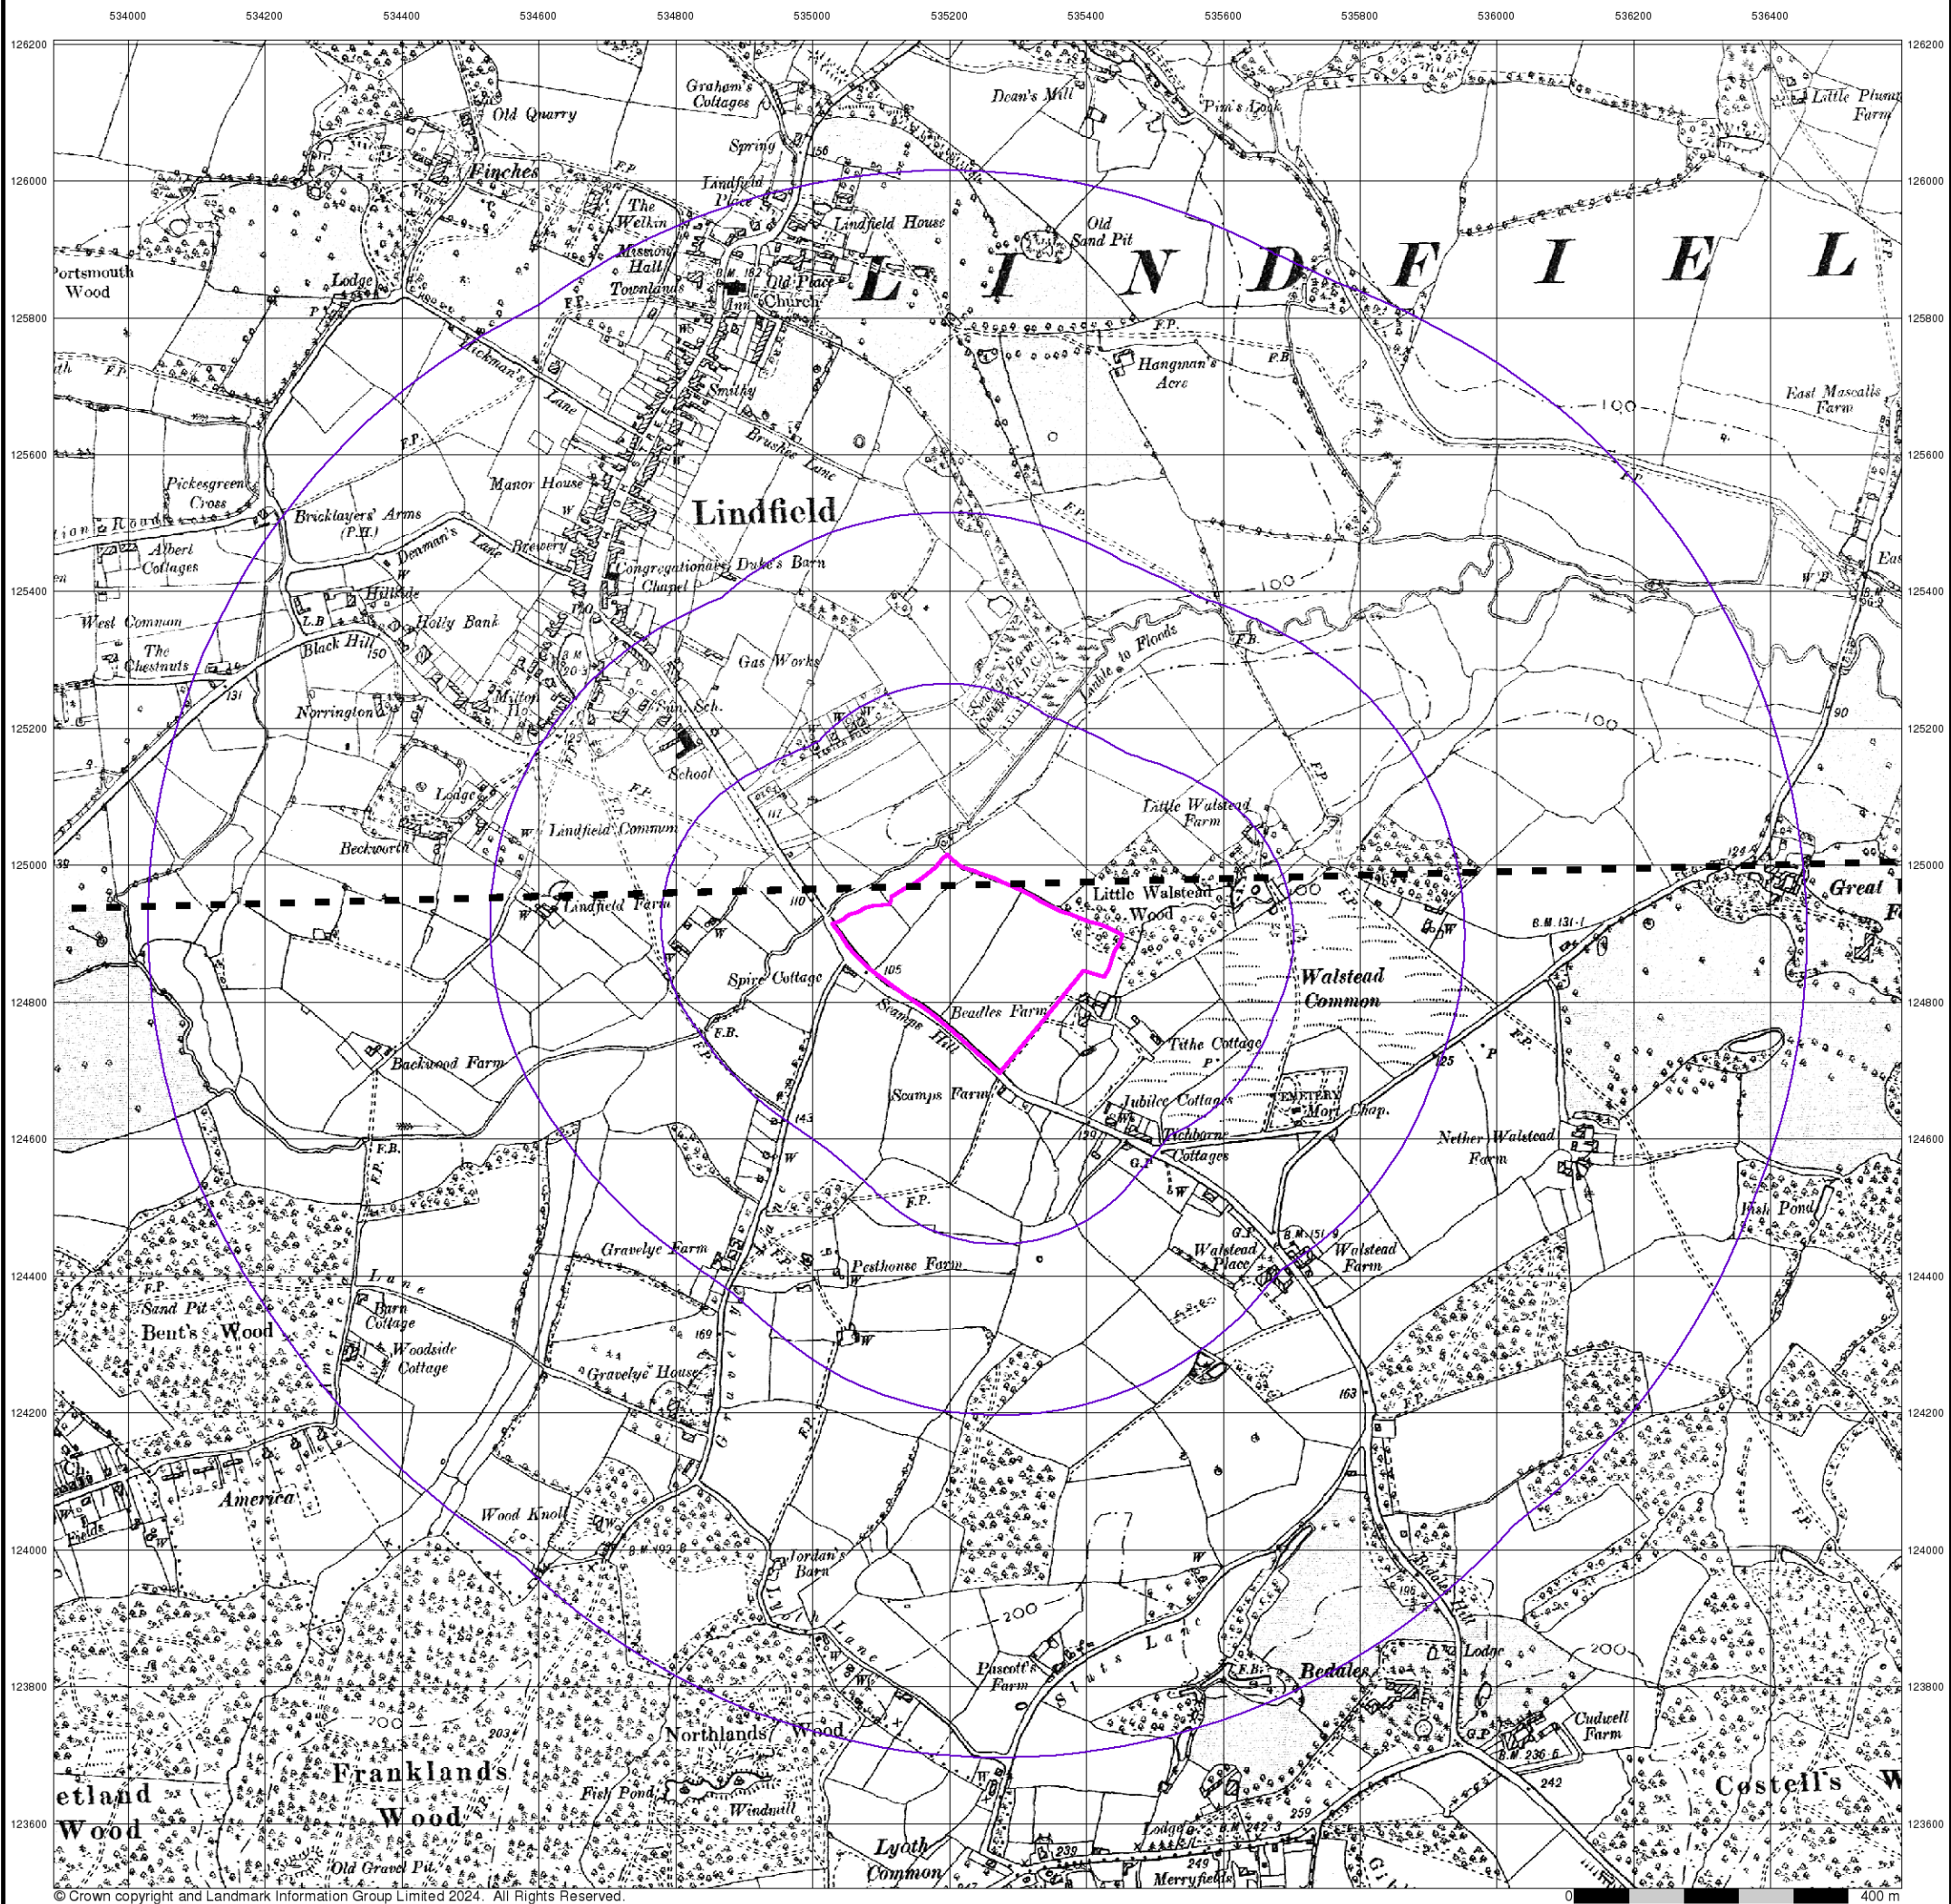


The historical maps shown were reproduced from maps predominantly held at the scale adopted for England, Wales and Scotland in the 1840's. In 1854 the 1:2,500 scale was adopted for mapping urban areas; these maps were used to update the 1:10,560 maps. The published date given therefore is often some years later than the surveyed date. Before 1938, all OS maps were based on the Cassini Projection, with independent surveys of a single county or group of counties, giving rise to significant inaccuracies in outlying areas. In the late 1940's, a Provisional Edition was produced, which updated the 1:10,560 mapping from a number of sources. The maps appear unfinished - with all military camps and other strategic sites removed. These maps were initially overprinted with the National Grid. In 1970, the first 1:10,000 maps were produced using the Transverse Mercator Projection. The revision process continued until recently, with new editions appearing every 10 years or so for urban areas.

Map Name(s) and Date(s)

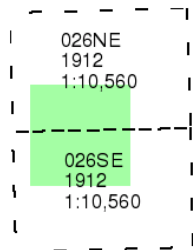

Historical Map - Slice A

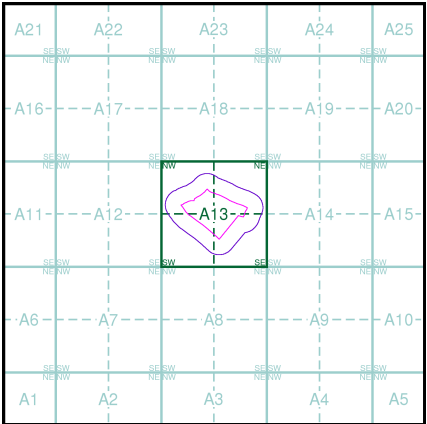


Order Details

Order Number: 334357177_1_1
Customer Ref: 6534
National Grid Reference: 535240, 124870
Slice: A
Site Area (Ha): 6.63
Search Buffer (m): 1000


Site Details

Scamps Hill, Lindfield, Haywards Heath, RH16 2GL

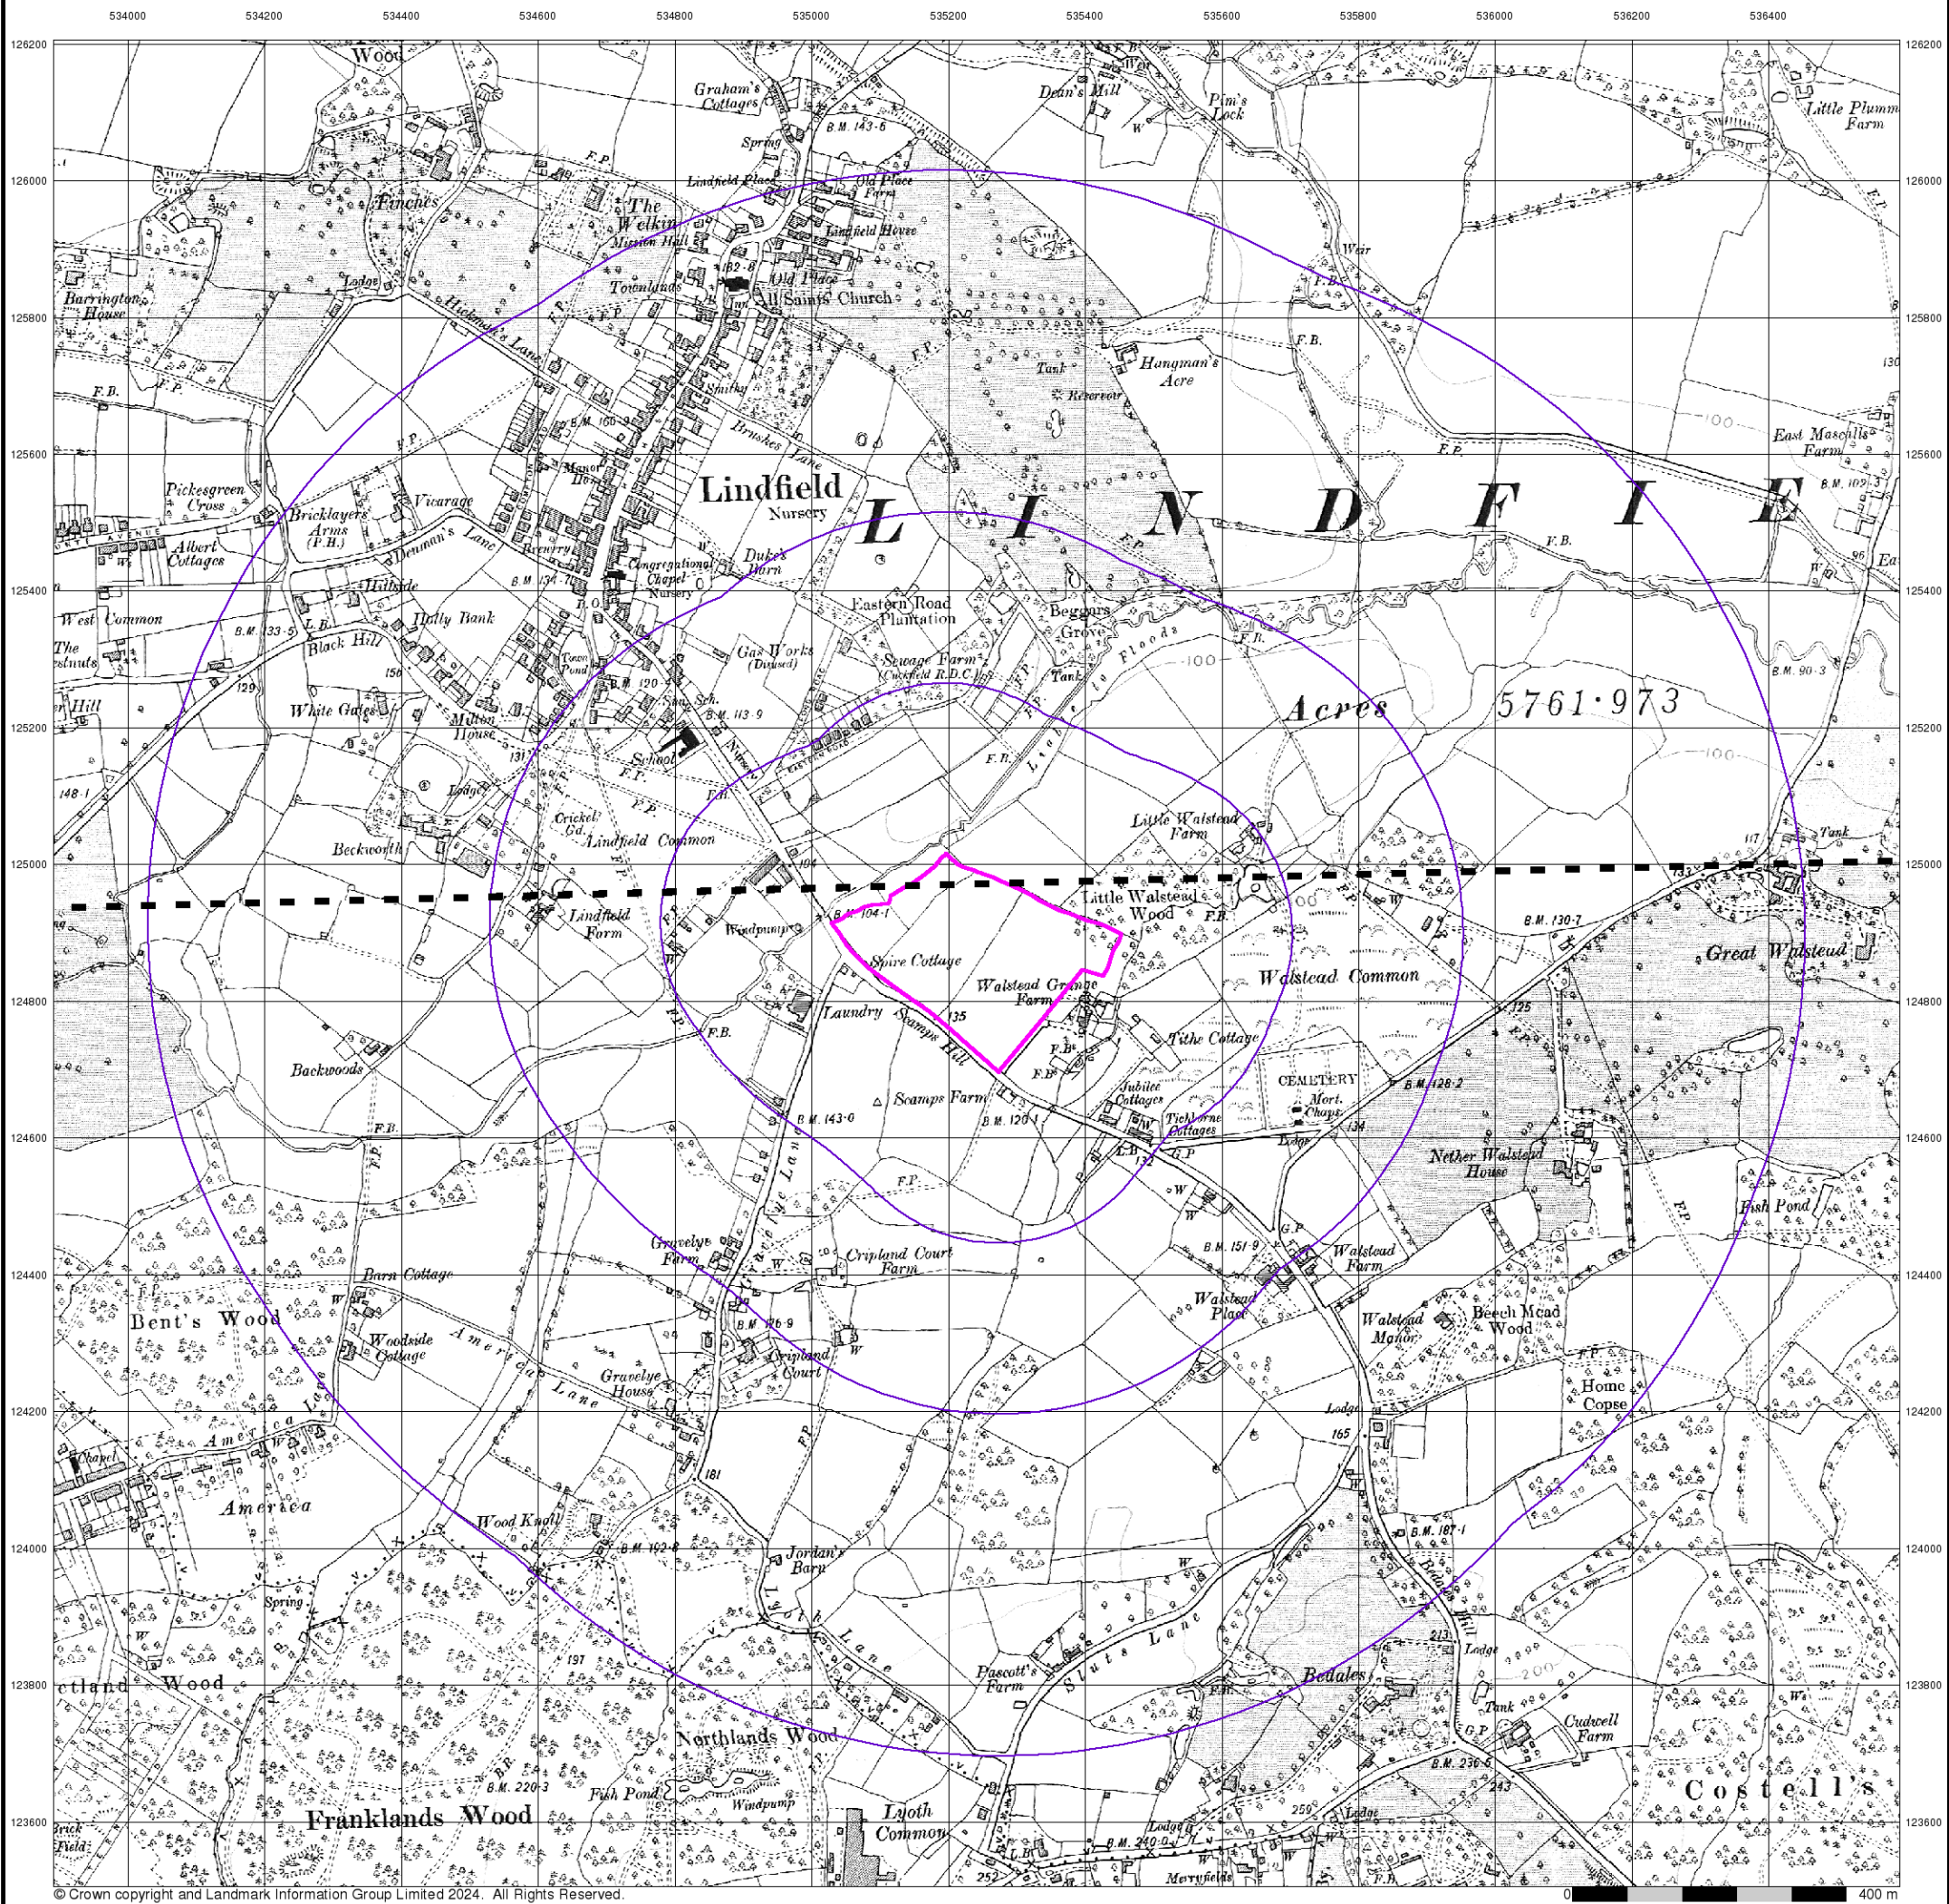


The historical maps shown were reproduced from maps predominantly held at the scale adopted for England, Wales and Scotland in the 1840's. In 1854 the 1:2,500 scale was adopted for mapping urban areas; these maps were used to update the 1:10,560 maps. The published date given therefore is often some years later than the surveyed date. Before 1938, all OS maps were based on the Cassini Projection, with independent surveys of a single county or group of counties, giving rise to significant inaccuracies in outlying areas. In the late 1940's, a Provisional Edition was produced, which updated the 1:10,560 mapping from a number of sources. The maps appear unfinished - with all military camps and other strategic sites removed. These maps were initially overprinted with the National Grid. In 1970, the first 1:10,000 maps were produced using the Transverse Mercator Projection. The revision process continued until recently, with new editions appearing every 10 years or so for urban areas.

Map Name(s) and Date(s)

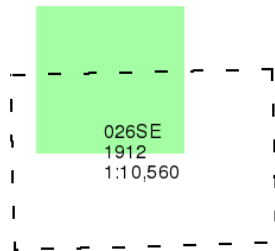

Historical Map - Slice A

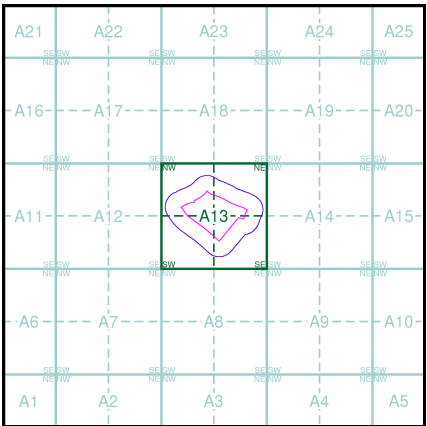


Order Details

Order Number: 334357177_1_1
Customer Ref: 6534
National Grid Reference: 535240, 124870
Slice: A
Site Area (Ha): 6.63
Search Buffer (m): 1000

Site Details

Scamps Hill, Lindfield, Haywards Heath, RH16 2GL

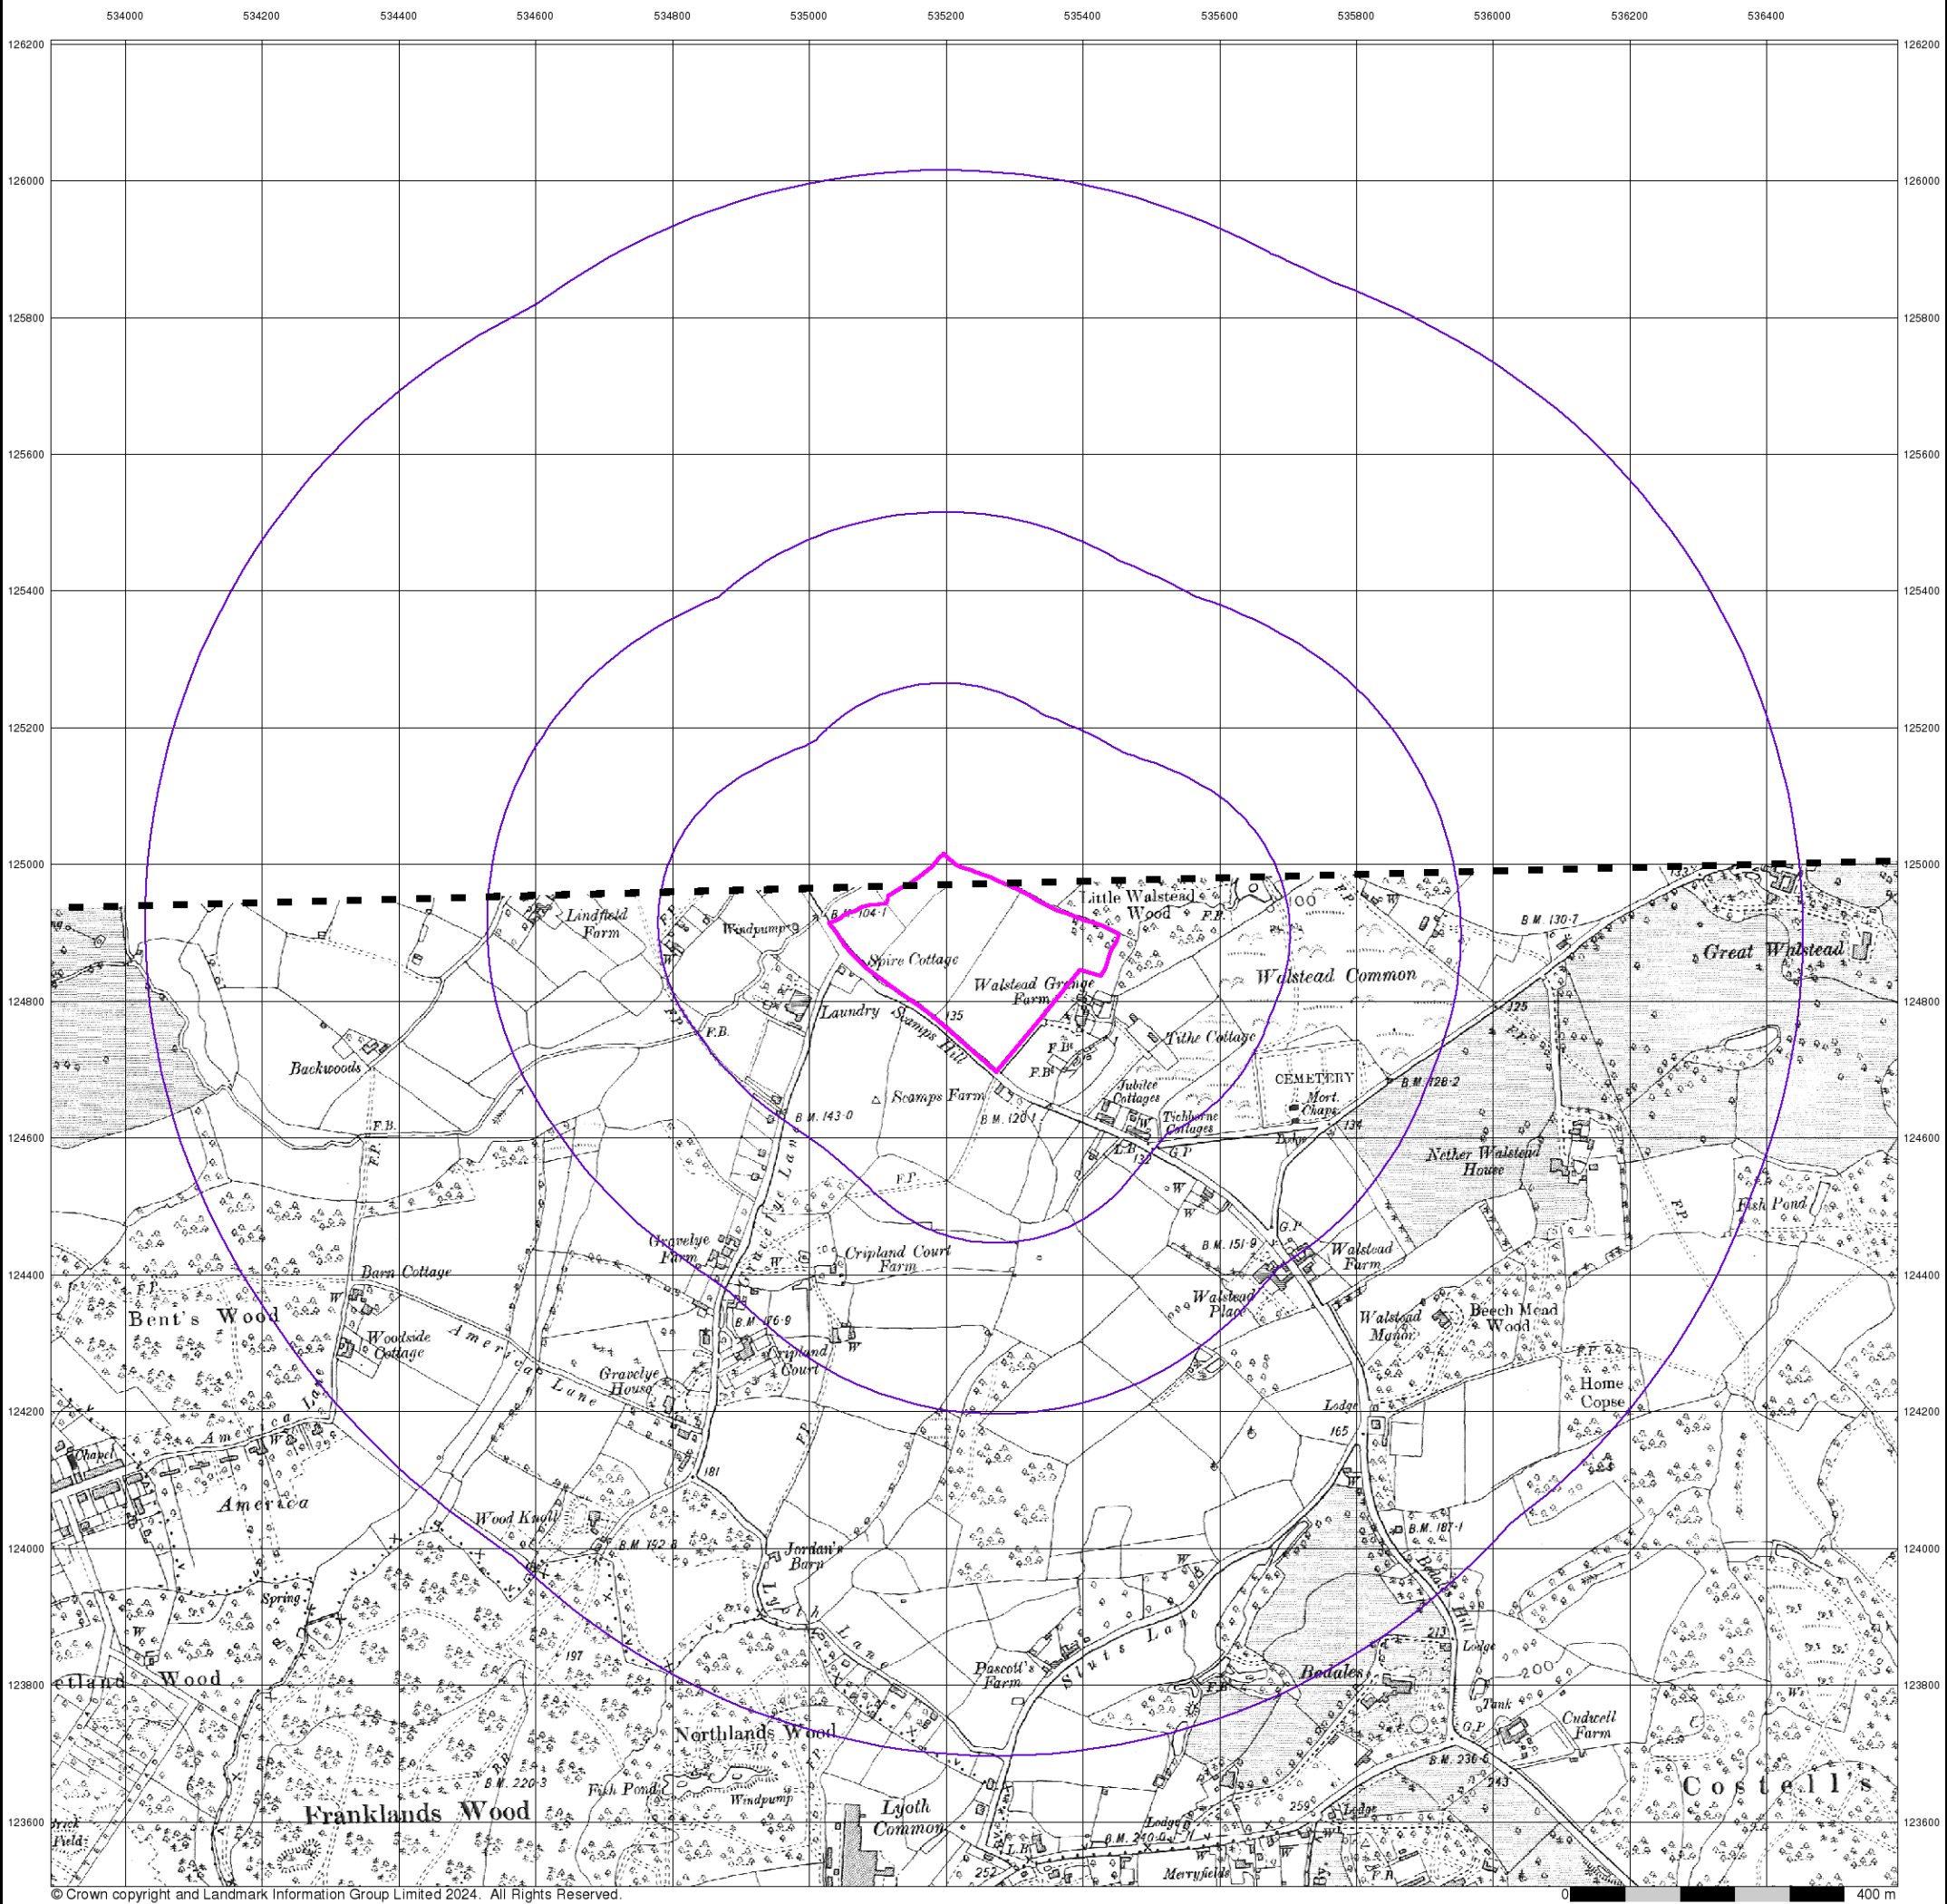


Sussex

Published 1938 - 1950


Source map scale - 1:10,560

The historical maps shown were reproduced from maps predominantly held at the scale adopted for England, Wales and Scotland in the 1840's. In 1854 the 1:2,500 scale was adopted for mapping urban areas; these maps were used to update the 1:10,560 maps. The published date given therefore is often some years later than the surveyed date. Before 1938, all OS maps were based on the Cassini Projection, with independent surveys of a single county or group of counties, giving rise to significant inaccuracies in outlying areas. In the late 1940's, a Provisional Edition was produced, which updated the 1:10,560 mapping from a number of sources. The maps appear unfinished - with all military camps and other strategic sites removed. These maps were initially overprinted with the National Grid. In 1970, the first 1:10,000 maps were produced using the Transverse Mercator Projection. The revision process continued until recently, with new editions appearing every 10 years or so for urban areas.

Map Name(s) and Date(s)

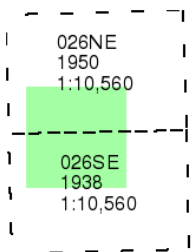

Historical Map - Slice A

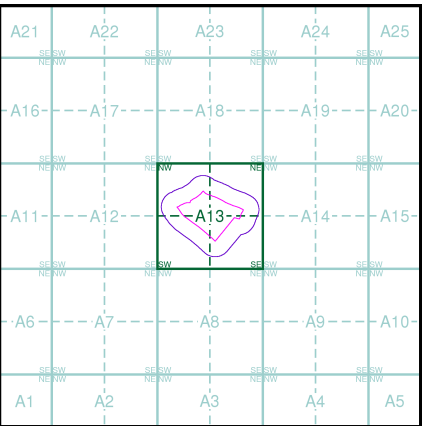


Order Details

Order Number: 334357177_1_1
Customer Ref: 6534
National Grid Reference: 535240, 124870
Slice: A
Site Area (Ha): 6.63
Search Buffer (m): 1000

Site Details

Scamps Hill, Lindfield, Haywards Heath, RH16 2GL

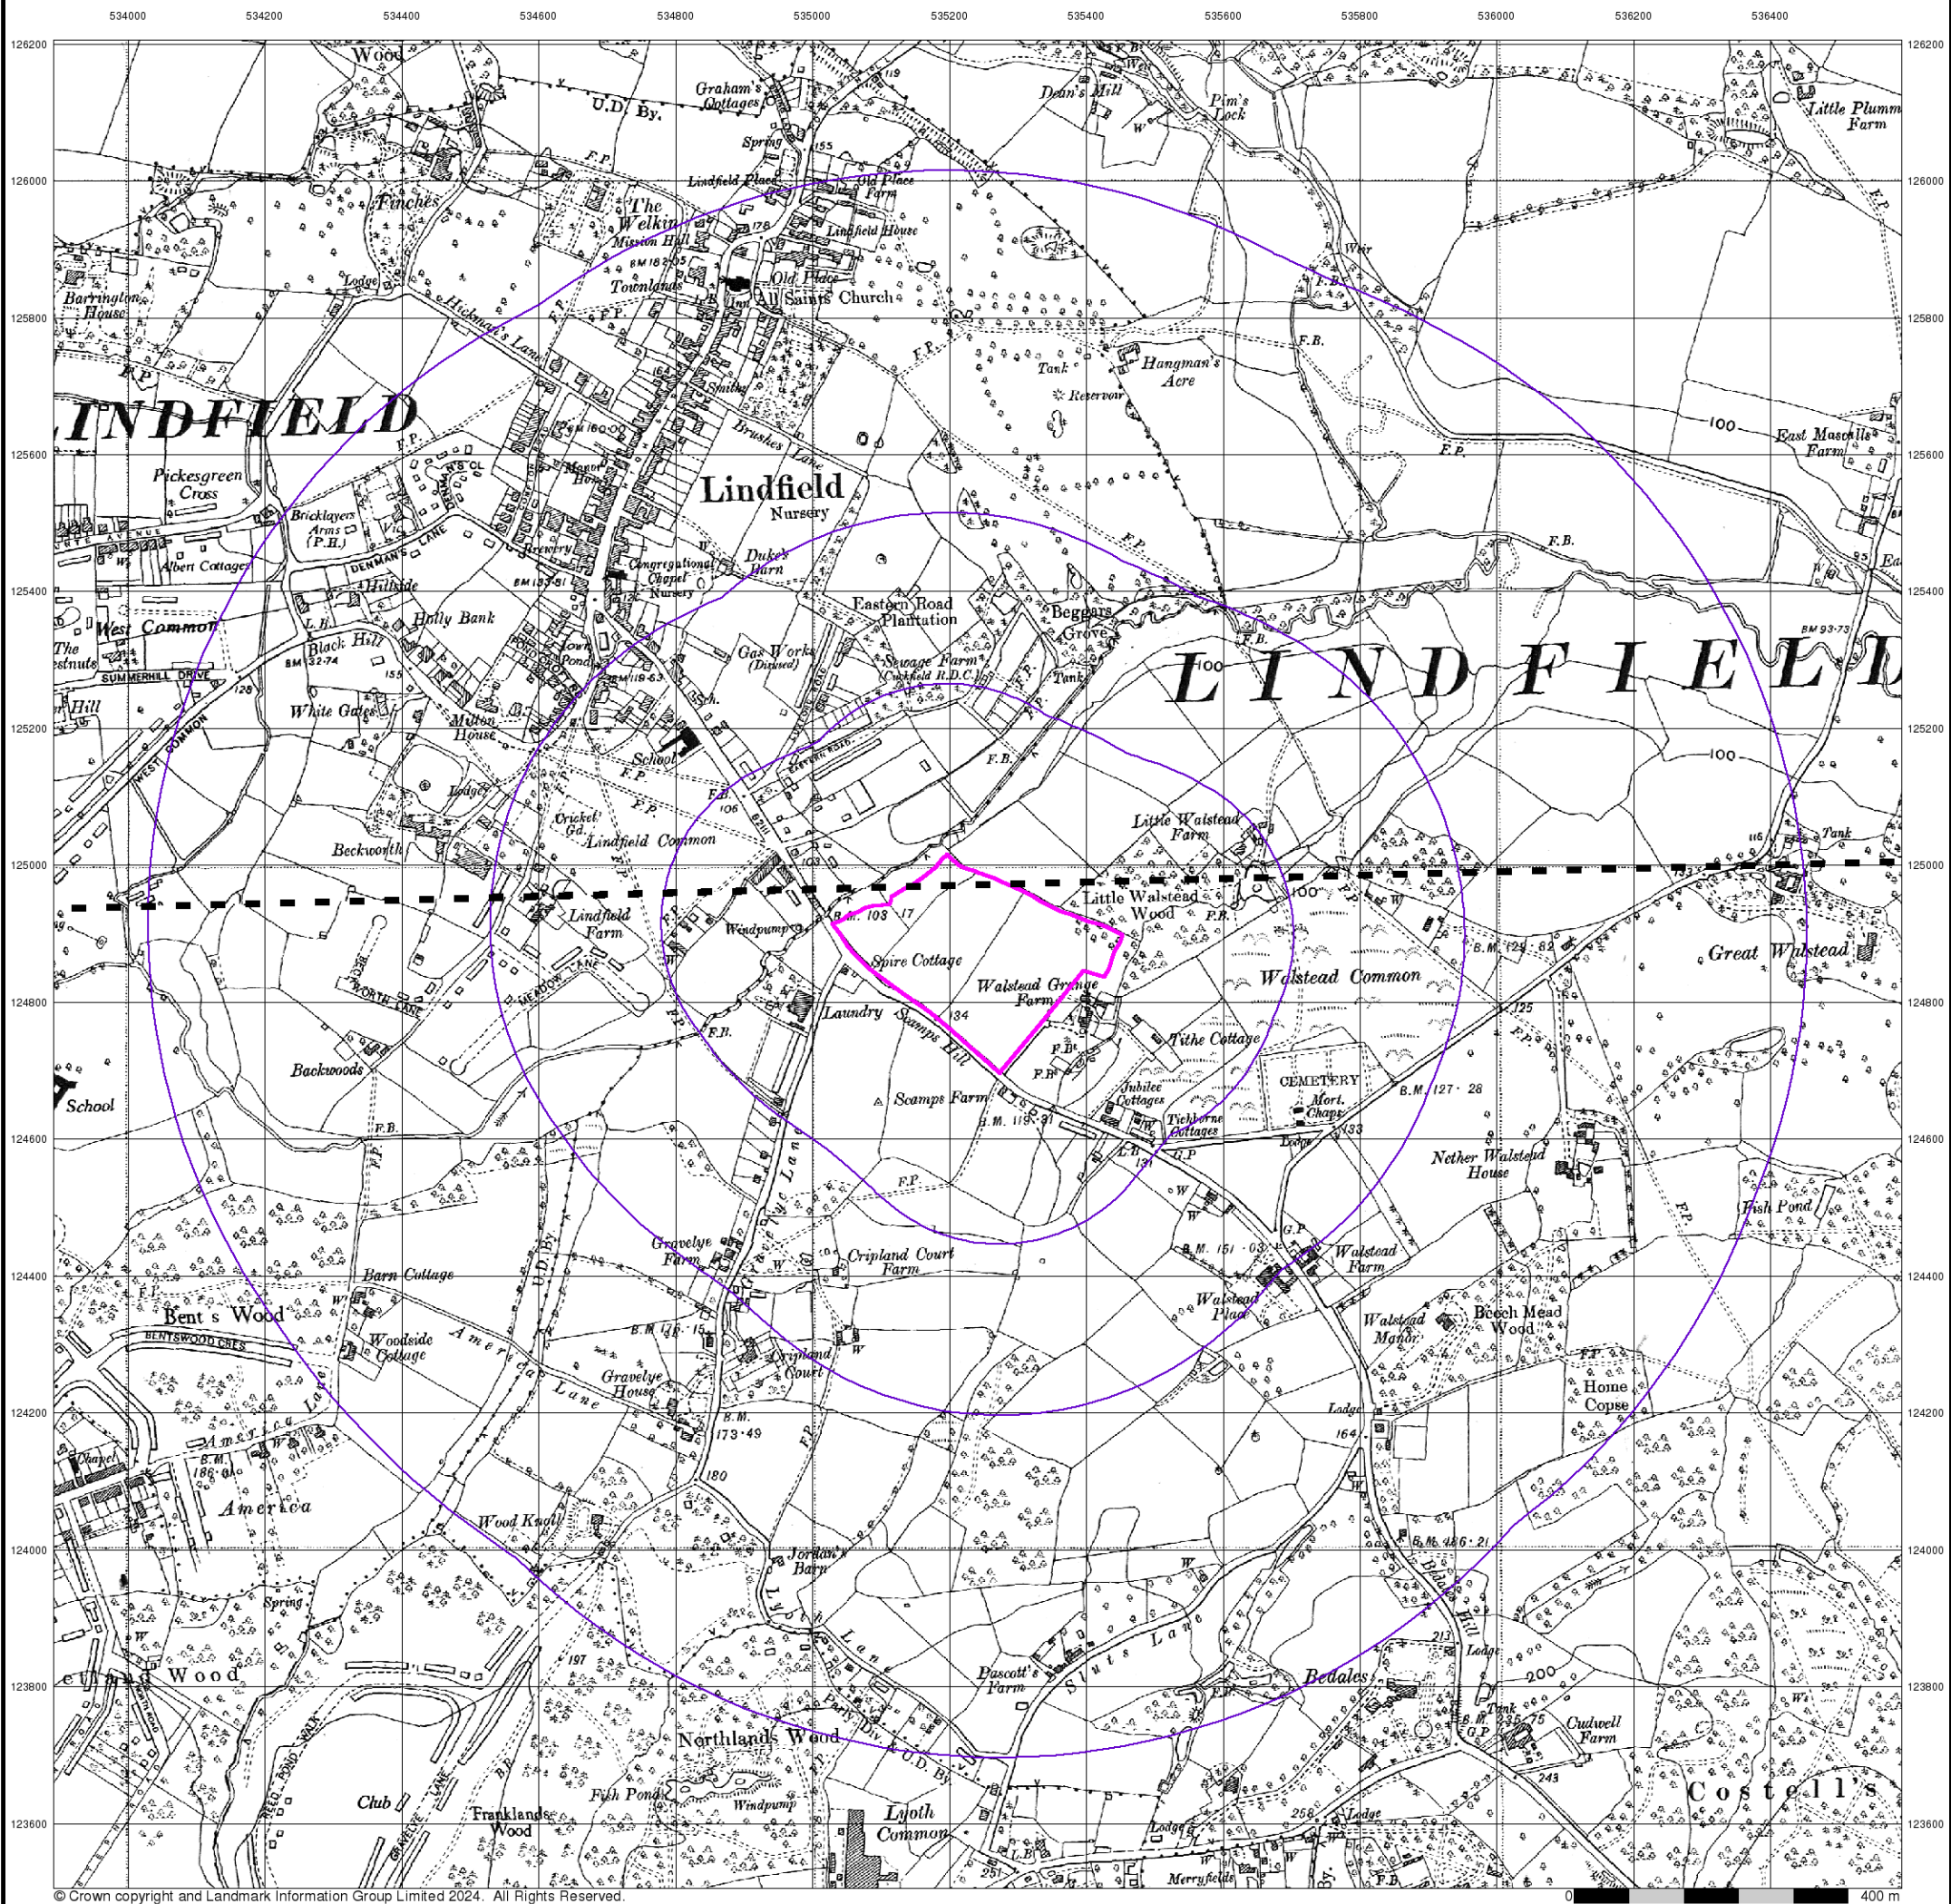

Ordnance Survey Plan

Published 1961 - 1963


Source map scale - 1:10,000

The historical maps shown were reproduced from maps predominantly held at the scale adopted for England, Wales and Scotland in the 1840's. In 1854 the 1:2,500 scale was adopted for mapping urban areas; these maps were used to update the 1:10,560 maps. The published date given therefore is often some years later than the surveyed date. Before 1938, all OS maps were based on the Cassini Projection, with independent surveys of a single county or group of counties, giving rise to significant inaccuracies in outlying areas. In the late 1940's, a Provisional Edition was produced, which updated the 1:10,560 mapping from a number of sources. The maps appear unfinished - with all military camps and other strategic sites removed. These maps were initially overprinted with the National Grid. In 1970, the first 1:10,000 maps were produced using the Transverse Mercator Projection. The revision process continued until recently, with new editions appearing every 10 years or so for urban areas.

Map Name(s) and Date(s)

TQ32NW	TQ32NE
1963	1961
1:10,560	1:10,560
TQ32SW	TQ32SE
1963	1961
1:10,560	1:10,560

Historical Map - Slice A

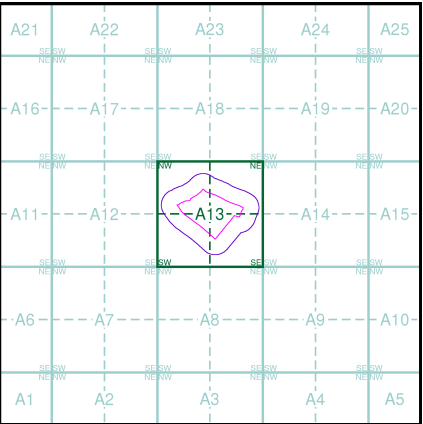

Order Details

Order Number: 334357177_1_1
Customer Ref: 6534
National Grid Reference: 535240, 124870
Slice: A
Site Area (Ha): 6.63
Search Buffer (m): 1000

Site Details

Scamps Hill, Lindfield, Haywards Heath, RH16 2GL


Ordnance Survey Plan

Published 1969


Source map scale - 1:10,000

The historical maps shown were reproduced from maps predominantly held at the scale adopted for England, Wales and Scotland in the 1840's. In 1854 the 1:2,500 scale was adopted for mapping urban areas; these maps were used to update the 1:10,560 maps. The published date given therefore is often some years later than the surveyed date. Before 1938, all OS maps were based on the Cassini Projection, with independent surveys of a single county or group of counties, giving rise to significant inaccuracies in outlying areas. In the late 1940's, a Provisional Edition was produced, which updated the 1:10,560 mapping from a number of sources. The maps appear unfinished - with all military camps and other strategic sites removed. These maps were initially overprinted with the National Grid. In 1970, the first 1:10,000 maps were produced using the Transverse Mercator Projection. The revision process continued until recently, with new editions appearing every 10 years or so for urban areas.

Map Name(s) and Date(s)

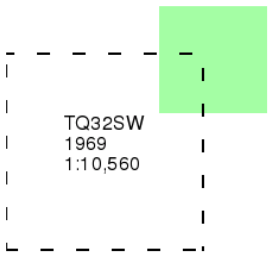

Historical Map - Slice A

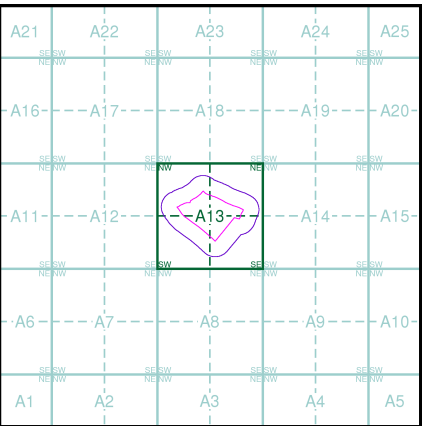


Order Details

Order Number: 334357177_1_1
Customer Ref: 6534
National Grid Reference: 535240, 124870
Slice: A
Site Area (Ha): 6.63
Search Buffer (m): 1000

Site Details

Scamps Hill, Lindfield, Haywards Heath, RH16 2GL

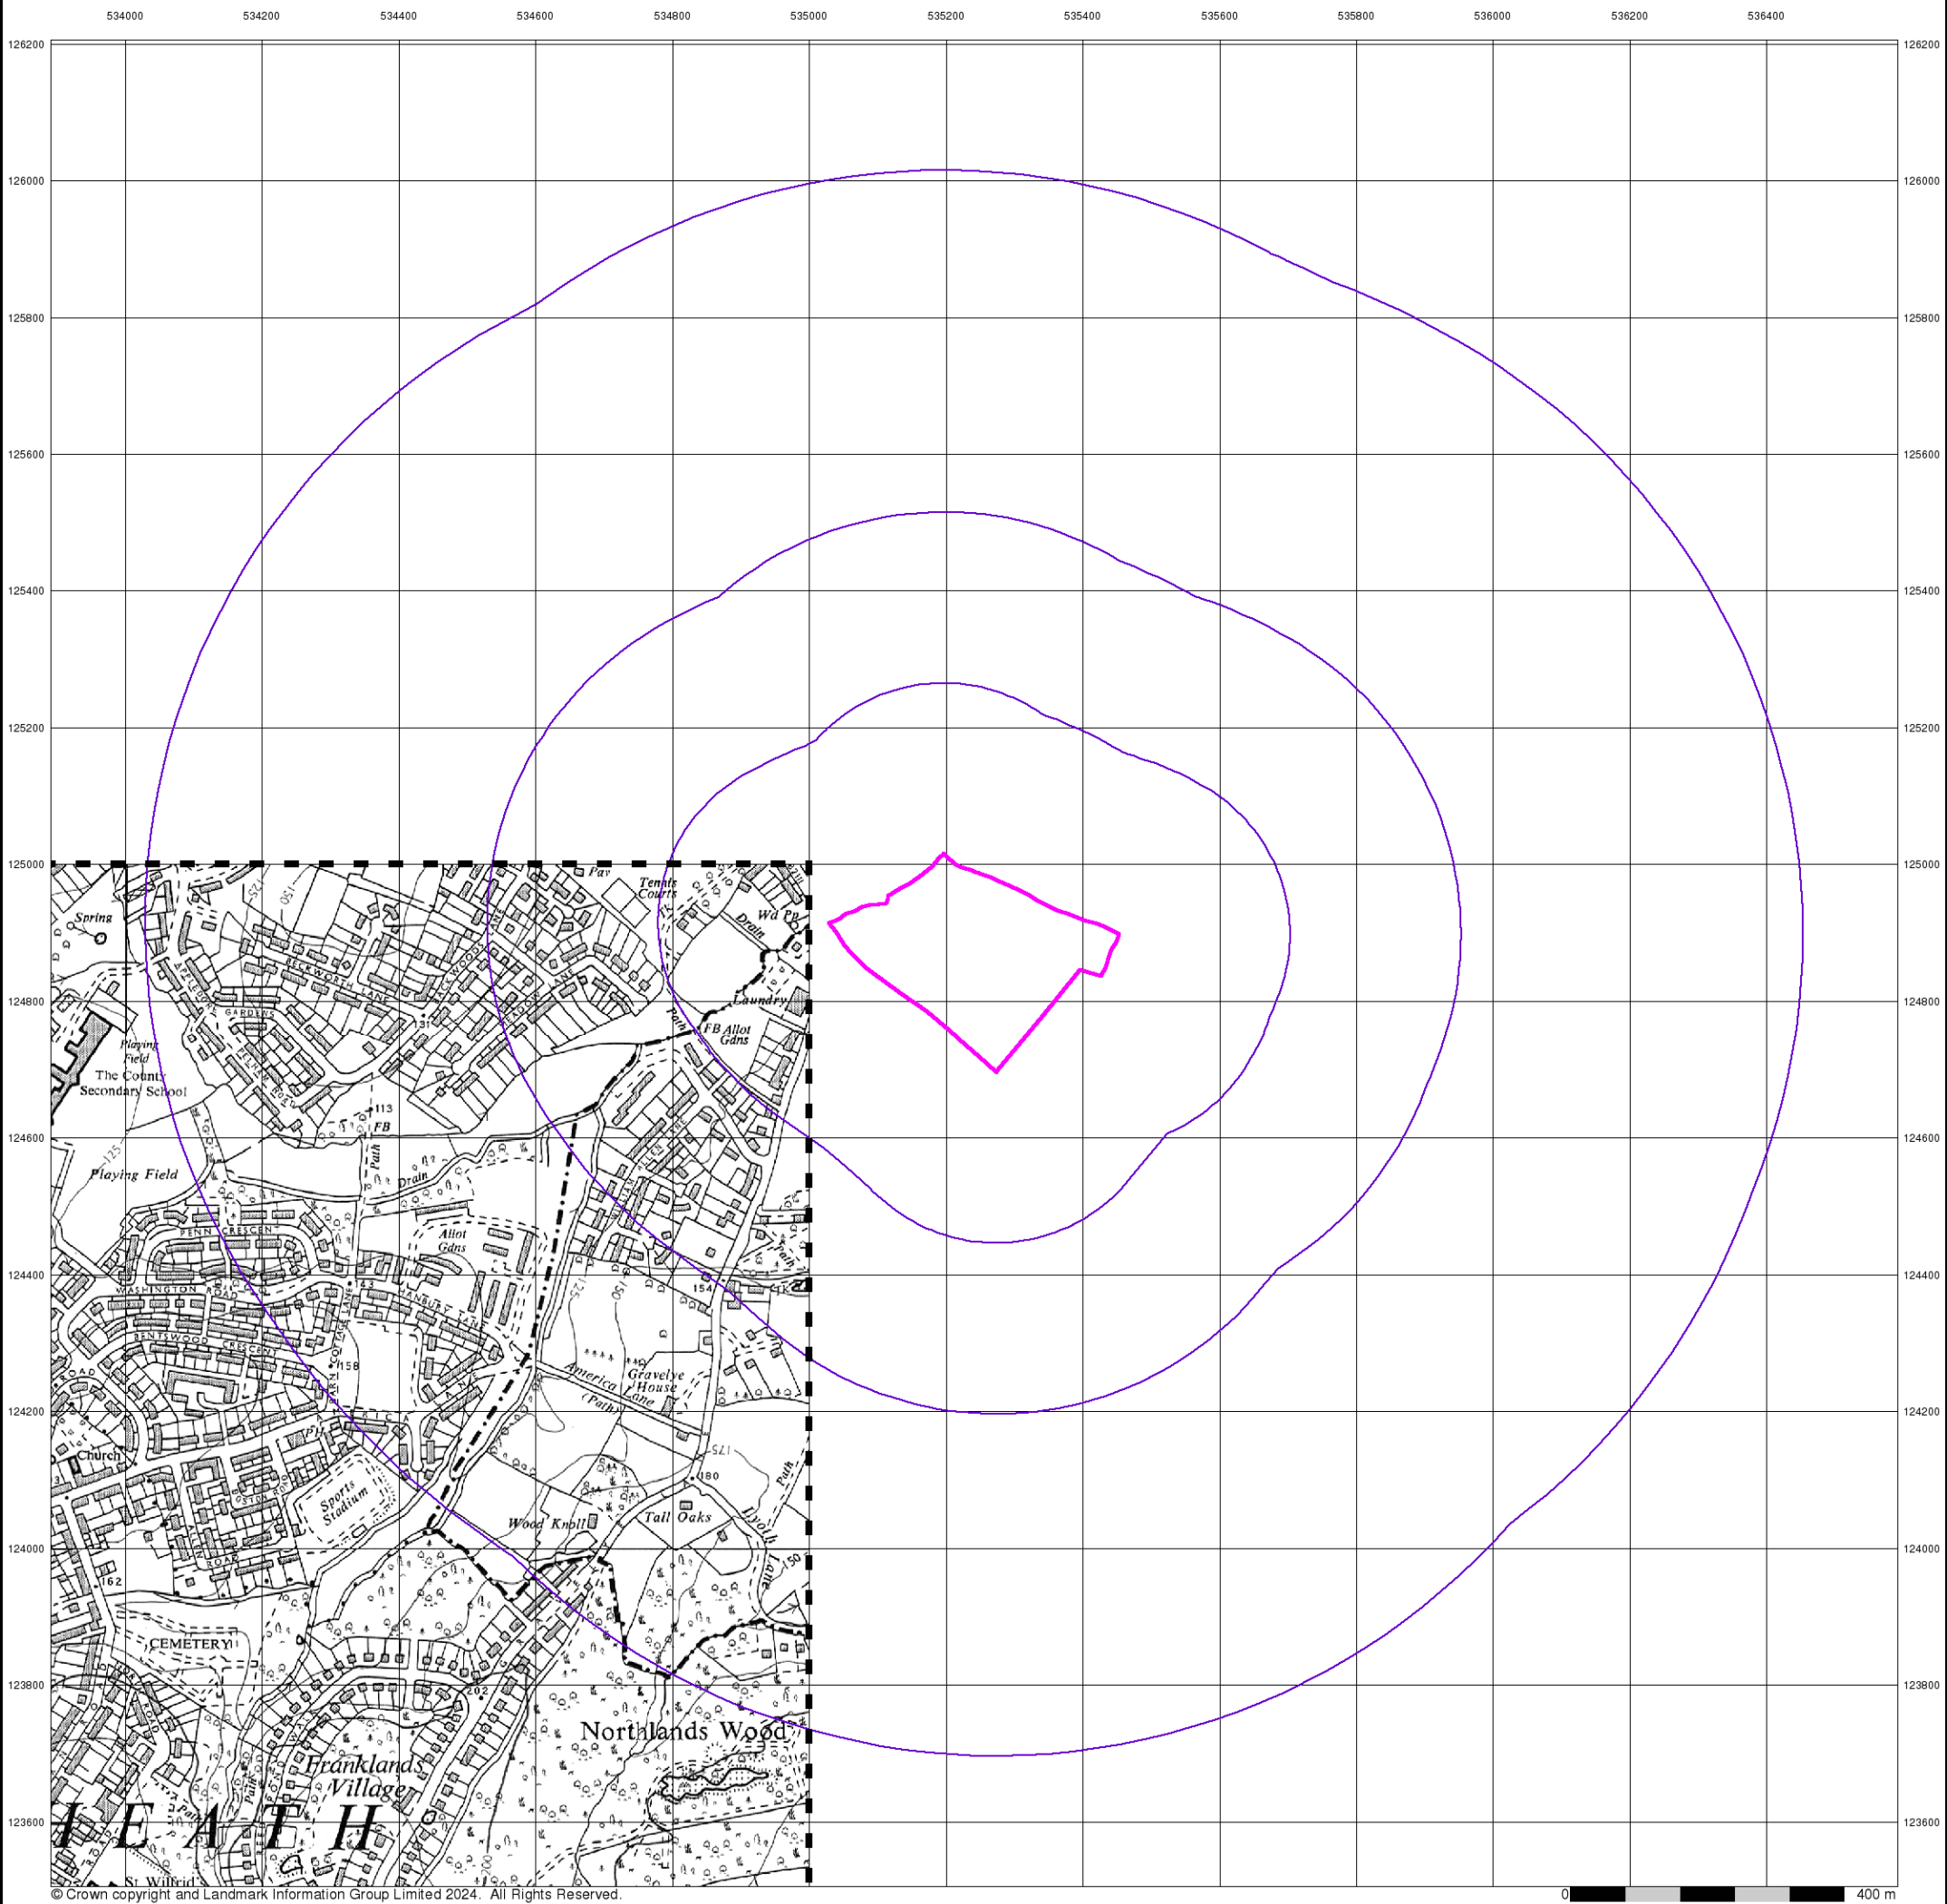

Ordnance Survey Plan

Published 1974 - 1978


Source map scale - 1:10,000

The historical maps shown were reproduced from maps predominantly held at the scale adopted for England, Wales and Scotland in the 1840's. In 1854 the 1:2,500 scale was adopted for mapping urban areas; these maps were used to update the 1:10,560 maps. The published date given therefore is often some years later than the surveyed date. Before 1938, all OS maps were based on the Cassini Projection, with independent surveys of a single county or group of counties, giving rise to significant inaccuracies in outlying areas. In the late 1940's, a Provisional Edition was produced, which updated the 1:10,560 mapping from a number of sources. The maps appear unfinished - with all military camps and other strategic sites removed. These maps were initially overprinted with the National Grid. In 1970, the first 1:10,000 maps were produced using the Transverse Mercator Projection. The revision process continued until recently, with new editions appearing every 10 years or so for urban areas.

Map Name(s) and Date(s)

TQ32NW	TQ32NE
1974	1976
1:10,000	1:10,000
TQ32SW	TQ32SE
1978	1975
1:10,000	1:10,000

Historical Map - Slice A

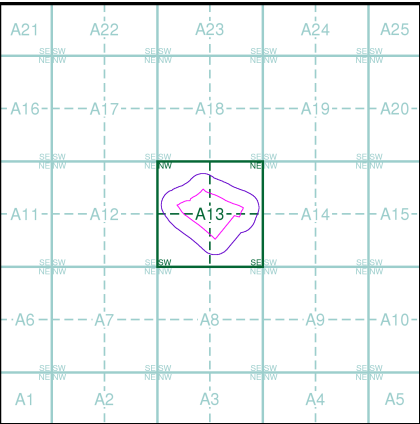

Order Details

Order Number: 334357177_1_1
Customer Ref: 6534
National Grid Reference: 535240, 124870
Slice: A
Site Area (Ha): 6.63
Search Buffer (m): 1000

Site Details

Scamps Hill, Lindfield, Haywards Heath, RH16 2GL


Ordnance Survey Plan

Published 1974


Source map scale - 1:10,000

The historical maps shown were reproduced from maps predominantly held at the scale adopted for England, Wales and Scotland in the 1840's. In 1854 the 1:2,500 scale was adopted for mapping urban areas; these maps were used to update the 1:10,560 maps. The published date given therefore is often some years later than the surveyed date. Before 1938, all OS maps were based on the Cassini Projection, with independent surveys of a single county or group of counties, giving rise to significant inaccuracies in outlying areas. In the late 1940's, a Provisional Edition was produced, which updated the 1:10,560 mapping from a number of sources. The maps appear unfinished - with all military camps and other strategic sites removed. These maps were initially overprinted with the National Grid. In 1970, the first 1:10,000 maps were produced using the Transverse Mercator Projection. The revision process continued until recently, with new editions appearing every 10 years or so for urban areas.

Map Name(s) and Date(s)

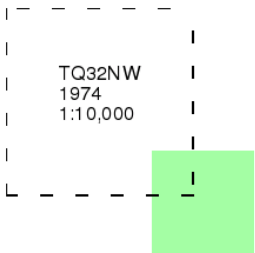

Historical Map - Slice A

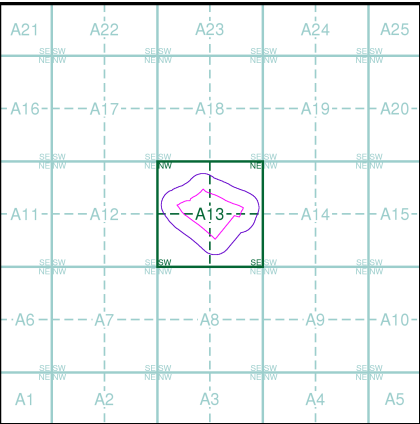

Order Details

Order Number: 334357177_1_1
Customer Ref: 6534
National Grid Reference: 535240, 124870
Slice: A
Site Area (Ha): 6.63
Search Buffer (m): 1000

Site Details

Scamps Hill, Lindfield, Haywards Heath, RH16 2GL

Ordnance Survey Plan

Published 1992 - 1993


Source map scale - 1:10,000

The historical maps shown were reproduced from maps predominantly held at the scale adopted for England, Wales and Scotland in the 1840's. In 1854 the 1:2,500 scale was adopted for mapping urban areas; these maps were used to update the 1:10,560 maps. The published date given therefore is often some years later than the surveyed date. Before 1938, all OS maps were based on the Cassini Projection, with independent surveys of a single county or group of counties, giving rise to significant inaccuracies in outlying areas. In the late 1940's, a Provisional Edition was produced, which updated the 1:10,560 mapping from a number of sources. The maps appear unfinished - with all military camps and other strategic sites removed. These maps were initially overprinted with the National Grid. In 1970, the first 1:10,000 maps were produced using the Transverse Mercator Projection. The revision process continued until recently, with new editions appearing every 10 years or so for urban areas.

Map Name(s) and Date(s)

TQ32NW	1993	1:10,000
TQ32SW	1992	1:10,000

Historical Map - Slice A

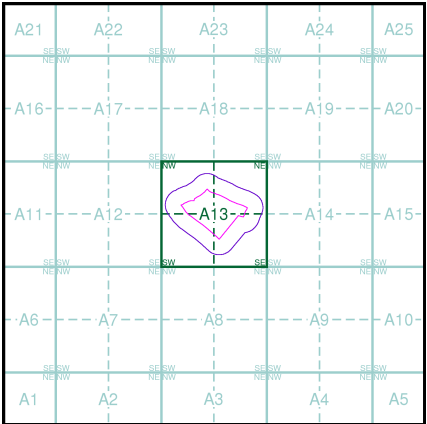

Order Details

Order Number: 334357177_1_1
Customer Ref: 6534
National Grid Reference: 535240, 124870
Slice: A
Site Area (Ha): 6.63
Search Buffer (m): 1000

Site Details

Scamps Hill, Lindfield, Haywards Heath, RH16 2GL

10k Raster Mapping

Published 2000


Source map scale - 1:10,000

The historical maps shown were produced from the Ordnance Survey's 1:10,000 colour raster mapping. These maps are derived from Landplan which replaced the old 1:10,000 maps originally published in 1970. The data is highly detailed showing buildings, fences and field boundaries as well as all roads, tracks and paths. Road names are also included together with the relevant road number and classification. Boundary information depiction includes county, unitary authority, district, civil parish and constituency.

Map Name(s) and Date(s)

TQ32NW	TQ32NE
2000	2000
1:10,000	1:10,000
TQ32SW	TQ32SE
2000	2000
1:10,000	1:10,000

Historical Map - Slice A

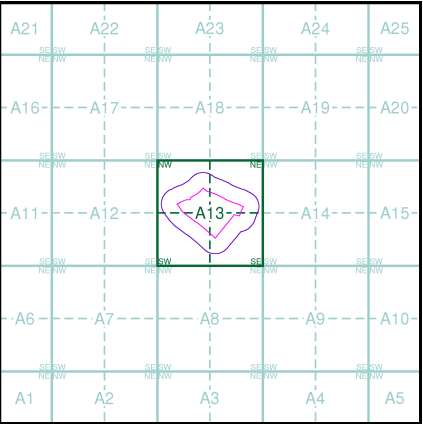

Order Details

Order Number: 334357177_1_1
Customer Ref: 6534
National Grid Reference: 535240, 124870
Slice: A
Site Area (Ha): 6.63
Search Buffer (m): 1000

Site Details

Scamps Hill, Lindfield, Haywards Heath, RH16 2GL

10k Raster Mapping

Published 2006


Source map scale - 1:10,000

The historical maps shown were produced from the Ordnance Survey's 1:10,000 colour raster mapping. These maps are derived from Landplan which replaced the old 1:10,000 maps originally published in 1970. The data is highly detailed showing buildings, fences and field boundaries as well as all roads, tracks and paths. Road names are also included together with the relevant road number and classification. Boundary information depiction includes county, unitary authority, district, civil parish and constituency.

Map Name(s) and Date(s)

TQ32NW	TQ32NE
2006	2006
1:10,000	1:10,000
TQ32SW	TQ32SE
2006	2006
1:10,000	1:10,000

Historical Map - Slice A

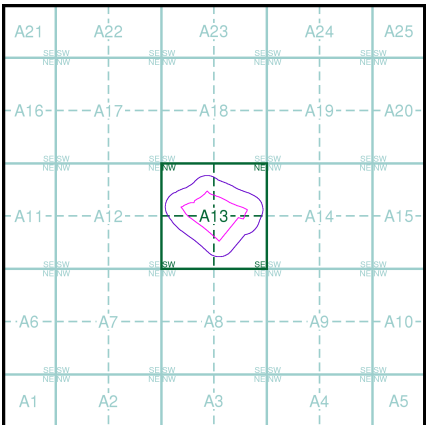

Order Details

Order Number: 334357177_1_1
Customer Ref: 6534
National Grid Reference: 535240, 124870
Slice: A
Site Area (Ha): 6.63
Search Buffer (m): 1000

Site Details

Scamps Hill, Lindfield, Haywards Heath, RH16 2GL

VectorMap Local

Published 2023


Source map scale - 1:10,000

VectorMap Local (Raster) is Ordnance Survey's highest detailed 'backdrop' mapping product. These maps are produced from OS's VectorMap Local, a simple vector dataset at a nominal scale of 1:10,000, covering the whole of Great Britain, that has been designed for creating graphical mapping. OS VectorMap Local is derived from large-scale information surveyed at 1:1250 scale (covering major towns and cities), 1:2500 scale (smaller towns, villages and developed rural areas), and 1:10 000 scale (mountain, moorland and river estuary areas).

Map Name(s) and Date(s)

TQ32NW	TQ32NE
2023	2023
Variable	Variable
TQ32SW	TQ32SE
2023	2023
Variable	Variable

Historical Map - Slice A

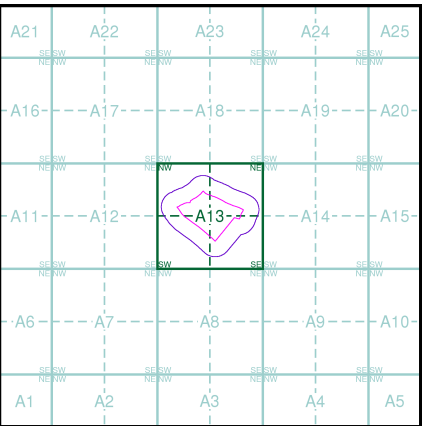

Order Details


Order Number: 334357177_1_1
Customer Ref: 6534
National Grid Reference: 535240, 124870
Slice: A
Site Area (Ha): 6.63
Search Buffer (m): 1000

Site Details

Scamps Hill, Lindfield, Haywards Heath, RH16 2GL

Historical Mapping Legends


Ordnance Survey County Series and Ordnance Survey Plan 1:2,500

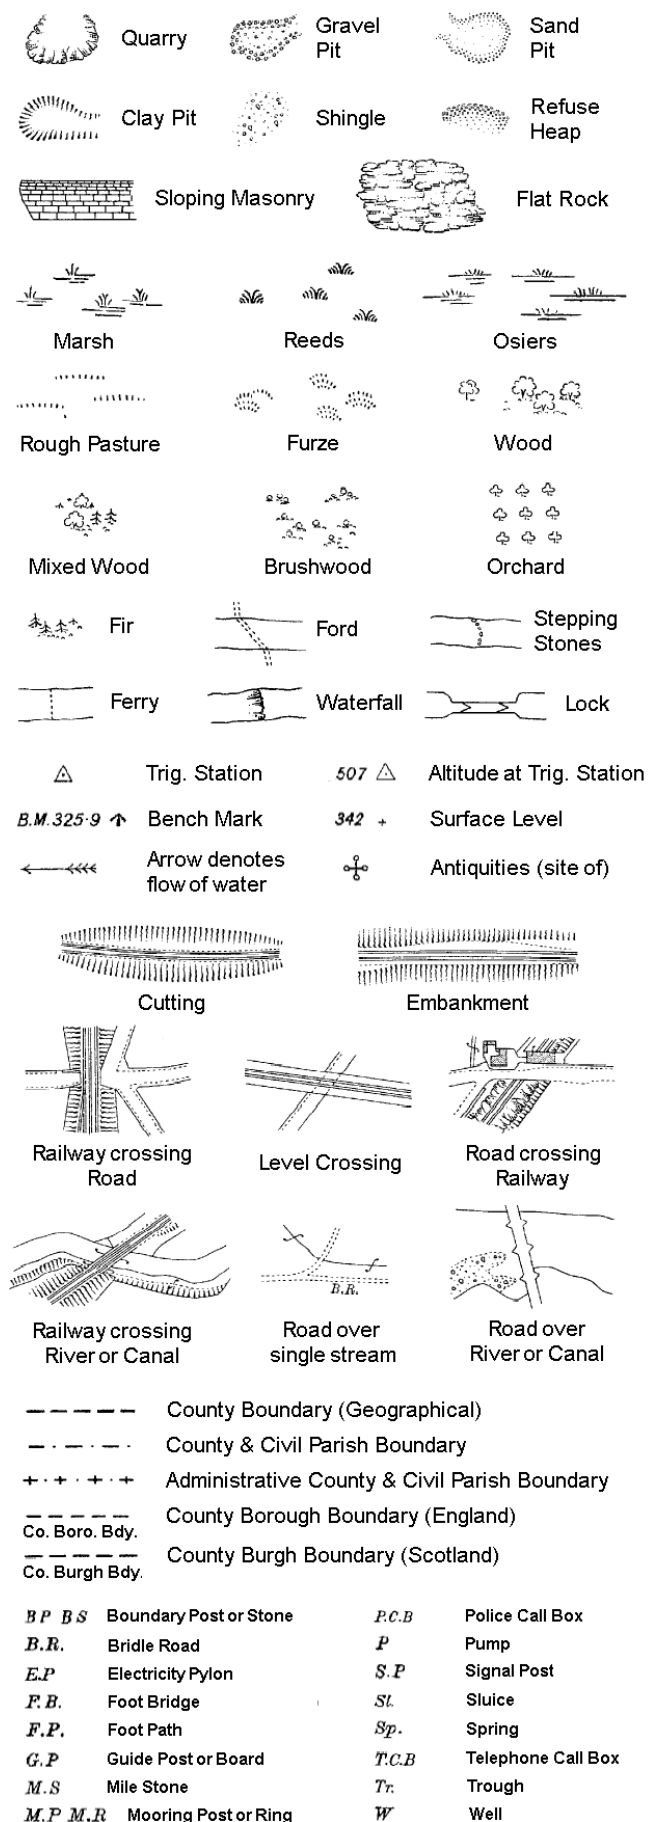

Ordnance Survey Plan, Additional SIMs and Supply of Unpublished Survey Information 1:2,500 and 1:1,250



Large-Scale National Grid Data 1:2,500 and 1:1,250

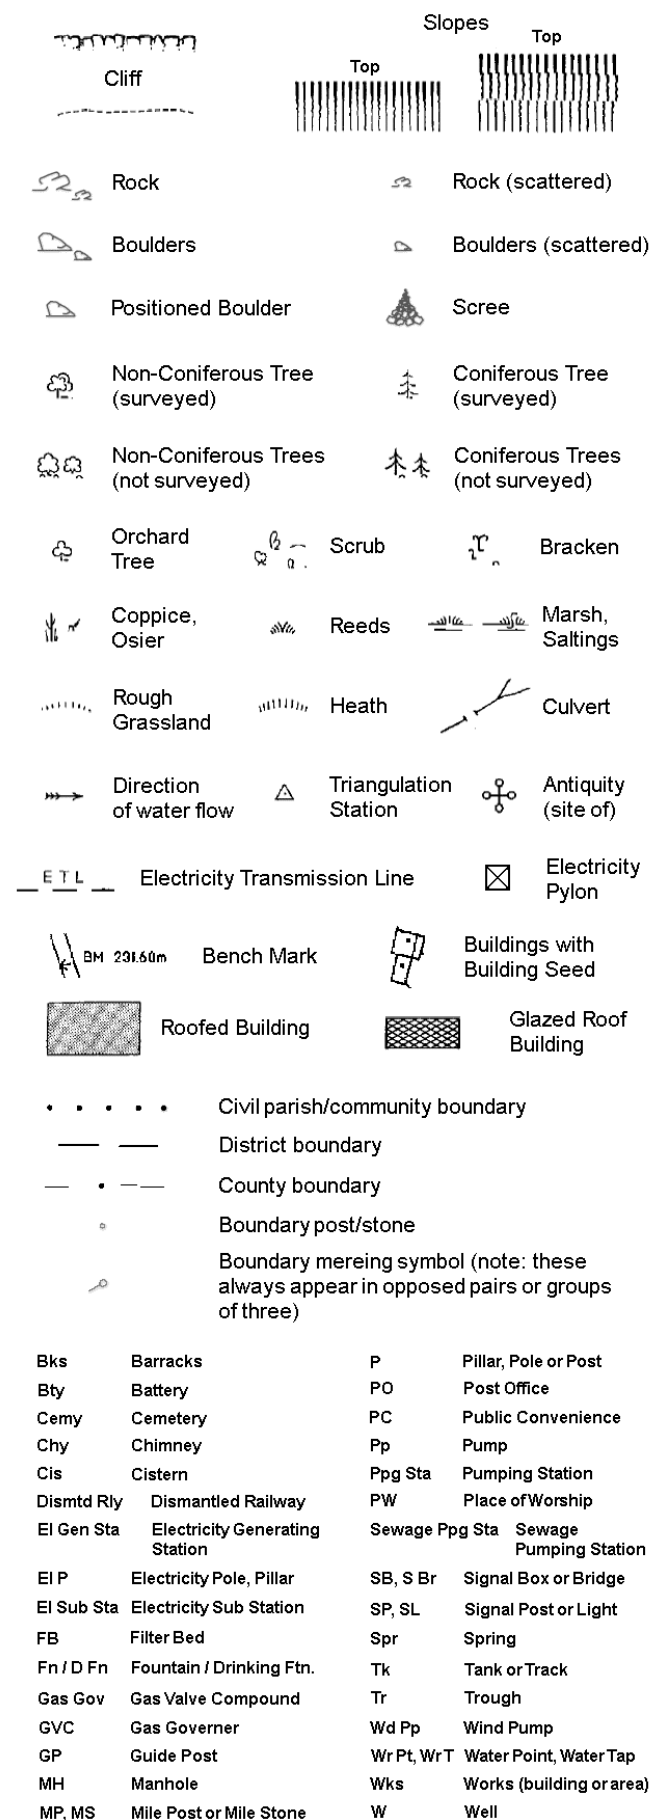

CD1.18


Envirocheck®

LANDMARK INFORMATION GROUP®

Historical Mapping & Photography included:

Mapping Type	Scale	Date	Pg
Sussex	1:2,500	1875	2
Sussex	1:2,500	1897	3
Sussex	1:2,500	1910	4
Sussex	1:2,500	1937	5
Ordnance Survey Plan	1:2,500	1955	6
Ordnance Survey Plan	1:2,500	1962 - 1964	7
Ordnance Survey Plan	1:2,500	1970 - 1971	8
Supply of Unpublished Survey Information	1:2,500	1973 - 1975	9
Ordnance Survey Plan	1:1,250	1975 - 1976	10
Additional SIMs	1:1,250	1987	11
Large-Scale National Grid Data	1:1,250	1993 - 1994	12
Large-Scale National Grid Data	1:2,500	1994	13
Historical Aerial Photography	1:2,500	1999	14

Historical Map - Segment A13

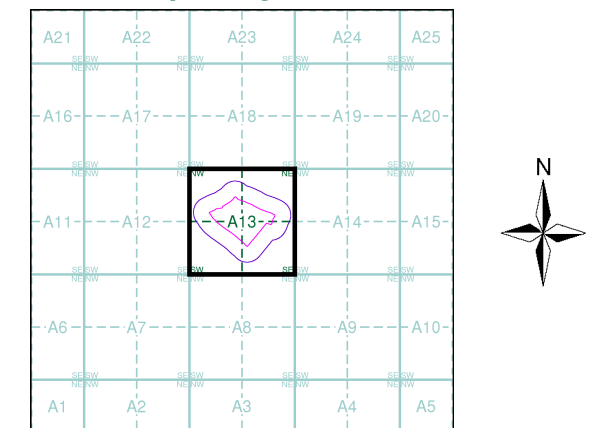

Order Details

Order Number: 334357177_1_1
Customer Ref: 6534
National Grid Reference: 535240, 124870
Slice: A
Site Area (Ha): 6.63
Search Buffer (m): 100

Site Details


Scamps Hill, Lindfield, Haywards Heath, RH16 2GL

Landmark®
INFORMATION GROUP


Tel: 0844 844 9952
Fax: 0844 844 9951
Web: www.envirocheck.co.uk

The historical maps shown were reproduced from maps predominantly held at the scale adopted for England, Wales and Scotland in the 1840's. In 1854 the 1:2,500 scale was adopted for mapping urban areas and by 1896 it covered the whole of what were considered to be the cultivated parts of Great Britain. The published date given below is often some years later than the surveyed date. Before 1938, all OS maps were based on the Cassini Projection, with independent surveys of a single county or group of counties, giving rise to significant inaccuracies in outlying areas.

Map Name(s) and Date(s)

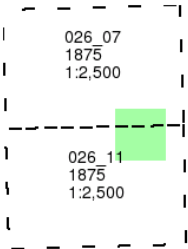

Historical Map - Segment A13

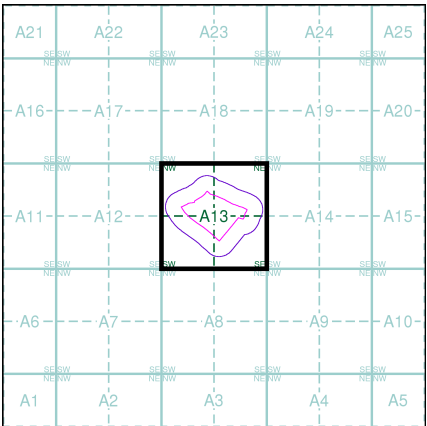


Order Details

Order Number: 334357177_1_1
Customer Ref: 6534
National Grid Reference: 535240, 124870
Slice: A
Site Area (Ha): 6.63
Search Buffer (m): 100


Site Details

Scamps Hill, Lindfield, Haywards Heath, RH16 2GL

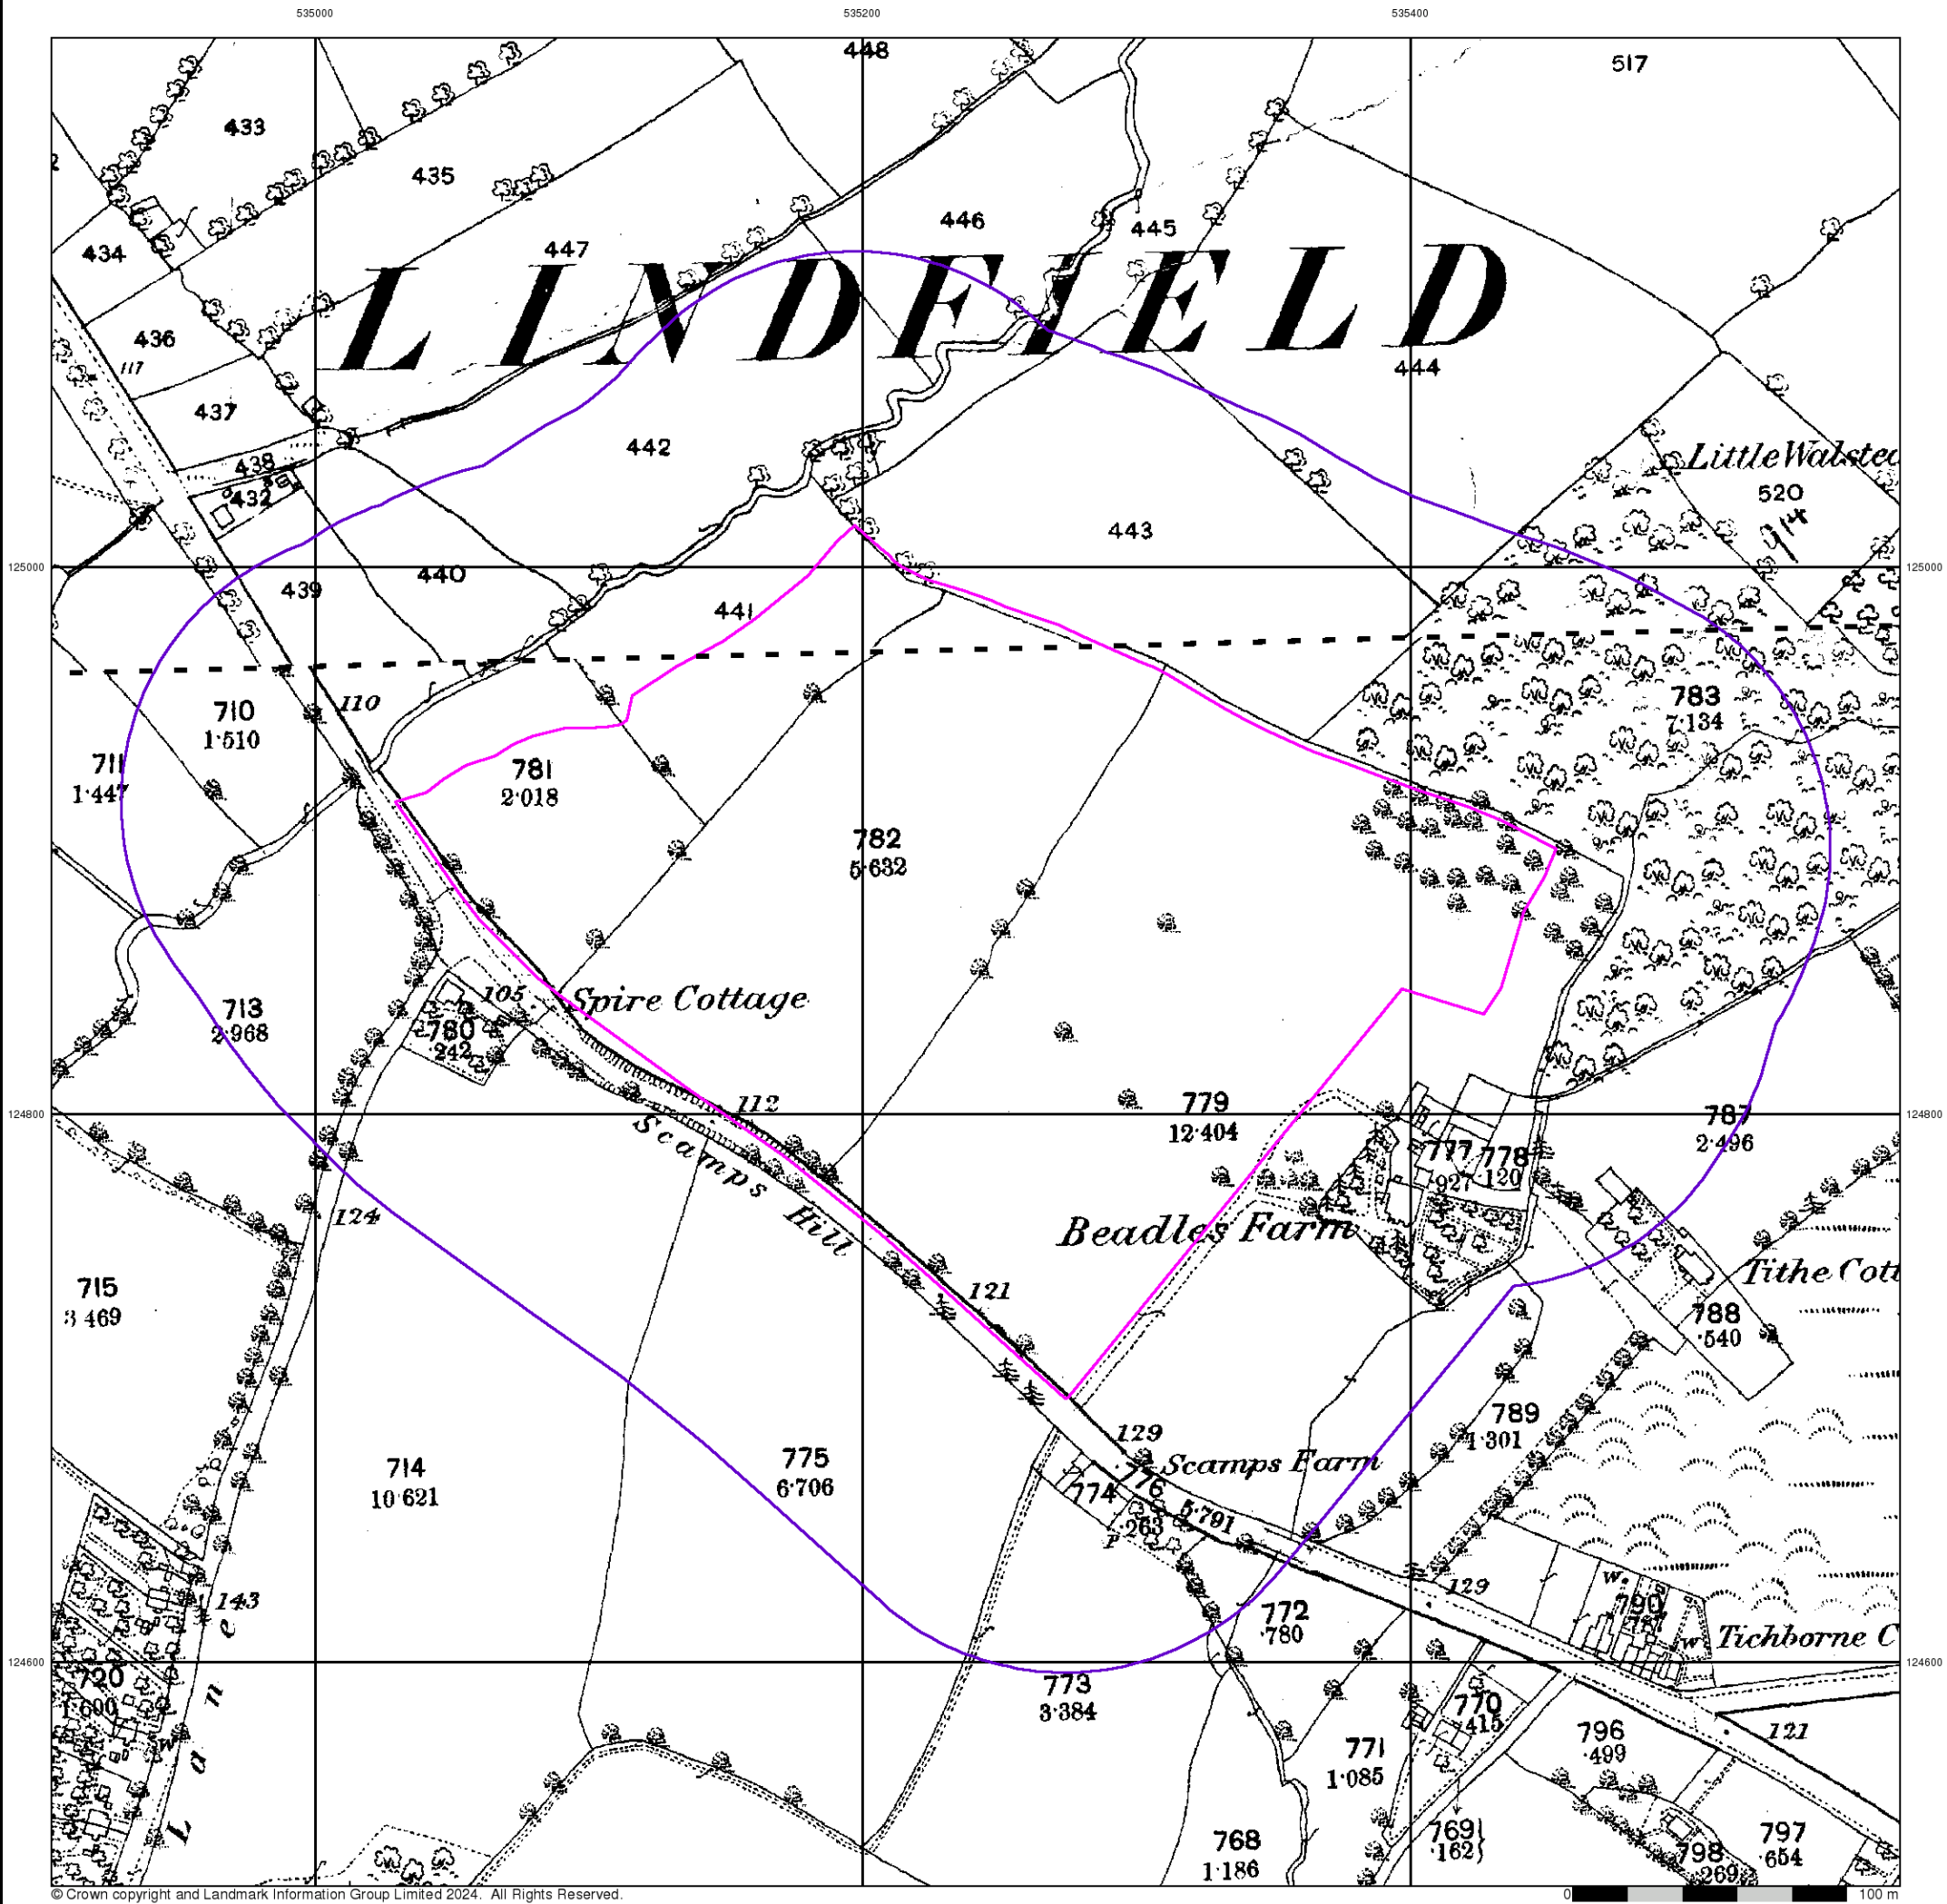


The historical maps shown were reproduced from maps predominantly held at the scale adopted for England, Wales and Scotland in the 1840's. In 1854 the 1:2,500 scale was adopted for mapping urban areas and by 1896 it covered the whole of what were considered to be the cultivated parts of Great Britain. The published date given below is often some years later than the surveyed date. Before 1938, all OS maps were based on the Cassini Projection, with independent surveys of a single county or group of counties, giving rise to significant inaccuracies in outlying areas.

Map Name(s) and Date(s)

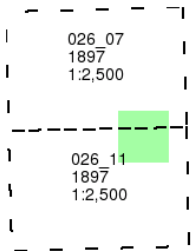

Historical Map - Segment A13

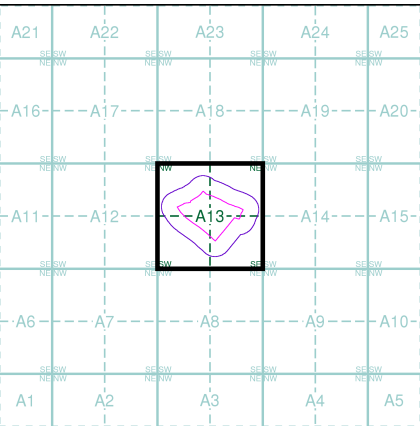


Order Details

Order Number: 334357177_1_1
Customer Ref: 6534
National Grid Reference: 535240, 124870
Slice: A
Site Area (Ha): 6.63
Search Buffer (m): 100


Site Details

Scamps Hill, Lindfield, Haywards Heath, RH16 2GL

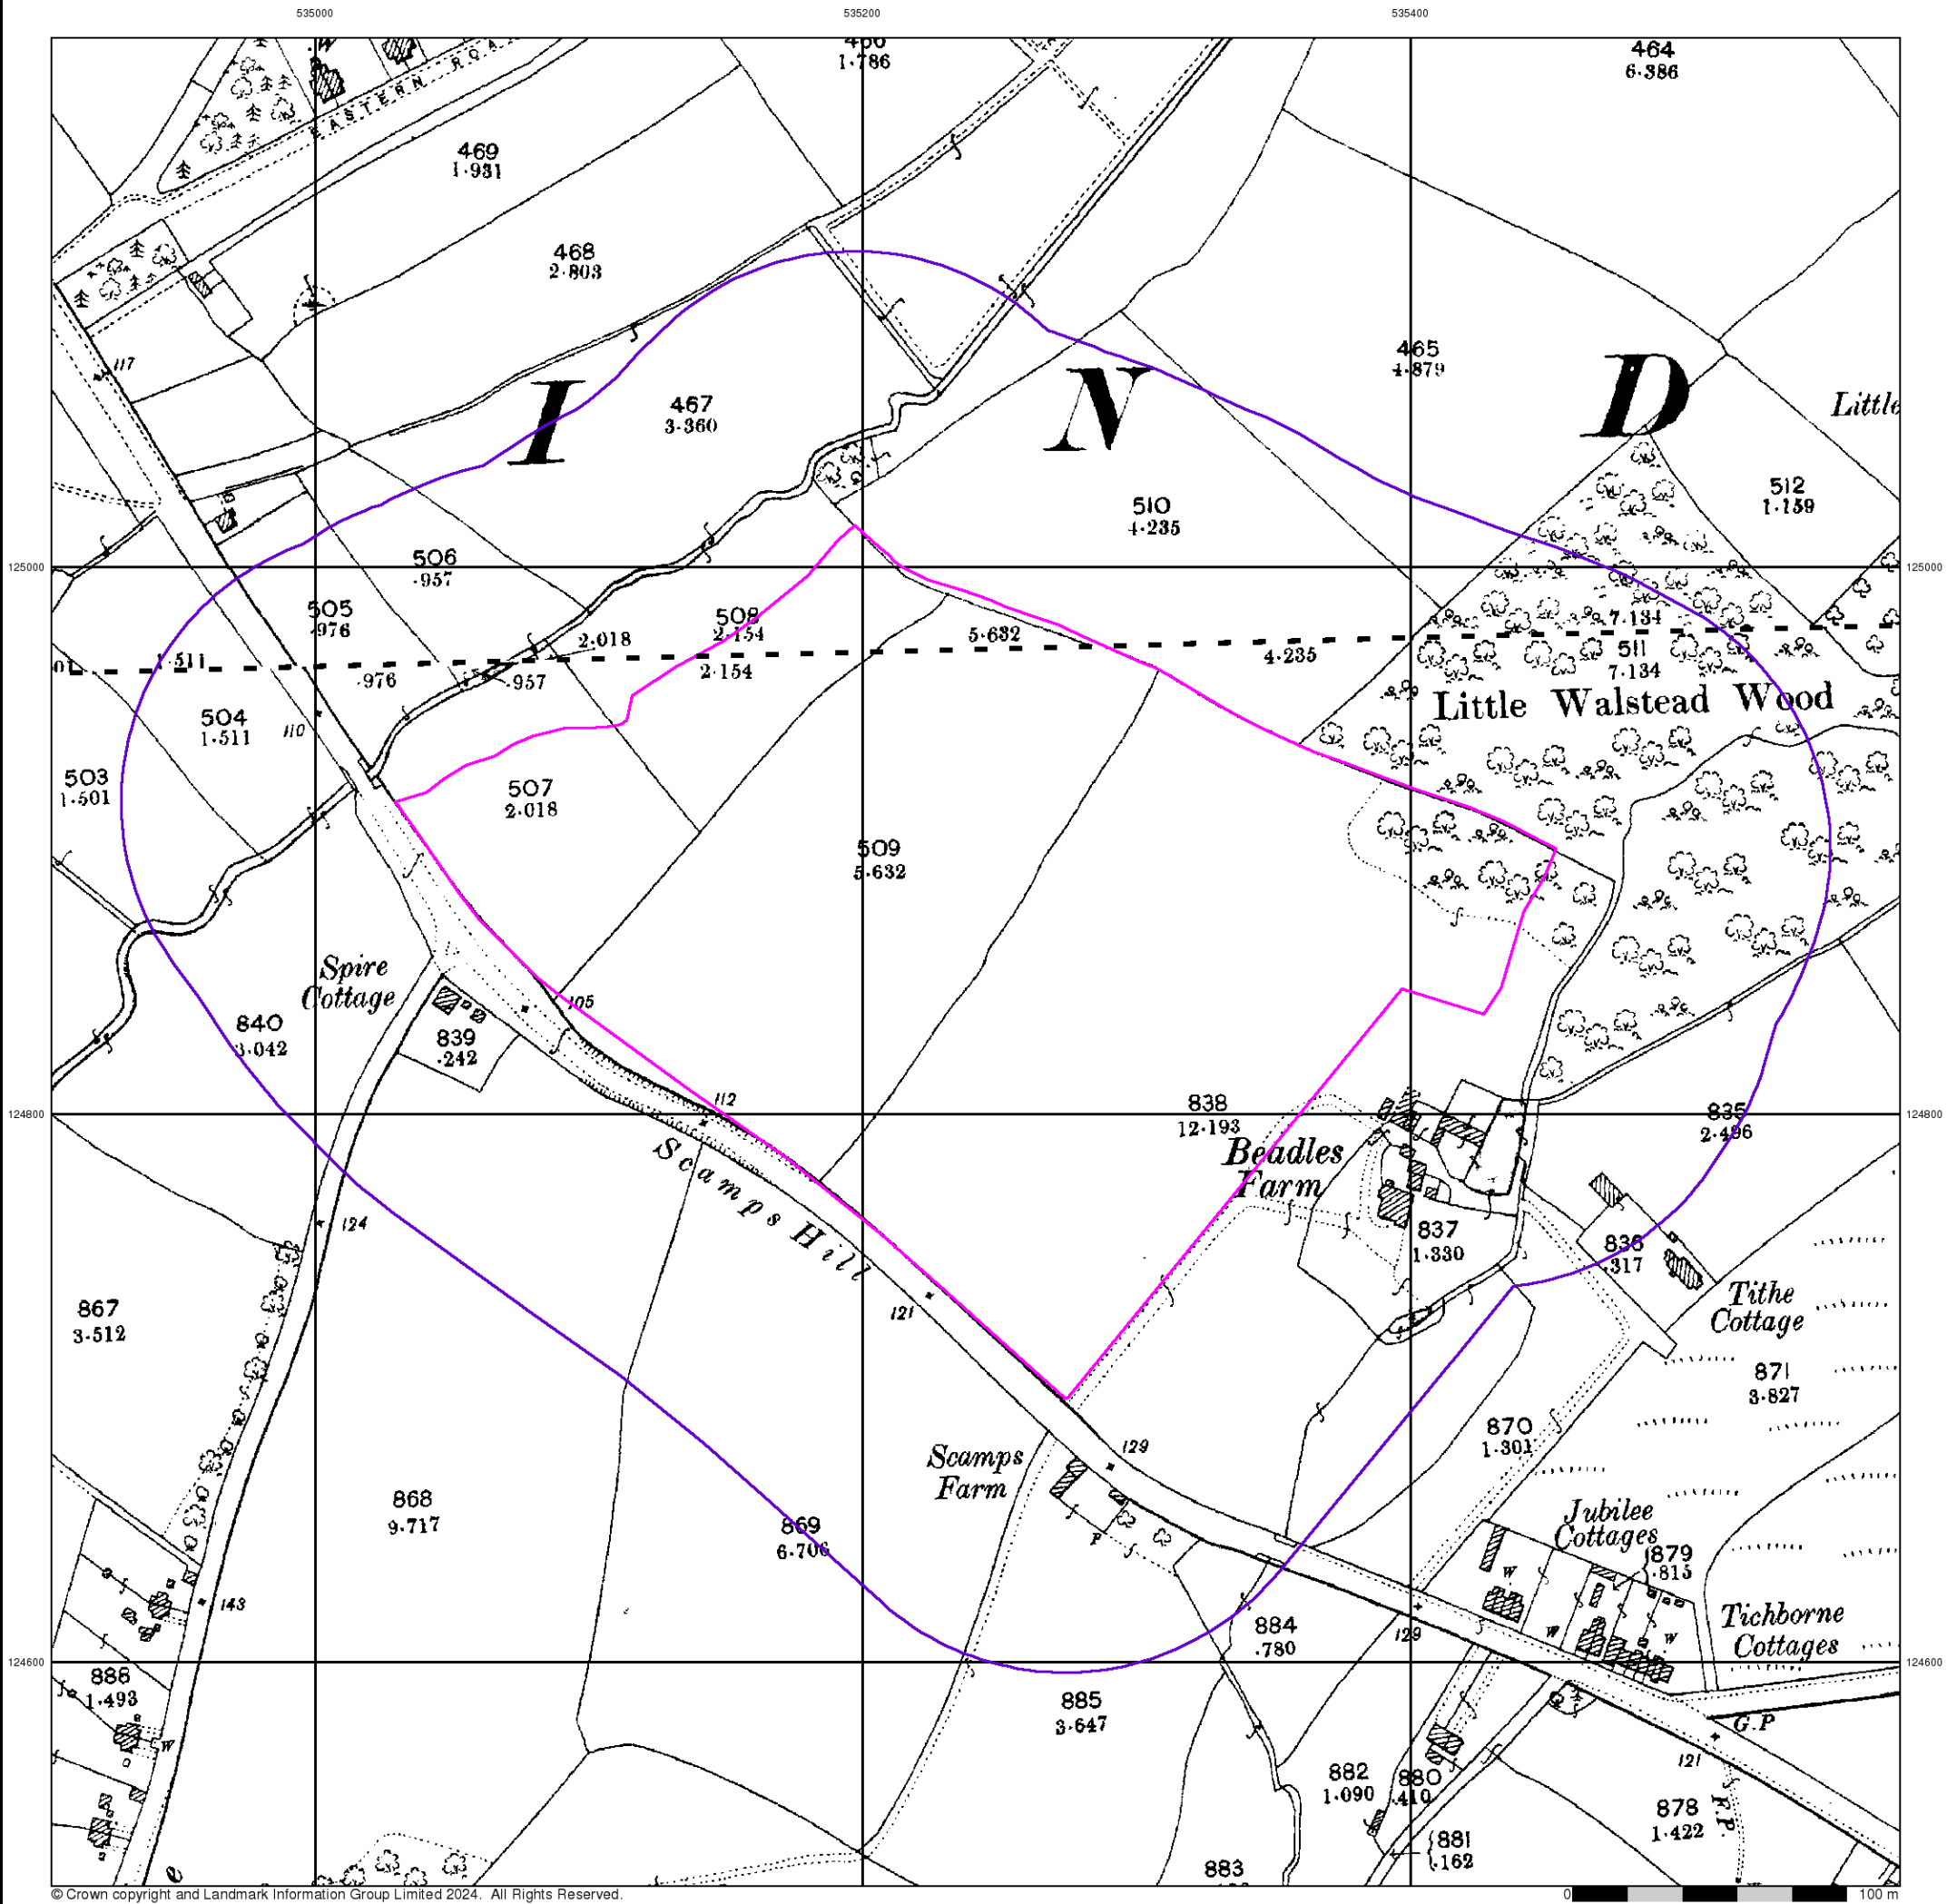


The historical maps shown were reproduced from maps predominantly held at the scale adopted for England, Wales and Scotland in the 1840's. In 1854 the 1:2,500 scale was adopted for mapping urban areas and by 1896 it covered the whole of what were considered to be the cultivated parts of Great Britain. The published date given below is often some years later than the surveyed date. Before 1938, all OS maps were based on the Cassini Projection, with independent surveys of a single county or group of counties, giving rise to significant inaccuracies in outlying areas.

Map Name(s) and Date(s)

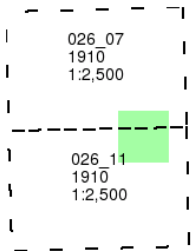

Historical Map - Segment A13

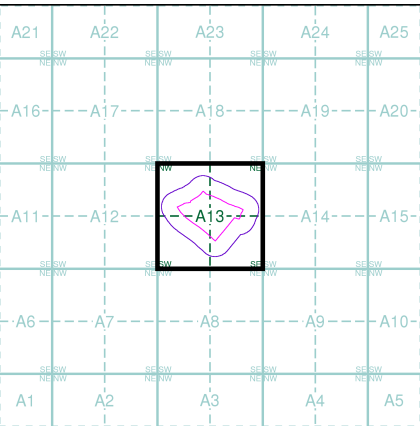


Order Details

Order Number: 334357177_1_1
Customer Ref: 6534
National Grid Reference: 535240, 124870
Slice: A
Site Area (Ha): 6.63
Search Buffer (m): 100


Site Details

Scamps Hill, Lindfield, Haywards Heath, RH16 2GL

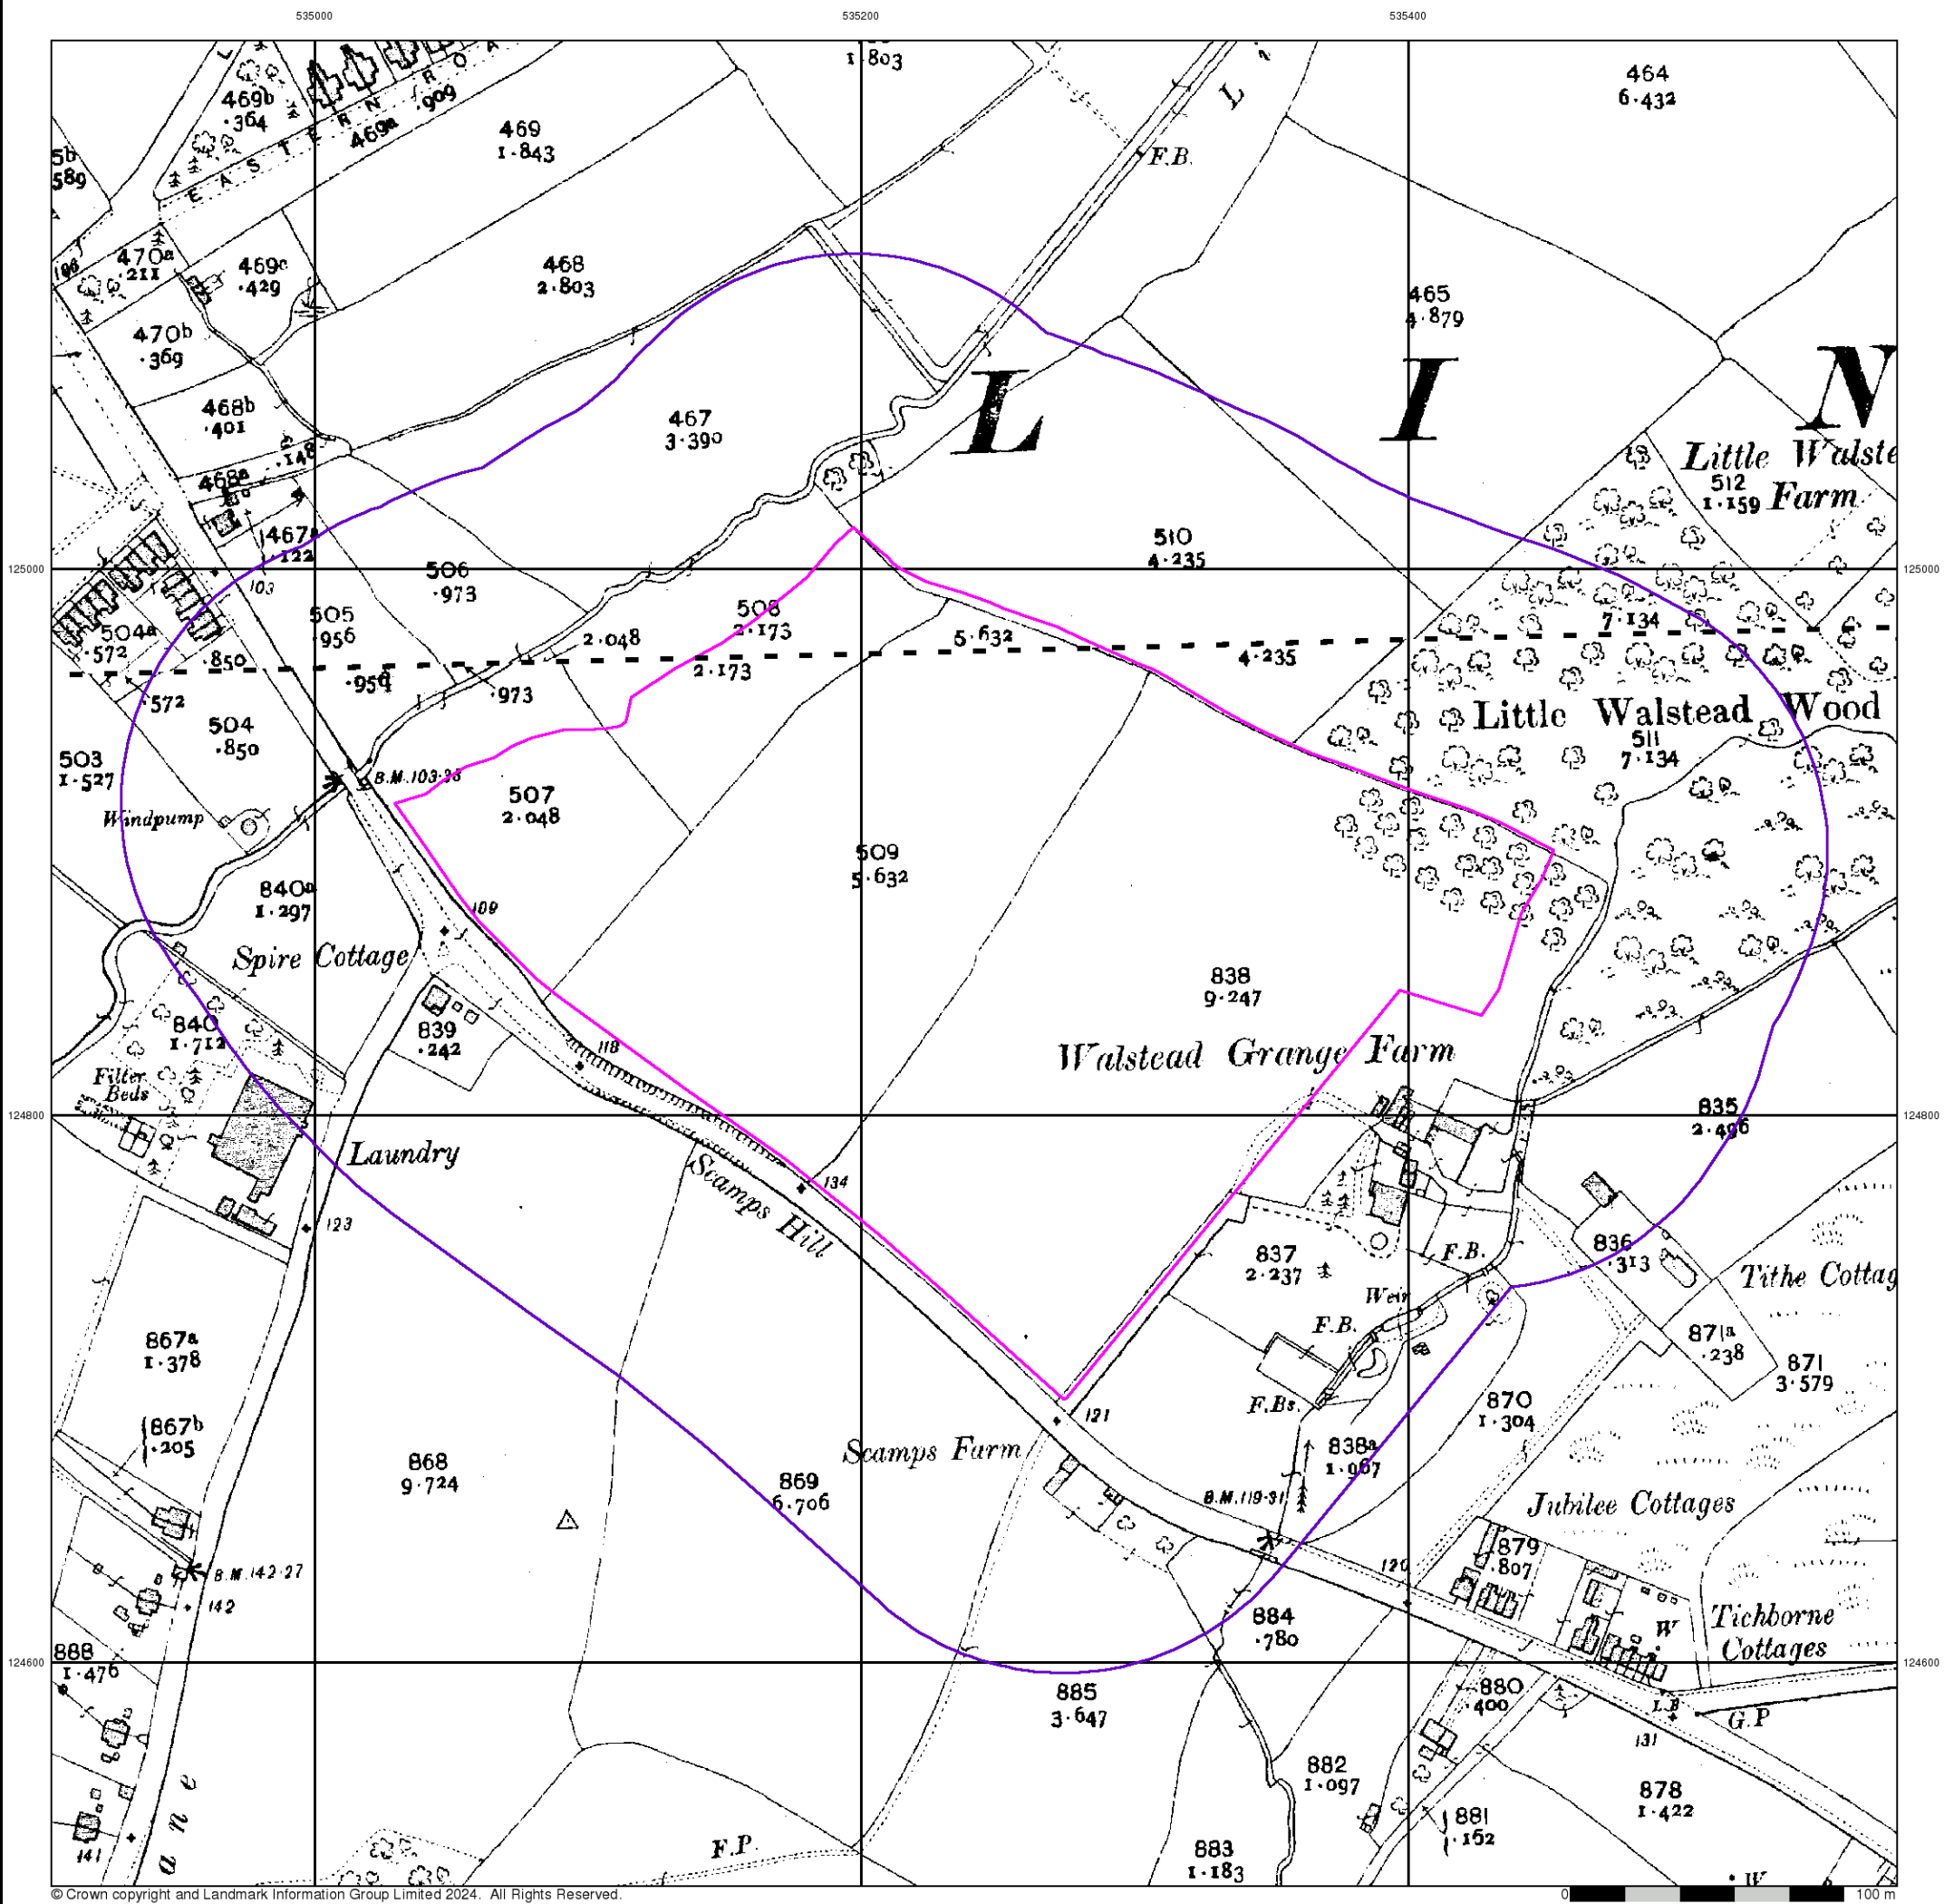


The historical maps shown were reproduced from maps predominantly held at the scale adopted for England, Wales and Scotland in the 1840's. In 1854 the 1:2,500 scale was adopted for mapping urban areas and by 1896 it covered the whole of what were considered to be the cultivated parts of Great Britain. The published date given below is often some years later than the surveyed date. Before 1938, all OS maps were based on the Cassini Projection, with independent surveys of a single county or group of counties, giving rise to significant inaccuracies in outlying areas.

Map Name(s) and Date(s)

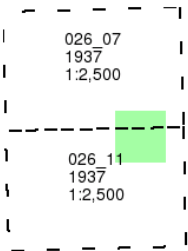

Historical Map - Segment A13

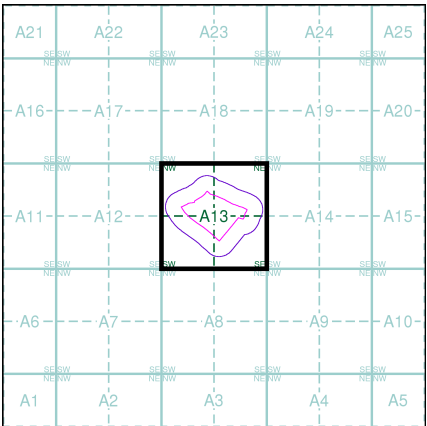


Order Details

Order Number: 334357177_1_1
Customer Ref: 6534
National Grid Reference: 535240, 124870
Slice: A
Site Area (Ha): 6.63
Search Buffer (m): 100

Site Details

Scamps Hill, Lindfield, Haywards Heath, RH16 2GL

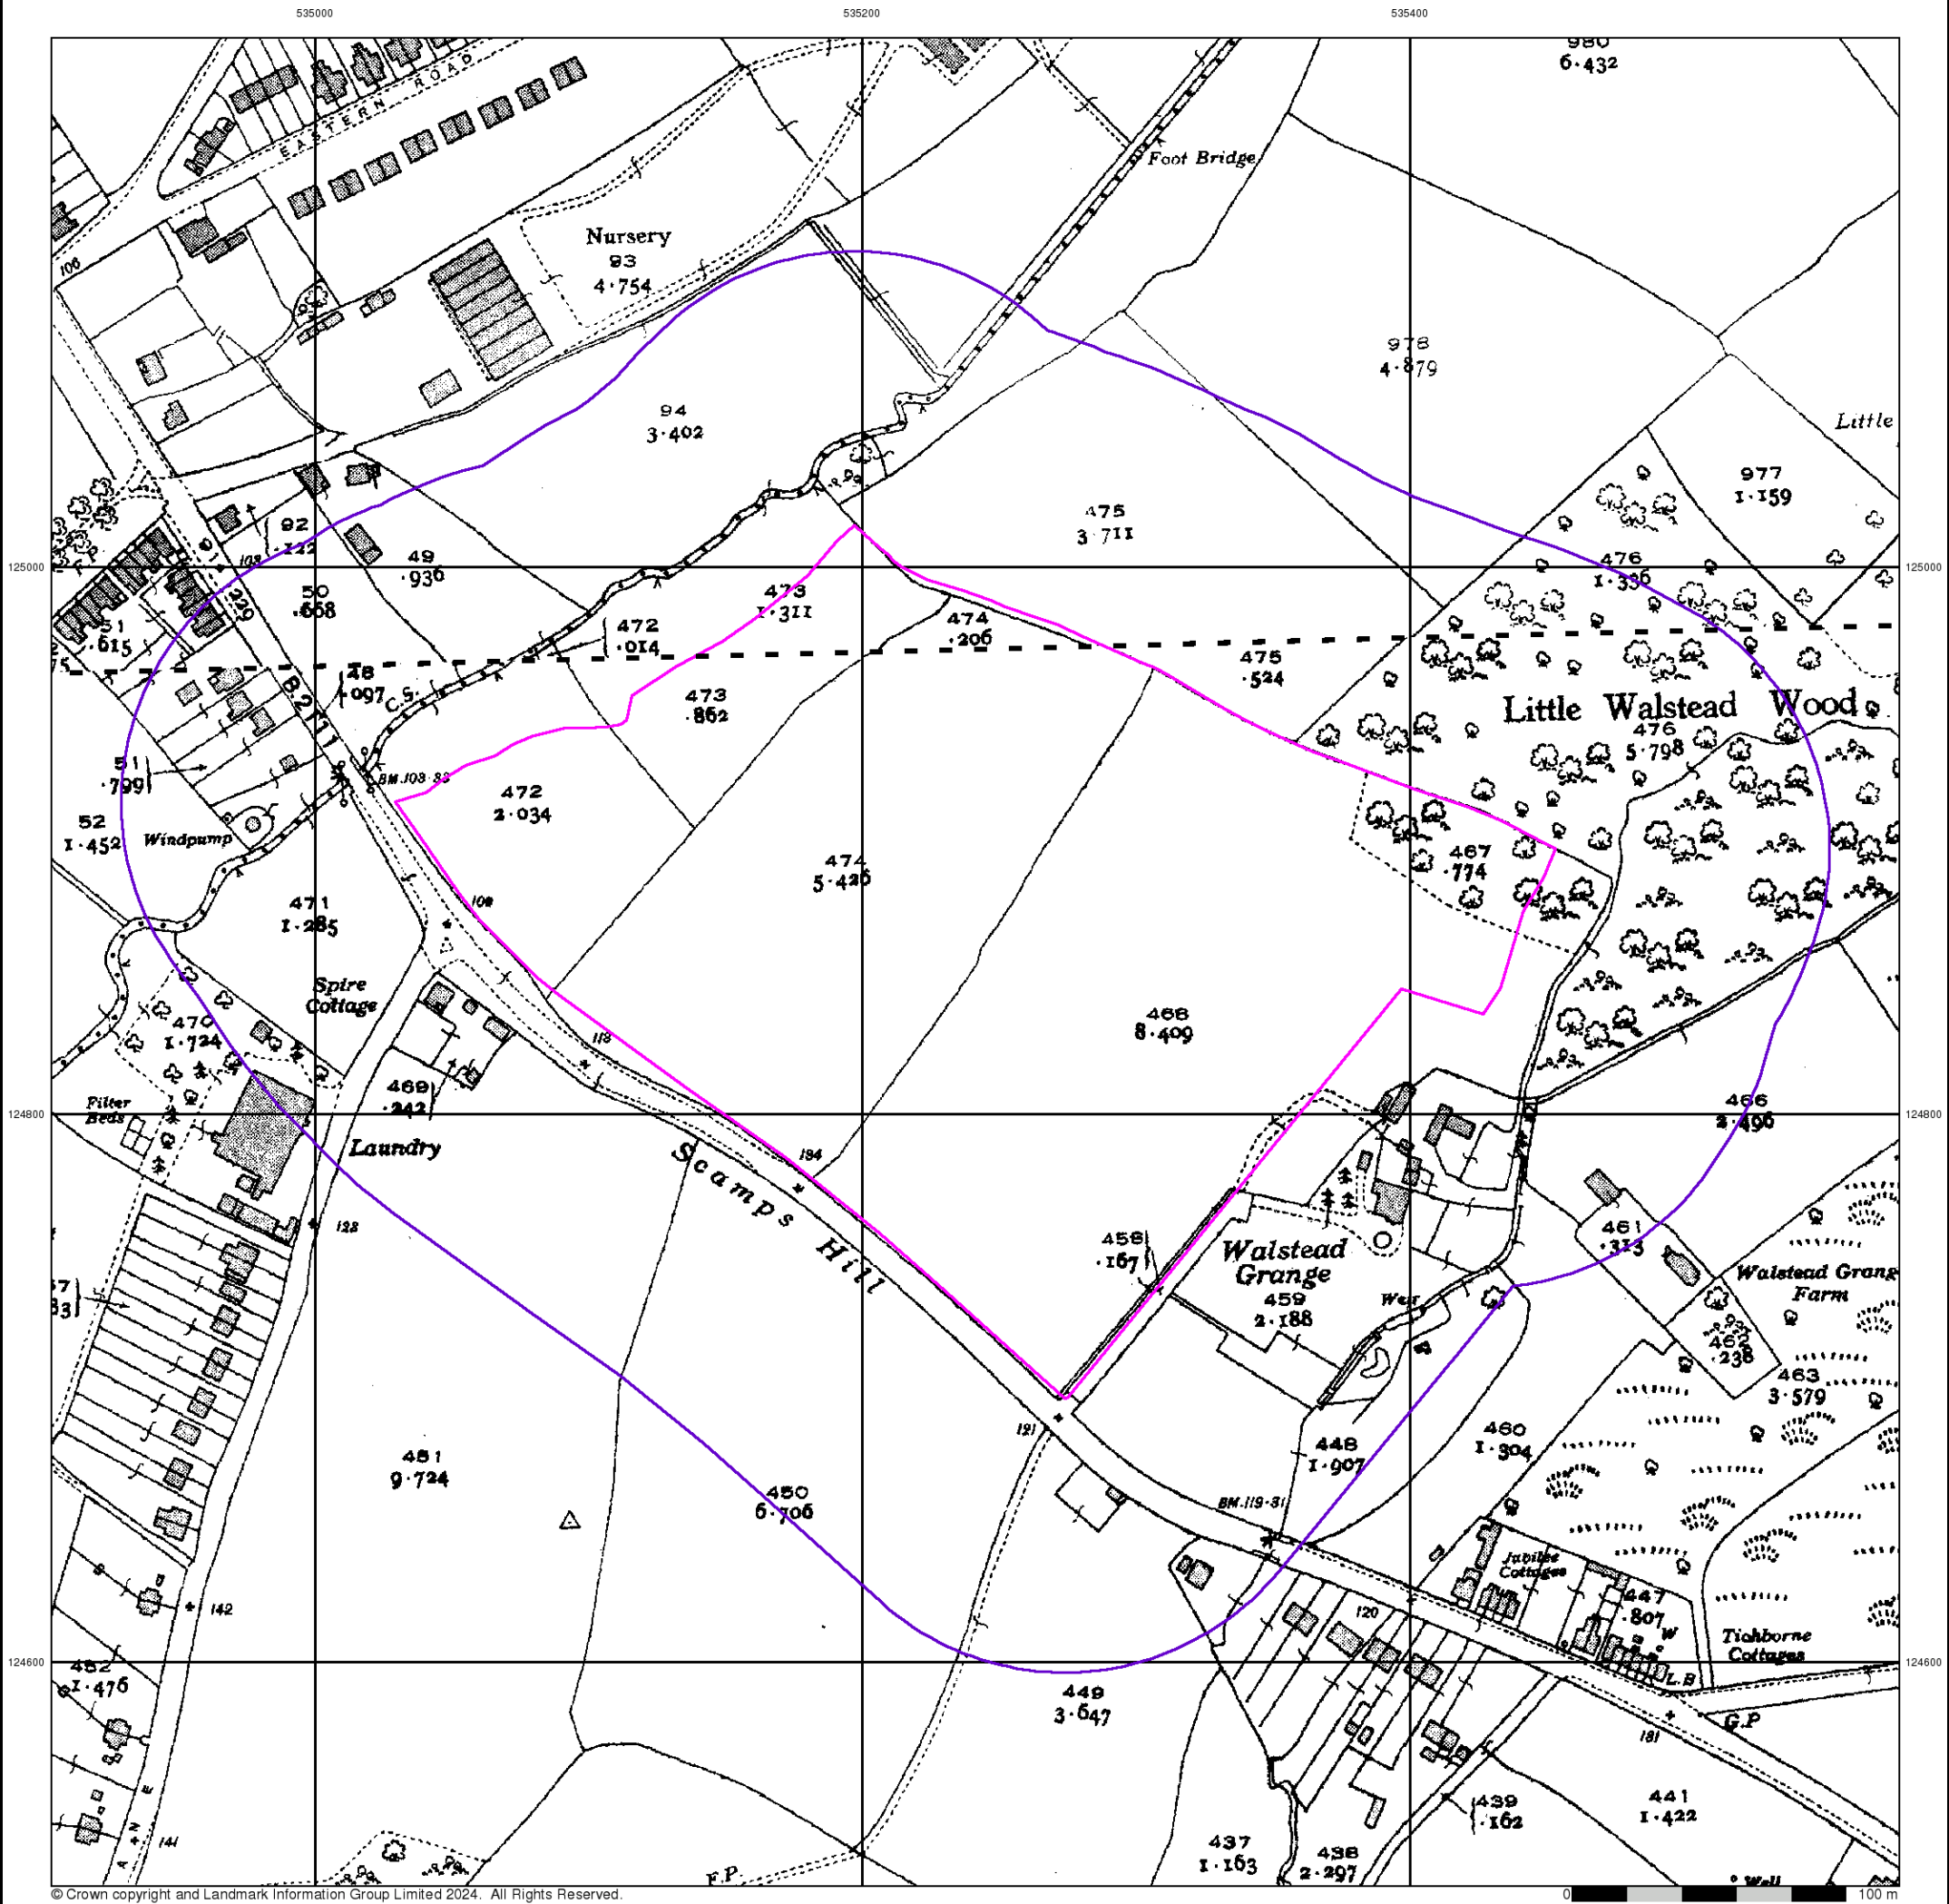

Ordnance Survey Plan

Published 1955


Source map scale - 1:2,500

The historical maps shown were reproduced from maps predominantly held at the scale adopted for England, Wales and Scotland in the 1840's. In 1854 the 1:2,500 scale was adopted for mapping urban areas and by 1896 it covered the whole of what were considered to be the cultivated parts of Great Britain. The published date given below is often some years later than the surveyed date. Before 1938, all OS maps were based on the Cassini Projection, with independent surveys of a single county or group of counties, giving rise to significant inaccuracies in outlying areas.

Map Name(s) and Date(s)

TQ3425 1955 12,500	TQ3525 1955 12,500
TQ3424 1955 12,500	TQ3524 1955 12,500

Historical Map - Segment A13

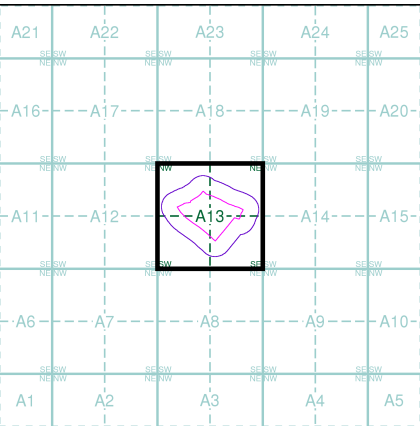


Order Details

Order Number: 334357177_1_1
Customer Ref: 6534
National Grid Reference: 535240, 124870
Slice: A
Site Area (Ha): 6.63
Search Buffer (m): 100

Site Details

Scamps Hill, Lindfield, Haywards Heath, RH16 2GL

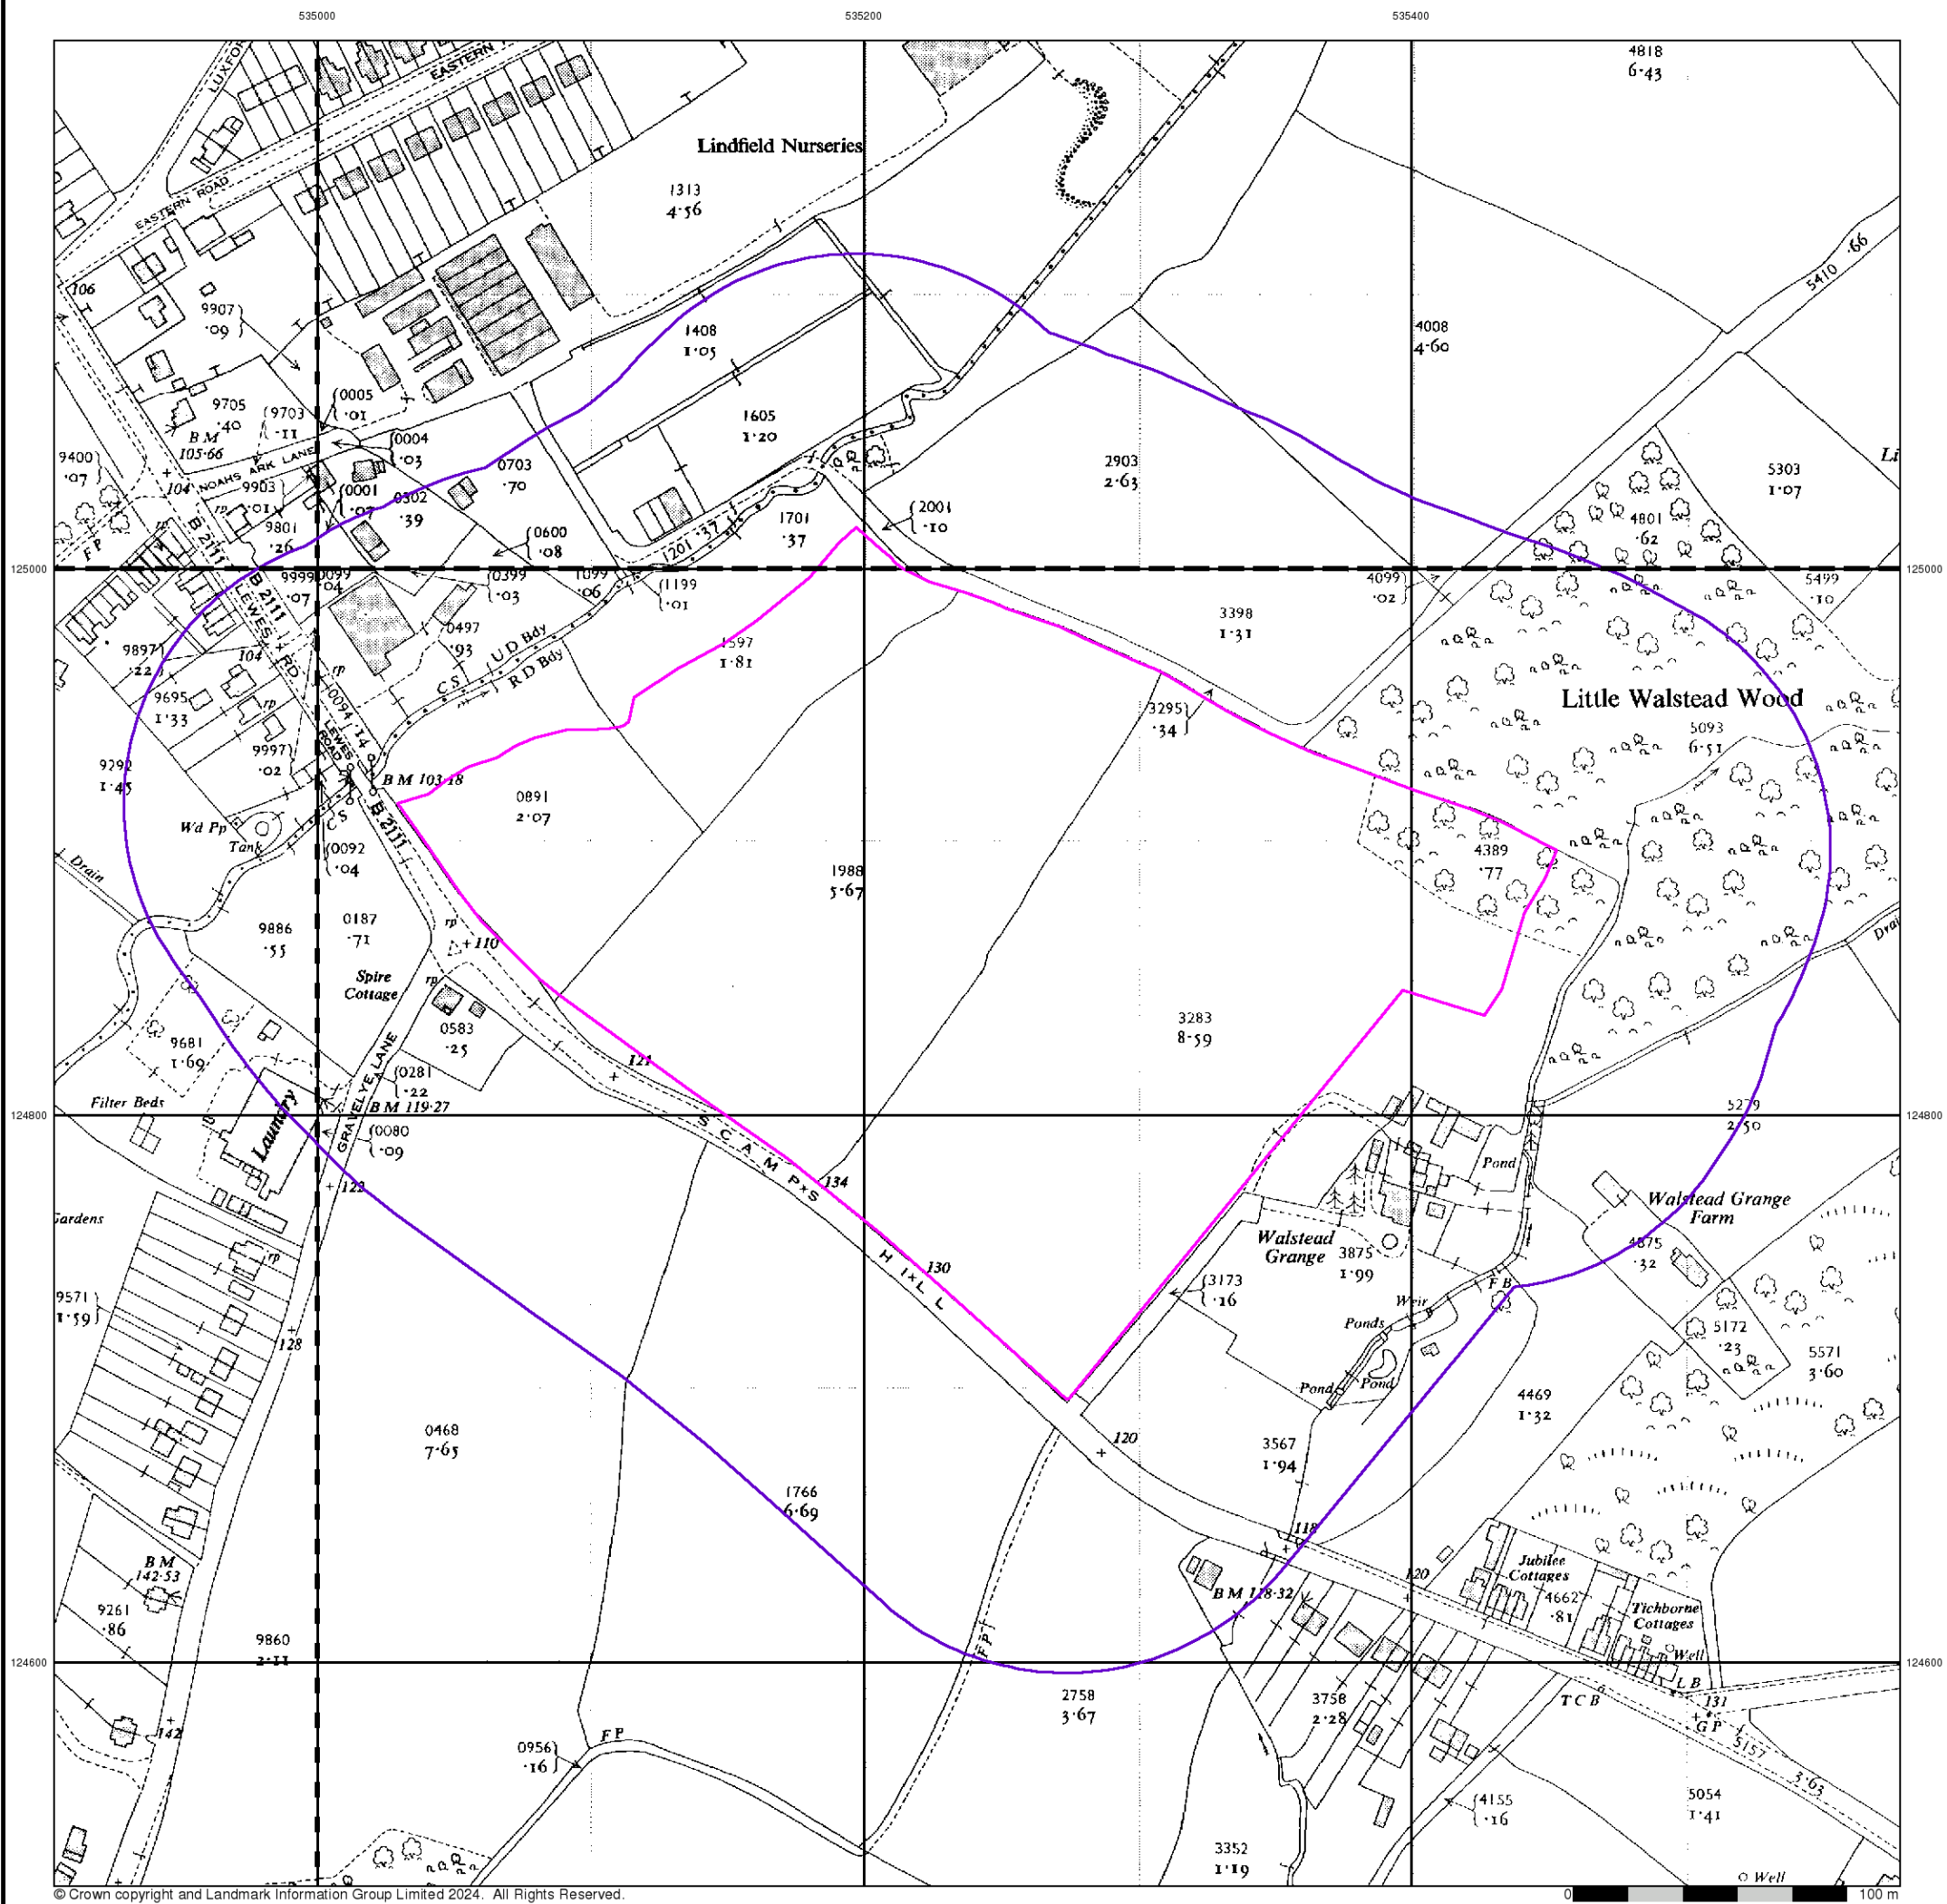

Ordnance Survey Plan

Published 1962 - 1964


Source map scale - 1:2,500

The historical maps shown were reproduced from maps predominantly held at the scale adopted for England, Wales and Scotland in the 1840's. In 1854 the 1:2,500 scale was adopted for mapping urban areas and by 1896 it covered the whole of what were considered to be the cultivated parts of Great Britain. The published date given below is often some years later than the surveyed date. Before 1938, all OS maps were based on the Cassini Projection, with independent surveys of a single county or group of counties, giving rise to significant inaccuracies in outlying areas.

Map Name(s) and Date(s)

TQ3425 1962 12,500	TQ3525 1962 12,500
TQ3424 1964 12,500	TQ3524 1964 12,500

Historical Map - Segment A13

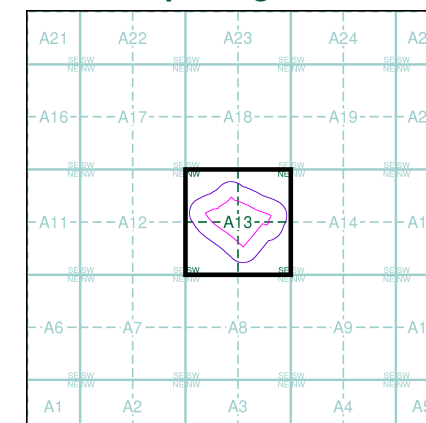


Order Details

Order Number: 334357177_1_1
 Customer Ref: 6534
 National Grid Reference: 535240, 124870
 Slice: A
 Site Area (Ha): 6.63
 Search Buffer (m): 100

Site Details

Scamps Hill, Lindfield, Haywards Heath, RH16 2GL

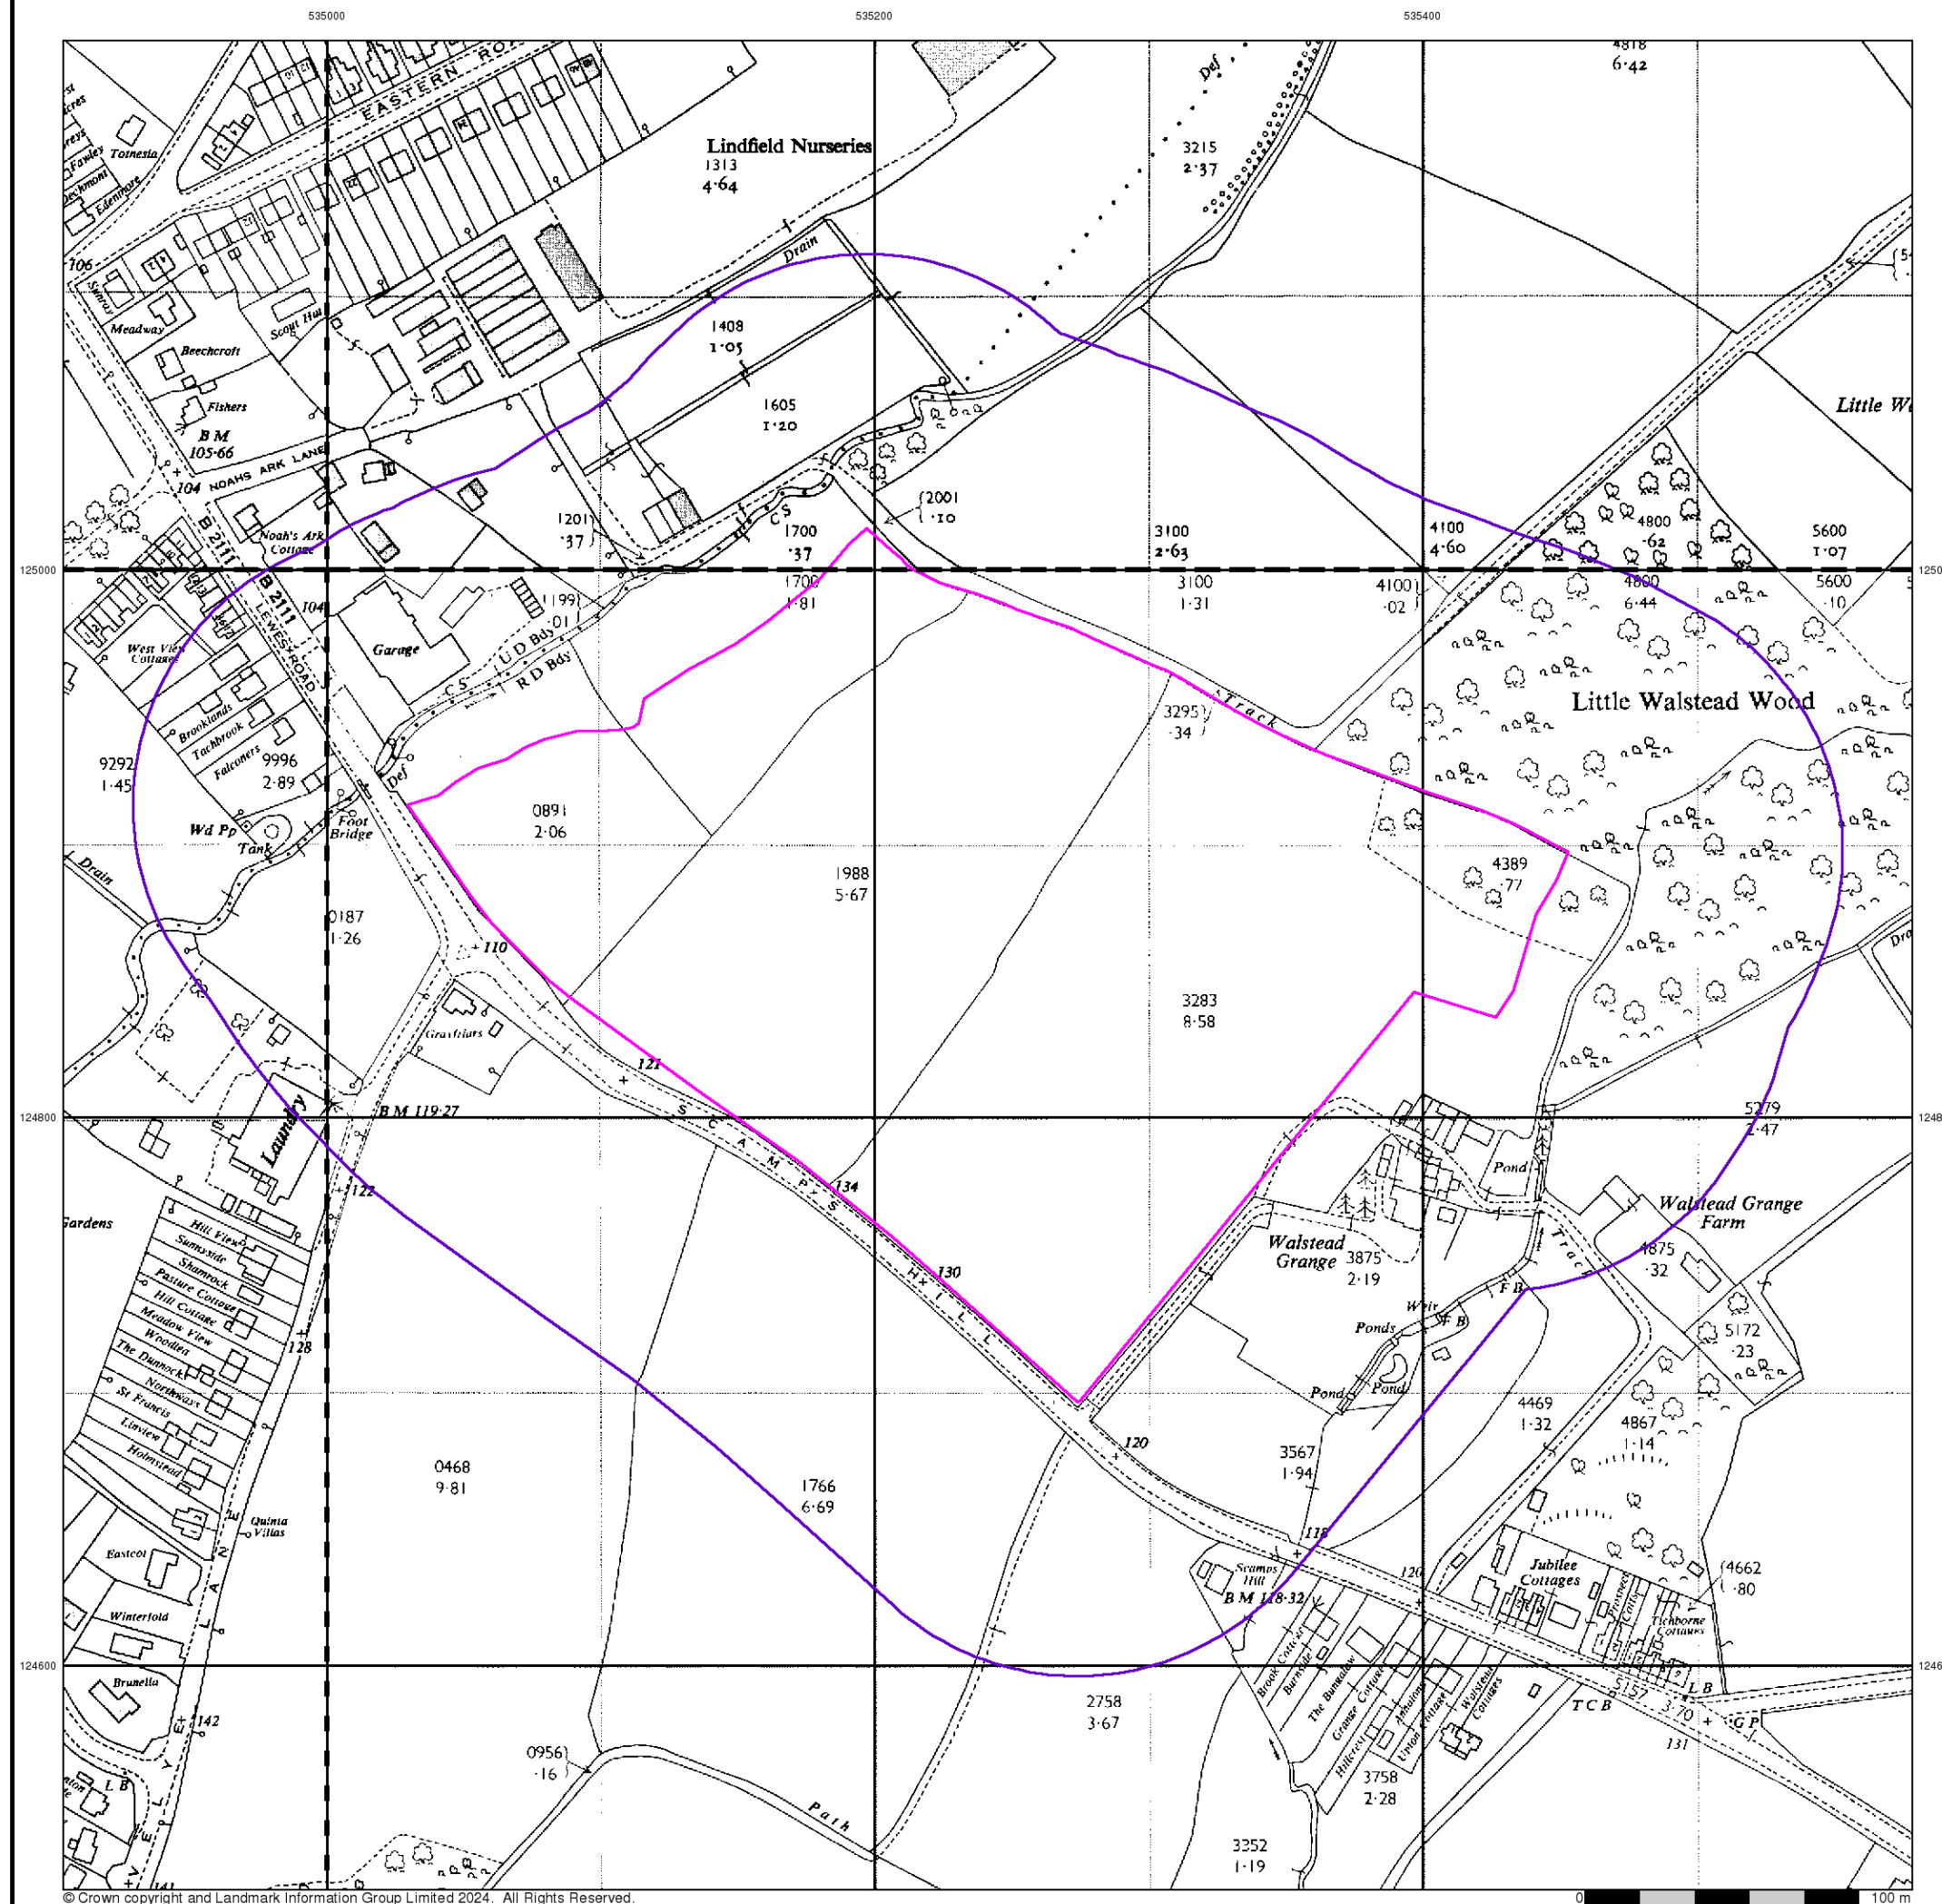

Ordnance Survey Plan

Published 1970 - 1971


Source map scale - 1:2,500

The historical maps shown were reproduced from maps predominantly held at the scale adopted for England, Wales and Scotland in the 1840's. In 1854 the 1:2,500 scale was adopted for mapping urban areas and by 1896 it covered the whole of what were considered to be the cultivated parts of Great Britain. The published date given below is often some years later than the surveyed date. Before 1938, all OS maps were based on the Cassini Projection, with independent surveys of a single county or group of counties, giving rise to significant inaccuracies in outlying areas.

Map Name(s) and Date(s)

TQ3425 1970 12,500	TQ3525 1970 12,500
TQ3424 1971 12,500	TQ3524 1971 12,500

Historical Map - Segment A13

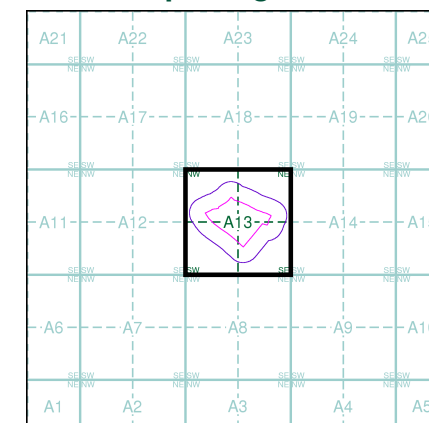


Order Details

Order Number: 334357177_1_1
 Customer Ref: 6534
 National Grid Reference: 535240, 124870
 Slice: A
 Site Area (Ha): 6.63
 Search Buffer (m): 100

Site Details

Scamps Hill, Lindfield, Haywards Heath, RH16 2GL

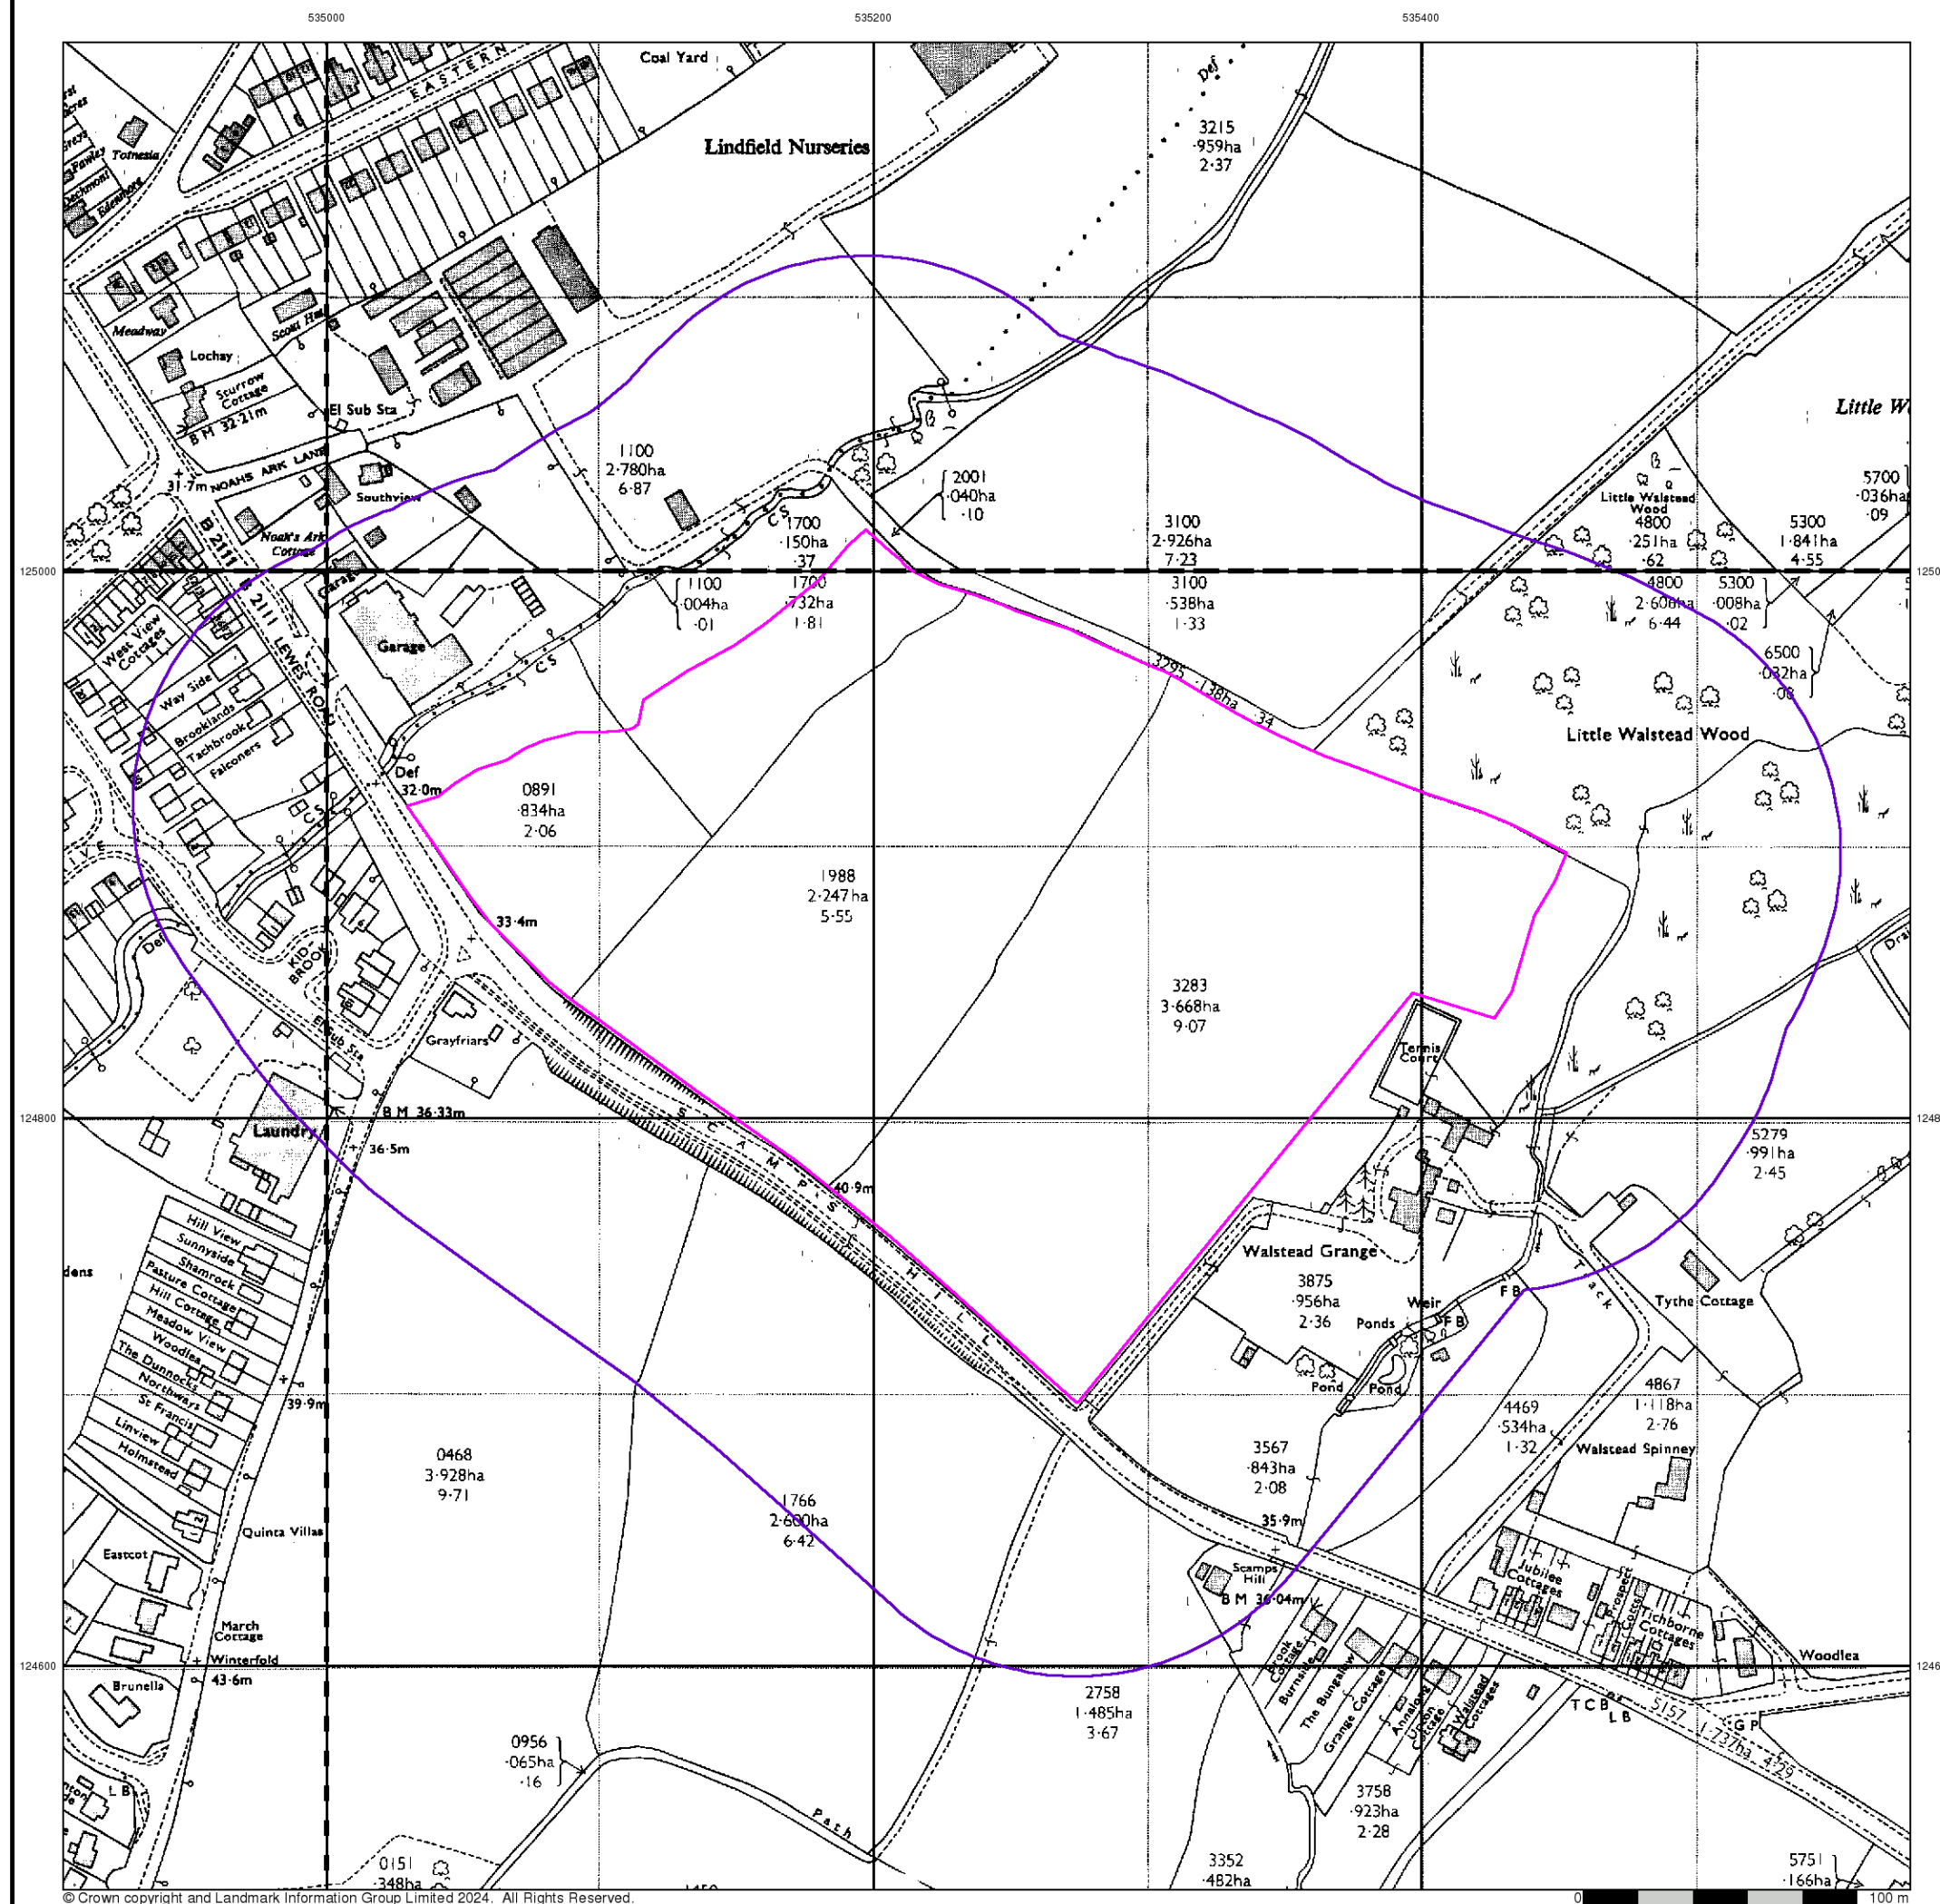

Source map scale - 1:2,500


Map Name(s) and Date(s)

Historical Map - Segment A13



Order Number:	334357177_1_1
Customer Ref:	6534
National Grid Reference:	535240, 124870
Slice:	A
Site Area (Ha):	6.63
Search Buffer (m):	100

Scamps Hill, Lindfield, Haywards Heath, RH16 2GL

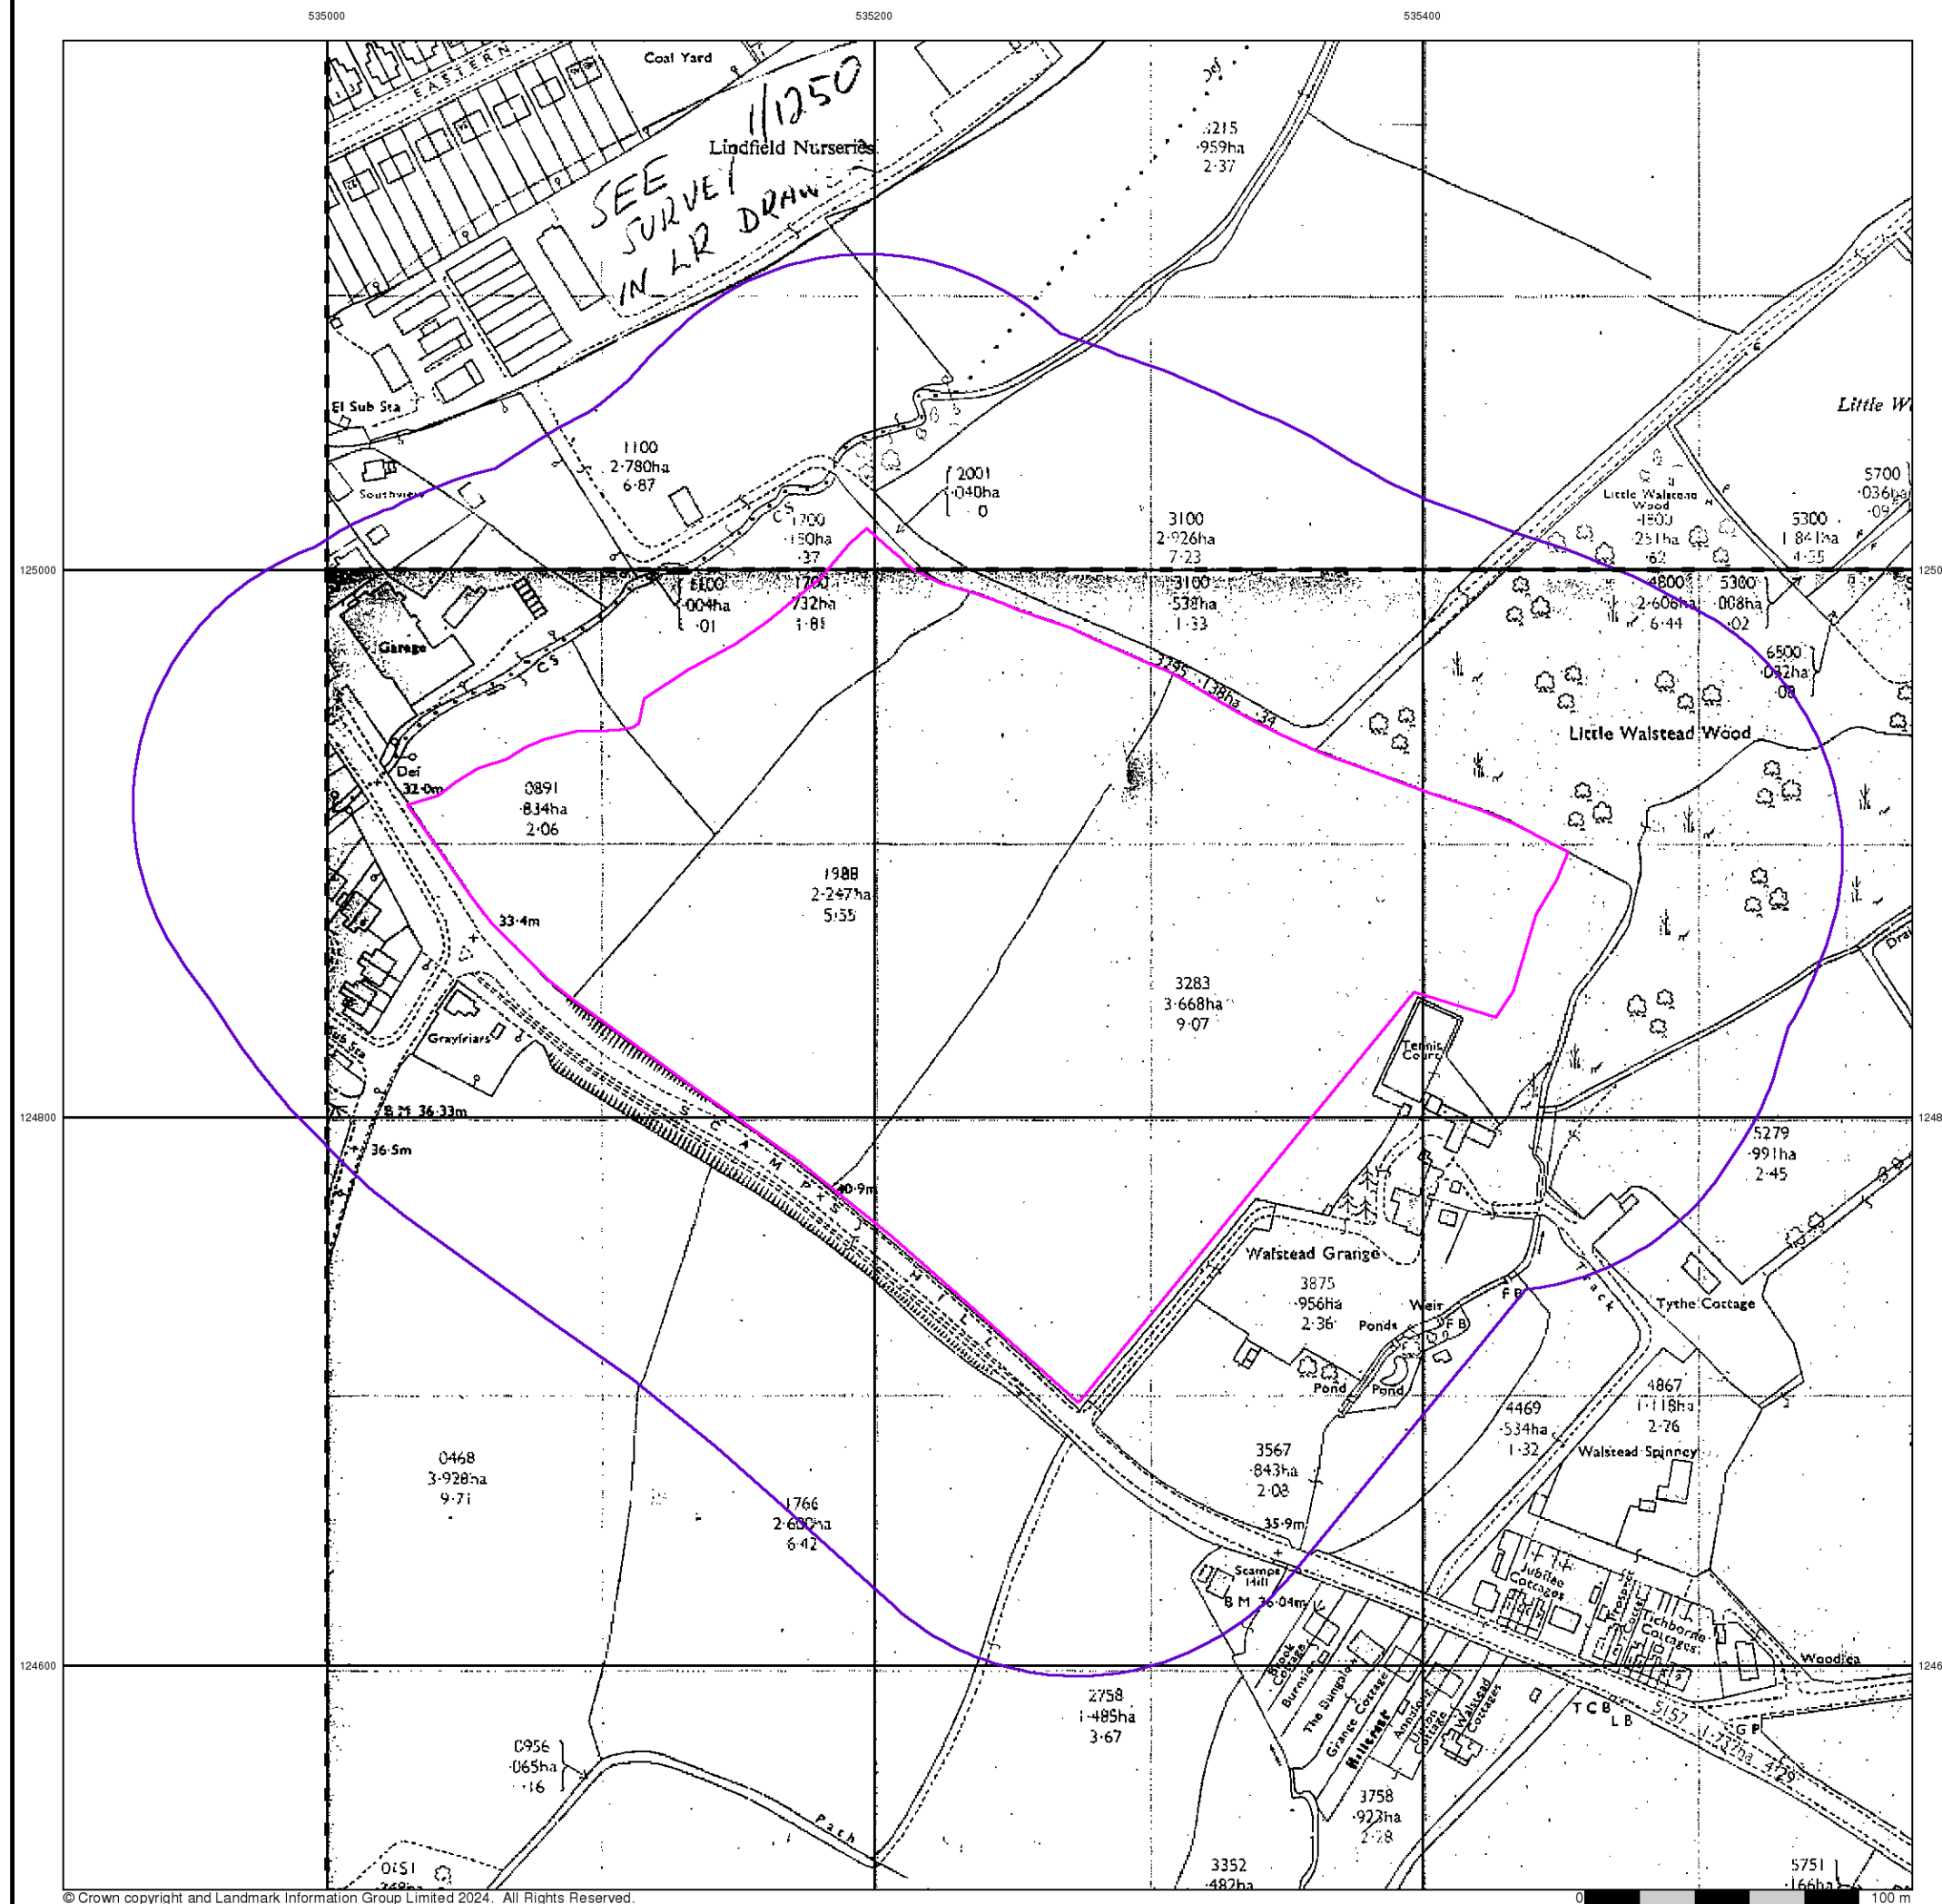

Ordnance Survey Plan

Published 1975 - 1976


Source map scale - 1:1,250

The historical maps shown were reproduced from maps predominantly held at the scale adopted for England, Wales and Scotland in the 1840's. In 1854 the 1:2,500 scale was adopted for mapping urban areas and by 1896 it covered the whole of what were considered to be the cultivated parts of Great Britain. The published date given below is often some years later than the surveyed date. Before 1938, all OS maps were based on the Cassini Projection, with independent surveys of a single county or group of counties, giving rise to significant inaccuracies in outlying areas.

Map Name(s) and Date(s)

TQ3425SE 1975 1:1,250	TQ3525SW 1975 1:1,250
TQ3424NE 1976 1:1,250	

Historical Map - Segment A13

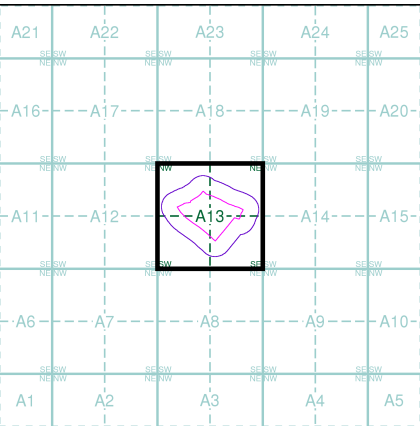

Order Details

Order Number: 334357177_1_1
Customer Ref: 6534
National Grid Reference: 535240, 124870
Slice: A
Site Area (Ha): 6.63
Search Buffer (m): 100

Site Details

Scamps Hill, Lindfield, Haywards Heath, RH16 2GL

Large-Scale National Grid Data

Published 1993 - 1994


Source map scale - 1:1,250

'Large Scale National Grid Data' superseded SIM cards (Ordnance Survey's 'Survey of Information on Microfilm') in 1992, and continued to be produced until 1999. These maps were the fore-runners of digital mapping and so provide detailed information on houses and roads, but tend to show less topographic features such as vegetation. These maps were produced at both 1:2,500 and 1:1,250 scales.

Map Name(s) and Date(s)

TQ3425SE	TQ3525SW	TQ3525SE
1993	1993	1993
1:1,250	1:1,250	1:1,250
TQ3424NE		
1994		
1:1,250		

Historical Map - Segment A13

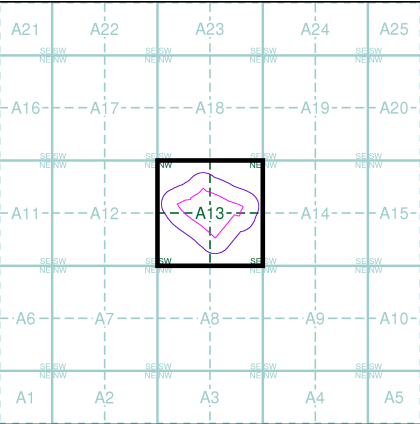

Order Details

Order Number: 334357177_1_1
Customer Ref: 6534
National Grid Reference: 535240, 124870
Slice: A
Site Area (Ha): 6.63
Search Buffer (m): 100

Site Details

Scamps Hill, Lindfield, Haywards Heath, RH16 2GL


Large-Scale National Grid Data

Published 1994


Source map scale - 1:2,500

'Large Scale National Grid Data' superseded SIM cards (Ordnance Survey's 'Survey of Information on Microfilm') in 1992, and continued to be produced until 1999. These maps were the fore-runners of digital mapping and so provide detailed information on houses and roads, but tend to show less topographic features such as vegetation. These maps were produced at both 1:2,500 and 1:1,250 scales.

Map Name(s) and Date(s)

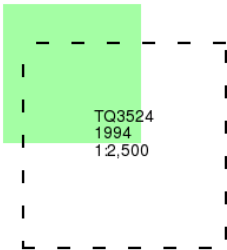

Historical Map - Segment A13

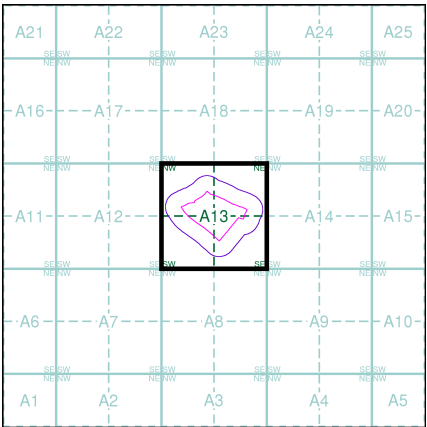

Order Details

Order Number: 334357177_1_1
Customer Ref: 6534
National Grid Reference: 535240, 124870
Slice: A
Site Area (Ha): 6.63
Search Buffer (m): 100

Site Details

Scamps Hill, Lindfield, Haywards Heath, RH16 2GL




Historical Aerial Photography

Published 1999

This aerial photography was produced by Getmapping, these vertical aerial photographs provide a seamless, full colour survey of the whole of Great Britain



Historical Aerial Photography - Segment A13

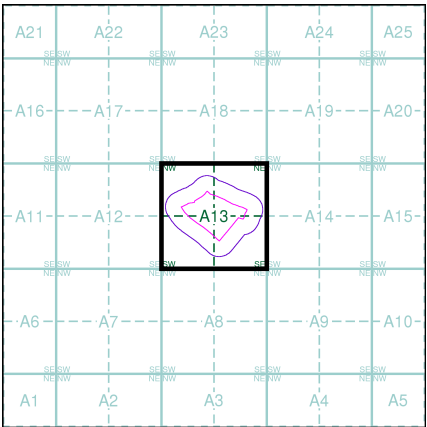

Order Details

Order Number: 334357177_1_1
Customer Ref: 6534
National Grid Reference: 535240, 124870
Slice: A
Site Area (Ha): 6.63
Search Buffer (m): 100


Site Details

Scamps Hill, Lindfield, Haywards Heath, RH16 2GL

General

- | | | |
|--|--|--|
| <p>Specified Site</p> <p>Several of Types at Location</p> <p>Contaminated Land Register Entry or Notice (Location)</p> <p>Discharge Consent</p> <p>Enforcement or Prohibition Notice</p> <p>Integrated Pollution Control</p> <p>Integrated Pollution Prevention Control</p> <p>Local Authority Integrated Pollution Prevention and Control</p> <p>Local Authority Pollution Prevention and Control Enforcement</p> <p>Pollution Incident to Controlled Waters</p> <p>Prosecution Relating to Authorised Processes</p> <p>Prosecution Relating to Controlled Waters</p> <p>Registered Radioactive Substance</p> <p>River Network or Water Feature</p> <p>River Quality Sampling Point</p> <p>Substantiated Pollution Incident Register</p> <p>Water Abstraction</p> <p>Water Industry Act Referral</p> <p>Hazardous Substances</p> <p>COMAH Site</p> <p>Explosive Site</p> <p>NIHHS Site</p> <p>Planning Hazardous Substance Consent</p> <p>Planning Hazardous Substance Enforcement</p> <p>Geological</p> <p>BGS Recorded Mineral Site</p> | <p>Specified Buffer(s)</p> <p>BGS Recorded Landfill Site (Location)</p> <p>BGS Recorded Landfill Site</p> <p>EA Historic Landfill (Buffered Point)</p> <p>EA Historic Landfill (Polygon)</p> <p>Integrated Pollution Control Registered Waste Site</p> <p>Licensed Waste Management Facility (Landfill Boundary)</p> <p>Licensed Waste Management Facility (Location)</p> <p>Local Authority Recorded Landfill Site (Location)</p> <p>Local Authority Recorded Landfill Site</p> <p>Potentially Infilled Land (Non-water)</p> <p>Potentially Infilled Land (Non-water)</p> <p>Potentially Infilled Land (Water)</p> <p>Potentially Infilled Land (Water)</p> <p>Potentially Infilled Land (Water)</p> <p>Registered Landfill Site</p> <p>Registered Landfill Site (Location)</p> <p>Registered Landfill Site (Point Buffered to 100m)</p> <p>Registered Landfill Site (Point Buffered to 250m)</p> <p>Registered Waste Transfer Site (Location)</p> <p>Registered Waste Transfer Site</p> <p>Registered Waste Treatment or Disposal Site (Location)</p> <p>Registered Waste Treatment or Disposal Site</p> | <p>Bearing Reference Point</p> <p>Overhead Transmission Line</p> <p>Map ID</p> |
|--|--|--|

Site Sensitivity Map - Segment A13

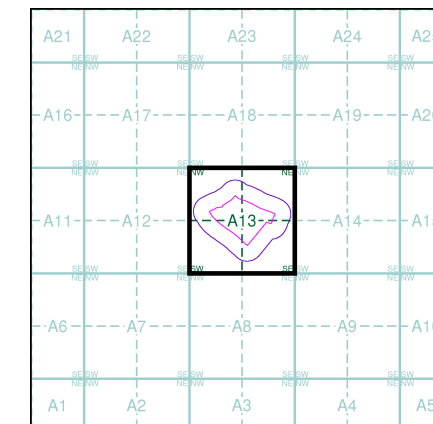


Order Details

Order Number: 334357177_1_1
 Customer Ref: 6534
 National Grid Reference: 535240, 124870
 Slice: A
 Site Area (Ha): 6.63
 Plot Buffer (m): 100

Site Details

Scamps Hill, Lindfield, Haywards Heath, RH16 2GL

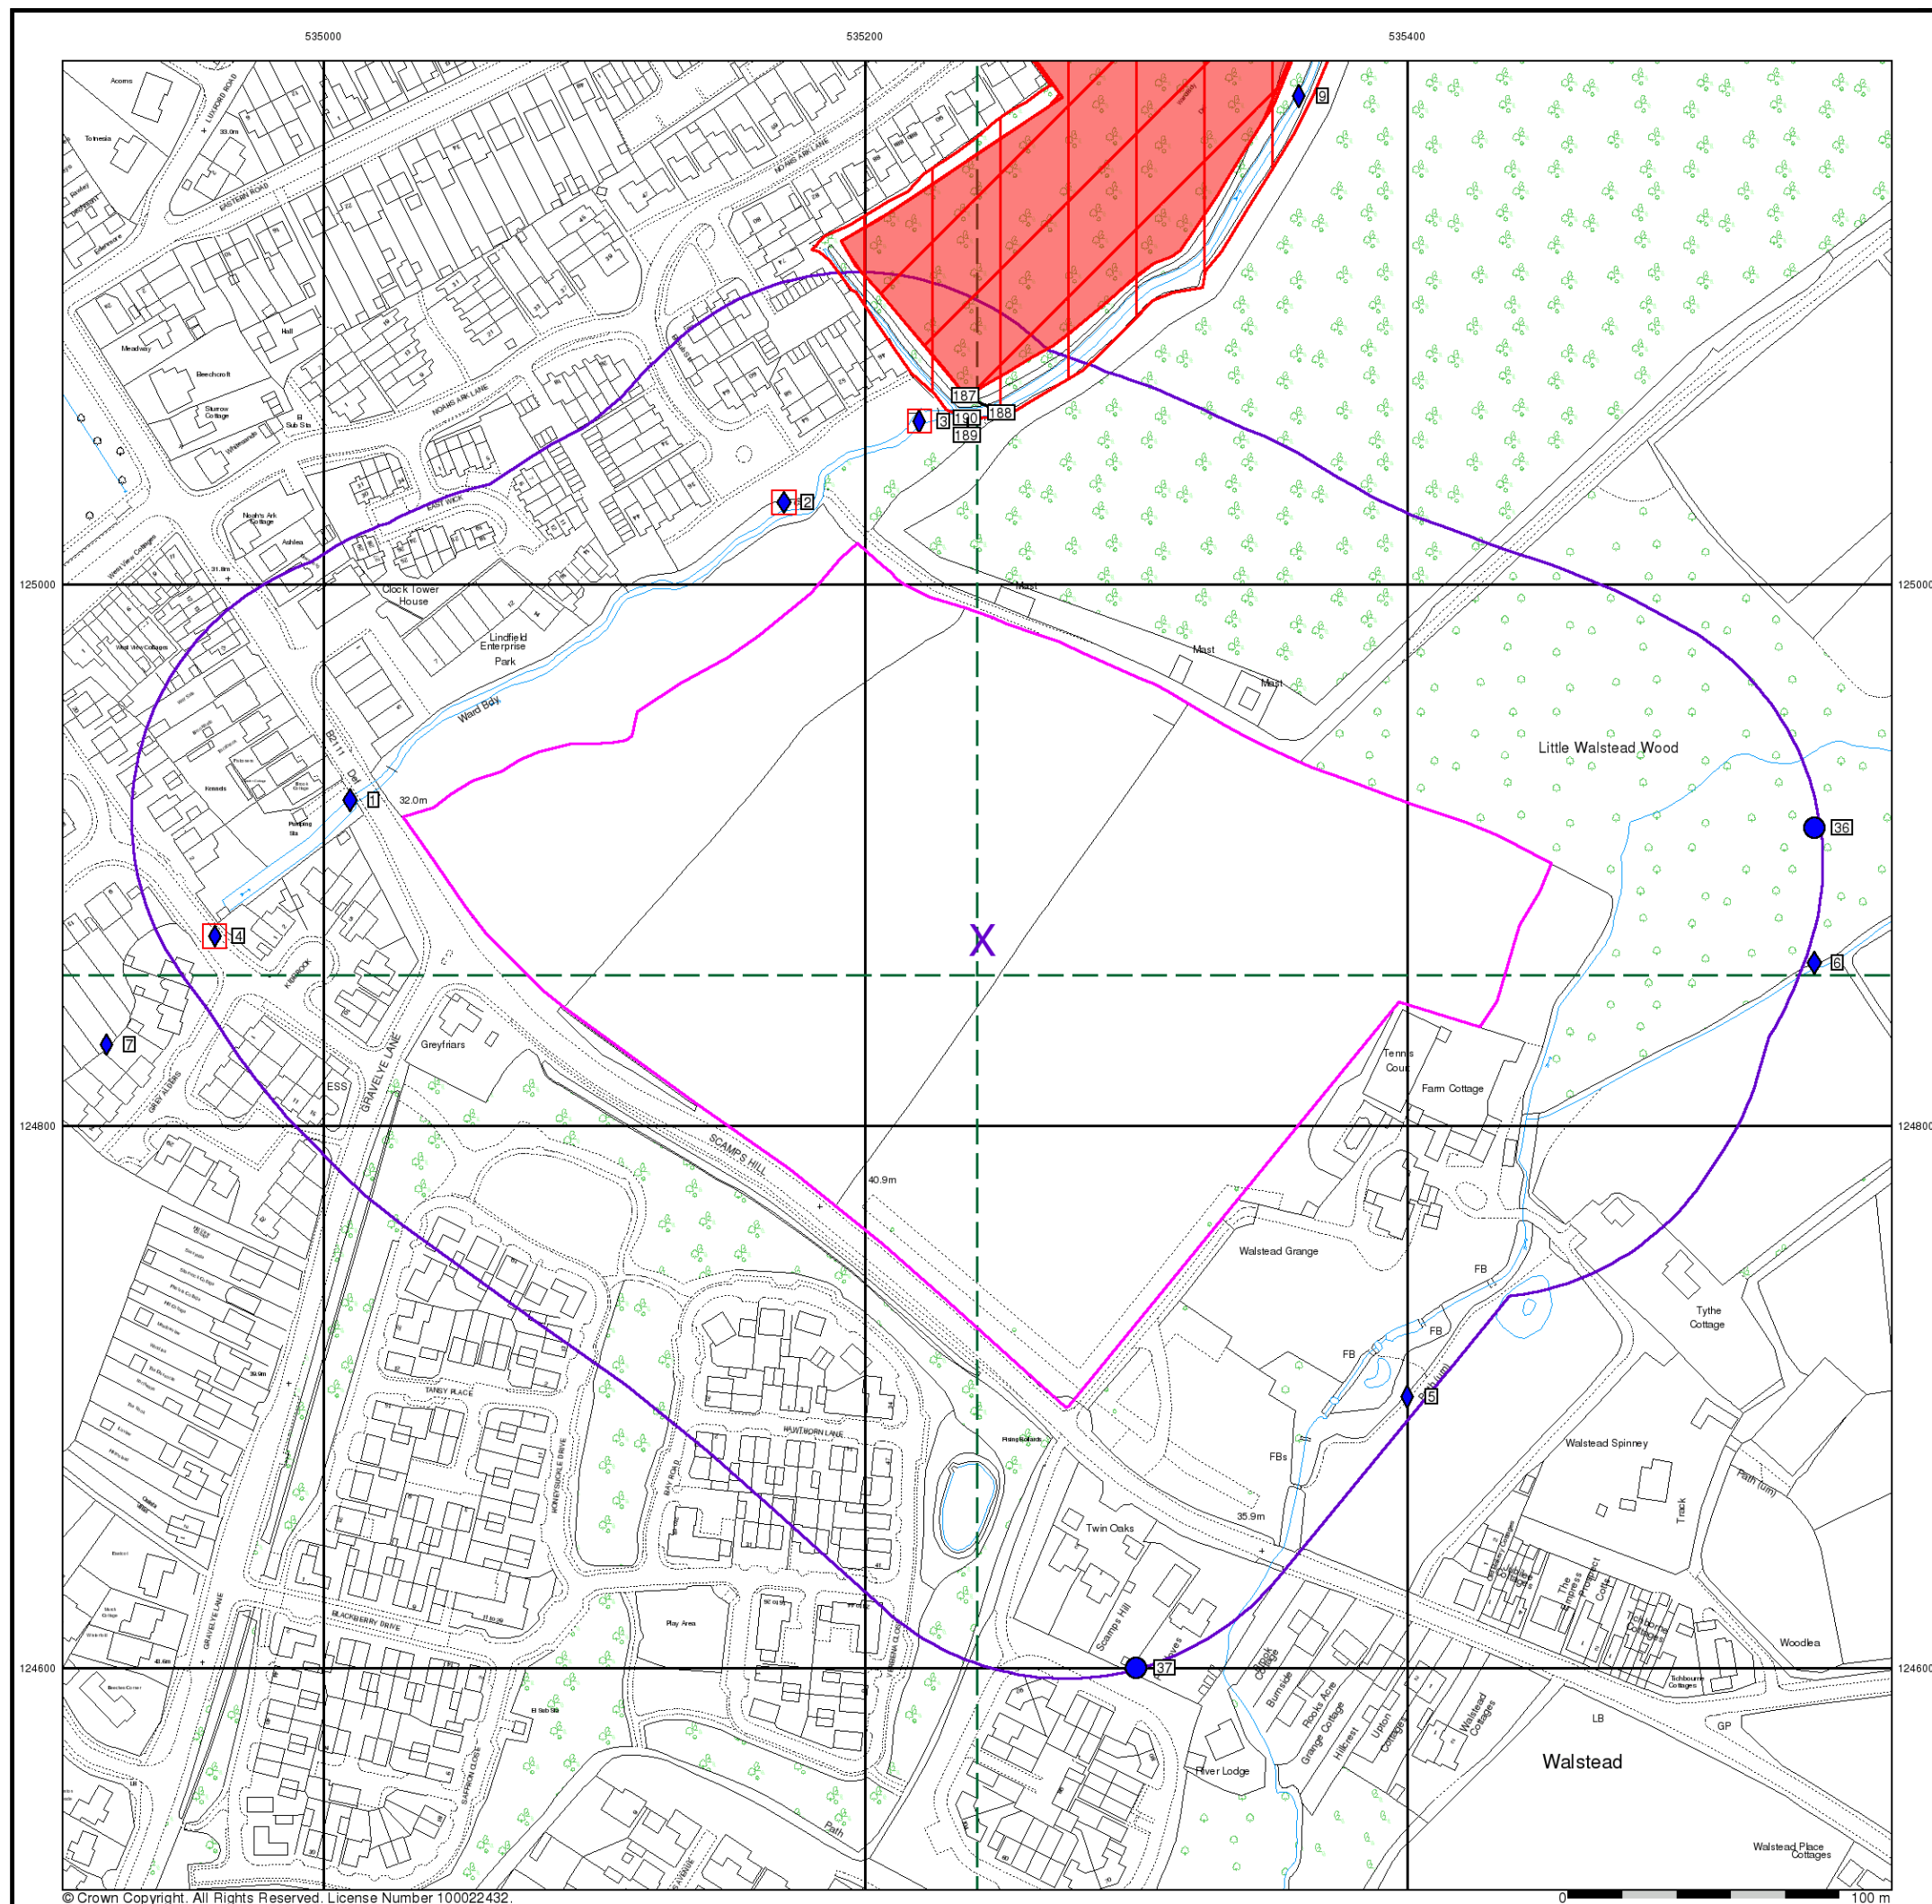

General

- Specified Site
- Specified Buffer(s)
- Bearing Reference Point
- Map ID

Several of Type at Location

Agency and Hydrological

- Contaminated Land Register Entry or Notice (Location)
- Contaminated Land Register Entry or Notice
- Discharge Consent
- Enforcement or Prohibition Notice
- Integrated Pollution Control
- Integrated Pollution Prevention Control
- Local Authority Integrated Pollution Prevention and Control
- Local Authority Pollution Prevention and Control
- Local Authority Pollution Prevention and Control Enforcement
- Pollution Incident to Controlled Waters
- Prosecution Relating to Authorised Processes
- Prosecution Relating to Controlled Waters
- Registered Radioactive Substance
- River Network or Water Feature
- River Quality Sampling Point
- Substantiated Pollution Incident Register
- Water Abstraction
- Water Industry Act Referral

Waste

- BGS Recorded Landfill Site (Location)
- BGS Recorded Landfill Site
- EA Historic Landfill (Buffered Point)
- EA Historic Landfill (Polygon)
- Integrated Pollution Control Registered Waste Site
- Licensed Waste Management Facility (Landfill Boundary)
- Licensed Waste Management Facility (Location)
- Local Authority Recorded Landfill Site (Location)
- Local Authority Recorded Landfill Site
- Potentially Infilled Land (Non-water)
- Potentially Infilled Land (Non-water)
- Potentially Infilled Land (Non-water)
- Potentially Infilled Land (Water)
- Potentially Infilled Land (Water)
- Potentially Infilled Land (Water)
- Potentially Infilled Land (Water)
- Registered Landfill Site (Location)
- Registered Landfill Site (Point Buffered to 100m)
- Registered Landfill Site (Point Buffered to 250m)
- Registered Waste Transfer Site (Location)
- Registered Waste Transfer Site
- Registered Waste Treatment or Disposal Site (Location)
- Registered Waste Treatment or Disposal Site


Hazardous Substances

- COMAH Site
- Explosive Site
- NIHHS Site
- Planning Hazardous Substance Consent
- Planning Hazardous Substance Enforcement

Geological

- BGS Recorded Mineral Site

Site Sensitivity Map - Slice A

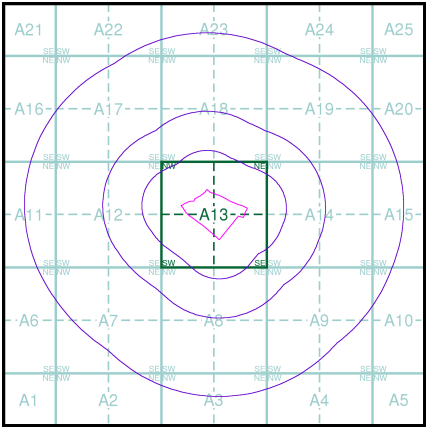

Order Details

Order Number: 334357177_1_1

Customer Ref: 6534

National Grid Reference: 535240, 124870

Slice: A

Site Area (Ha): 6.63

Search Buffer (m): 1000

Site Details


Scamps Hill, Lindfield, Haywards Heath, RH16 2GL

Landmark

Tel: 0844 844 9952

Fax: 0844 844 9951

Web: www.envirocheck.co.uk

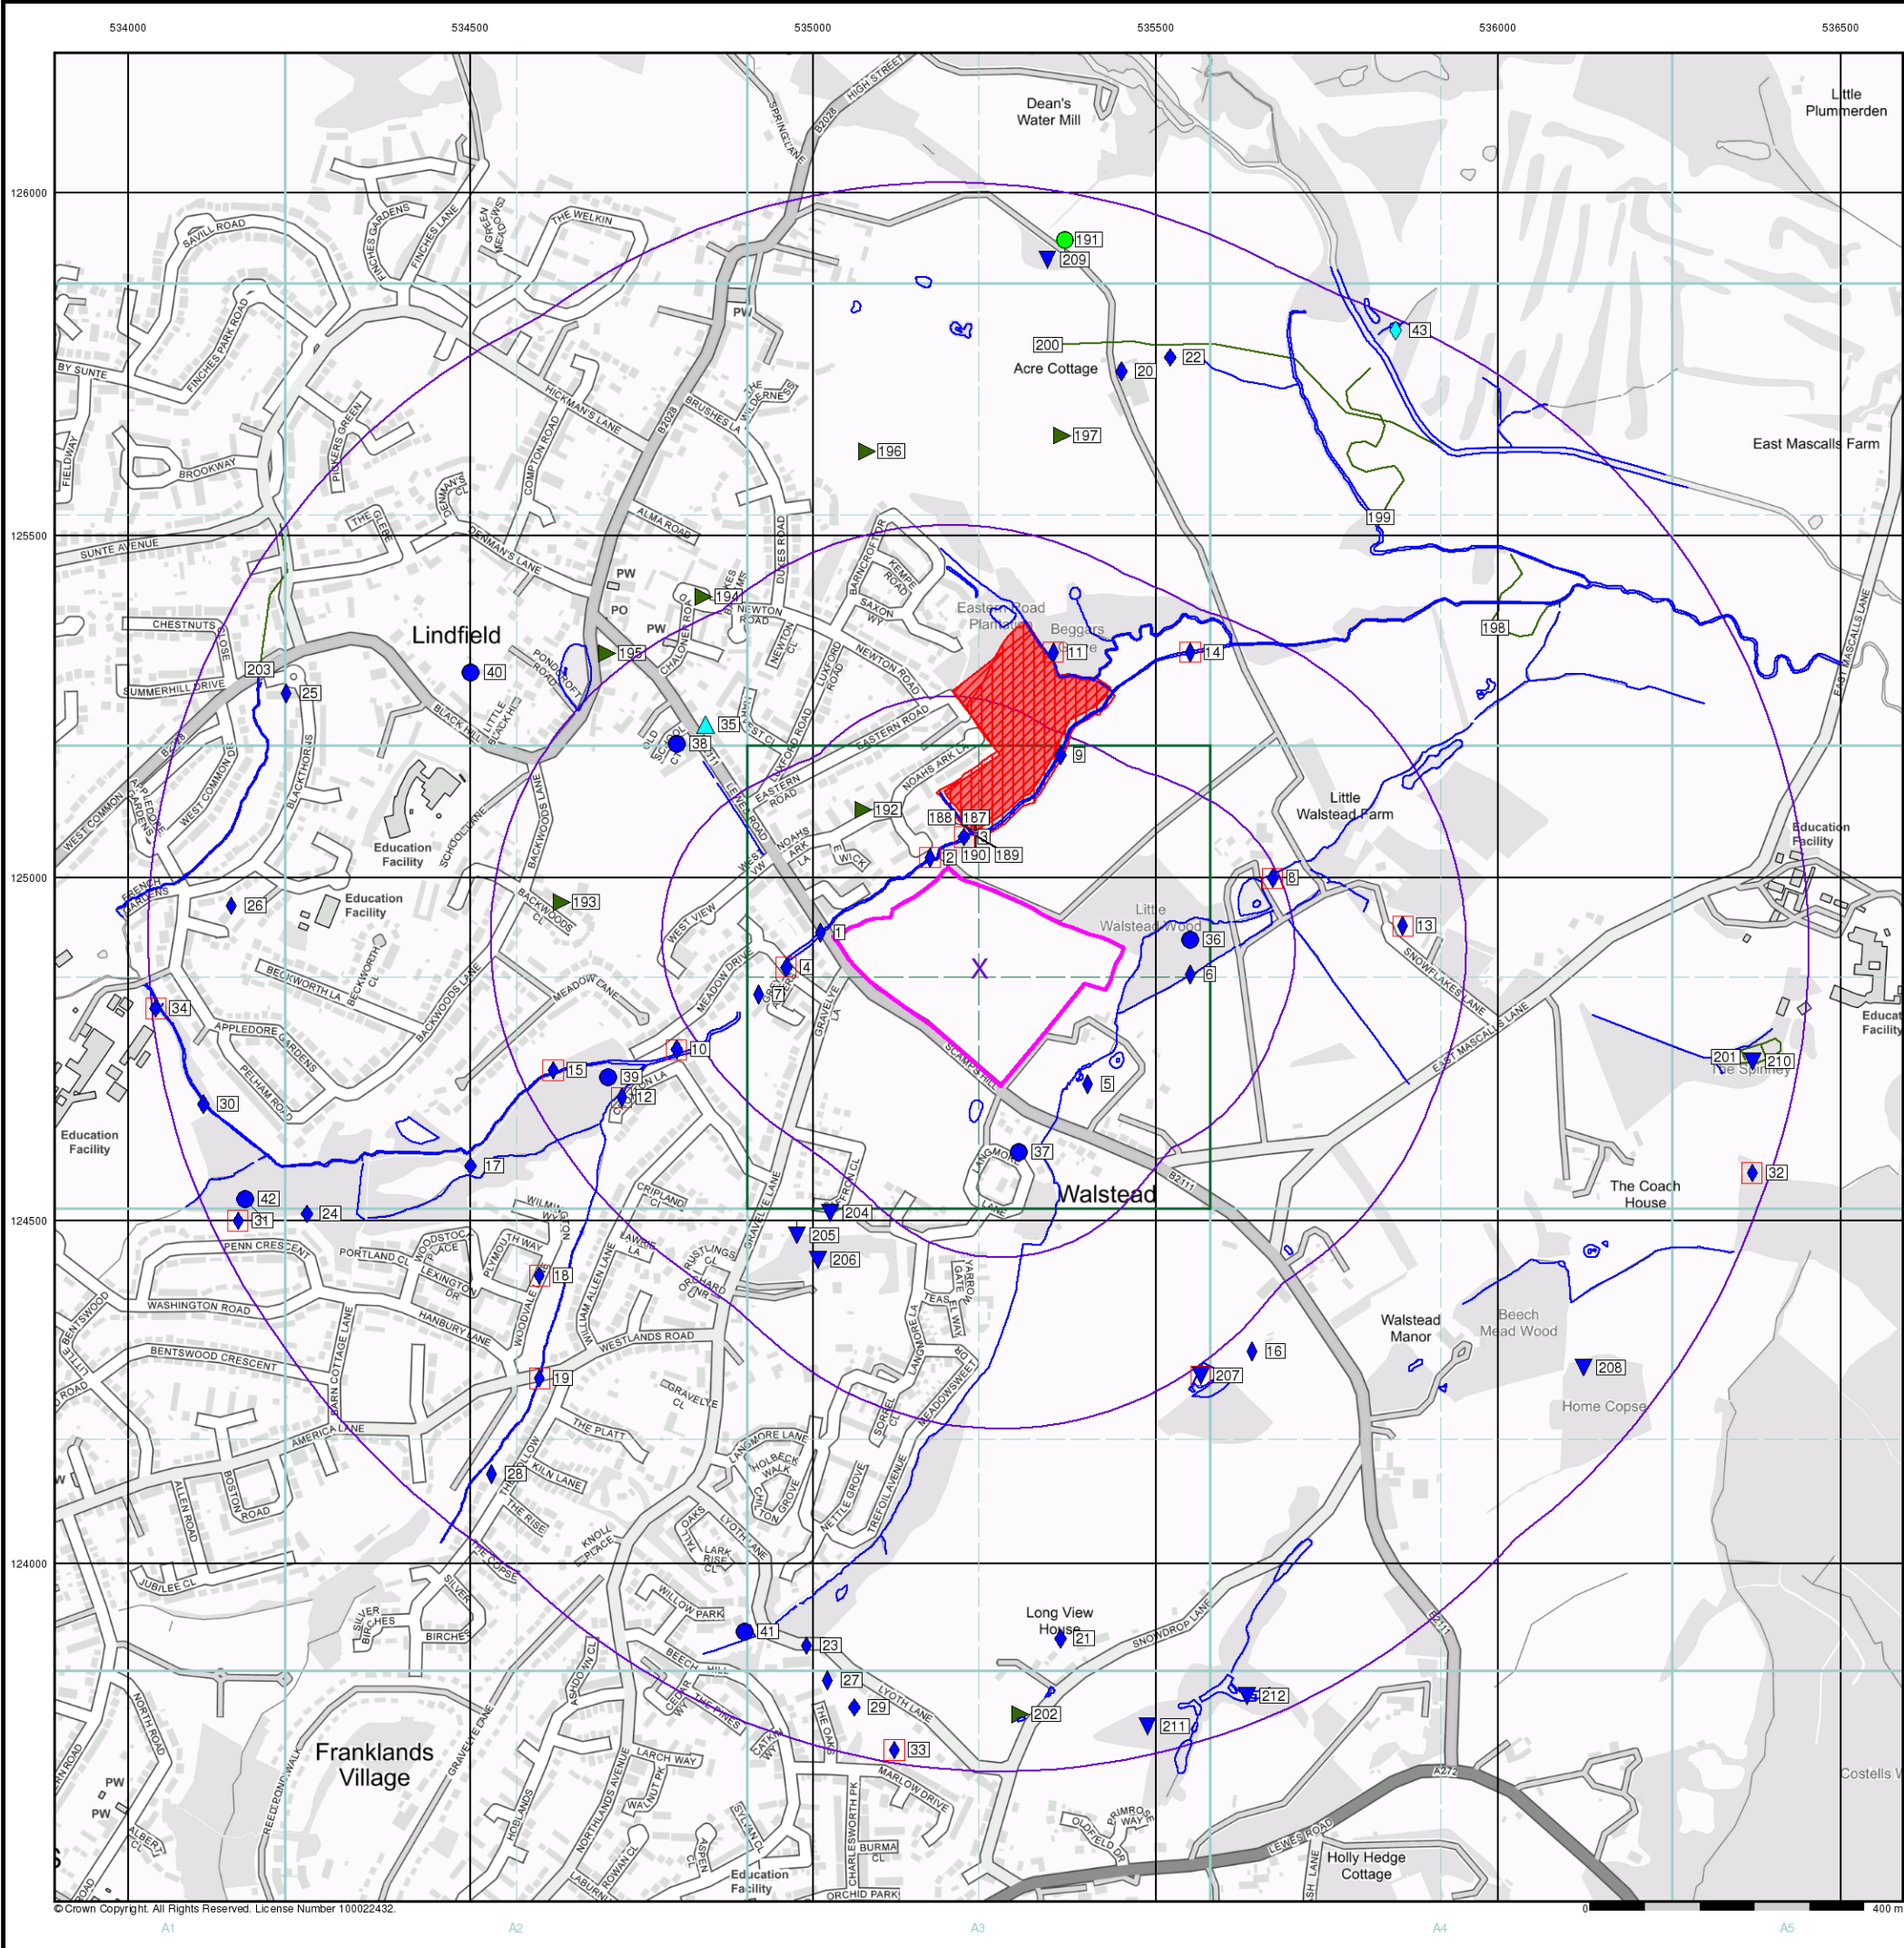

Industrial Land Use Map


General

- Specified Site
- Specified Buffer(s)
- Bearing Reference Point
- Slice
- Map ID

Industrial Land Use

- Contemporary Trade Directory Entry
- Fuel Station Entry
- Gas Pipeline
- Points of Interest - Commercial Services
- Points of Interest - Education and Health
- Points of Interest - Manufacturing and Production
- Points of Interest - Public Infrastructure
- Points of Interest - Recreational and Environmental
- Underground Electrical Cables

Industrial Land Use Map - Slice A

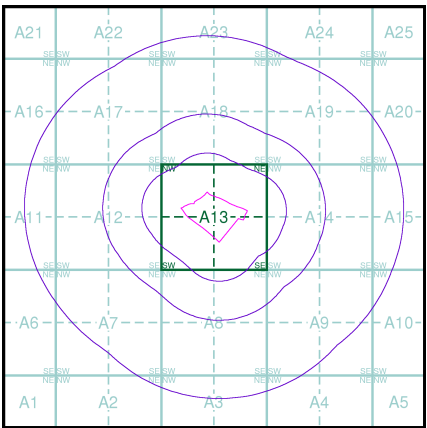


Order Details

Order Number: 334357177_1_1
Customer Ref: 6534
National Grid Reference: 535240, 124870
Slice: A
Site Area (Ha): 6.63
Search Buffer (m): 1000

Site Details

Scamps Hill, Lindfield, Haywards Heath, RH16 2GL

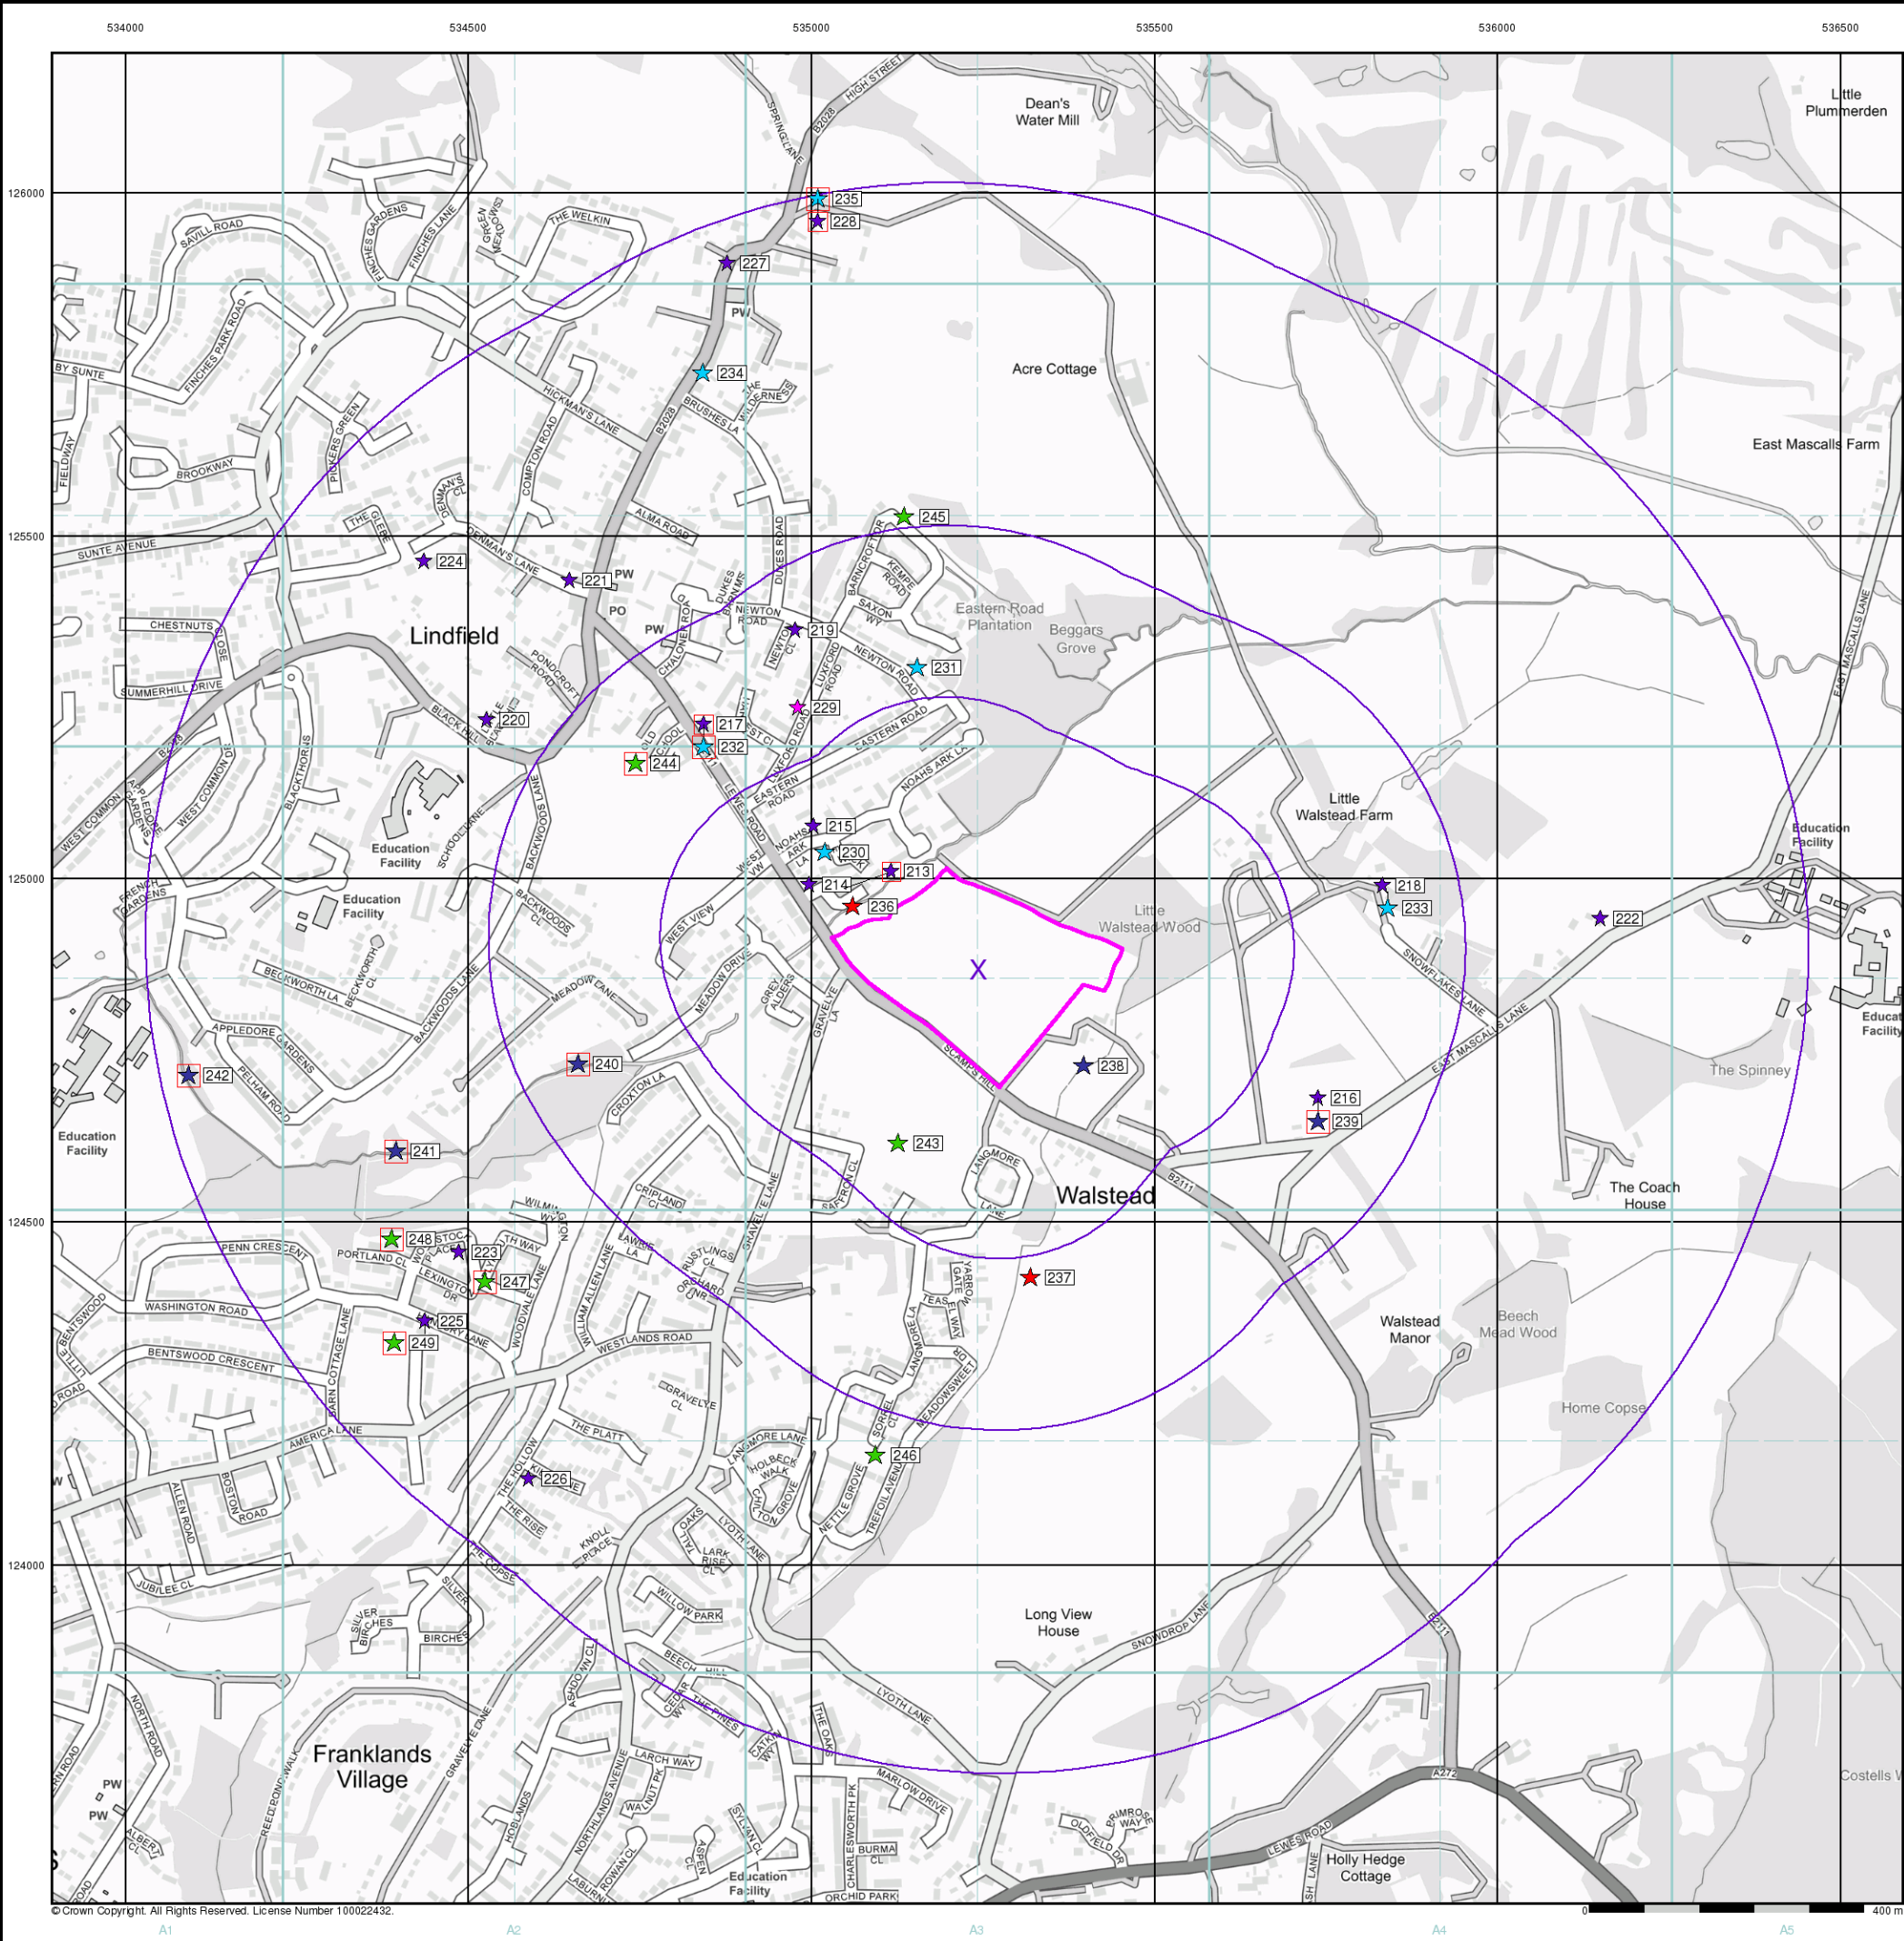


General

- Specified Site
- Specified Buffer(s)
- Bearing Reference Point

Agency and Hydrological (Flood)

- Extreme Flooding from Rivers or Sea without Defences (Zone 2)
- Flooding from Rivers or Sea without Defences (Zone 3)
- Area Benefiting from Flood Defence
- Flood Water Storage Areas
- Flood Defence

Flood Map - Slice A

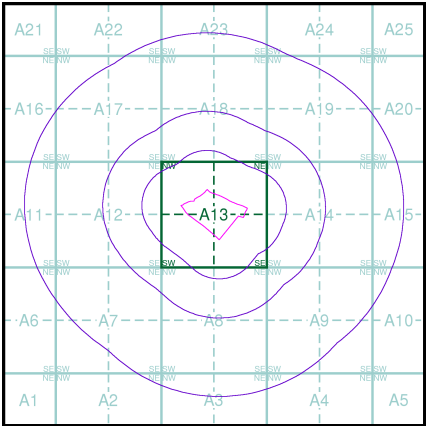

Order Details

Order Number: 334357177_1_1
Customer Ref: 6534
National Grid Reference: 535240, 124870
Slice: A
Site Area (Ha): 6.63
Search Buffer (m): 1000

Site Details

Scamps Hill, Lindfield, Haywards Heath, RH16 2GL

General

- Specified Site
- Specified Buffer(s)
- Bearing Reference Point
- Map ID
- Several of Type at Location


Agency and Hydrological (Boreholes)

- BGS Borehole Depth 0 - 10m
- BGS Borehole Depth 10 - 30m
- BGS Borehole Depth 30m +
- Confidential
- Other

For Borehole information please refer to the Borehole .csv file which accompanied this slice.

A copy of the BGS Borehole Ordering Form is available to download from the Support section of www.envirocheck.co.uk.

Borehole Map - Slice A

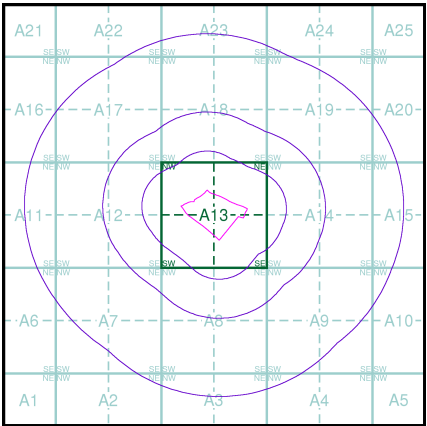

Order Details

Order Number: 334357177_1_1
Customer Ref: 6534
National Grid Reference: 535240, 124870
Slice: A
Site Area (Ha): 6.63
Search Buffer (m): 1000

Site Details

Scamps Hill, Lindfield, Haywards Heath, RH16 2GL

General

- Specified Site
- Specified Buffer(s)
- Bearing Reference Point


OS Water Network Data

- | | |
|--------------|-------------------------|
| Canal | Drain |
| Reservoir | Other |
| Foreshore | Lake |
| Marsh | Transfer |
| Tidal River | Lock Or Flight Of Locks |
| Inland River | Sea |

Contours (height in meters)

- Standard Contour 105 100 95
- Master Contour
- Spot Height 167.3
- MLW Mean Low Water
- MHW Mean High Water

OS Water Network Map - Slice A

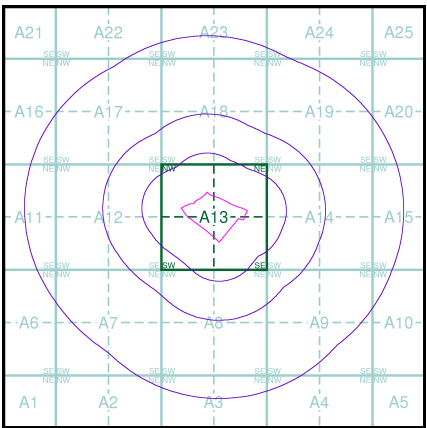

Order Details

Order Number: 334357177_1_1
Customer Ref: 6534
National Grid Reference: 535240, 124870
Slice: A
Site Area (Ha): 6.63
Search Buffer (m): 1000

Site Details

Scamps Hill, Lindfield, Haywards Heath, RH16 2GL

General

- Specified Site
- Specified Buffer(s)
- Bearing Reference Point

Risk of Flooding from Surface Water


- High - 30 Year Return
- Medium - 100 Year Return
- Low - 1000 Year Return

Suitability

See the suitability map below

- National to county
- County to town
- Town to street
- Street to parcels of land
- Property

E/NRW Suitability Map - Slice A

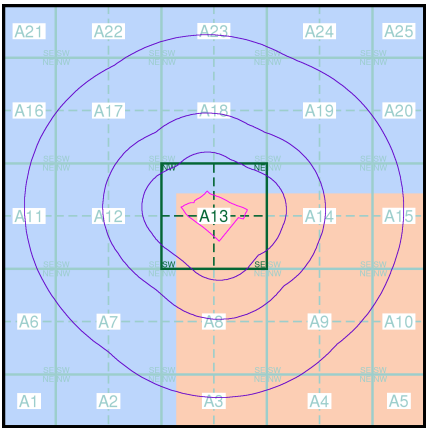

Order Details

Order Number: 334357177_1_1
Customer Ref: 6534
National Grid Reference: 535240, 124870
Slice: A
Site Area (Ha): 6.63
Search Buffer (m): 1000

Site Details


Scamps Hill, Lindfield, Haywards Heath, RH16 2GL

General


Specified Site Specified Buffer(s) Bearing Reference Point

Estimated Soil Chemistry Arsenic

Arsenic Concentrations mg/kg

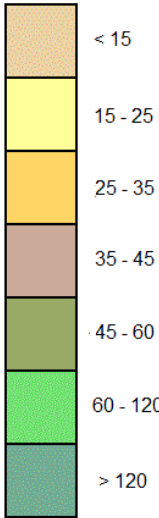

Estimated Soil Chemistry Arsenic - Slice A

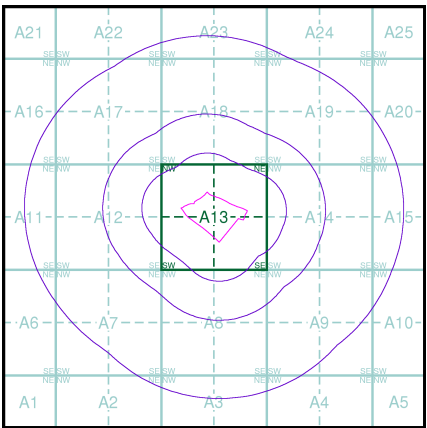


Order Details

Order Details: 334357177_1_1
Customer Ref: 6534
National Grid Reference: 535240, 124870
Slice: A
Site Area (Ha): 6.63
Search Buffer (m): 1000

Site Details

Scamps Hill, Lindfield, Haywards Heath, RH16 2GL

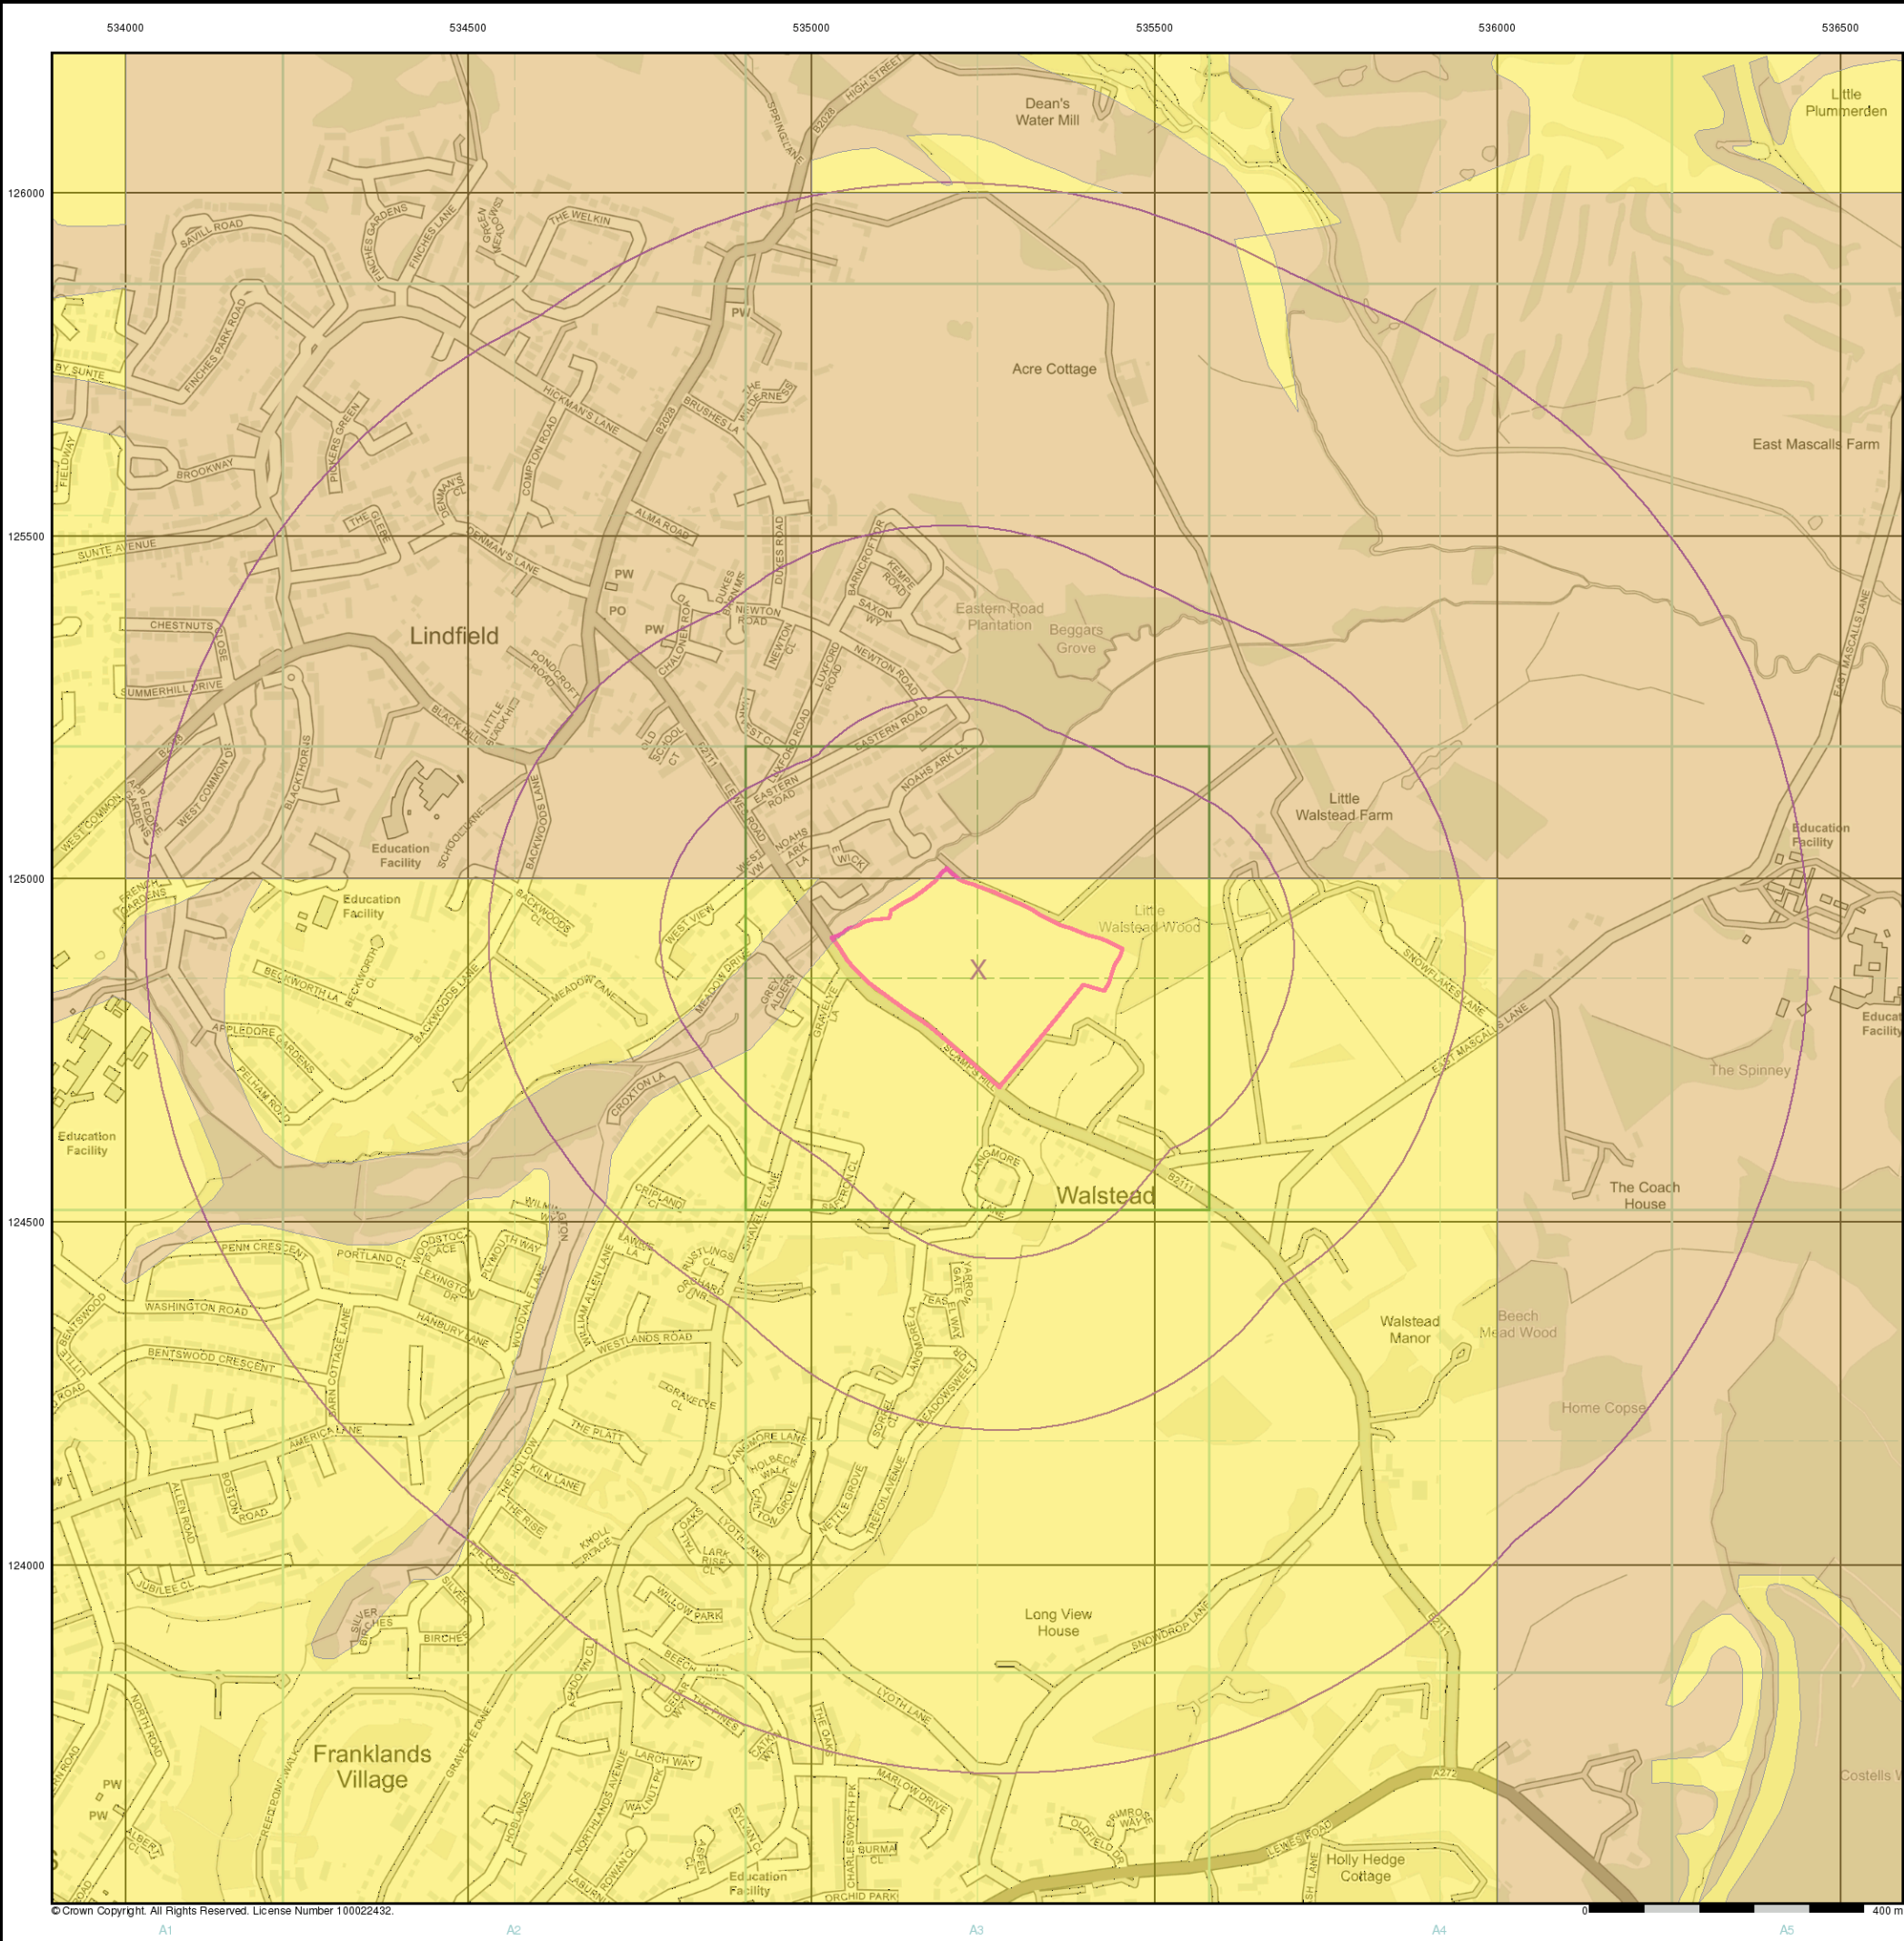


General


Specified Site Specified Buffer(s) Bearing Reference Point

Estimated Soil Chemistry Cadmium

Cadmium Concentrations mg/kg

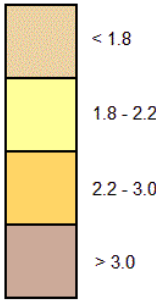

Estimated Soil Chemistry Cadmium - Slice A

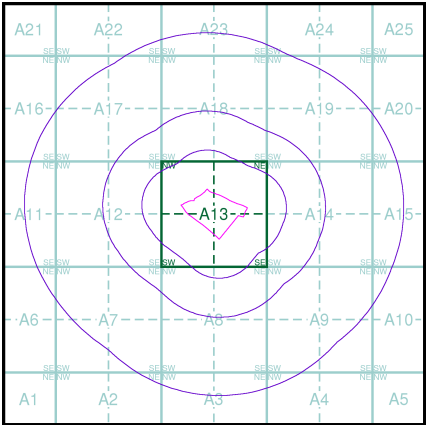


Order Details

Order Details: 334357177_1_1
Customer Ref: 6534
National Grid Reference: 535240, 124870
Slice: A
Site Area (Ha): 6.63
Search Buffer (m): 1000

Site Details

Scamps Hill, Lindfield, Haywards Heath, RH16 2GL

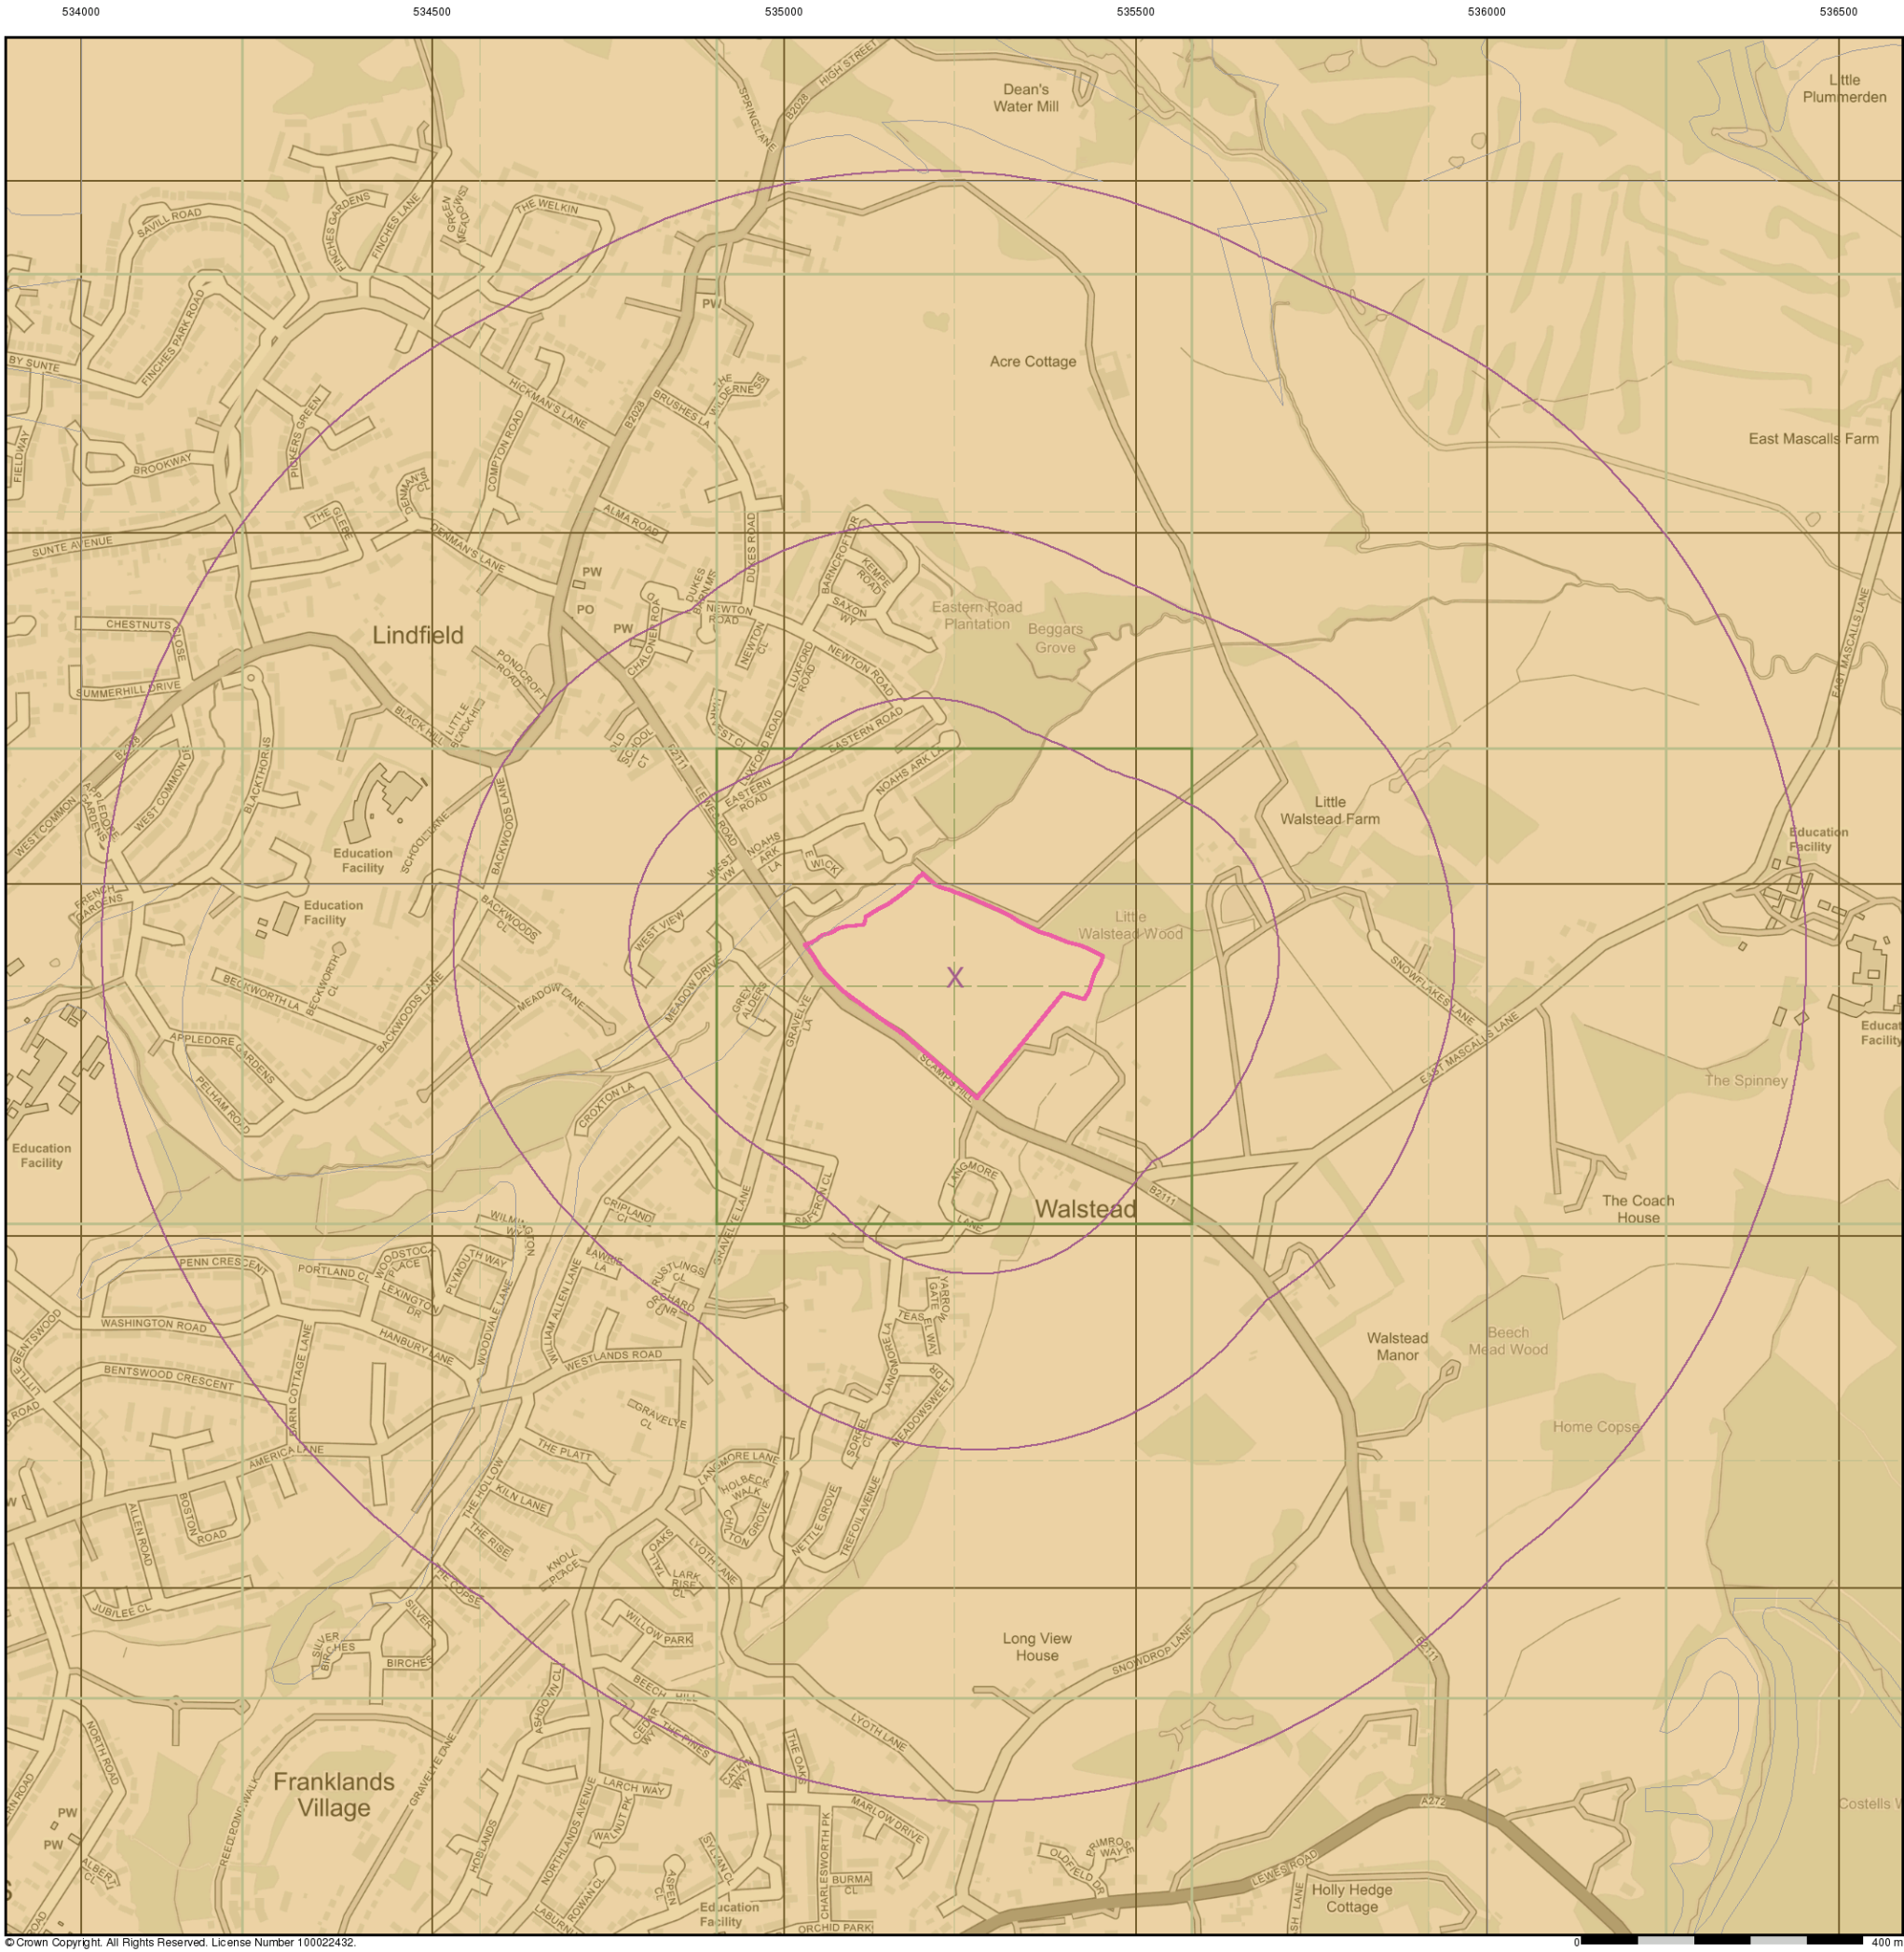


General


Specified Site Specified Buffer(s) Bearing Reference Point

Estimated Soil Chemistry Chromium

Chromium Concentrations mg/kg

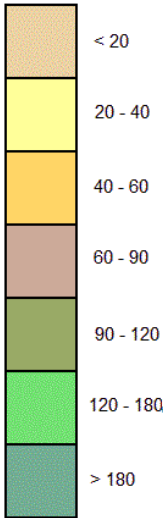

Estimated Soil Chemistry Chromium - Slice A

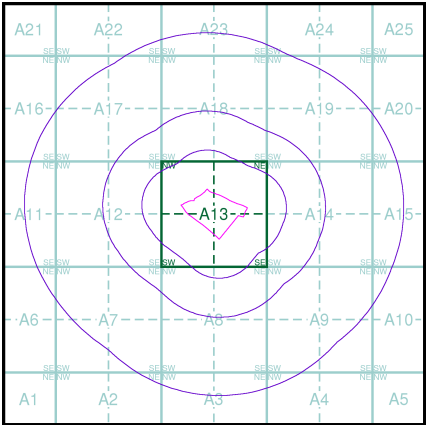

Order Details

Order Details: 334357177_1_1
Customer Ref: 6534
National Grid Reference: 535240, 124870
Slice: A
Site Area (Ha): 6.63
Search Buffer (m): 1000

Site Details


Scamps Hill, Lindfield, Haywards Heath, RH16 2GL

General


Specified Site Specified Buffer(s) Bearing Reference Point

Estimated Soil Chemistry Lead

Lead Concentrations mg/kg

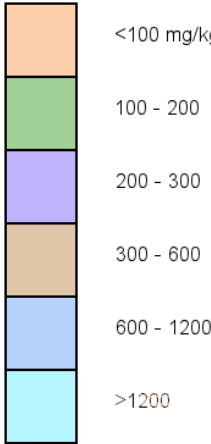

Estimated Soil Chemistry Lead - Slice A

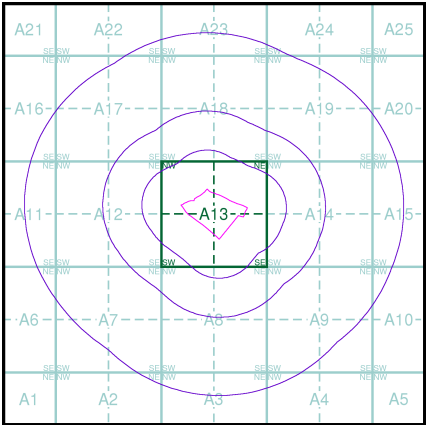


Order Details

Order Details: 334357177_1_1
Customer Ref: 6534
National Grid Reference: 535240, 124870
Slice: A
Site Area (Ha): 6.63
Search Buffer (m): 1000

Site Details

Scamps Hill, Lindfield, Haywards Heath, RH16 2GL

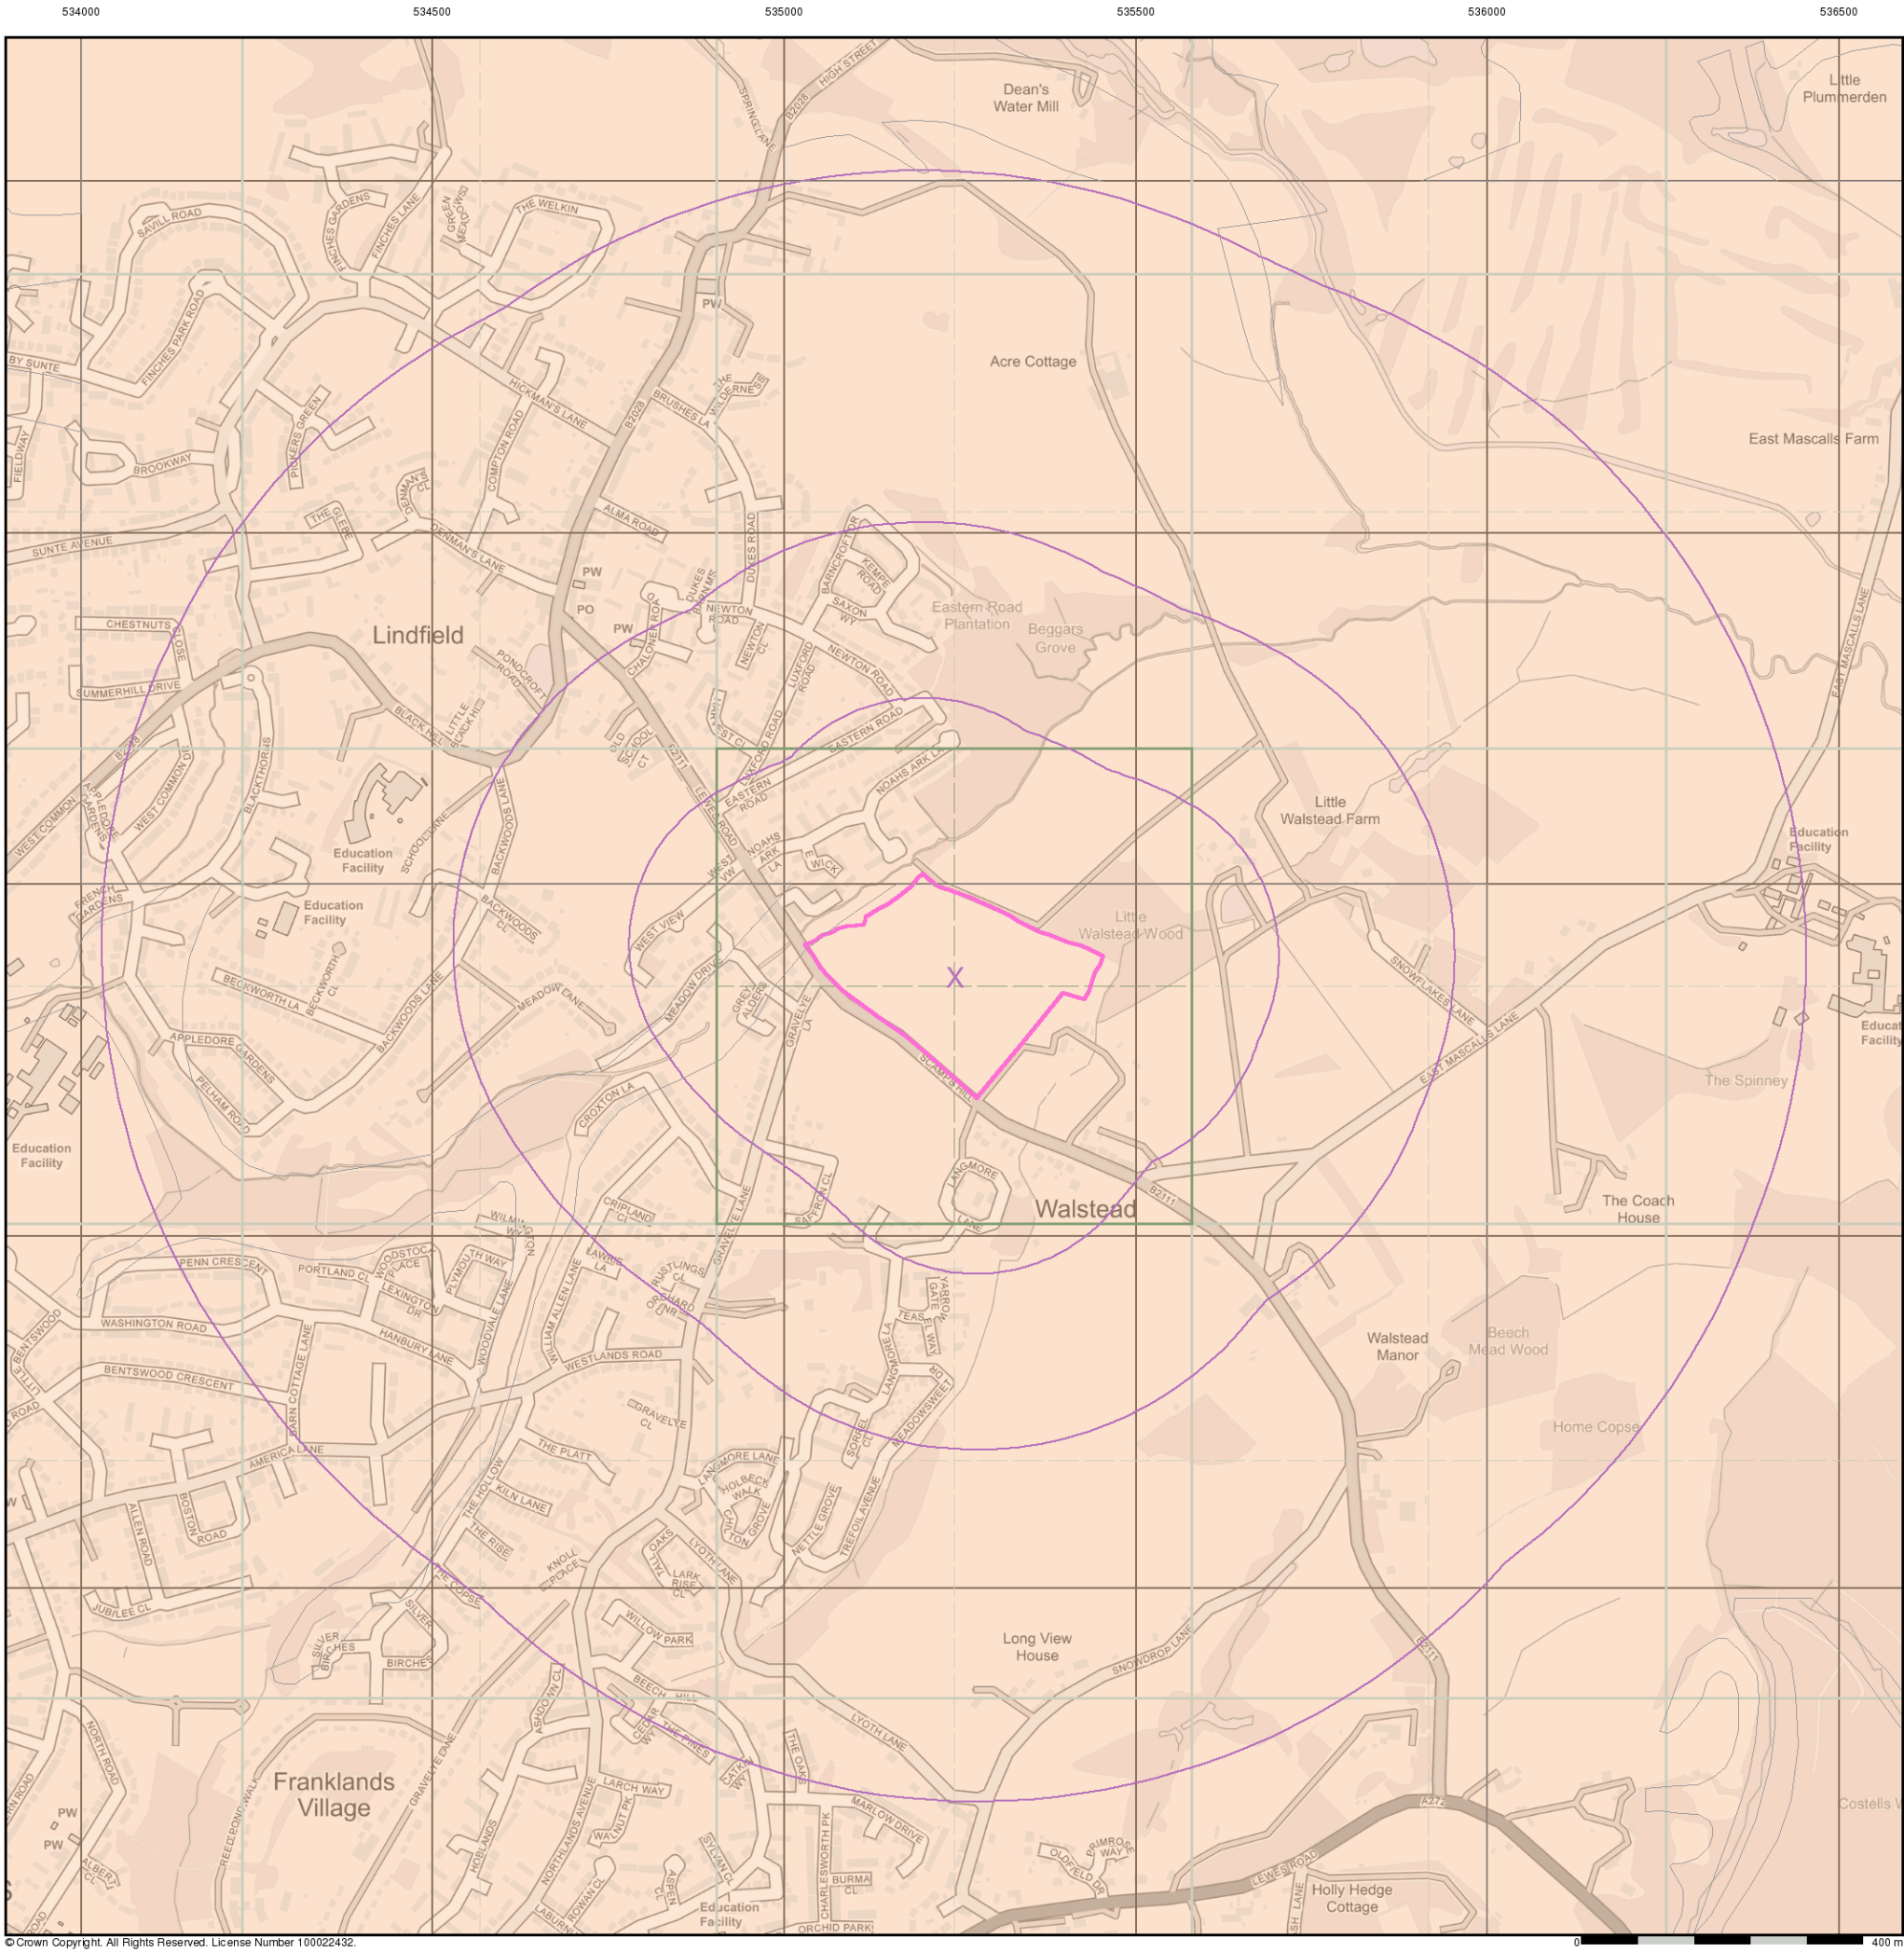


General


Specified Site Specified Buffer(s) Bearing Reference Point

Estimated Soil Chemistry Nickel

Nickel Concentrations mg/kg

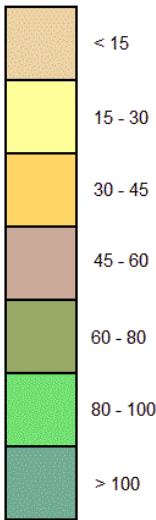

Estimated Soil Chemistry Nickel - Slice A

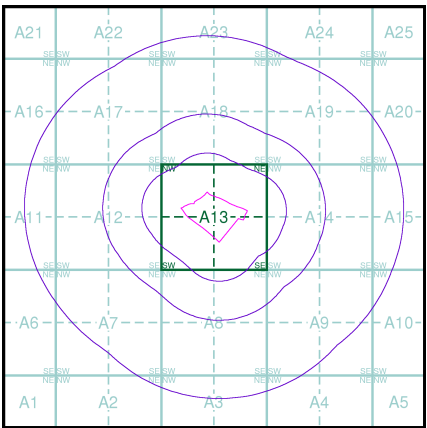


Order Details

Order Details: 334357177_1_1
Customer Ref: 6534
National Grid Reference: 535240, 124870
Slice: A
Site Area (Ha): 6.63
Search Buffer (m): 1000

Site Details

Scamps Hill, Lindfield, Haywards Heath, RH16 2GL

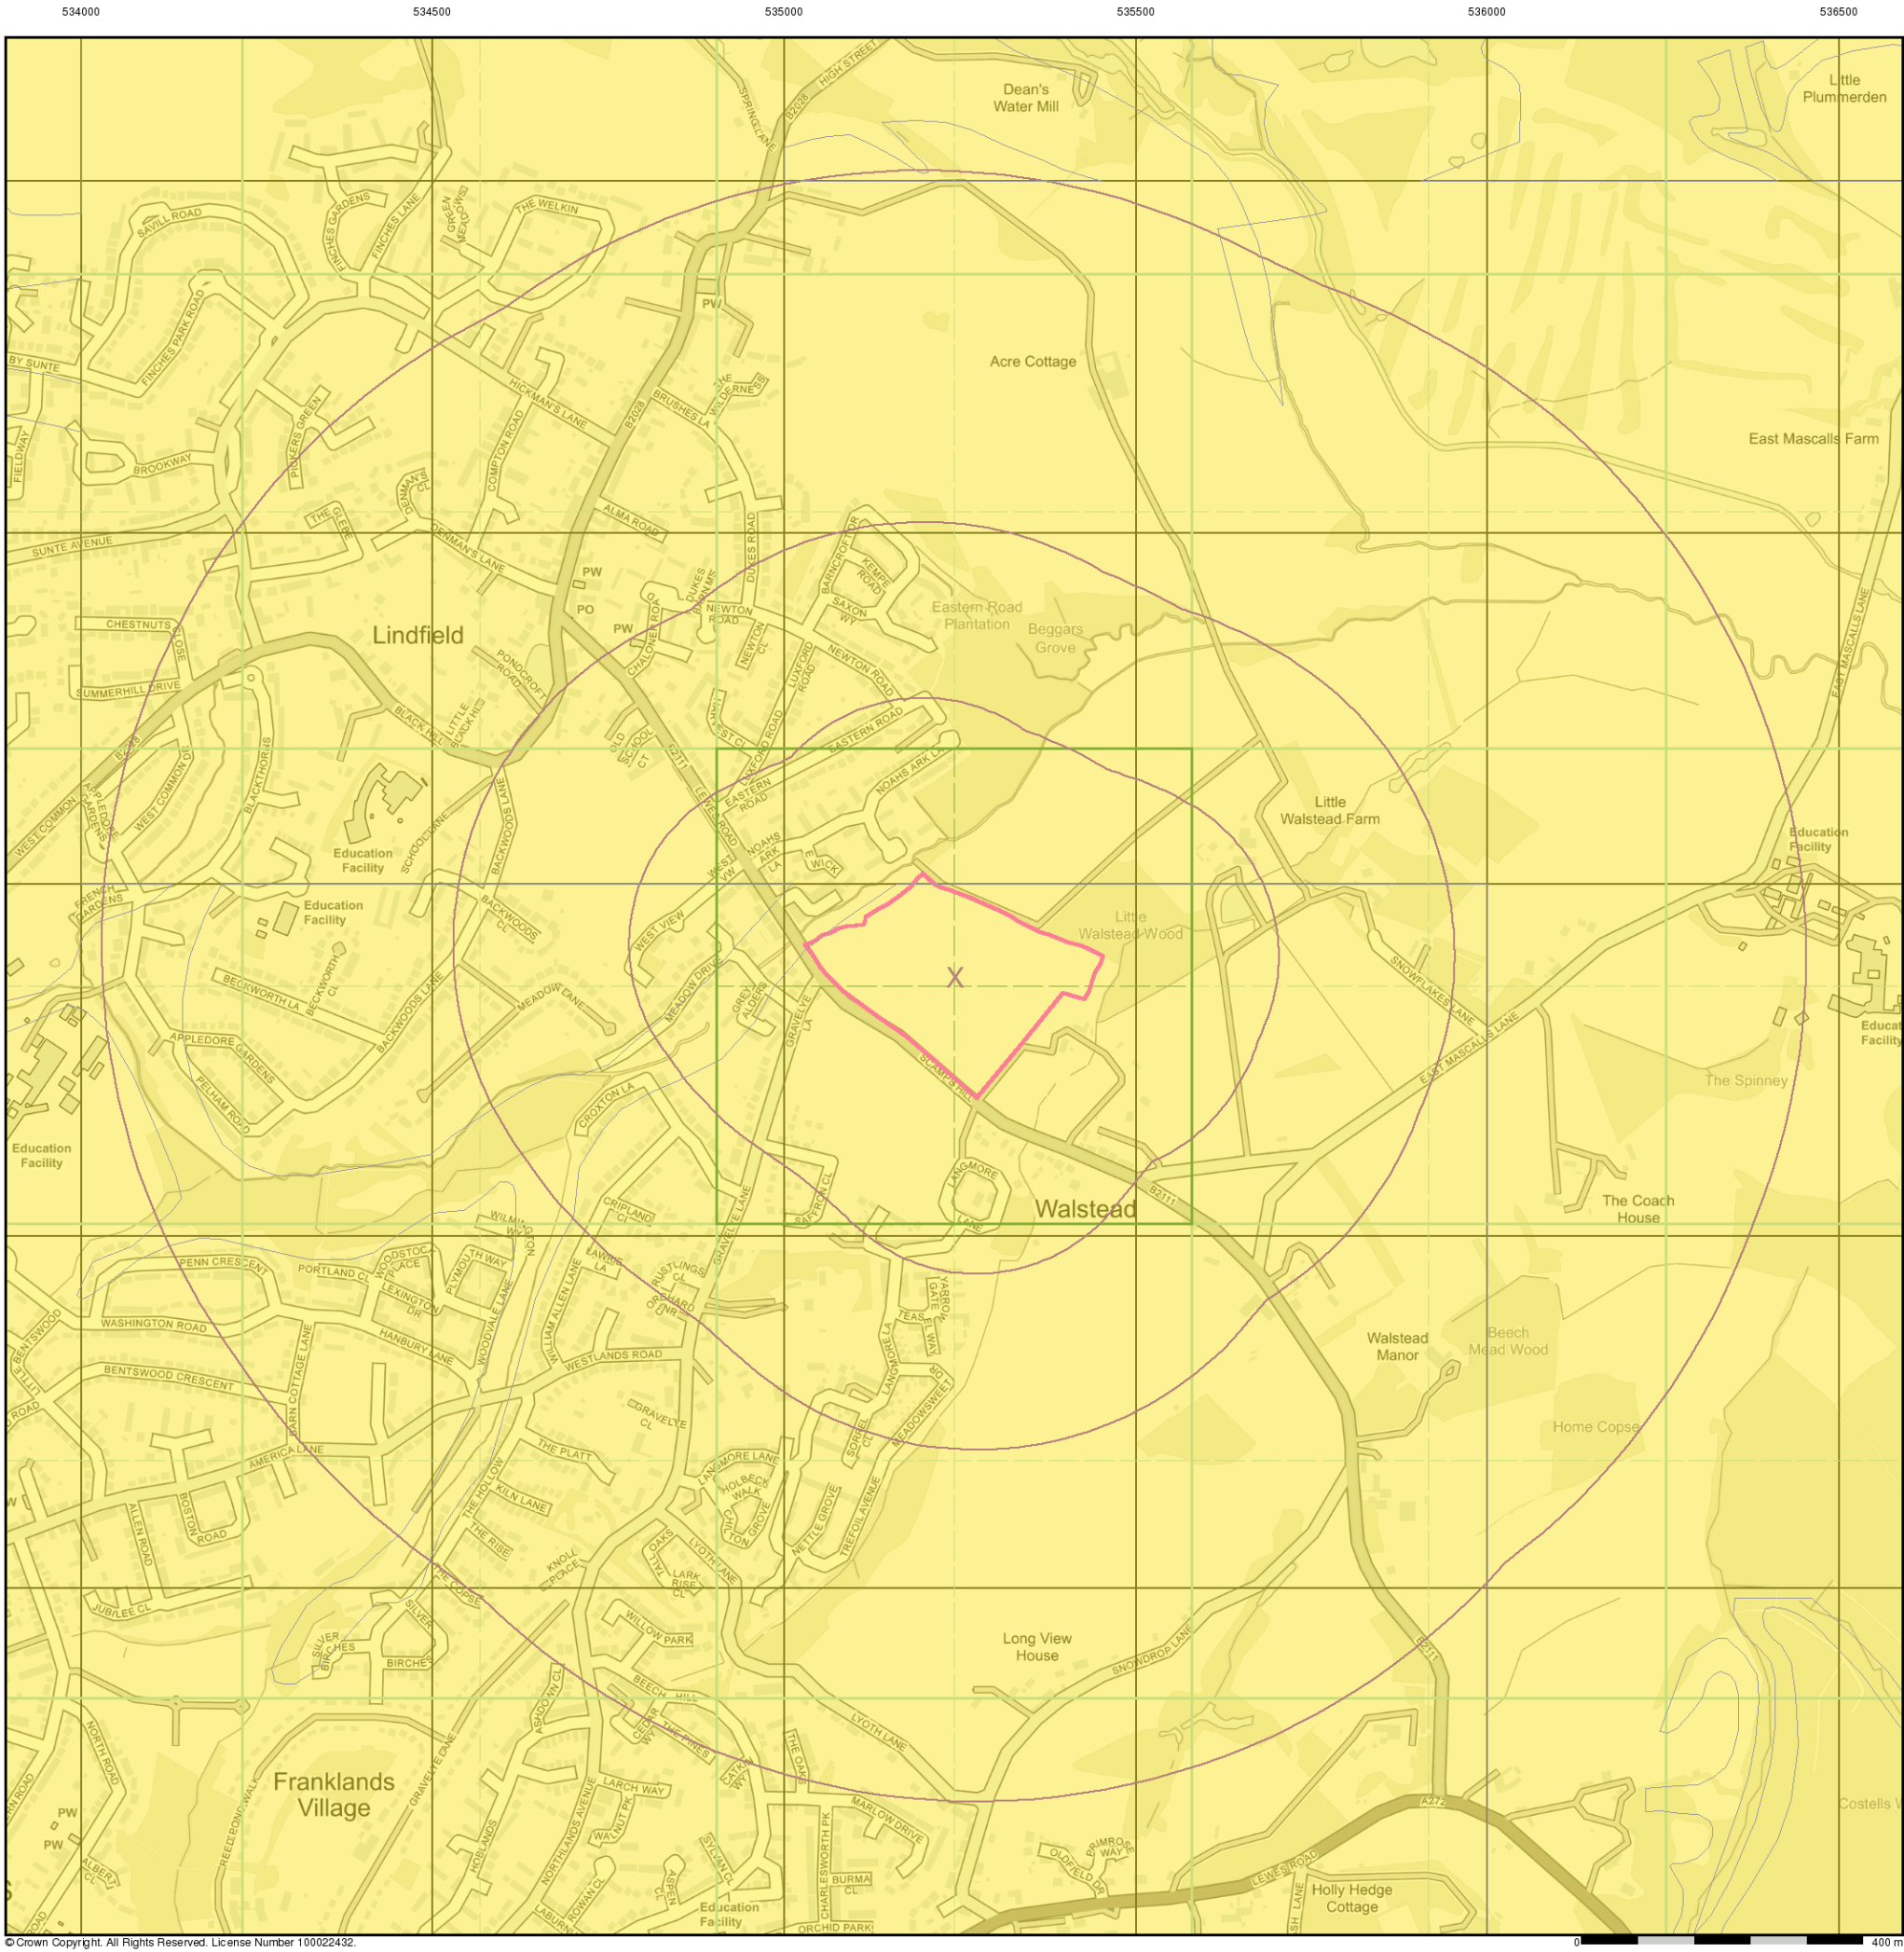

Geology 1:50,000 Maps Legends

Superficial Geology

Map Colour	Lex Code	Rock Name	Rock Type	Min and Max Age
	ALV	Alluvium	Clay, Silt, Sand and Gravel	Not Supplied - Holocene
	HEAD	Head	Clay, Silt, Sand and Gravel	Not Supplied - Quaternary
	RTD1	River Terrace Deposits, 1	Sand and Gravel	Not Supplied - Quaternary

Bedrock and Faults

Map Colour	Lex Code	Rock Name	Rock Type	Min and Max Age
	UTW	UPPER TUNBRIDGE WELLS SAND	Sandstone and Siltstone, Interbedded	Not Supplied - Valanginian
	LTW	LOWER TUNBRIDGE WELLS SAND	Sandstone, Siltstone and Mudstone	Not Supplied - Valanginian
	WDC	Wadhurst Clay Formation	Mudstone	Not Supplied - Valanginian
	UGRC	Upper Grinstead Clay	Mudstone	Not Supplied - Valanginian
	CKST	CUCKFIELD STONE BED	Sandstone, Calcareous	Not Supplied - Valanginian
	ARS	ARDINGLY SANDSTONE MEMBER	Sandstone	Not Supplied - Valanginian
	LGRC	Lower Grinstead Clay	Mudstone	Not Supplied - Valanginian
		Faults		

Envirocheck®

LANDMARK INFORMATION GROUP®

Geology 1:50,000 Maps


This report contains geological map extracts taken from the BGS Digital Geological map of Great Britain at 1:50,000 scale and is designed for users carrying out preliminary site assessments who require geological maps for the area around the site. This mapping may be more up to date than previously published paper maps.

The various geological layers - artificial and landslip deposits, superficial geology and solid (bedrock) geology are displayed in separate maps, but superimposed on the final 'Combined Surface Geology' map. All map legends feature on this page. Not all layers have complete nationwide coverage, so availability of data for relevant map sheets is indicated below.

Geology 1:50,000 Maps Coverage

Map ID:	1
Map Sheet No:	302
Map Name:	Horsham
Map Date:	1972
Bedrock Geology:	Available
Superficial Geology:	Available
Artificial Geology:	Available
Faults:	Not Supplied
Landslip:	Available
Rock Segments:	Not Supplied

Geology 1:50,000 Maps - Slice A

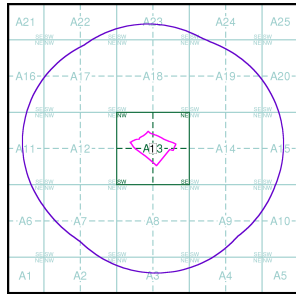

Order Details:


Order Number:	334357177_1_1
Customer Reference:	6534
National Grid Reference:	535240, 124870
Slice:	A
Site Area (Ha):	6.63
Search Buffer (m):	1000

Site Details:

Scamps Hill, Lindfield, Haywards Heath, RH16 2GL

Landmark®
LANDMARK INFORMATION GROUP

Tel: 0844 844 9952
Fax: 0844 844 9951
Web: www.envirocheck.co.uk

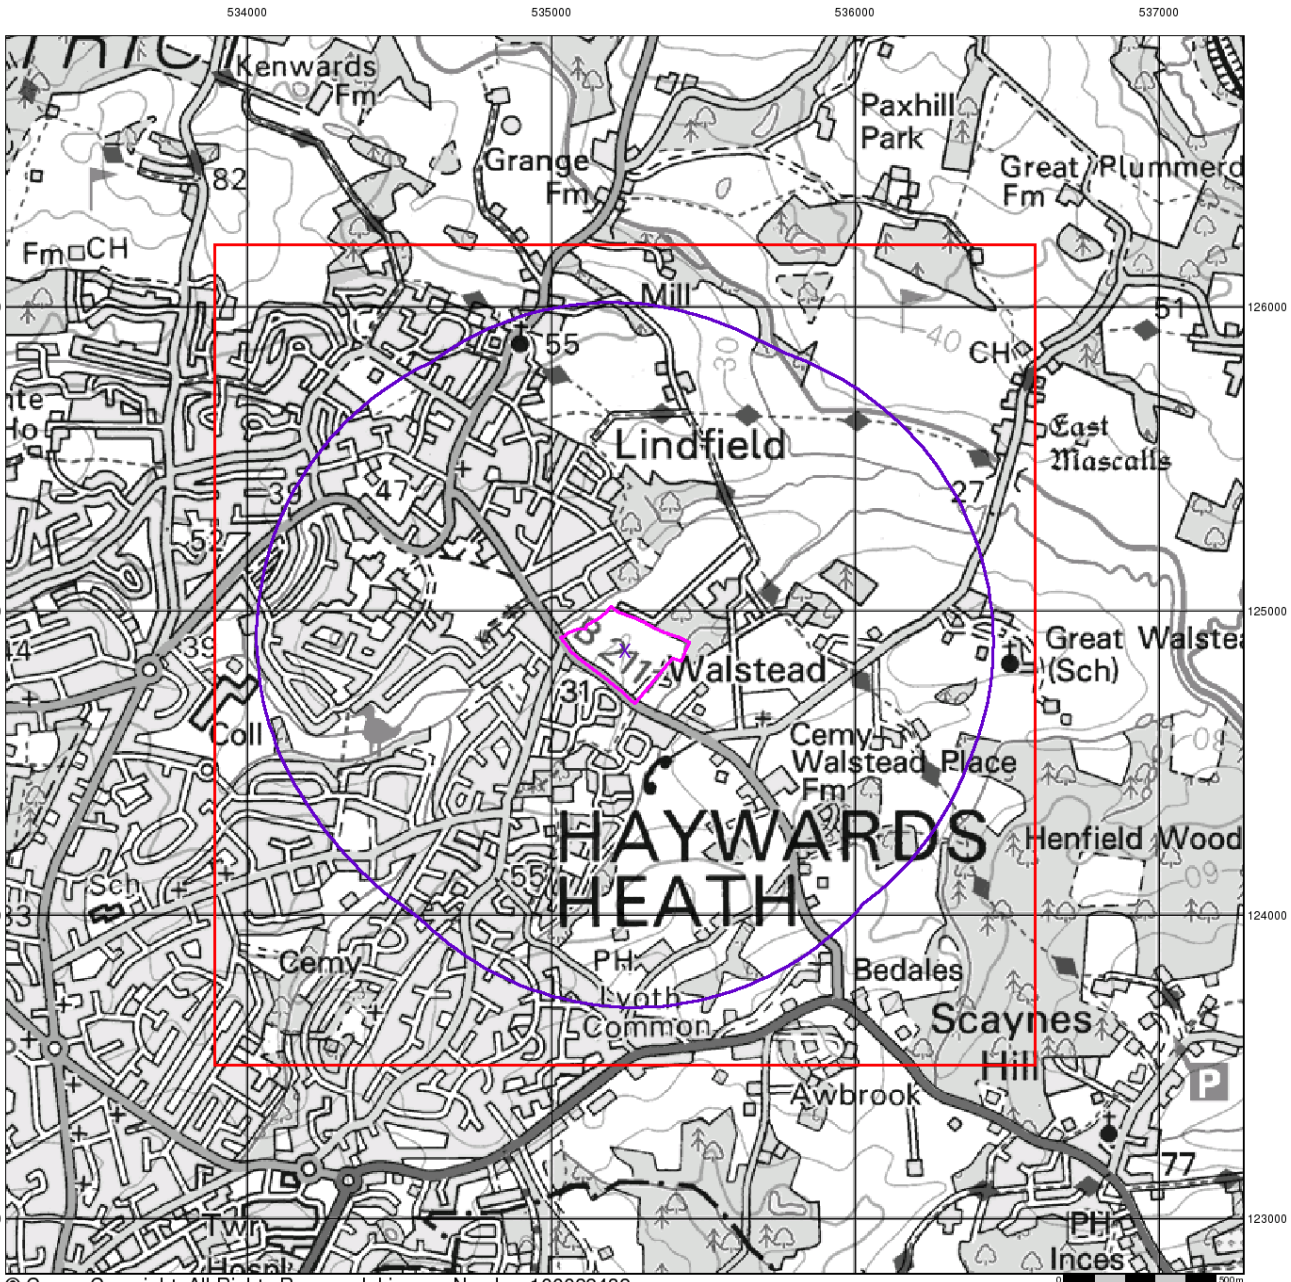

© Crown Copyright. All Rights Reserved. License Number 100022432.

Envirocheck®

LANDMARK INFORMATION GROUP®

Artificial Ground and Landslip


Artificial ground is a term used by BGS for those areas where the ground surface has been significantly modified by human activity. Information about previously developed ground is especially important, as it is often associated with potentially contaminated material, unpredictable engineering conditions and unstable ground.

Artificial ground includes:

- Made ground - man-made deposits such as embankments and spoil heaps on the natural ground surface.
- Worked ground - areas where the ground has been cut away such as quarries and road cuttings.
- Infilled ground - areas where the ground has been cut away then wholly or partially backfilled.
- Landscaped ground - areas where the surface has been reshaped.
- Disturbed ground - areas of ill-defined shallow or near surface mineral workings where it is impracticable to map made and worked ground separately.

Mass movement (landslip) deposits on BGS geological maps are primarily superficial deposits that have moved down slope under gravity to form landslips. These affect bedrock, other superficial deposits and artificial ground. The dataset also includes foundered strata, where the ground has collapsed due to subsidence.

Artificial Ground and Landslip Map - Slice A

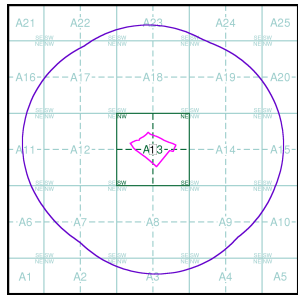

Order Details:


Order Number: 334357177_1_1
Customer Reference: 6534
National Grid Reference: 535240, 124870
Slice: A
Site Area (Ha): 6.63
Search Buffer (m): 1000

Site Details:

Scamps Hill, Lindfield, Haywards Heath, RH16 2GL

Landmark®
LANDMARK INFORMATION GROUP

Tel: 0844 844 9952
Fax: 0844 844 9951
Web: www.envirocheck.co.uk

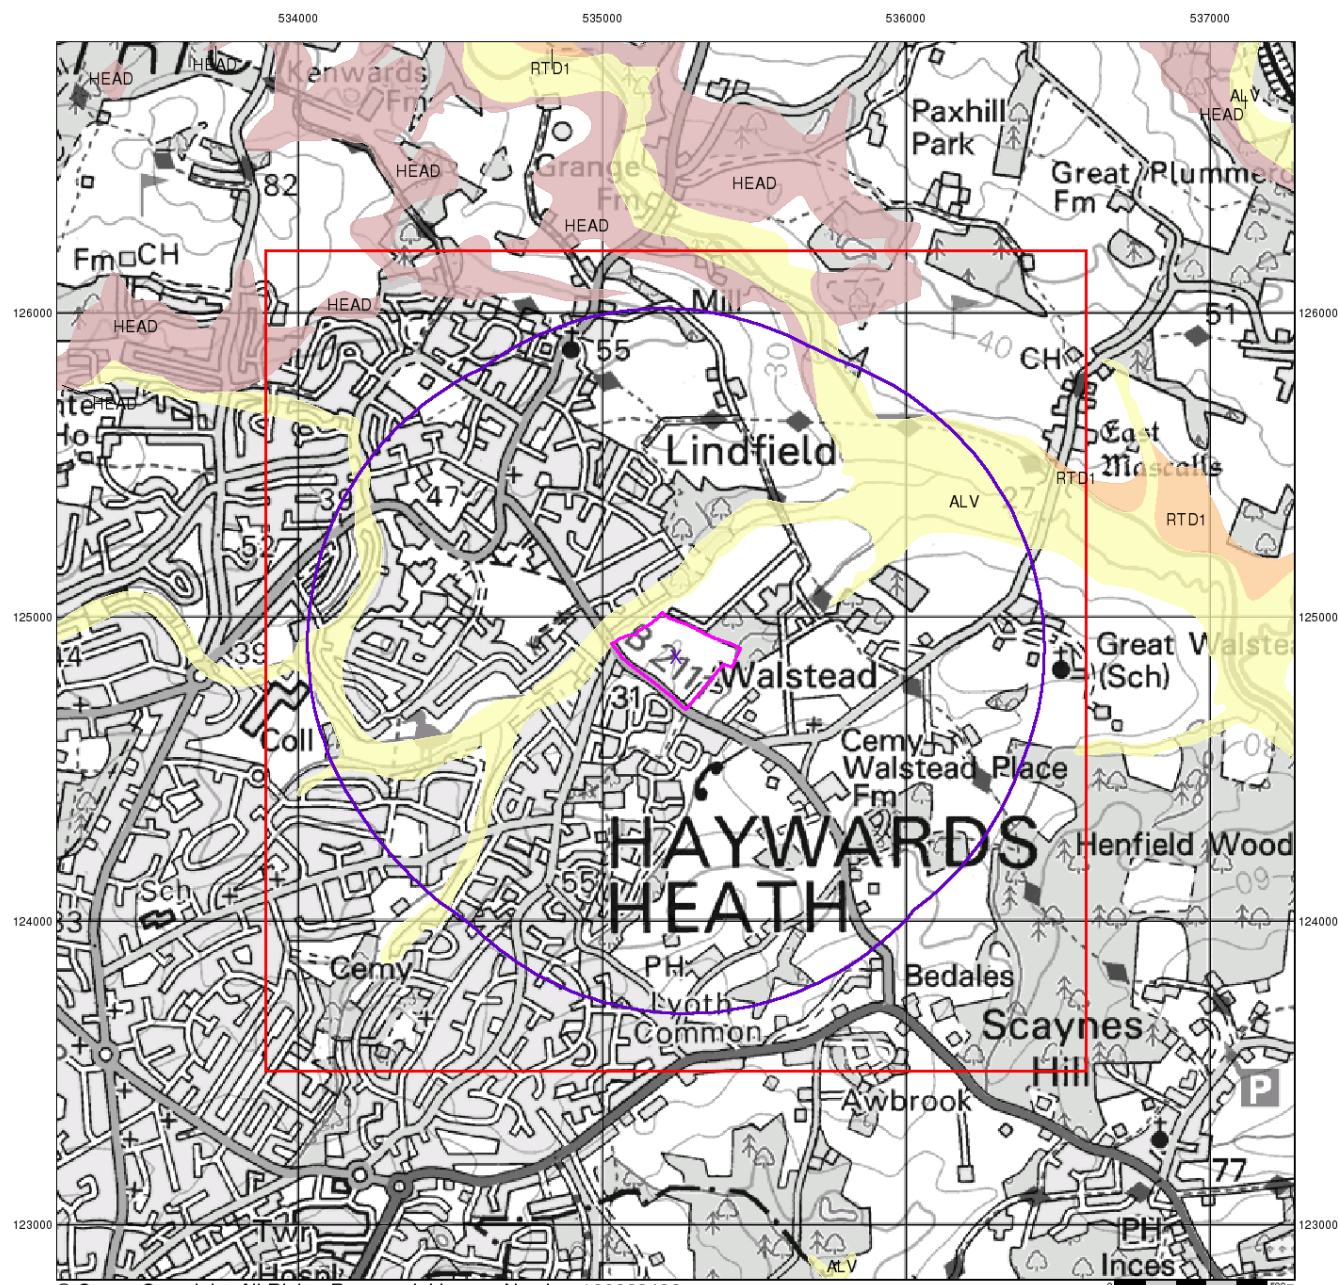

© Crown Copyright. All Rights Reserved. License Number 100022432.

Envirocheck®

LANDMARK INFORMATION GROUP®


Superficial Geology

Superficial Deposits are the youngest geological deposits formed during the most recent period of geological time, the Quaternary, which extends back about 1.8 million years from the present.

They rest on older deposits or rocks referred to as Bedrock. This dataset contains Superficial deposits that are of natural origin and 'in place'. Other superficial strata may be held in the Mass Movement dataset where they have been moved, or in the Artificial Ground dataset where they are of man-made origin.

Most of these Superficial deposits are unconsolidated sediments such as gravel, sand, silt and clay, and onshore they form relatively thin, often discontinuous patches or larger spreads.

Superficial Geology Map - Slice A

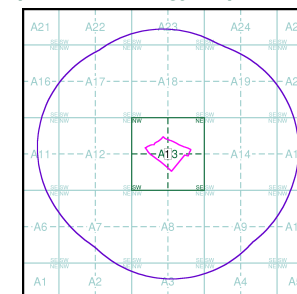

Order Details:

Order Number: 334357177_1_1
 Customer Reference: 6534
 National Grid Reference: 535240, 124870
 Slice: A
 Site Area (Ha): 6.63
 Search Buffer (m): 1000

Site Details:

Scamps Hill, Lindfield, Haywards Heath, RH16 2GL

Landmark®
 INFORMATION GROUP

Tel: 0844 844 9952
 Fax: 0844 844 9951
 Web: www.envirocheck.co.uk

Envirocheck®

● LANDMARK INFORMATION GROUP®

Bedrock and Faults


Bedrock geology is a term used for the main mass of rocks forming the Earth and are present everywhere, whether exposed at the surface in outcrops or concealed beneath superficial deposits or water.

The bedrock has formed over vast lengths of geological time ranging from ancient and highly altered rocks of the Proterozoic, some 2500 million years ago, or older, up to the relatively young Pliocene, 1.8 million years ago.

The bedrock geology includes many lithologies, often classified into three types based on origin: igneous, metamorphic and sedimentary.

The BGS Faults and Rock Segments dataset includes geological faults (e.g. normal, thrust), and thin beds mapped as lines (e.g. coal seam, gypsum bed). Some of these are linked to other particular 1:50,000 Geology datasets, for example, coal seams are part of the bedrock sequence, most faults and mineral veins primarily affect the bedrock but cut across the strata and post date its deposition.

Bedrock and Faults Map - Slice A

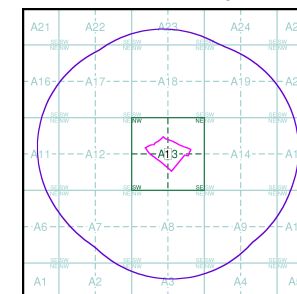

Order Details:

Order Number: 334357177_1_1
 Customer Reference: 6534
 National Grid Reference: 535240, 124870
 Slice: A
 Site Area (Ha): 6.63
 Search Buffer (m): 1000

Site Details:


Scamps Hill, Lindfield, Haywards Heath, RH16 2GL

Landmark®
 ● LANDMARK INFORMATION GROUP


Tel: 0844 844 9952
 Fax: 0844 844 9951
 Web: www.envirocheck.co.uk

v15.0 07-Feb-2024

Page 4 of 5

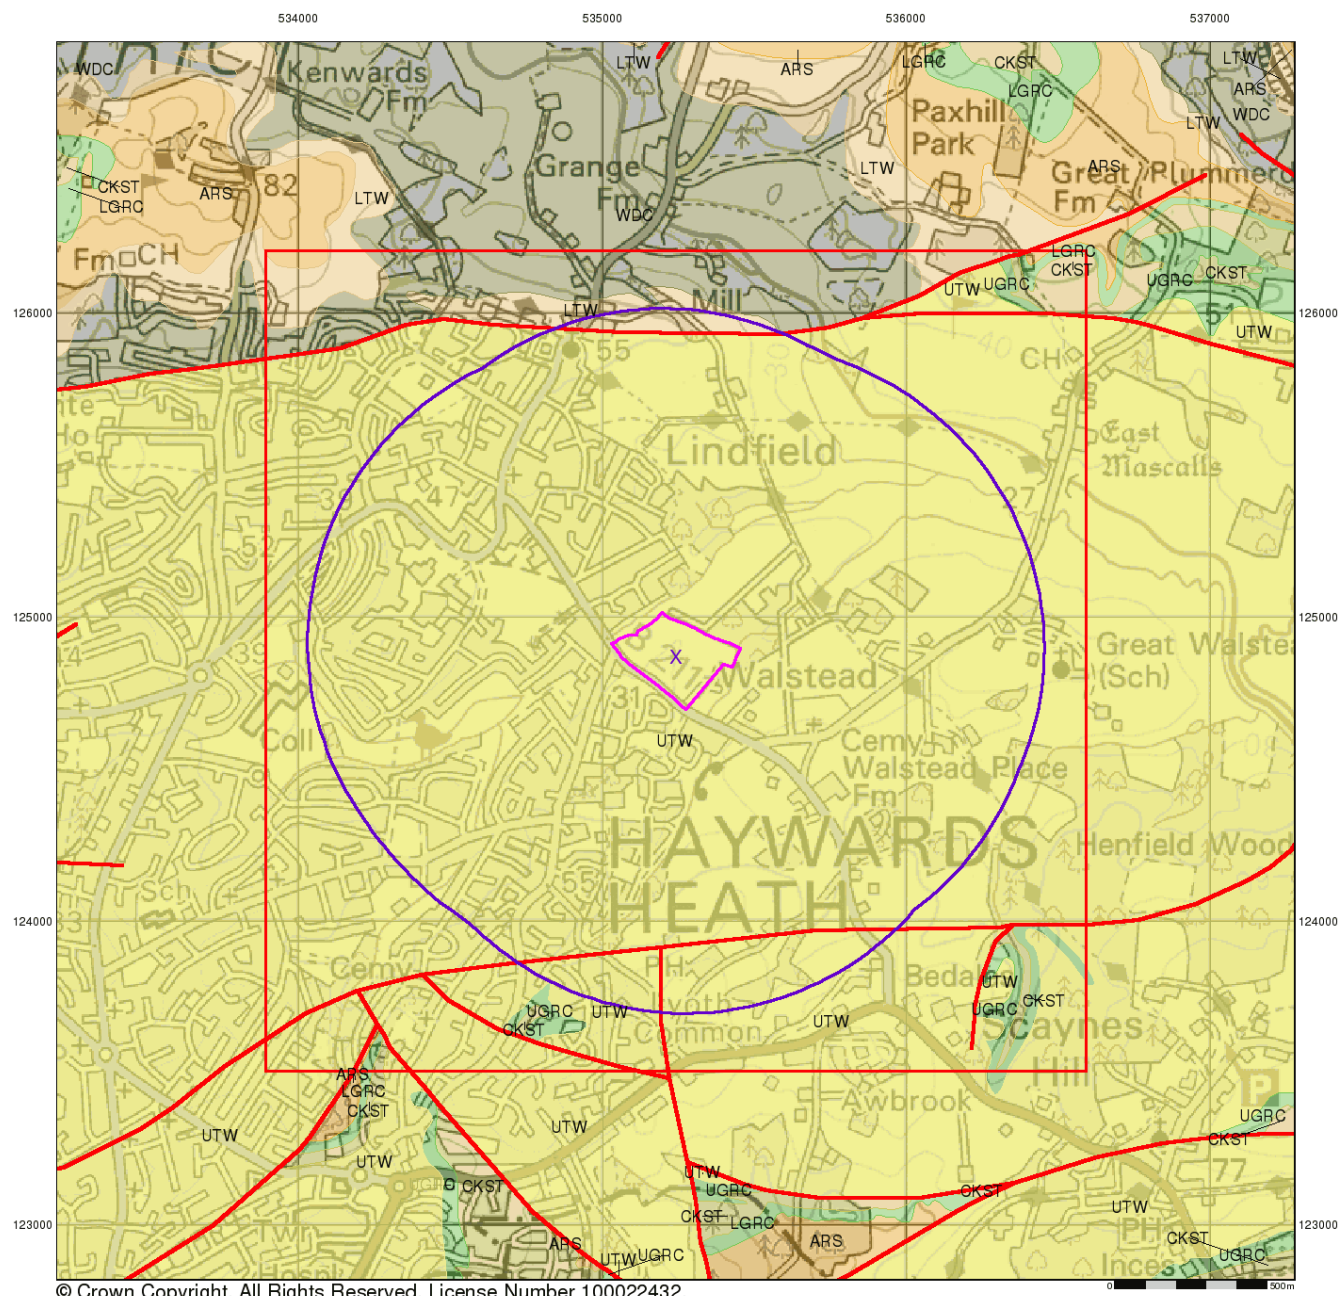

© Crown Copyright. All Rights Reserved. License Number 100022432.

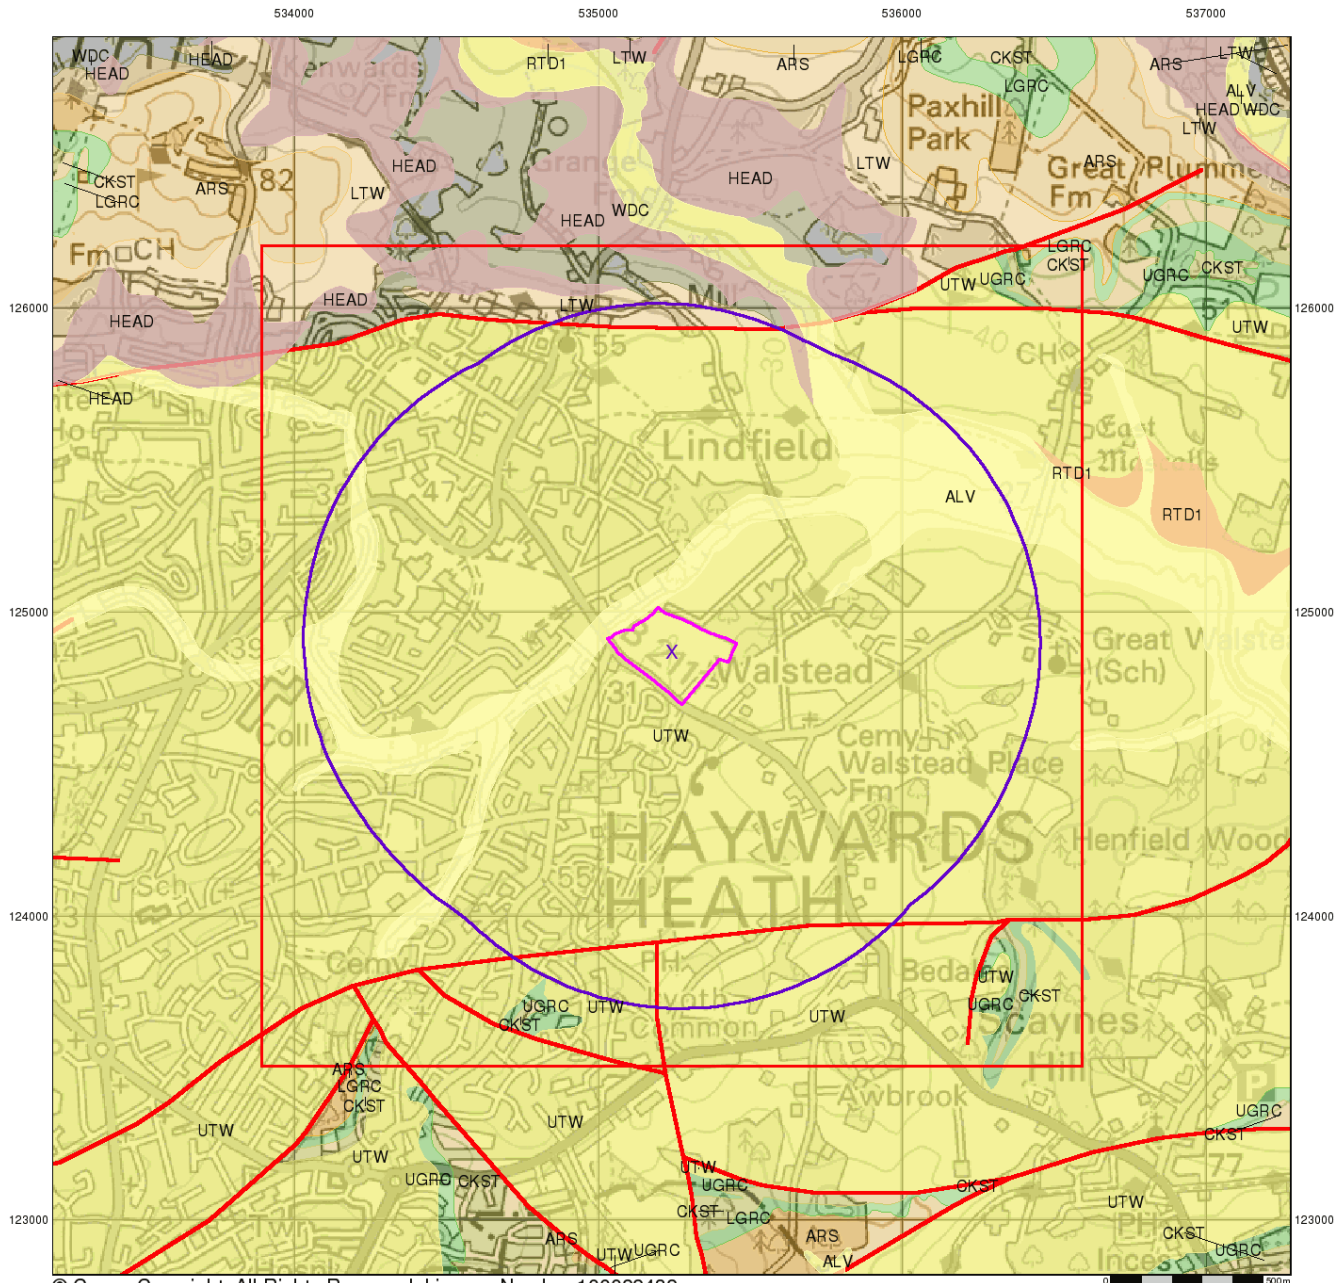

© Crown Copyright. All Rights Reserved. License Number 100022432.

Envirocheck®

LANDMARK INFORMATION GROUP®

Combined Surface Geology

The Combined Surface Geology map combines all the previous maps into one combined geological overview of your site.

Please consult the legends to the previous maps to interpret the Combined "Surface Geology" map.


Additional Information

More information on 1:50,000 Geological mapping and explanations of rock classifications can be found on the BGS website. Using the LEX Codes in this report, further descriptions of rock types can be obtained by interrogating the 'BGS Lexicon of Named Rock Units'. This database can be accessed by following the 'Information and Data' link on the BGS website.

Contact

British Geological Survey
Kingsley Dunham Centre
Keyworth
Nottingham
NG12 5GG
Telephone: 0115 936 3143
Fax: 0115 936 3276
email: enquiries@bgs.ac.uk
website: www.bgs.ac.uk

Combined Geology Map - Slice A

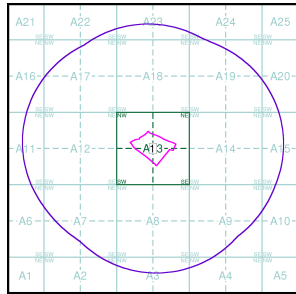

Order Details:

Order Number: 334357177_1_1
Customer Reference: 6534
National Grid Reference: 535240, 124870
Slice: A
Site Area (Ha): 6.63
Search Buffer (m): 1000

Site Details:

Scamps Hill, Lindfield, Haywards Heath, RH16 2GL

Landmark®
INFORMATION GROUP

Tel: 0844 844 9952
Fax: 0844 844 9951
Web: www.envirocheck.co.uk

Envirocheck®

LANDMARK INFORMATION GROUP®

Groundwater Vulnerability

General

-  Specified Site
  Specified Buffer(s)
  Bearing Reference Point
-  Slice
  Map ID

Agency and Hydrological

Bedrock Aquifers

-  High Vulnerability, Principal Aquifer
-  High Vulnerability, Secondary Aquifer
-  Medium Vulnerability, Principal Aquifer
-  Medium Vulnerability, Secondary Aquifer
-  Low Vulnerability, Principal Aquifer
-  Low Vulnerability, Secondary Aquifer


Superficial Aquifers

-  High Vulnerability, Principal Aquifer
-  High Vulnerability, Secondary Aquifer
-  Medium Vulnerability, Principal Aquifer
-  Medium Vulnerability, Secondary Aquifer
-  Low Vulnerability, Principal Aquifer
-  Low Vulnerability, Secondary Aquifer

 Unproductive Aquifer

 Soluble Rock

Site Sensitivity Context Map - Slice A

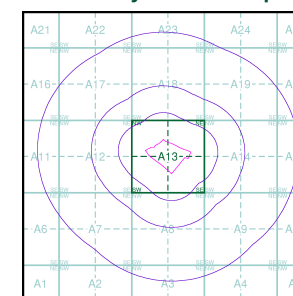

Order Details


Order Number: 334357177_1_1
 Customer Ref: 6534
 National Grid Reference: 535240, 124870
 Slice: A
 Site Area (Ha): 6.63
 Search Buffer (m): 1000


Site Details

Scamps Hill, Lindfield, Haywards Heath, RH16 2GL

Landmark®
 INFORMATION GROUP

Tel: 0844 844 9952
 Fax: 0844 844 9951
 Web: www.envirocheck.co.uk

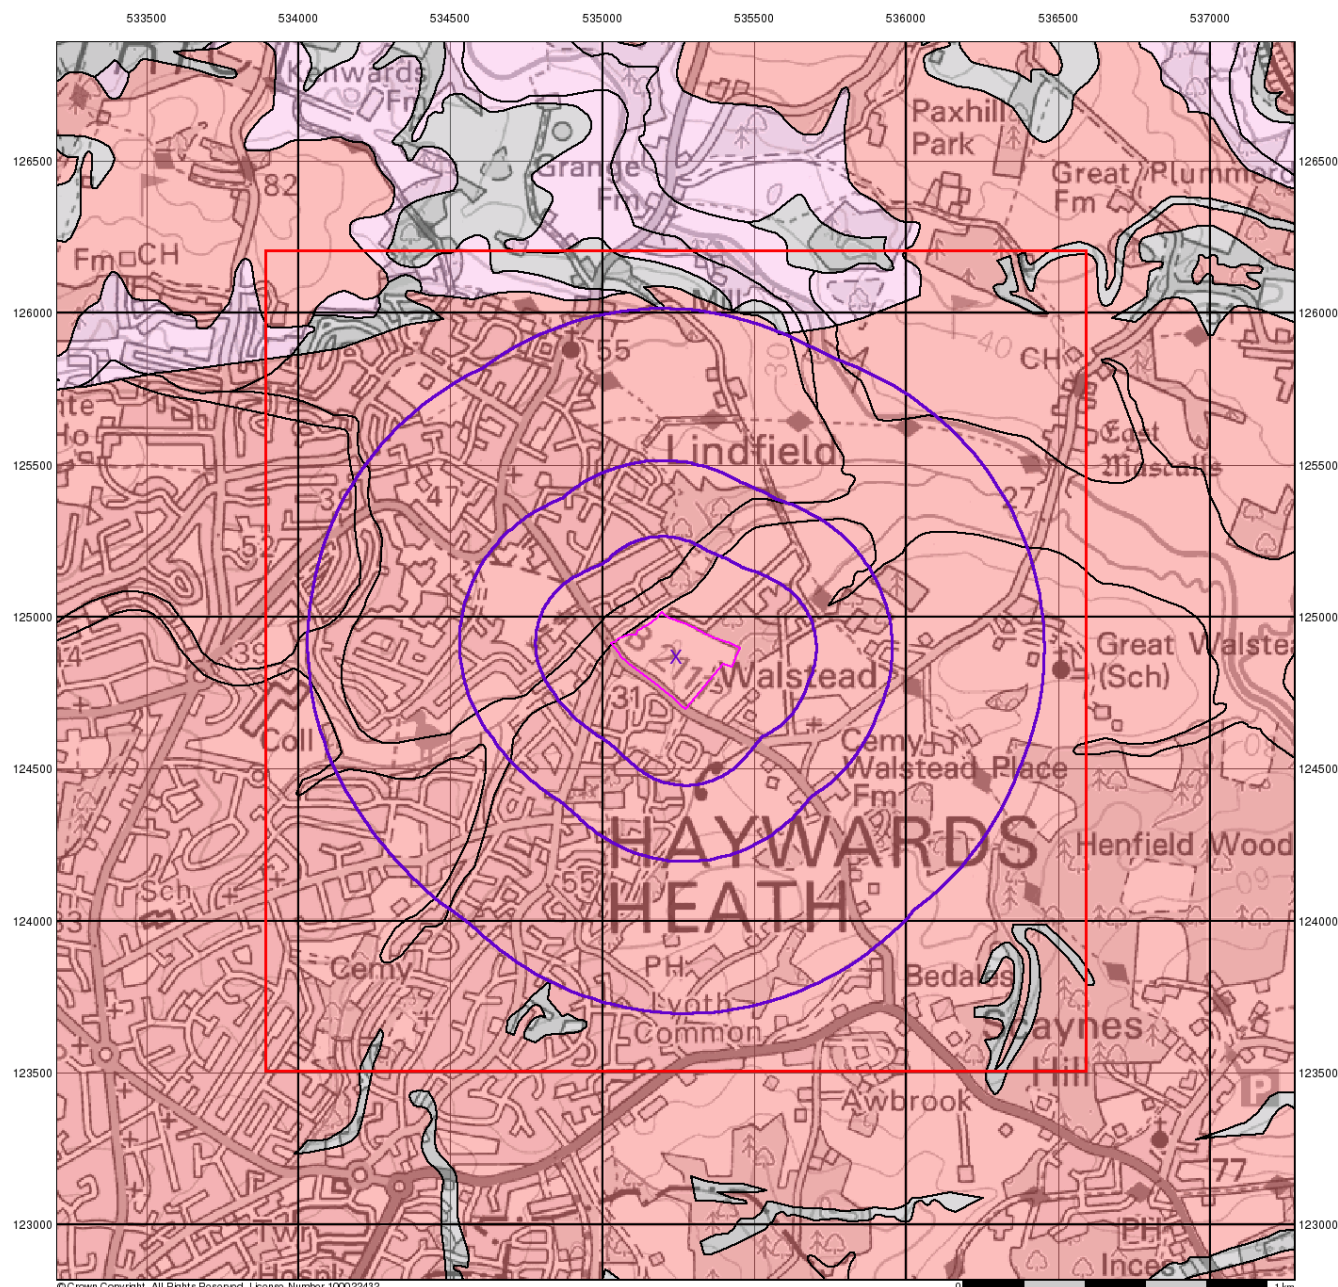

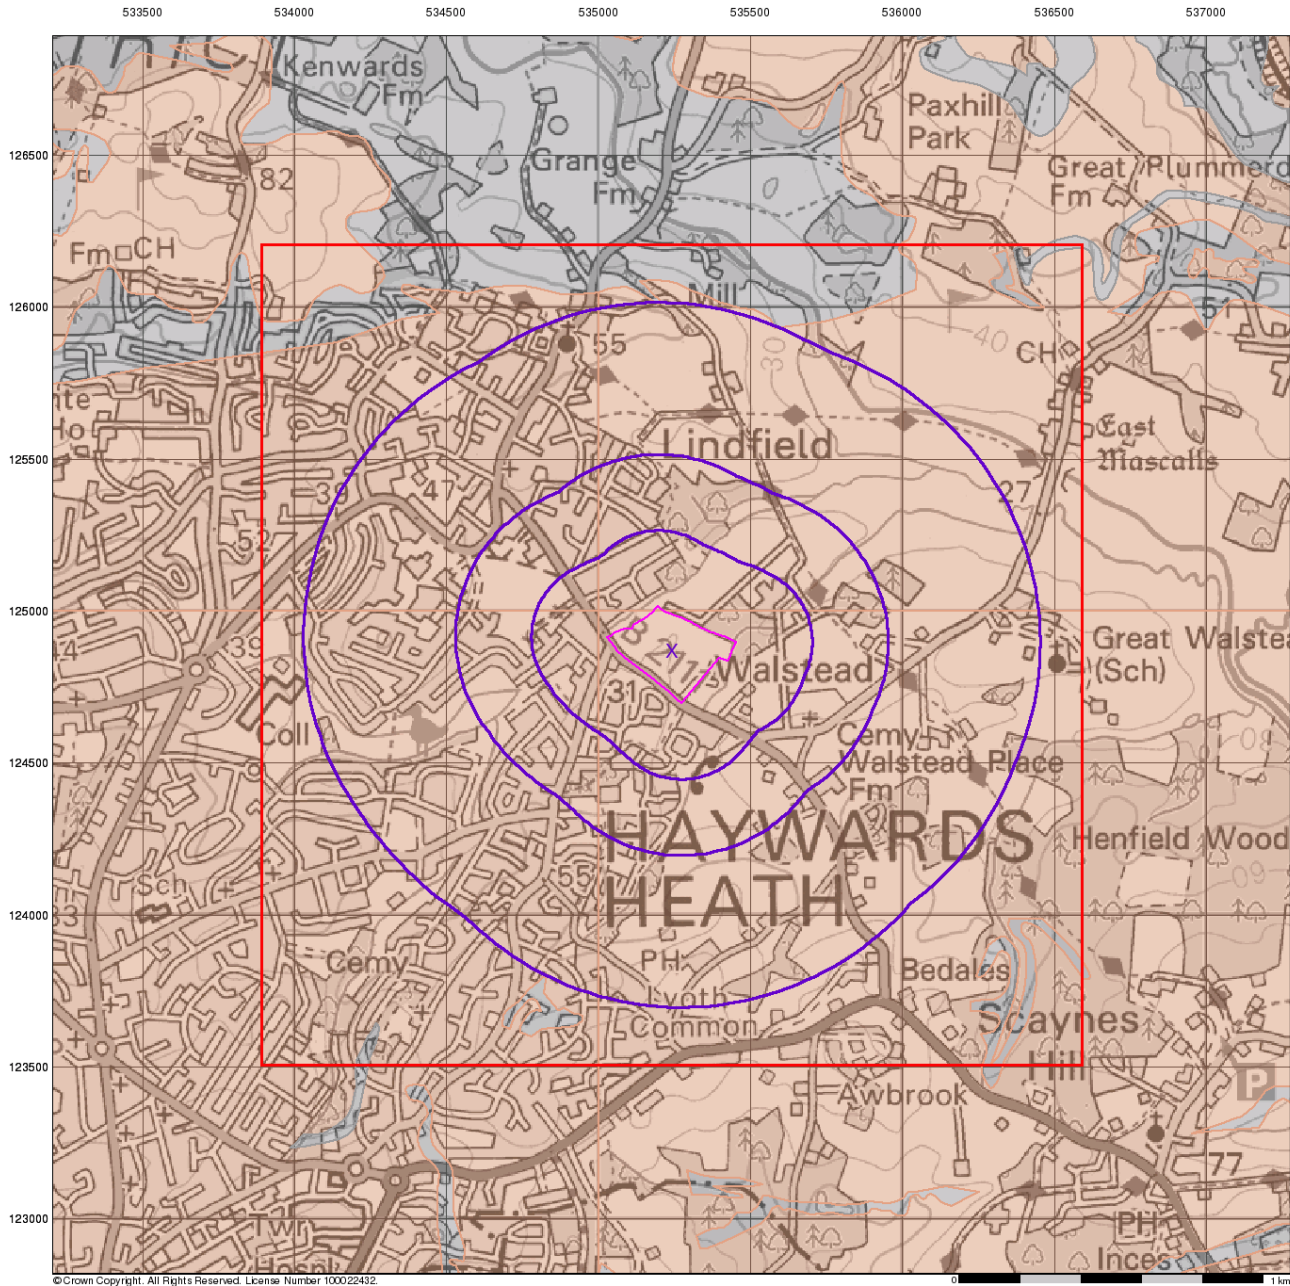

© Crown Copyright. All Rights Reserved. License Number 100022432.

Envirocheck®

LANDMARK INFORMATION GROUP®

Bedrock Aquifer Designation

General


- Specified Site
- Specified Buffer(s)
- Bearing Reference Point
- Slice
- Map ID

Agency and Hydrological

Geological Classes

- Principal Aquifer
- Secondary A Aquifer
- Secondary B Aquifer
- Secondary Undifferentiated
- Unproductive Strata
- Unknown
- Unknown (Lakes and Landslip)

Site Sensitivity Context Map - Slice A

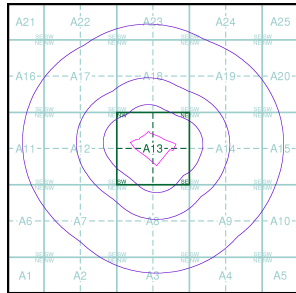

Order Details


Order Number: 334357177_1_1
Customer Ref: 6534
National Grid Reference: 535240, 124870
Slice: A
Site Area (Ha): 6.63
Search Buffer (m): 1000

Site Details

Scamps Hill, Lindfield, Haywards Heath, RH16 2GL

Landmark®
LANDMARK INFORMATION GROUP

Tel: 0844 844 9952
Fax: 0844 844 9951
Web: www.envirocheck.co.uk

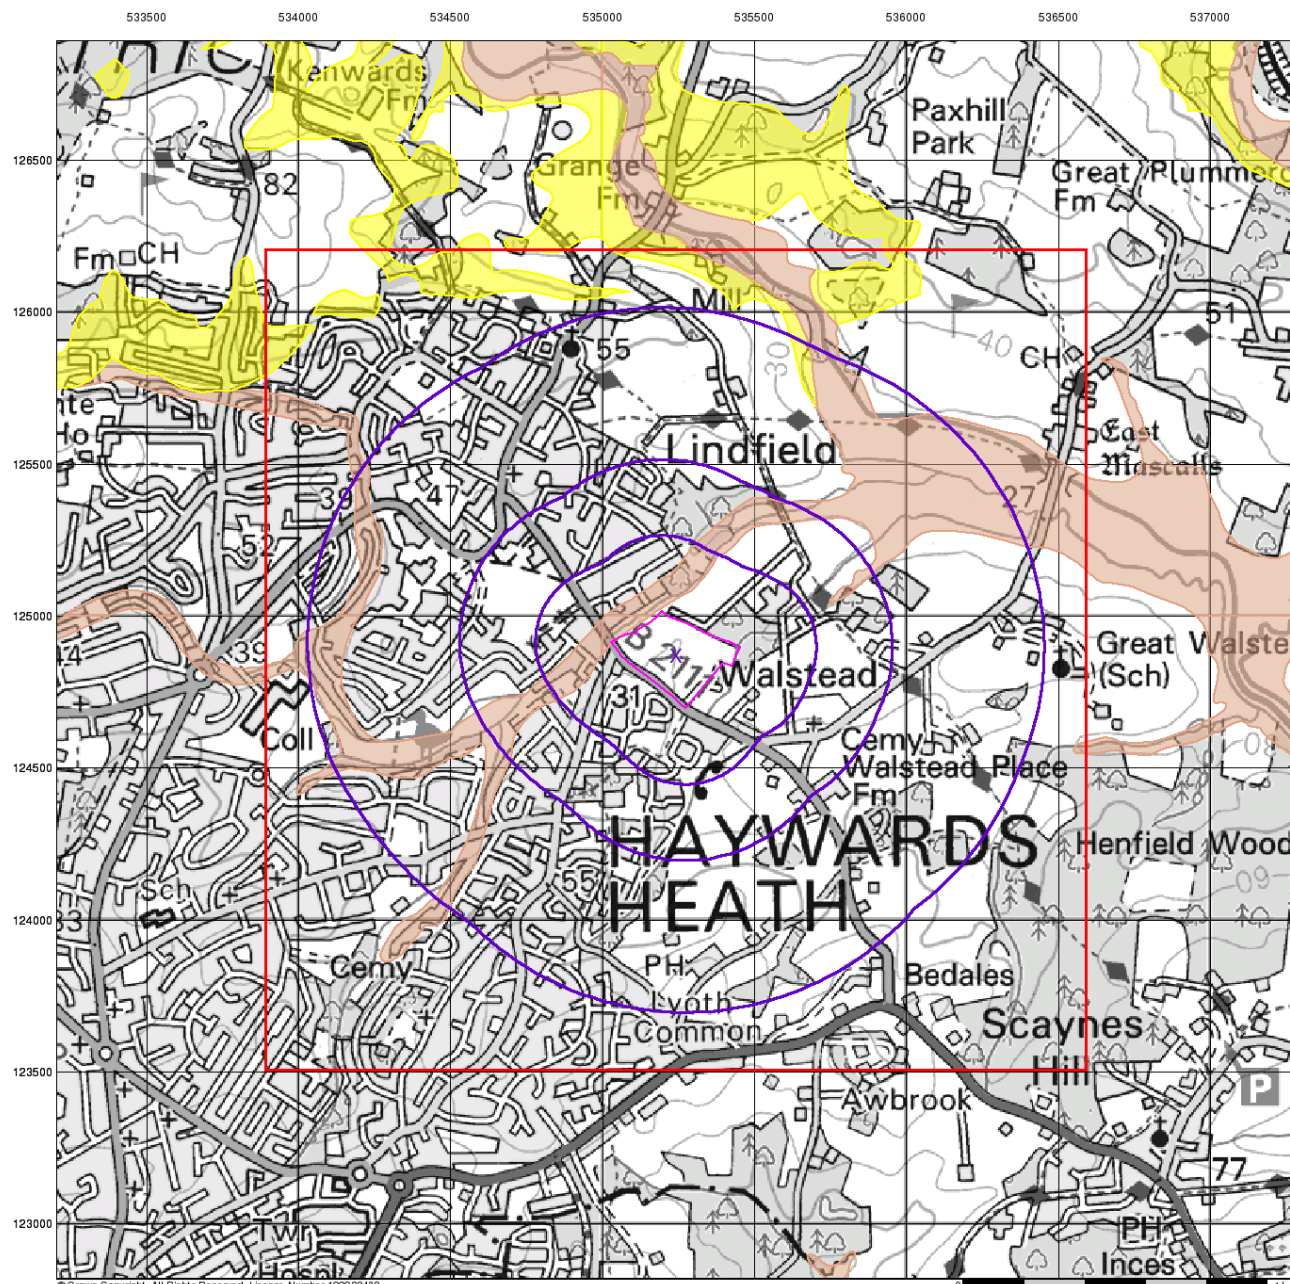

© Crown Copyright. All Rights Reserved. License Number 100022432

Envirocheck®

LANDMARK INFORMATION GROUP®

Superficial Aquifer Designation

General


- ◊ Specified Site
- Specified Buffer(s)
- X Bearing Reference Point
- Slice
- Map ID

Agency and Hydrological

Geological Classes

- Principal Aquifer
- Secondary A Aquifer
- Secondary B Aquifer
- Secondary Undifferentiated
- Unproductive Strata
- Unknown
- Unknown (Lakes and Landslip)

Site Sensitivity Context Map - Slice A

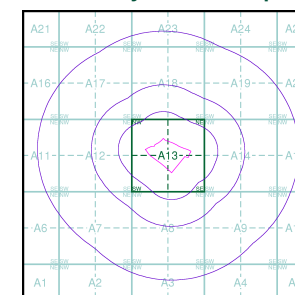

Order Details


Order Number: 334357177_1_1
 Customer Ref: 6534
 National Grid Reference: 535240, 124870
 Slice: A
 Site Area (Ha): 6.63
 Search Buffer (m): 1000

Site Details

Scamps Hill, Lindfield, Haywards Heath, RH16 2GL

Landmark®
 INFORMATION GROUP

Tel: 0844 844 9952
 Fax: 0844 844 9951
 Web: www.envirocheck.co.uk

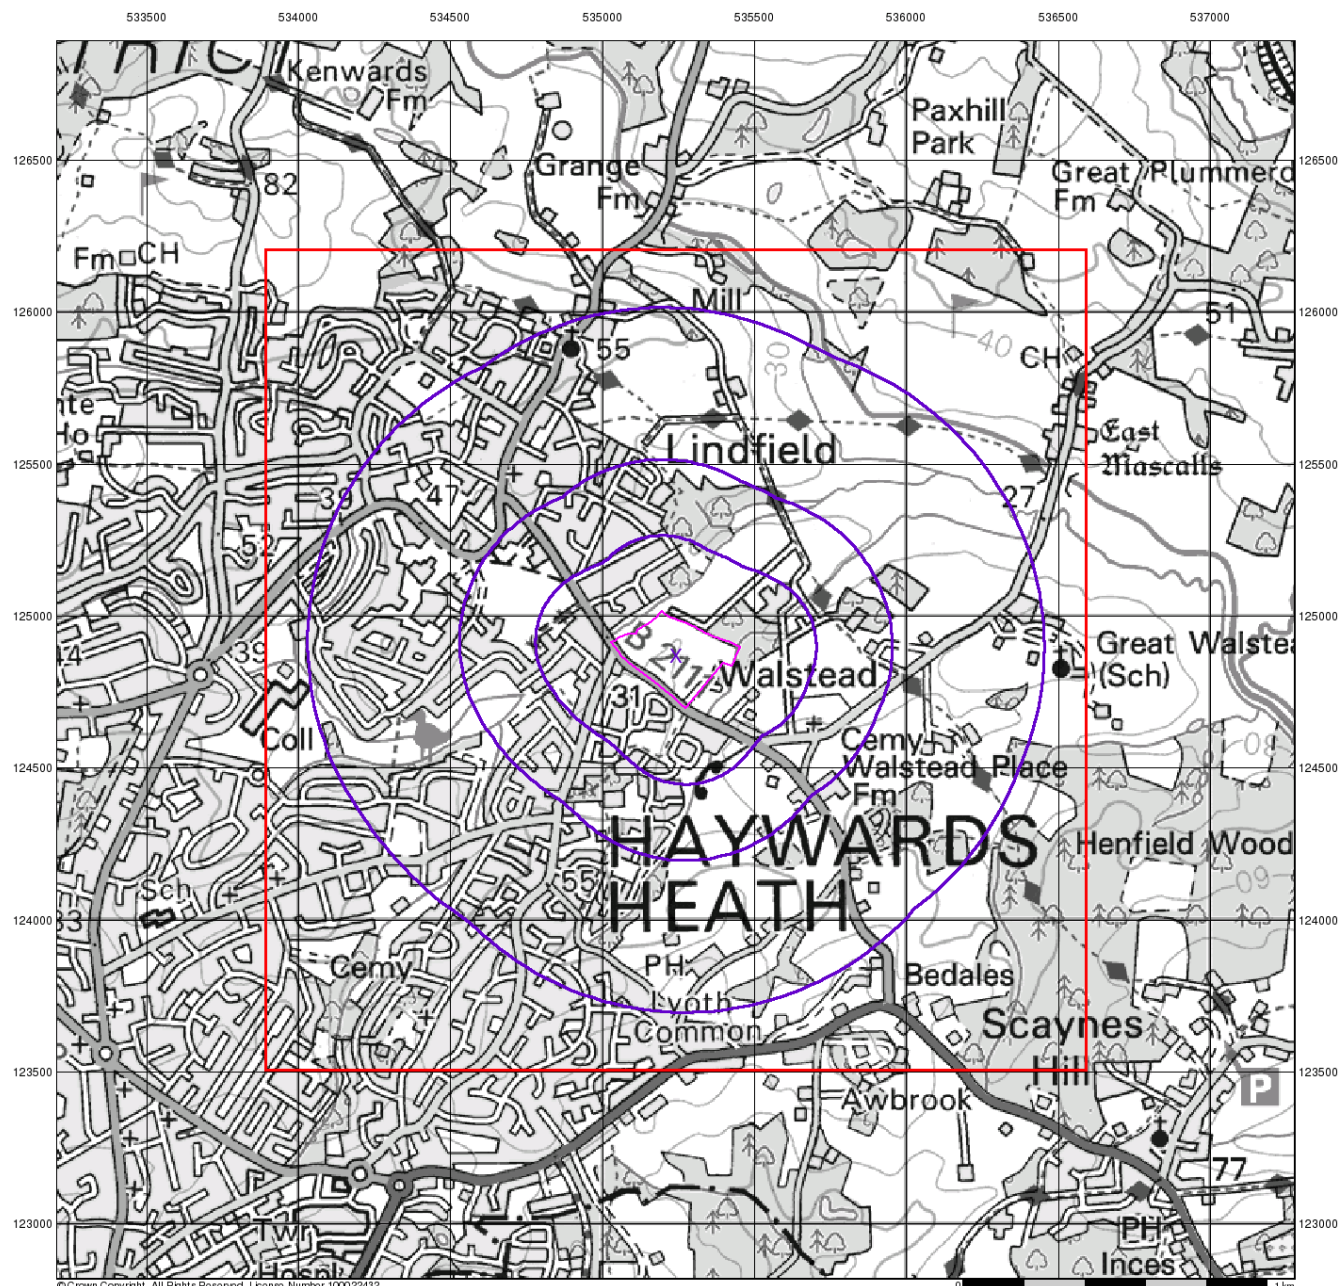

© Crown Copyright. All Rights Reserved. License Number 100022432

Envirocheck®

LANDMARK INFORMATION GROUP®

Source Protection Zones


General

- Specified Site
- Specified Buffer(s)
- Bearing Reference Point
- Slice
- Map ID

Agency and Hydrological

- Inner zone (Zone 1)
- Inner zone - subsurface activity only (Zone 1c)
- Outer zone (Zone 2)
- Outer zone - subsurface activity only (Zone 2c)
- Total catchment (Zone 3)
- Total catchment - subsurface activity only (Zone 3c)
- Special interest (Zone 4)

Site Sensitivity Context Map - Slice A

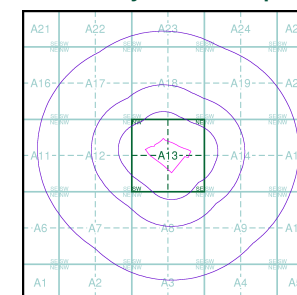

Order Details


Order Number: 334357177_1_1
 Customer Ref: 6534
 National Grid Reference: 535240, 124870
 Slice: A
 Site Area (Ha): 6.63
 Search Buffer (m): 1000

Site Details

Scamps Hill, Lindfield, Haywards Heath, RH16 2GL

Landmark®
 LANDMARK INFORMATION GROUP

Tel: 0844 844 9952
 Fax: 0844 844 9951
 Web: www.envirocheck.co.uk

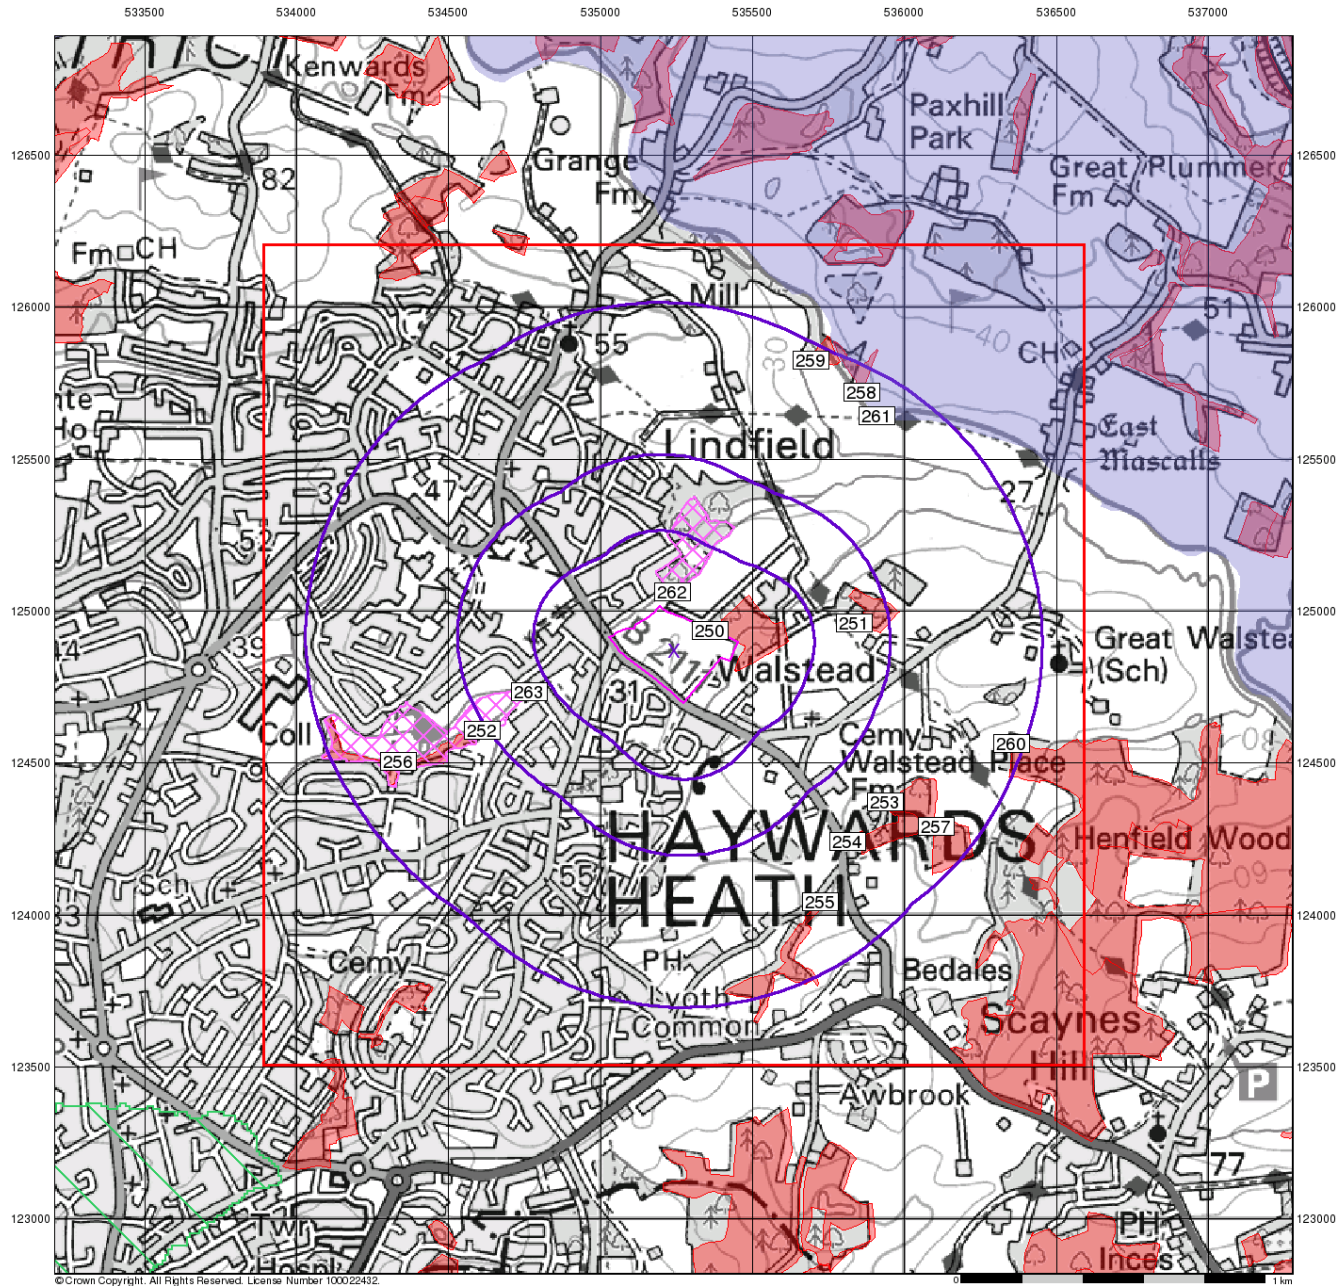

© Crown Copyright. All Rights Reserved. License Number 100022432

Envirocheck®

LANDMARK INFORMATION GROUP®

Sensitive Land Uses


General

- Specified Site
- Specified Buffer(s)
- Bearing Reference Point
- Slice
- Map ID

Sensitive Land Uses

- Ancient Woodland
- Area of Adopted Green Belt
- Area of Unadopted Green Belt
- Area of Outstanding Natural Beauty
- Environmentally Sensitive Area
- Forest Park
- Local Nature Reserve
- Marine Nature Reserve
- National Nature Reserve
- National Park
- Nitrate Sensitive Area
- Nitrate Vulnerable Zone
- Ramsar Site
- Site of Special Scientific Interest
- Special Area of Conservation
- Special Protection Area
- World Heritage Sites

Site Sensitivity Context Map - Slice A

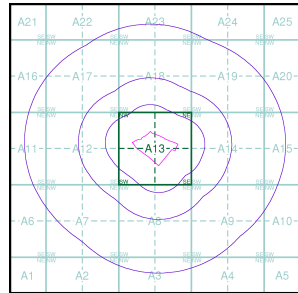

Order Details


Order Number: 334357177_1_1
Customer Ref: 6534
National Grid Reference: 535240, 124870
Slice: A
Site Area (Ha): 6.63
Search Buffer (m): 1000

Site Details

Scamps Hill, Lindfield, Haywards Heath, RH16 2GL

Landmark®
LANDMARK INFORMATION GROUP

Tel: 0844 844 9952
Fax: 0844 844 9951
Web: www.envirocheck.co.uk

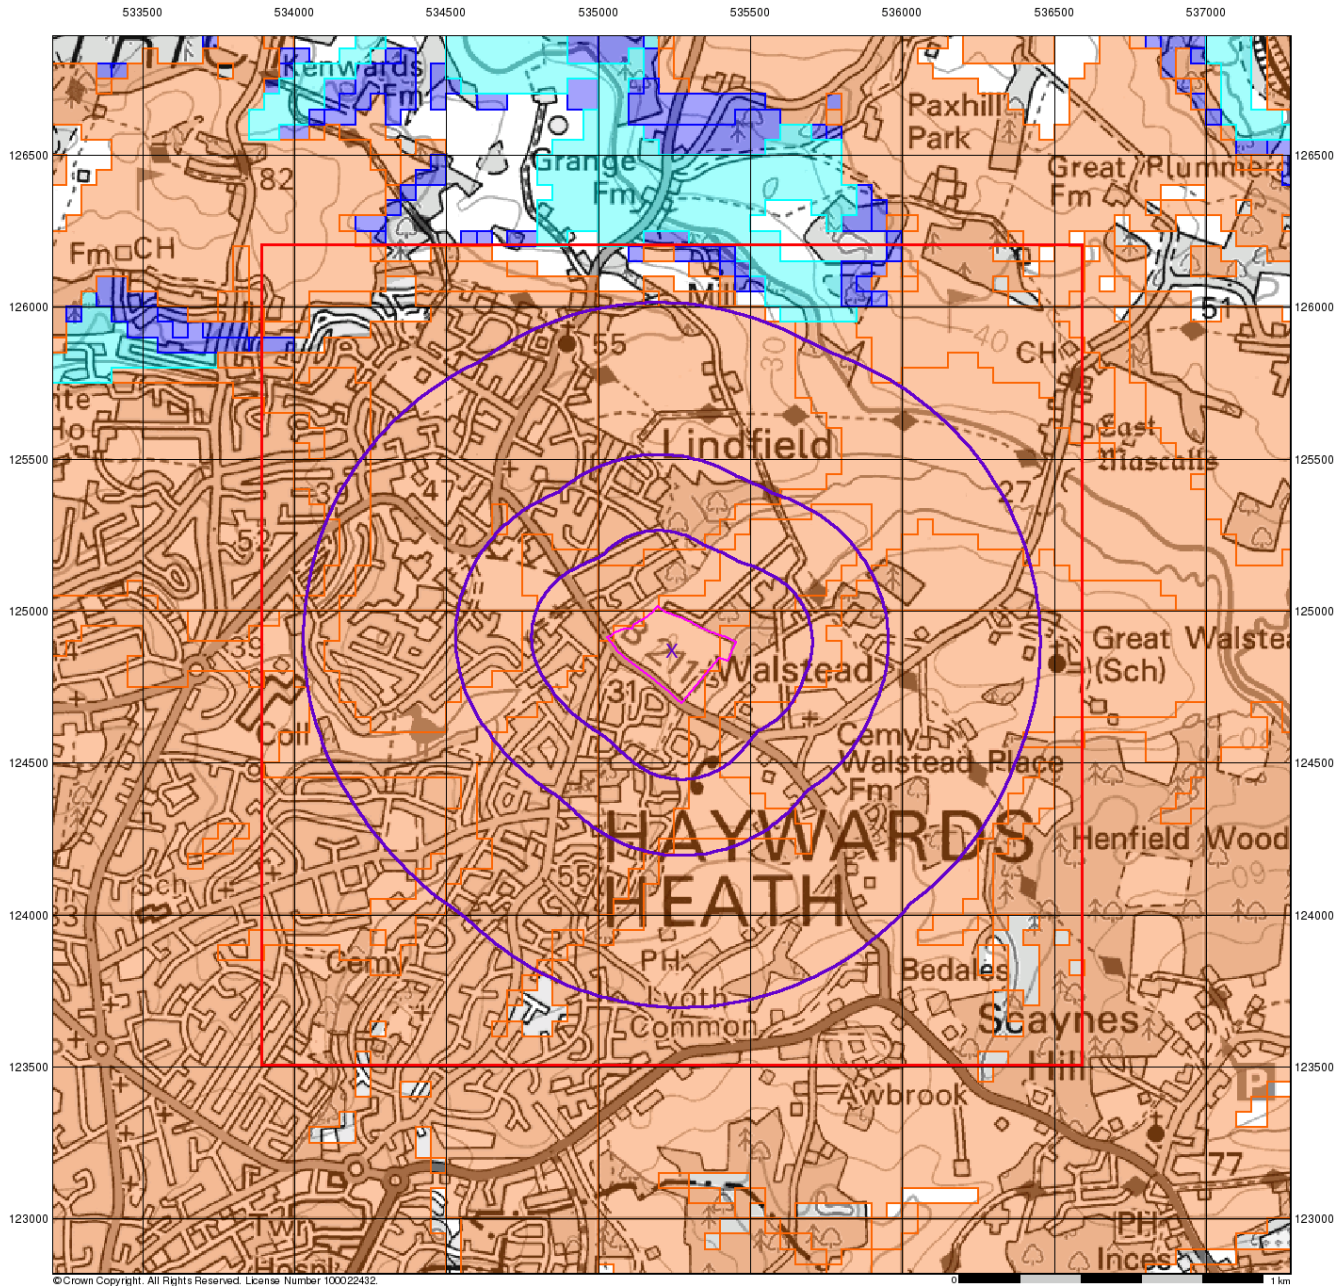

© Crown Copyright. All Rights Reserved. License Number 100022432.

Envirocheck®

LANDMARK INFORMATION GROUP®

BGS Flood GFS Data


General

- Specified Site
- Specified Buffer(s)
- Bearing Reference Point
- Slice

Agency and Hydrological (Flood)

- Limited Potential for Groundwater Flooding to Occur
- Potential for Groundwater Flooding of Property Situated Below Ground Level
- Potential for Groundwater Flooding to Occur at Surface

Site Sensitivity Context Map - Slice A

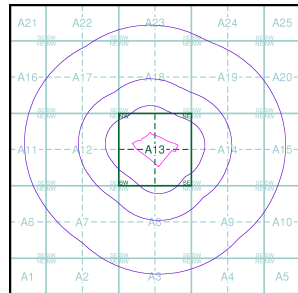

Order Details

Order Number: 334357177_1_1
Customer Ref: 6534
National Grid Reference: 535240, 124870
Slice: A
Site Area (Ha): 6.63
Search Buffer (m): 1000

Site Details

Scamps Hill, Lindfield, Haywards Heath, RH16 2GL

Landmark®
LANDMARK INFORMATION GROUP

Tel: 0844 844 9952
Fax: 0844 844 9951
Web: www.envirocheck.co.uk

Envirocheck[®] Report:

Datasheet

Order Details:

Order Number:

334357177_1_1

Customer Reference:

6534

National Grid Reference:

535240, 124870

Slice:

A

Site Area (Ha):

6.63

Search Buffer (m):

1000

Site Details:

Scamps Hill

Lindfield

Haywards Heath

RH16 2GL

Client Details:

Mr J Lees

Lees Roxburgh Ltd

The Genesis Centre

Science Park South, Birchwood

Warrington

WA3 7BH

Report Section	Page Number
Summary	-
Agency & Hydrological	1
Waste	36
Hazardous Substances	-
Geological	38
Industrial Land Use	44
Sensitive Land Use	50
Data Currency	52
Data Suppliers	58
Useful Contacts	59

Introduction

The Environment Act 1995 has made site sensitivity a key issue, as the legislation pays as much attention to the pathways by which contamination could spread, and to the vulnerable targets of contamination, as it does the potential sources of contamination. For this reason, Landmark's Site Sensitivity maps and Datasheet(s) place great emphasis on statutory data provided by the Environment Agency/Natural Resources Wales and the Scottish Environment Protection Agency; it also incorporates data from Natural England (and the Scottish and Welsh equivalents) and Local Authorities; and highlights hydrogeological features required by environmental and geotechnical consultants. It does not include any information concerning past uses of land. The datasheet is produced by querying the Landmark database to a distance defined by the client from a site boundary provided by the client. In this datasheet the National Grid References (NGRs) are rounded to the nearest 10m in accordance with Landmark's agreements with a number of Data Suppliers.

Copyright Notice

© Landmark Information Group Limited 2024. The Copyright on the information and data and its format as contained in this Envirocheck® Report ("Report") is the property of Landmark Information Group Limited ("Landmark") and several other Data Providers, including (but not limited to) Ordnance Survey, British Geological Survey, the Environment Agency/Natural Resources Wales and Natural England, and must not be reproduced in whole or in part by photocopying or any other method. The Report is supplied under Landmark's Terms and Conditions accepted by the Customer. A copy of Landmark's Terms and Conditions can be found with the Index Map for this report. Additional copies of the Report may be obtained from Landmark, subject to Landmark's charges in force from time to time. The Copyright, design rights and any other intellectual rights shall remain the exclusive property of Landmark and /or other Data providers, whose Copyright material has been included in this Report. © Environment Agency & United Kingdom Research and Innovation 2024. © Natural Resources Wales & United Kingdom Research and Innovation 2024.

Natural England Copyright Notice

Site of Special Scientific Interest, National Nature Reserve, Ramsar, Special Protection Area, Special Conservation Area, Marine Nature Reserve data (derived from Ordnance Survey 1:10000 raster) is provided by, and used with the permission of, Natural England who retain the copyright and Intellectual Property Rights for the data.

Scottish Natural Heritage Copyright

Contains SNH information licensed under the Open Government Licence v3.0.

Ove Arup Copyright Notice

The Mining Instability data was obtained on licence from Ove Arup & Partners Limited (for further information, contact mining.review@arup.com). No reproduction or further use of such Data is to be made without the prior written consent of Ove Arup & Partners Limited. The supplied Mining Instability data is derived from publicly available records and other third party sources and neither Ove Arup & Partners nor Landmark warrant the accuracy or completeness of such information or data.

Stantec Copyright Notice

The cavity data presented has been extracted from the PBA (now Stantec UK Ltd) enhanced version of the original DEFRA national cavity databases. Stantec UK Ltd retain the copyright & intellectual property rights in the data. Whilst all reasonable efforts are made to check that the information contained in the cavity databases is accurate we do not warrant that the data is complete or error free. The information is based upon our own researches and those collated from a number of external sources and is continually being augmented and updated by Stantec UK Ltd. In no event shall Stantec UK Ltd or Landmark be liable for any loss or damage including, without limitation, indirect or consequential loss or damage arising from the use of this data.

Radon Potential dataset Copyright Notice

Information supplied from a joint dataset compiled by The British Geological Survey and Public Health England.

Natural Resources Wales Copyright Notice

Contains Natural Resources Wales information © Natural Resources Wales and Database Right. All rights Reserved. Contains Ordnance Survey Data. Ordnance Survey Licence number 100019741. Crown Copyright and Database Right. Contains Natural Resources Wales information © Natural Resources Wales and Database Right. All rights Reserved. Some features of this information are based on digital spatial data licensed from the Centre for Ecology & Hydrology © NERC (CEH). Defra, Met Office and DARD Rivers Agency © Crown copyright. © Cranfield University. © James Hutton Institute. Contains OS data © Crown copyright and database right 2024. Land & Property Services © Crown copyright and database right.

Report Version v53.0

Data Type	Page Number	On Site	0 to 250m	251 to 500m	501 to 1000m (*up to 2000m)
Agency & Hydrological					
BGS Groundwater Flooding Susceptibility	pg 1	Yes	Yes	Yes	n/a
Contaminated Land Register Entries and Notices					
Discharge Consents	pg 1		15	13	26
Prosecutions Relating to Controlled Waters			n/a	n/a	n/a
Enforcement and Prohibition Notices					
Integrated Pollution Controls					
Integrated Pollution Prevention And Control					
Local Authority Integrated Pollution Prevention And Control					
Local Authority Pollution Prevention and Controls	pg 15			1	
Local Authority Pollution Prevention and Control Enforcements					
Nearest Surface Water Feature	pg 15		Yes		
Pollution Incidents to Controlled Waters	pg 15		2	2	3
Prosecutions Relating to Authorised Processes					
Registered Radioactive Substances					
River Quality	pg 16				1
River Quality Biology Sampling Points					
Substantiated Pollution Incident Register					
River Quality Chemistry Sampling Points					
Water Abstractions	pg 16				1 (*2)
Water Industry Act Referrals					
Groundwater Vulnerability Map	pg 17	Yes	n/a	n/a	n/a
Groundwater Vulnerability - Soluble Rock Risk			n/a	n/a	n/a
Groundwater Vulnerability - Local Information			n/a	n/a	n/a
Bedrock Aquifer Designations	pg 18	Yes	n/a	n/a	n/a
Superficial Aquifer Designations	pg 18	Yes	n/a	n/a	n/a
Source Protection Zones					
Extreme Flooding from Rivers or Sea without Defences	pg 18		Yes	n/a	n/a
Flooding from Rivers or Sea without Defences	pg 18		Yes	n/a	n/a
Areas Benefiting from Flood Defences				n/a	n/a
Flood Water Storage Areas				n/a	n/a
Flood Defences	pg 19		Yes	n/a	n/a
OS Water Network Lines	pg 19		29	30	84

Data Type	Page Number	On Site	0 to 250m	251 to 500m	501 to 1000m (*up to 2000m)
Waste					
BGS Recorded Landfill Sites	pg 36		1		
Historical Landfill Sites	pg 36		1		
Integrated Pollution Control Registered Waste Sites					
Licensed Waste Management Facilities (Landfill Boundaries)					
Licensed Waste Management Facilities (Locations)					
Local Authority Landfill Coverage	pg 36	2	n/a	n/a	n/a
Local Authority Recorded Landfill Sites	pg 36		2		
Potentially Infilled Land (Non-Water)	pg 36				1
Potentially Infilled Land (Water)	pg 36		1	1	10
Registered Landfill Sites					
Registered Waste Transfer Sites					
Registered Waste Treatment or Disposal Sites					
Hazardous Substances					
Control of Major Accident Hazards Sites (COMAH)					
Explosive Sites					
Notification of Installations Handling Hazardous Substances (NIHHS)					
Planning Hazardous Substance Consents					
Planning Hazardous Substance Enforcements					

Data Type	Page Number	On Site	0 to 250m	251 to 500m	501 to 1000m (*up to 2000m)
Geological					
BGS 1:625,000 Solid Geology	pg 38	Yes	n/a	n/a	n/a
BGS Estimated Soil Chemistry	pg 38	Yes	Yes		Yes
BGS Recorded Mineral Sites	pg 38			3	7
BGS Urban Soil Chemistry					
BGS Urban Soil Chemistry Averages					
CBSCB Compensation District			n/a	n/a	n/a
Coal Mining Affected Areas			n/a	n/a	n/a
Mining Instability	pg 40	Yes	n/a	n/a	n/a
Man-Made Mining Cavities					
Natural Cavities					
Non Coal Mining Areas of Great Britain				n/a	n/a
Potential for Collapsible Ground Stability Hazards	pg 40	Yes	Yes	n/a	n/a
Potential for Compressible Ground Stability Hazards	pg 41	Yes	Yes	n/a	n/a
Potential for Ground Dissolution Stability Hazards				n/a	n/a
Potential for Landslide Ground Stability Hazards	pg 41	Yes	Yes	n/a	n/a
Potential for Running Sand Ground Stability Hazards	pg 42	Yes	Yes	n/a	n/a
Potential for Shrinking or Swelling Clay Ground Stability Hazards	pg 42	Yes	Yes	n/a	n/a
Radon Potential - Radon Affected Areas			n/a	n/a	n/a
Radon Potential - Radon Protection Measures			n/a	n/a	n/a
Industrial Land Use					
Contemporary Trade Directory Entries	pg 44		12	5	10
Fuel Station Entries	pg 46			1	
Points of Interest - Commercial Services	pg 46		1	5	3
Points of Interest - Education and Health					
Points of Interest - Manufacturing and Production	pg 47		1	1	
Points of Interest - Public Infrastructure	pg 47		1	5	4
Points of Interest - Recreational and Environmental	pg 48		1	2	9
Gas Pipelines					
Underground Electrical Cables					

Data Type	Page Number	On Site	0 to 250m	251 to 500m	501 to 1000m (*up to 2000m)
Sensitive Land Use					
Ancient Woodland	pg 50	1		1	9
Areas of Adopted Green Belt					
Areas of Unadopted Green Belt					
Areas of Outstanding Natural Beauty	pg 50				1
Environmentally Sensitive Areas					
Forest Parks					
Local Nature Reserves	pg 50		1	1	
Marine Nature Reserves					
National Nature Reserves					
National Parks					
Nitrate Sensitive Areas					
Nitrate Vulnerable Zones					
Ramsar Sites					
Sites of Special Scientific Interest					
Special Areas of Conservation					
Special Protection Areas					
World Heritage Sites					

Map ID	Details	Quadrant Reference (Compass Direction)	Estimated Distance From Site	Contact	NGR
	BGS Groundwater Flooding Susceptibility Flooding Type: Limited Potential for Groundwater Flooding to Occur	A13NE (N)	0	1	535243 125000
	BGS Groundwater Flooding Susceptibility Flooding Type: Limited Potential for Groundwater Flooding to Occur	A13NE (NE)	0	1	535243 124869
	BGS Groundwater Flooding Susceptibility Flooding Type: Limited Potential for Groundwater Flooding to Occur	A13NW (N)	0	1	535200 125000
	BGS Groundwater Flooding Susceptibility Flooding Type: Limited Potential for Groundwater Flooding to Occur	A13SE (SE)	0	1	535350 124800
	BGS Groundwater Flooding Susceptibility Flooding Type: Limited Potential for Groundwater Flooding to Occur	A13NW (NW)	0	1	535150 124950
	BGS Groundwater Flooding Susceptibility Flooding Type: Limited Potential for Groundwater Flooding to Occur	A13NW (W)	30	1	535000 124869
	BGS Groundwater Flooding Susceptibility Flooding Type: Limited Potential for Groundwater Flooding to Occur	A13SW (W)	61	1	535000 124850
	BGS Groundwater Flooding Susceptibility Flooding Type: Limited Potential for Groundwater Flooding to Occur	A13NW (NW)	91	1	535000 125000
	BGS Groundwater Flooding Susceptibility Flooding Type: Limited Potential for Groundwater Flooding to Occur	A13SE (SE)	127	1	535450 124700
	BGS Groundwater Flooding Susceptibility Flooding Type: Limited Potential for Groundwater Flooding to Occur	A13NW (N)	143	1	535150 125150
	BGS Groundwater Flooding Susceptibility Flooding Type: Limited Potential for Groundwater Flooding to Occur	A18SW (NW)	245	1	535000 125200
	BGS Groundwater Flooding Susceptibility Flooding Type: Limited Potential for Groundwater Flooding to Occur	A12NE (W)	280	1	534750 124869
	BGS Groundwater Flooding Susceptibility Flooding Type: Limited Potential for Groundwater Flooding to Occur	A14NW (E)	362	1	535800 125000
	BGS Groundwater Flooding Susceptibility Flooding Type: Limited Potential for Groundwater Flooding to Occur	A8NE (S)	447	1	535243 124250
	BGS Groundwater Flooding Susceptibility Flooding Type: Limited Potential for Groundwater Flooding to Occur	A17SE (NW)	471	1	534700 125250
1	Discharge Consents Operator: Southern Water Services Limited Property Type: PUMPING STATION ON SEWERAGE NETWORK (WATER COMPANY) Location: Lewes Road Lindfield Wps Lewes Road Wps, Lewes Road, Lindfield, East Sussex, RH16 2In Authority: Environment Agency, Southern Region Catchment Area: Ouse Reference: A01271 Permit Version: 1 Effective Date: 14th September 2007 Issued Date: 14th September 2007 Revocation Date: Not Supplied Discharge Type: Sewage Discharges - Pumping Station - Water Company Discharge: Freshwater Stream/River Environment: Receiving Water: Scrase Stream Status: New Consent (Water Resources Act 1991, Section 88 & Schedule 10 as amended by Environment Act 1995) Positional Accuracy: Located by supplier to within 10m	A13NW (W)	21	2	535010 124920

Map ID	Details	Quadrant Reference (Compass Direction)	Estimated Distance From Site	Contact	NGR
2	Discharge Consents Operator: Southern Water Services Limited Property Type: PUMPING STATION ON SEWERAGE NETWORK (WATER COMPANY) Location: Noahs Ark Lane Wps Rear 18 Noahs Ark Lane, Lindfield, Haywards Heath, West Sussex, Rh16 2lt Authority: Environment Agency, Southern Region Catchment Area: Ouse Reference: A01497 Permit Version: 1 Effective Date: 21st September 2007 Issued Date: 21st September 2007 Revocation Date: Not Supplied Discharge Type: Sewage Discharges - Pumping Station - Water Company Discharge: Freshwater Stream/River Environment: Receiving Water: Scrase Stream Status: New Consent (Water Resources Act 1991, Section 88 & Schedule 10 as amended by Environment Act 1995) Positional Accuracy: Located by supplier to within 10m	A13NW (NW)	23	2	535170 125020
2	Discharge Consents Operator: Southern Water Services Limited Property Type: STORM TANK/CSO ON SEWERAGE NETWORK (WATER COMPANY) Location: Noahs Ark Lane Ps, Linfield, Sussex Authority: Environment Agency, Southern Region Catchment Area: Not Supplied Reference: A01084 Permit Version: 2 Effective Date: 20th August 2001 Issued Date: 20th August 2001 Revocation Date: Not Supplied Discharge Type: Public Sewage: Storm Sewage Overflow Discharge: Freshwater Stream/River Environment: Receiving Water: Freshwater River Status: Pre National Rivers Authority Legislation where issue date < 01/09/1989 Positional Accuracy: Located by supplier to within 10m	A13NW (NW)	30	2	535170 125030
2	Discharge Consents Operator: Southern Water Services Limited Property Type: STORM TANK/CSO ON SEWERAGE NETWORK (WATER COMPANY) Location: Noahs Ark Lane Ps, Linfield, Sussex Authority: Environment Agency, Southern Region Catchment Area: Not Supplied Reference: A01084 Permit Version: 1 Effective Date: 26th July 2001 Issued Date: 26th July 2001 Revocation Date: 20th August 2001 Discharge Type: Public Sewage: Storm Sewage Overflow Discharge: Freshwater Stream/River Environment: Receiving Water: Freshwater River Status: Pre National Rivers Authority Legislation where issue date < 01/09/1989 Positional Accuracy: Located by supplier to within 10m	A13NW (NW)	30	2	535170 125030
3	Discharge Consents Operator: Southern Water Services Limited Property Type: STORM TANK/CSO ON SEWERAGE NETWORK (WATER COMPANY) Location: Lewes Road Lindfield, Lewes Road, Lindfield, West Sussex Authority: Environment Agency, Southern Region Catchment Area: Not Given Reference: W00410 Permit Version: 1 Effective Date: 6th October 1981 Issued Date: 6th October 1981 Revocation Date: 14th February 2001 Discharge Type: Public Sewage: Storm Sewage Overflow Discharge: Freshwater Stream/River Environment: Receiving Water: Freshwater River Status: Revoked (Water Resources Act 1991, Section 88 & Schedule 10 as amended by Environment Act 1995) Positional Accuracy: Located by supplier to within 10m	A13NW (N)	45	2	535200 125060

Map ID	Details	Quadrant Reference (Compass Direction)	Estimated Distance From Site	Contact	NGR
3	Discharge Consents Operator: Southern Water Services Limited Property Type: STORM TANK/CSO ON SEWERAGE NETWORK (WATER COMPANY) Location: Lewes Road Lindfield, Lewes Road, Lindfield, West Sussex Authority: Environment Agency, Southern Region Catchment Area: Not Given Reference: W00410 Permit Version: 1 Effective Date: 6th October 1981 Issued Date: 6th October 1981 Revocation Date: 14th February 2001 Discharge Type: Discharge Of Other Matter-Surface Water Discharge: Freshwater Stream/River Environment: Receiving Water: Freshwater River Status: Revoked (Water Resources Act 1991, Section 88 & Schedule 10 as amended by Environment Act 1995) Positional Accuracy: Located by supplier to within 100m	A13NW (N)	51	2	535220 125060
4	Discharge Consents Operator: Algrey Homes Ltd. Property Type: Undefined Or Other Location: Dev. At Junction Of Grevelye Lan, And Lewes Road, Lindfield West Sussex Authority: Environment Agency, Southern Region Catchment Area: Not Given Reference: S01637 Permit Version: 1 Effective Date: 5th October 1967 Issued Date: 5th October 1967 Revocation Date: 31st March 1997 Discharge Type: Discharge Of Other Matter-Surface Water Discharge: Freshwater Stream/River Environment: Receiving Water: Freshwater River Status: Lapsed (under Environment Act 1995, Schedule 23) Positional Accuracy: Located by supplier to within 100m	A13NW (W)	82	2	534960 124870
4	Discharge Consents Operator: Algrey Properties Property Type: Undefined Or Other Location: Meadow Lane, Lindfield Sussex Authority: Environment Agency, Southern Region Catchment Area: Not Supplied Reference: S01385 Permit Version: 1 Effective Date: 30th July 1965 Issued Date: 30th July 1965 Revocation Date: 11th March 1994 Discharge Type: Discharge Of Other Matter-Surface Water Discharge: Freshwater Stream/River Environment: Receiving Water: Freshwater River Status: Pre National Rivers Authority Legislation where issue date < 01/09/1989 Positional Accuracy: Located by supplier to within 10m	A13NW (W)	87	2	534950 124880
4	Discharge Consents Operator: Algrey Properties Property Type: Undefined Or Other Location: Meadow Lane, Lindfield Sussex Authority: Environment Agency, Southern Region Catchment Area: Not Supplied Reference: S01385 Permit Version: 1 Effective Date: 30th July 1965 Issued Date: 30th July 1965 Revocation Date: 11th March 1994 Discharge Type: Discharge Of Other Matter-Surface Water Discharge: Freshwater Stream/River Environment: Receiving Water: Freshwater River Status: Pre National Rivers Authority Legislation where issue date < 01/09/1989 Positional Accuracy: Located by supplier to within 10m	A13SW (W)	130	2	534930 124830

Map ID	Details	Quadrant Reference (Compass Direction)	Estimated Distance From Site	Contact	NGR
5	Discharge Consents Operator: James Heagerty Esq Property Type: DOMESTIC PROPERTY (SINGLE) (INCL FARM HOUSE) Location: Service Cottage, Walstead Grange, Lindfield Authority: Environment Agency, Southern Region Catchment Area: Not Supplied Reference: S02597 Permit Version: 1 Effective Date: 15th March 1968 Issued Date: 15th March 1968 Revocation Date: 1st July 1991 Discharge Type: Discharge Of Other Matter-Surface Water Discharge: Freshwater Stream/River Environment: Receiving Water: Freshwater River Status: Pre National Rivers Authority Legislation where issue date < 01/09/1989 Positional Accuracy: Located by supplier to within 100m	A13SE (SE)	95	2	535400 124700
6	Discharge Consents Operator: Gary Marshall Property Type: DOMESTIC PROPERTY (SINGLE) (INCL FARM HOUSE) Location: Frenshams Scaynes Hill Rd Walstead Frenshams, Scaynes Hill Road, Walstead, West Sussex, Rh16 2qg Authority: Environment Agency, Southern Region Catchment Area: Ouse Reference: P13043 Permit Version: 1 Effective Date: 25th May 2007 Issued Date: 25th May 2007 Revocation Date: Not Supplied Discharge Type: Sewage Discharges - Final/Treated Effluent - Not Water Company Discharge: Freshwater Stream/River Environment: Receiving Water: Highway Drain To Trib Rvr Ouse Status: New Consent (Water Resources Act 1991, Section 88 & Schedule 10 as amended by Environment Act 1995) Positional Accuracy: Located by supplier to within 10m	A13NE (E)	104	2	535550 124860
7	Discharge Consents Operator: Mitchell Yuill Property Type: Undefined Or Other Location: Meadow Drive, Lindfield Sussex Authority: Environment Agency, Southern Region Catchment Area: Not Supplied Reference: N02131 Permit Version: 1 Effective Date: 15th May 1974 Issued Date: 15th May 1974 Revocation Date: 3rd March 1994 Discharge Type: Discharge Of Other Matter-Surface Water Discharge: Freshwater Stream/River Environment: Receiving Water: Freshwater River Status: Pre National Rivers Authority Legislation where issue date < 01/09/1989 Positional Accuracy: Located by supplier to within 10m	A13SW (W)	138	2	534920 124830
8	Discharge Consents Operator: Mr J R Filmer Property Type: DOMESTIC PROPERTY (SINGLE) (INCL FARM HOUSE) Location: Little Walstead Farm, H. Heath Little Walstead Farm, East Mascalls Lane, Haywards Heath, West Sussex, Rh16 2qj Authority: Environment Agency, Southern Region Catchment Area: Ouse Reference: P12605 Permit Version: 1 Effective Date: 17th March 2006 Issued Date: 17th March 2006 Revocation Date: Not Supplied Discharge Type: Sewage Discharges - Final/Treated Effluent - Not Water Company Discharge: Freshwater Stream/River Environment: Receiving Water: Tributary Of River Ouse Status: New Consent (Water Resources Act 1991, Section 88 & Schedule 10 as amended by Environment Act 1995) Positional Accuracy: Located by supplier to within 10m	A14NW (E)	218	2	535650 124990

Map ID	Details	Quadrant Reference (Compass Direction)	Estimated Distance From Site	Contact	NGR
8	Discharge Consents Operator: J R Filmer Esq. Property Type: Undefined Or Other Location: Little Walstead Farm, East Mascalls Lane, Lindfield, Haywards Heath, West Sussex, RH16 2qj Authority: Environment Agency, Southern Region Catchment Area: Not Given Reference: D01050 Permit Version: 1 Effective Date: 27th May 1963 Issued Date: 27th May 1963 Revocation Date: 30th November 2005 Discharge Type: Unknown Discharge: Freshwater Stream/River Environment: Freshwater River Receiving Water: Freshwater River Status: Application refused - 1961 Rivers (Prevention of Pollution) Act Positional Accuracy: Located by supplier to within 10m	A14NW (E)	241	2	535670 125000
9	Discharge Consents Operator: Southern Water Services Limited Property Type: CONSTRUCTION OF BUILDINGS Location: Newton Road Housing Site, Lindfield West Sussex Authority: Environment Agency, Southern Region Catchment Area: Not Given Reference: S01488 Permit Version: 1 Effective Date: 13th May 1966 Issued Date: 13th May 1966 Revocation Date: 4th September 1997 Discharge Type: Discharge Of Other Matter-Surface Water Discharge: Freshwater Stream/River Environment: Freshwater River Receiving Water: Freshwater River Status: Pre National Rivers Authority Legislation where issue date < 01/09/1989 Positional Accuracy: Located by supplier to within 100m	A13NE (N)	221	2	535360 125180
10	Discharge Consents Operator: The Occupier Property Type: DOMESTIC PROPERTY (MULTIPLE) (INCL FARM HOUSES) Location: Gravelye Farm Housing Estate, Roundwood Lane, Lindfield Sussex Authority: Environment Agency, Southern Region Catchment Area: Not Given Reference: S01364 Permit Version: 1 Effective Date: 9th November 1956 Issued Date: 9th November 1956 Revocation Date: 31st March 1997 Discharge Type: Discharge Of Other Matter-Surface Water Discharge: Freshwater Stream/River Environment: Freshwater River Receiving Water: Freshwater River Status: Lapsed (under Environment Act 1995, Schedule 23) Positional Accuracy: Located by supplier to within 100m	A12SE (W)	282	2	534800 124750
10	Discharge Consents Operator: Messrs Wardroper Estates Ltd. Property Type: Undefined Or Other Location: Road & Land At Gravelye Estate, Lindfield, East Sussex Authority: Environment Agency, Southern Region Catchment Area: Not Supplied Reference: S01245 Permit Version: 1 Effective Date: 10th July 1964 Issued Date: 10th July 1964 Revocation Date: 9th March 1994 Discharge Type: Discharge Of Other Matter-Surface Water Discharge: Freshwater Stream/River Environment: Freshwater River Receiving Water: Freshwater River Status: Pre National Rivers Authority Legislation where issue date < 01/09/1989 Positional Accuracy: Located by supplier to within 10m	A12SE (W)	302	2	534790 124730

Map ID	Details	Quadrant Reference (Compass Direction)	Estimated Distance From Site	Contact	NGR
11	Discharge Consents Operator: Southern Water Services Limited Property Type: Undefined Or Other Location: Lindfield Nurseries, Lewes Road, , Lindfield, Sussex Authority: Environment Agency, Southern Region Catchment Area: Not Given Reference: S02097 Permit Version: 1 Effective Date: 8th June 1972 Issued Date: 8th June 1972 Revocation Date: 19th March 1996 Discharge Type: Sewage Discharges - Unspecified - Water Company Discharge: Freshwater Stream/River Environment: Receiving Water: Freshwater River Status: Pre National Rivers Authority Legislation where issue date < 01/09/1989 Positional Accuracy: Located by supplier to within 100m	A18SE (N)	351	2	535350 125330
11	Discharge Consents Operator: Southern Water Services Limited Property Type: Undefined Or Other Location: Lindfield Nurseries, Lewes Road, , Lindfield, Sussex Authority: Environment Agency, Southern Region Catchment Area: Not Given Reference: S02097 Permit Version: 1 Effective Date: 8th June 1972 Issued Date: 8th June 1972 Revocation Date: 19th March 1996 Discharge Type: Unknown Discharge: Freshwater Stream/River Environment: Receiving Water: Freshwater River Status: Pre National Rivers Authority Legislation where issue date < 01/09/1989 Positional Accuracy: Located by supplier to within 100m	A18SE (N)	378	2	535390 125340
12	Discharge Consents Operator: The Occupier Property Type: DOMESTIC PROPERTY (MULTIPLE) (INCL FARM HOUSES) Location: Gravelye Farm Housing Estate, Roundwood Lane, Lindfield Sussex Authority: Environment Agency, Southern Region Catchment Area: Not Given Reference: S01364 Permit Version: 1 Effective Date: 9th November 1956 Issued Date: 9th November 1956 Revocation Date: 31st March 1997 Discharge Type: Discharge Of Other Matter-Surface Water Discharge: Freshwater Stream/River Environment: Receiving Water: Freshwater River Status: Lapsed (under Environment Act 1995, Schedule 23) Positional Accuracy: Located by supplier to within 100m	A12SE (W)	388	2	534720 124680
12	Discharge Consents Operator: Messrs Wardroper Estates Ltd. Property Type: Undefined Or Other Location: Road & Land At Gravelye Estate, Lindfield, East Sussex Authority: Environment Agency, Southern Region Catchment Area: Not Supplied Reference: S01245 Permit Version: 1 Effective Date: 10th July 1964 Issued Date: 10th July 1964 Revocation Date: 9th March 1994 Discharge Type: Discharge Of Other Matter-Surface Water Discharge: Freshwater Stream/River Environment: Receiving Water: Freshwater River Status: Pre National Rivers Authority Legislation where issue date < 01/09/1989 Positional Accuracy: Located by supplier to within 10m	A12SE (W)	394	2	534720 124670

Map ID	Details	Quadrant Reference (Compass Direction)	Estimated Distance From Site	Contact	NGR
13	Discharge Consents Operator: Mr C J Mills Property Type: DOMESTIC PROPERTY (SINGLE) (INCL FARM HOUSE) Location: Snowflakes Cottages, Walstead Snowflakes Cottages 1,2,& 3, East Mascalls Road, Walstead, Haywards Heath, West Sussex, Rh16 2qj Authority: Environment Agency, Southern Region Catchment Area: Ouse Reference: P11771 Permit Version: 1 Effective Date: 17th July 2003 Issued Date: 17th July 2003 Revocation Date: Not Supplied Discharge Type: Sewage Discharges - Final/Treated Effluent - Not Water Company Discharge: Freshwater Stream/River Environment: Receiving Water: Unnamed Trib.River Ouse Status: New Consent (Water Resources Act 1991, Section 88 & Schedule 10 as amended by Environment Act 1995) Positional Accuracy: Located by supplier to within 10m	A14NW (E)	409	2	535860 124930
13	Discharge Consents Operator: D Pickett & R Ashworth Property Type: DOMESTIC PROPERTY (SINGLE) (INCL FARM HOUSE) Location: Snowflakes Cottages, Walstead Snowflakes Cottages 1,2,& 3, East Mascalls Road, Walstead, Haywards Heath, West Sussex, Rh16 2qj Authority: Environment Agency, Southern Region Catchment Area: Ouse Reference: P11771 Permit Version: 1 Effective Date: 17th July 2003 Issued Date: 17th July 2003 Revocation Date: Not Supplied Discharge Type: Sewage Discharges - Final/Treated Effluent - Not Water Company Discharge: Freshwater Stream/River Environment: Receiving Water: Unnamed Trib.River Ouse Status: New Consent (Water Resources Act 1991, Section 88 & Schedule 10 as amended by Environment Act 1995) Positional Accuracy: Located by supplier to within 10m	A14NW (E)	409	2	535860 124930
13	Discharge Consents Operator: Mr S Hurlle Property Type: DOMESTIC PROPERTY (SINGLE) (INCL FARM HOUSE) Location: Snowflakes Cottages, Walstead Snowflakes Cottages 1,2,& 3, East Mascalls Road, Walstead, Haywards Heath, West Sussex, Rh16 2qj Authority: Environment Agency, Southern Region Catchment Area: Ouse Reference: P11771 Permit Version: 1 Effective Date: 17th July 2003 Issued Date: 17th July 2003 Revocation Date: Not Supplied Discharge Type: Sewage Discharges - Final/Treated Effluent - Not Water Company Discharge: Freshwater Stream/River Environment: Receiving Water: Unnamed Trib.River Ouse Status: New Consent (Water Resources Act 1991, Section 88 & Schedule 10 as amended by Environment Act 1995) Positional Accuracy: Located by supplier to within 10m	A14NW (E)	409	2	535860 124930
14	Discharge Consents Operator: Southern Water Services Limited Property Type: PUMPING STATION ON SEWERAGE NETWORK (WATER COMPANY) Location: Sewage Pumping Station, Lewes Road, Lindfield, West Sussex Authority: Environment Agency, Southern Region Catchment Area: Not Supplied Reference: S02066 Permit Version: 1 Effective Date: 30th December 1971 Issued Date: 30th December 1971 Revocation Date: 1st July 1991 Discharge Type: Public Sewage: Storm Sewage Overflow Discharge: Freshwater Stream/River Environment: Receiving Water: Freshwater River Status: Pre National Rivers Authority Legislation where issue date < 01/09/1989 Positional Accuracy: Located by supplier to within 10m	A18SE (NE)	411	2	535510 125320

Map ID	Details	Quadrant Reference (Compass Direction)	Estimated Distance From Site	Contact	NGR
14	Discharge Consents Operator: Southern Water Services Limited Property Type: FARMS (NOT HOUSE)/CROP + ANIMAL REARING/PLANT NURSERY Location: Site Of Lindfield Nurseries, Noah'S Ark Lane, Lindfield, Sussex Authority: Environment Agency, Southern Region Catchment Area: Not Given Reference: S02069 Permit Version: 1 Effective Date: 1st April 1991 Issued Date: 1st April 1991 Revocation Date: Not Supplied Discharge Type: Discharge Of Other Matter-Surface Water Discharge: Freshwater Stream/River Environment: Receiving Water: Freshwater River Status: Post National Rivers Authority Legislation where issue date > 31/08/1989 Positional Accuracy: Located by supplier to within 100m	A18SE (NE)	438	2	535550 125330
15	Discharge Consents Operator: Southern Water Services Limited Property Type: STORM TANK/CSO ON SEWERAGE NETWORK (WATER COMPANY) Location: William Allen Lane Cso William Allen Lane, Lindfield, Haywards Heath, West Sussex, Rh16 2se Authority: Environment Agency, Southern Region Catchment Area: Not Given Reference: W00409 Permit Version: 1 Effective Date: 6th October 1981 Issued Date: 6th October 1981 Revocation Date: 31st July 2010 Discharge Type: Public Sewage: Storm Sewage Overflow Discharge: Freshwater Stream/River Environment: Receiving Water: Freshwater River Status: Pre National Rivers Authority Legislation where issue date < 01/09/1989 Positional Accuracy: Located by supplier to within 100m	A12SE (W)	453	2	534620 124720
15	Discharge Consents Operator: Southern Water Services Limited Property Type: STORM TANK/CSO ON SEWERAGE NETWORK (WATER COMPANY) Location: William Allen Lane Cso William Allen Lane, Lindfield, Haywards Heath, West Sussex, Rh16 2se Authority: Environment Agency, Southern Region Catchment Area: Not Supplied Reference: W00409 Permit Version: 2 Effective Date: 1st August 2010 Issued Date: 19th January 2010 Revocation Date: Not Supplied Discharge Type: Public Sewage: Storm Sewage Overflow Discharge: Freshwater Stream/River Environment: Receiving Water: Scrase Stream Status: Modified (Water Resources Act 1991, Schedule 10 as amended by Environment Act 1995) Positional Accuracy: Located by supplier to within 10m	A12SE (W)	468	2	534608 124711
16	Discharge Consents Operator: Caring Homes Ltd Property Type: DENTIST/HOSPITAL/NURSING HOME (MEDICAL)/HUMAN HEALTH Location: Walstead Place Residential Home, Walstead, Lindfield, West Sussex, Rh16 2qg Authority: Environment Agency, Southern Region Catchment Area: Ouse Reference: P04820 Permit Version: 1 Effective Date: 21st May 1993 Issued Date: 21st May 1993 Revocation Date: Not Supplied Discharge Type: Sewage Discharges - Final/Treated Effluent - Not Water Company Discharge: Freshwater Stream/River Environment: Receiving Water: Freshwater Stream Or River Status: Post National Rivers Authority Legislation where issue date > 31/08/1989 Positional Accuracy: Located by supplier to within 100m	A9NW (SE)	533	2	535640 124310

Map ID	Details	Quadrant Reference (Compass Direction)	Estimated Distance From Site	Contact	NGR
17	Discharge Consents Operator: Southern Water Services Limited Property Type: CONSTRUCTION OF BUILDINGS Location: Development North Of Hanbury Lan, Haywards Heath, West Sussex Authority: Environment Agency, Southern Region Catchment Area: Not Given Reference: S01478 Permit Version: 1 Effective Date: 22nd April 1966 Issued Date: 22nd April 1966 Revocation Date: 4th September 1997 Discharge Type: Discharge Of Other Matter-Surface Water Discharge: Freshwater Stream/River Environment: Receiving Water: Freshwater River Status: Pre National Rivers Authority Legislation where issue date < 01/09/1989 Positional Accuracy: Located by supplier to within 100m	A12SW (W)	626	2	534500 124580
18	Discharge Consents Operator: Southern Water Services Limited Property Type: CONSTRUCTION OF BUILDINGS Location: Development North Of Hanbury Lan, Haywards Heath, West Sussex Authority: Environment Agency, Southern Region Catchment Area: Not Given Reference: S01478 Permit Version: 1 Effective Date: 22nd April 1966 Issued Date: 22nd April 1966 Revocation Date: 4th September 1997 Discharge Type: Discharge Of Other Matter-Surface Water Discharge: Freshwater Stream/River Environment: Receiving Water: Freshwater River Status: Pre National Rivers Authority Legislation where issue date < 01/09/1989 Positional Accuracy: Located by supplier to within 100m	A7NE (SW)	631	2	534630 124410
18	Discharge Consents Operator: Southern Water Services Limited Property Type: CONSTRUCTION OF BUILDINGS Location: Development North Of Hanbury Lan, Haywards Heath, West Sussex Authority: Environment Agency, Southern Region Catchment Area: Not Given Reference: S01478 Permit Version: 1 Effective Date: 22nd April 1966 Issued Date: 22nd April 1966 Revocation Date: 4th September 1997 Discharge Type: Discharge Of Other Matter-Surface Water Discharge: Freshwater Stream/River Environment: Receiving Water: Freshwater River Status: Pre National Rivers Authority Legislation where issue date < 01/09/1989 Positional Accuracy: Located by supplier to within 10m	A7NE (SW)	645	2	534600 124420
19	Discharge Consents Operator: Greenhaven Estates Limited Property Type: CONSTRUCTION OF BUILDINGS Location: Development Adj. Gravelye House, Gravelye Lane, Lindfield East Sussex Authority: Environment Agency, Southern Region Catchment Area: Not Supplied Reference: S01754 Permit Version: 1 Effective Date: 11th September 1968 Issued Date: 11th September 1968 Revocation Date: 17th March 1994 Discharge Type: Discharge Of Other Matter-Surface Water Discharge: Freshwater Stream/River Environment: Receiving Water: Freshwater River Status: Pre National Rivers Authority Legislation where issue date < 01/09/1989 Positional Accuracy: Located by supplier to within 10m	A7NE (SW)	746	2	534600 124280

Map ID	Details	Quadrant Reference (Compass Direction)	Estimated Distance From Site	Contact	NGR
19	Discharge Consents Operator: Southern Water Services Limited Property Type: WTW/WATER COLLECTION/TREATMENT/SUPPLY Location: Surface Water Sewer, East Side O, America Lane Refuse Tip, Haywards Heath, West Sussex Authority: Environment Agency, Southern Region Catchment Area: Not Given Reference: S01257 Permit Version: 1 Effective Date: 8th May 1964 Issued Date: 8th May 1964 Revocation Date: 30th September 1997 Discharge Type: Discharge Of Other Matter-Surface Water Discharge: Freshwater Stream/River Environment: Receiving Water: Freshwater River Status: Pre National Rivers Authority Legislation where issue date < 01/09/1989 Positional Accuracy: Located by supplier to within 100m	A7NE (SW)	746	2	534600 124280
19	Discharge Consents Operator: Southern Water Services Limited Property Type: Undefined Or Other Location: Household Refuse Tip, America Lane, Haywards Heath, West Sussex Authority: Environment Agency, Southern Region Catchment Area: Not Given Reference: S01329 Permit Version: 1 Effective Date: 12th May 1961 Issued Date: 12th May 1961 Revocation Date: 30th September 1997 Discharge Type: Discharge Of Other Matter-Surface Water Discharge: Freshwater Stream/River Environment: Receiving Water: Freshwater River Status: Revoked (Water Resources Act 1991, Section 88 & Schedule 10 as amended by Environment Act 1995) Positional Accuracy: Located by supplier to within 100m	A7NE (SW)	754	2	534600 124270
20	Discharge Consents Operator: Mr W W Filmer Property Type: Undefined Or Other Location: Hangmans Acre, Old Place Farm, Lindfield, Sussex Authority: Environment Agency, Southern Region Catchment Area: Not Given Reference: D01435 Permit Version: 1 Effective Date: 27th May 1963 Issued Date: 27th May 1963 Revocation Date: Not Supplied Discharge Type: Trade Discharge - Process Water Discharge: Freshwater Stream/River Environment: Receiving Water: Freshwater River Status: Pre National Rivers Authority Legislation where issue date < 01/09/1989 Positional Accuracy: Located by supplier to within 100m	A18NE (N)	768	2	535450 125740
21	Discharge Consents Operator: Hall & Woodhouse Ltd Property Type: Undefined Or Other Location: The Snowdrop P.H., Lyoth Lane, Lindfield West Sussex Authority: Environment Agency, Southern Region Catchment Area: Ouse Reference: P02706 Permit Version: 1 Effective Date: 17th January 1990 Issued Date: 17th January 1990 Revocation Date: Not Supplied Discharge Type: Sewage Discharges - Final/Treated Effluent - Not Water Company Discharge: Freshwater Stream/River Environment: Receiving Water: Freshwater Stream Or River Status: Post National Rivers Authority Legislation where issue date > 31/08/1989 Positional Accuracy: Located by supplier to within 100m	A8SE (S)	811	2	535360 123890

Map ID	Details	Quadrant Reference (Compass Direction)	Estimated Distance From Site	Contact	NGR
22	Discharge Consents Operator: Mr Bill Filmer Property Type: DOMESTIC PROPERTY (SINGLE) (INCL FARM HOUSE) Location: Hangmans Cottage Chimney Corner, Lindfield, Haywards Heath, West Sussex, Rh16 2hz Authority: Environment Agency, Southern Region Catchment Area: Not Supplied Reference: Eprsb3495db Permit Version: 1 Effective Date: 5th January 2021 Issued Date: 6th January 2021 Revocation Date: Not Supplied Discharge Type: Sewage Discharges - Final/Treated Effluent - Not Water Company Discharge: Freshwater Stream/River Environment: Receiving Water: Tributary Of The Scrase Stream Status: New issued under EPR 2010 Positional Accuracy: Located by supplier to within 10m	A18NE (N)	812	2	535520 125760
23	Discharge Consents Operator: Mr & Mrs Hotblack Property Type: DOMESTIC PROPERTY (SINGLE) (INCL FARM HOUSE) Location: Outwood, Lyoths Lane, Lindfield, Sussex, Rh16 2qa Authority: Environment Agency, Southern Region Catchment Area: Not Given Reference: P04837 Permit Version: 1 Effective Date: 19th May 1993 Issued Date: 19th May 1993 Revocation Date: Not Supplied Discharge Type: Sewage Discharges - Final/Treated Effluent - Not Water Company Discharge: Freshwater Stream/River Environment: Receiving Water: Freshwater River Status: Post National Rivers Authority Legislation where issue date > 31/08/1989 Positional Accuracy: Located by supplier to within 100m	A8SW (S)	865	2	534990 123880
24	Discharge Consents Operator: Southern Water Services Limited Property Type: STORM TANK/CSO ON SEWERAGE NETWORK (WATER COMPANY) Location: Penn Crescent Haywards Heath Outside 53 Cso, Penn Crescent, Haywards Heath, West Sussex, Rh16 3hp Authority: Environment Agency, Southern Region Catchment Area: Not Supplied Reference: A00957 Permit Version: 1 Effective Date: 1st March 2021 Issued Date: 1st March 2021 Revocation Date: Not Supplied Discharge Type: Public Sewage: Storm Sewage Overflow Discharge: Freshwater Stream/River Environment: Receiving Water: Tributary Of The Scrase Stream Status: Varied under EPR 2010 Positional Accuracy: Located by supplier to within 10m	A7NW (W)	869	2	534260 124510
25	Discharge Consents Operator: Southern Water Services Limited Property Type: Undefined Or Other Location: Hickman'S Lane, Lindfield West Sussex Authority: Environment Agency, Southern Region Catchment Area: Not Given Reference: S01331 Permit Version: 1 Effective Date: 14th July 1961 Issued Date: 14th July 1961 Revocation Date: 30th September 1997 Discharge Type: Discharge Of Other Matter-Surface Water Discharge: Freshwater Stream/River Environment: Receiving Water: Freshwater River Status: Pre National Rivers Authority Legislation where issue date < 01/09/1989 Positional Accuracy: Located by supplier to within 100m	A17SW (W)	875	2	534230 125270

Map ID	Details	Quadrant Reference (Compass Direction)	Estimated Distance From Site	Contact	NGR
26	Discharge Consents Operator: Messrs Croudace Ltd. Property Type: Undefined Or Other Location: Black Hill Estate, & Linfield Phase 2, Haywards Heath, West Sussex Authority: Environment Agency, Southern Region Catchment Area: Not Supplied Reference: S01224 Permit Version: 1 Effective Date: 12th March 1965 Issued Date: 12th March 1965 Revocation Date: 9th March 1994 Discharge Type: Discharge Of Other Matter-Surface Water Discharge: Freshwater Stream/River Environment: Receiving Water: Freshwater River Status: Pre National Rivers Authority Legislation where issue date < 01/09/1989 Positional Accuracy: Located by supplier to within 10m	A11NE (W)	881	2	534150 124960
27	Discharge Consents Operator: MR P VP SMYTH Property Type: DOMESTIC PROPERTY (SINGLE) (INCL FARM HOUSE) Location: OLD COTTAGE, LYOTH LANE, HAYWARDS HEATH, EAST SUSSEX Authority: Environment Agency, Southern Region Catchment Area: Not Supplied Reference: P07672 Permit Version: 1 Effective Date: 25th August 1999 Issued Date: 25th August 1999 Revocation Date: Not Supplied Discharge Type: Sewage Discharges - Final/Treated Effluent - Not Water Company Discharge: Freshwater Stream/River Environment: Receiving Water: Freshwater River Status: New Consent (Water Resources Act 1991, Section 88 & Schedule 10 as amended by Environment Act 1995) Positional Accuracy: Located by supplier to within 10m	A3NW (S)	903	2	535020 123830
28	Discharge Consents Operator: Roger Malcolm Developments Ltd. Property Type: CONSTRUCTION OF BUILDINGS Location: Residential Development, Off Gravelys Lane, Lindfield West Sussex Authority: Environment Agency, Southern Region Catchment Area: Not Supplied Reference: S01963 Permit Version: 1 Effective Date: 2nd April 1971 Issued Date: 2nd April 1971 Revocation Date: 25th March 1994 Discharge Type: Discharge Of Other Matter-Surface Water Discharge: Freshwater Stream/River Environment: Receiving Water: Freshwater River Status: Pre National Rivers Authority Legislation where issue date < 01/09/1989 Positional Accuracy: Located by supplier to within 10m	A7SW (SW)	907	2	534530 124130
29	Discharge Consents Operator: Mr & Mrs D Walker Property Type: DOMESTIC PROPERTY (SINGLE) (INCL FARM HOUSE) Location: Old Orchard, Lyoth Lane, Lindfield, West Sussex Authority: Environment Agency, Southern Region Catchment Area: Not Given Reference: P05461 Permit Version: 1 Effective Date: 15th August 1994 Issued Date: 15th August 1994 Revocation Date: Not Supplied Discharge Type: Sewage Discharges - Final/Treated Effluent - Not Water Company Discharge: Freshwater Stream/River Environment: Receiving Water: Freshwater River Status: Post National Rivers Authority Legislation where issue date > 31/08/1989 Positional Accuracy: Located by supplier to within 100m	A3NW (S)	932	2	535060 123790

Map ID	Details	Quadrant Reference (Compass Direction)	Estimated Distance From Site	Contact	NGR
30	Discharge Consents Operator: Southern Water Services Limited Property Type: STORM TANK/CSO ON SEWERAGE NETWORK (WATER COMPANY) Location: Rear Of 35 Pelham Road, Lindfield West Sussex Authority: Environment Agency, Southern Region Catchment Area: Not Given Reference: W00403 Permit Version: 1 Effective Date: 30th September 1982 Issued Date: 30th September 1982 Revocation Date: Not Supplied Discharge Type: Public Sewage: Storm Sewage Overflow Discharge: Freshwater Stream/River Environment: Receiving Water: Freshwater River Status: Pre National Rivers Authority Legislation where issue date < 01/09/1989 Positional Accuracy: Located by supplier to within 100m	A11SE (W)	952	2	534110 124670
31	Discharge Consents Operator: Southern Water Services Limited Property Type: STORM TANK/CSO ON SEWERAGE NETWORK (WATER COMPANY) Location: Penn Crescent Cso Haywards Heath Penn Crescent (31) Cso, Penn Crescent Haywards Heath, West Sussex, Rh16 3hw Authority: Environment Agency, Southern Region Catchment Area: Ouse Reference: A01272/S/05 Permit Version: 1 Effective Date: 24th July 2007 Issued Date: 24th July 2007 Revocation Date: 31st March 2008 Discharge Type: Public Sewage: Storm Sewage Overflow Discharge: Freshwater Stream/River Environment: Receiving Water: Scrase Stream Via Ditch Status: New Consent (Water Resources Act 1991, Section 88 & Schedule 10 as amended by Environment Act 1995) Positional Accuracy: Located by supplier to within 10m	A6NE (W)	963	2	534160 124500
31	Discharge Consents Operator: Southern Water Services Limited Property Type: STORM TANK/CSO ON SEWERAGE NETWORK (WATER COMPANY) Location: Penn Crescent Cso Haywards Heath Penn Crescent (31) Cso, Penn Crescent Haywards Heath, West Sussex, Rh16 3hw Authority: Environment Agency, Southern Region Catchment Area: Ouse Reference: A01272/S/05 Permit Version: 2 Effective Date: 1st April 2008 Issued Date: 24th July 2007 Revocation Date: Not Supplied Discharge Type: Public Sewage: Storm Sewage Overflow Discharge: Freshwater Stream/River Environment: Receiving Water: Scrase Stream Via Ditch Status: New Consent (Water Resources Act 1991, Section 88 & Schedule 10 as amended by Environment Act 1995) Positional Accuracy: Located by supplier to within 10m	A6NE (W)	963	2	534160 124500
32	Discharge Consents Operator: Mr & Mrs Slater Property Type: Undefined Or Other Location: Keepers Cottage & Hindover Ctge, East Mascalls Lane, Haywards Heath, West Sussex, Rh16 2qj Authority: Environment Agency, Southern Region Catchment Area: Ouse Reference: S00019 Permit Version: 1 Effective Date: 13th April 1982 Issued Date: 13th April 1982 Revocation Date: Not Supplied Discharge Type: Sewage Discharges - Final/Treated Effluent - Not Water Company Discharge: Freshwater Stream/River Environment: Receiving Water: Freshwater Stream Or River Status: Pre National Rivers Authority Legislation where issue date < 01/09/1989 Positional Accuracy: Located by supplier to within 100m	A15SW (E)	974	2	536370 124570

Map ID	Details	Quadrant Reference (Compass Direction)	Estimated Distance From Site	Contact	NGR
32	Discharge Consents Operator: Dr & Mrs Reader Property Type: Undefined Or Other Location: Keepers Cottage & Hindover Ctge, East Mascalls Lane, Haywards Heath, West Sussex, Rh16 2qj Authority: Environment Agency, Southern Region Catchment Area: Ouse Reference: S00019 Permit Version: 1 Effective Date: 13th April 1982 Issued Date: 13th April 1982 Revocation Date: Not Supplied Discharge Type: Sewage Discharges - Final/Treated Effluent - Not Water Company Discharge: Freshwater Stream/River Environment: Receiving Water: Freshwater Stream Or River Status: Pre National Rivers Authority Legislation where issue date < 01/09/1989 Positional Accuracy: Located by supplier to within 10m	A15SW (E)	974	2	536370 124570
33	Discharge Consents Operator: Mr Adrian White Property Type: DOMESTIC PROPERTY (SINGLE) (INCL FARM HOUSE) Location: Oak View Lyoth Lane, Lindfield, ., West Sussex, Rh16 2qa Authority: Environment Agency, Southern Region Catchment Area: Ouse Reference: Npswqd003018 Permit Version: 1 Effective Date: 15th July 2008 Issued Date: 15th July 2008 Revocation Date: Not Supplied Discharge Type: Sewage Discharges - Final/Treated Effluent - Not Water Company Discharge: Freshwater Stream/River Environment: Receiving Water: Tributary Of The River Ouse Status: New Consent (Water Resources Act 1991, Section 88 & Schedule 10 as amended by Environment Act 1995) Positional Accuracy: Located by supplier to within 10m	A3NW (S)	981	2	535118 123728
33	Discharge Consents Operator: Mrs. Darryl Griswood Property Type: DOMESTIC PROPERTY (SINGLE) (INCL FARM HOUSE) Location: Plot Adjacent To Oakview, Lyoth Lane, Lindfield, West Sussex, Rh16 2qa Authority: Environment Agency, Southern Region Catchment Area: Ouse Reference: Npswqd002275 Permit Version: 1 Effective Date: 23rd June 2008 Issued Date: 23rd June 2008 Revocation Date: Not Supplied Discharge Type: Sewage Discharges - Final/Treated Effluent - Not Water Company Discharge: Freshwater Stream/River Environment: Receiving Water: Trib Of Scrase Stream Status: New Consent (Water Resources Act 1991, Section 88 & Schedule 10 as amended by Environment Act 1995) Positional Accuracy: Located by supplier to within 10m	A3NW (S)	981	2	535118 123728
34	Discharge Consents Operator: West Sussex County Council Property Type: EDUCATION/NURSERY/SCHOOL/COLLEGE/UNI/TRAINING VENUE Location: Haywards Heath Secondary School, West Common, Haywards Heath, West Sussex Authority: Environment Agency, Southern Region Catchment Area: Not Given Reference: S02088 Permit Version: 1 Effective Date: 1st May 1972 Issued Date: 1st May 1972 Revocation Date: 31st March 1997 Discharge Type: Discharge Of Other Matter-Surface Water Discharge: Freshwater Stream/River Environment: Receiving Water: Freshwater River Status: Lapsed (under Environment Act 1995, Schedule 23) Positional Accuracy: Located by supplier to within 100m	A11SE (W)	989	2	534050 124780

Map ID	Details	Quadrant Reference (Compass Direction)	Estimated Distance From Site	Contact	NGR
34	Discharge Consents Operator: West Sussex County Council Property Type: EDUCATION/NURSERY/SCHOOL/COLLEGE/UNI/TRAINING VENUE Location: Haywards Heath Secondary School, West Common, Haywards Heath, West Sussex Authority: Environment Agency, Southern Region Catchment Area: Not Given Reference: S02088 Permit Version: 1 Effective Date: 1st May 1972 Issued Date: 1st May 1972 Revocation Date: 31st March 1997 Discharge Type: Discharge Of Other Matter-Surface Water Discharge: Freshwater Stream/River Environment: Receiving Water: Freshwater River Status: Lapsed (under Environment Act 1995, Schedule 23) Positional Accuracy: Located by supplier to within 100m	A11SE (W)	995	2	534040 124810
35	Local Authority Pollution Prevention and Controls Name: Lindfield Motors Location: Lewes Road, LINDFIELD, West Sussex, RH16 2LG Authority: Mid Sussex District Council, Environmental Services Section Permit Reference: PPC/LA-PPC/AP/024/1 Dated: 26th February 2004 Process Type: Local Authority Pollution Prevention and Control Description: PG1/1Waste oil burners, less than 0.4MW net rated thermal input Status: Permitted Positional Accuracy: Manually positioned to the address or location	A17SE (NW)	359	3	534842 125220
	Nearest Surface Water Feature	A13NW (NW)	14	-	535142 125004
36	Pollution Incidents to Controlled Waters Property Type: Domestic/Residential Location: Little Walstead Farm Authority: Environment Agency, Southern Region Pollutant: Oils - Unknown Note: Milky Scum On Stream Incident Date: 31st January 1997 Incident Reference: 597017 Catchment Area: Not Given Receiving Water: Not Given Cause of Incident: Oils/Related Products Incident Severity: Category 3 - Minor Incident Positional Accuracy: Located by supplier to within 100m	A13NE (E)	98	2	535550 124910
37	Pollution Incidents to Controlled Waters Property Type: Domestic/Residential Location: Northlands Wood Stream Authority: Environment Agency, Southern Region Pollutant: Sewage - Septic Tank Effluent Note: Sewage/Slurry In Stream Incident Date: 6th June 1992 Incident Reference: P00071 Catchment Area: Not Given Receiving Water: Not Given Cause of Incident: Sewage - Other Incident Severity: Category 3 - Minor Incident Positional Accuracy: Located by supplier to within 100m	A13SE (S)	100	2	535300 124600
38	Pollution Incidents to Controlled Waters Property Type: Industrial: Other Location: Crazy Horse Print Unit, Lewes Road, LINDFIELD Authority: Environment Agency, Southern Region Pollutant: Miscellaneous - Fire water / Foam Note: 4 Pump Fire Involving Factory Building Incident Date: 22nd June 1996 Incident Reference: 596175 Catchment Area: Not Given Receiving Water: Not Given Cause of Incident: Industrial - Other Incident Severity: Category 3 - Minor Incident Positional Accuracy: Located by supplier to within 100m	A17SE (NW)	367	2	534800 125200

Map ID	Details	Quadrant Reference (Compass Direction)	Estimated Distance From Site	Contact	NGR
39	Pollution Incidents to Controlled Waters Property Type: Construction/Demolition Location: Enterprise Park, Lewes Road, LINDFIELD Authority: Environment Agency, Southern Region Pollutant: Miscellaneous - Inert Suspended Solids Note: Stream Brown In Colour Incident Date: 22nd June 1992 Incident Reference: P00107 Catchment Area: Not Given Receiving Water: Not Given Cause of Incident: Miscellaneous/Other Pollution Type Incident Severity: Category 3 - Minor Incident Positional Accuracy: Located by supplier to within 100m	A12SE (W)	393	2	534700 124700
40	Pollution Incidents to Controlled Waters Property Type: Waste Management Facilities Location: Lindfield Funeral Directors, LINDFIELD Authority: Environment Agency, Southern Region Pollutant: General Biodegradable : Animal Blood & Offal Note: Not Supplied Incident Date: 20th October 1999 Incident Reference: 3225 Catchment Area: Ouse Receiving Water: Potential River Cause of Incident: Drainage Failures : Foul Sewer Failure Incident Severity: Category 3 - Minor Incident Positional Accuracy: Approximate location provided by supplier	A17SW (NW)	656	2	534500 125300
41	Pollution Incidents to Controlled Waters Property Type: Other General Premises Location: Beech Hill, HAYWARDS HEATH Authority: Environment Agency, Southern Region Pollutant: Oils - Petrol Note: Oil Discharging From Pipe 70 Watercourse; Miscellaneous Premises: Unknown Incident Date: 17th September 1994 Incident Reference: P00737 Catchment Area: Not Given Receiving Water: Not Given Cause of Incident: Oils/Related Products Incident Severity: Category 3 - Minor Incident Positional Accuracy: Located by supplier to within 100m	A7SE (S)	880	2	534900 123900
42	Pollution Incidents to Controlled Waters Property Type: Schools/Universities Location: Oathall School, LINDFIELD, West Sussex Authority: Environment Agency, Southern Region Pollutant: Chemicals - Acid Note: Fire - Chemicals - 14676 Incident Date: 2nd December 1996 Incident Reference: 696375 Catchment Area: Not Given Receiving Water: Not Given Cause of Incident: Unknown Incident Severity: Category 3 - Minor Incident Positional Accuracy: Unknown	A6NE (W)	927	2	534200 124500
	River Quality Name: Ouse GQA Grade: River Quality B Reach: Scaynes Hill Stw - Shell Bk Conf Estimated Distance (km): 6.5 Flow Rate: Flow less than 1.25 cumecs Flow Type: River Year: 2000	A19NW (NE)	899	2	535911 125673
43	Water Abstractions Operator: Paxhill Park Ltd Licence Number: 10/41/282007 Permit Version: 100 Location: Catchpits At Paxhill Park Golf Club Authority: Environment Agency, Southern Region Abstraction: Golf Courses: Spray Irrigation - Direct Abstraction Type: Water may be abstracted from a single point Source: Groundwater Daily Rate (m3): Not Supplied Yearly Rate (m3): Not Supplied Details: See Licence Map Paxhill Golf Course Authorised Start: 01 May Authorised End: 30 September Permit Start Date: 1st April 2016 Permit End Date: Not Supplied Positional Accuracy: Located by supplier to within 100m	A19NW (NE)	986	2	535850 125800

Map ID	Details	Quadrant Reference (Compass Direction)	Estimated Distance From Site	Contact	NGR
	Water Abstractions Operator: D Hobbs & Sons Licence Number: 282001 Permit Version: Not Supplied Location: Fulling Mill Farm, LINDFIELD, Sussex Authority: Environment Agency, Southern Region Abstraction: Spray Irrigation Abstraction Type: Not Supplied Source: Surface Daily Rate (m3): 764 Yearly Rate (m3): 6818 Details: River Ouse Authorised Start: Not Supplied Authorised End: Not Supplied Permit Start Date: Not Supplied Permit End Date: Not Supplied Positional Accuracy: Located by supplier to within 100m	A20SW (NE)	1166	2	536450 125500
	Water Abstractions Operator: Haywards Heath Golf Club Licence Number: 21/110 Permit Version: 100 Location: Haywards Heath Golf Course Authority: Environment Agency, Southern Region Abstraction: Golf Courses: Spray Irrigation - Direct Abstraction Type: Water may be abstracted from a single point Source: Groundwater Daily Rate (m3): Not Supplied Yearly Rate (m3): Not Supplied Details: See Licence Map Authorised Start: 01 April Authorised End: 31 October Permit Start Date: 1st April 2016 Permit End Date: Not Supplied Positional Accuracy: Located by supplier to within 100m	(NW)	1977	2	533440 126090
	Groundwater Vulnerability Map Combined Classification: Secondary Bedrock Aquifer - High Vulnerability Combined Vulnerability: High Combined Aquifer: Productive Bedrock Aquifer, Productive Superficial Aquifer Pollutant Speed: Intermediate Bedrock Flow: Mixed Dilution: 300-550 mm/year Baseflow Index: 40-70% Superficial Patchiness: <90% Superficial Thickness: <3m Superficial Recharge: No Data	A13NW (NW)	0	4	535155 124998
	Groundwater Vulnerability Map Combined Classification: Secondary Bedrock Aquifer - High Vulnerability Combined Vulnerability: High Combined Aquifer: Productive Bedrock Aquifer, No Superficial Aquifer Pollutant Speed: Intermediate Bedrock Flow: Well Connected Fractures Dilution: 300-550 mm/year Baseflow Index: 40-70% Superficial Patchiness: <90% Superficial Thickness: <3m Superficial Recharge: No Data	A13NE (N)	0	4	535243 125000

Map ID	Details	Quadrant Reference (Compass Direction)	Estimated Distance From Site	Contact	NGR
	Groundwater Vulnerability Map Combined Classification: Secondary Bedrock Aquifer - High Vulnerability Combined Vulnerability: High Combined Aquifer: Productive Bedrock Aquifer, No Superficial Aquifer Pollutant Speed: Intermediate Bedrock Flow: Mixed Dilution: 300-550 mm/year Baseflow Index: 40-70% Superficial Patchiness: <90% Superficial Thickness: <3m Superficial Recharge: No Data	A13NE (NE)	0	4	535243 124869
	Groundwater Vulnerability - Soluble Rock Risk None				
	Bedrock Aquifer Designations Aquifer Designation: Secondary Aquifer - A	A13NE (N)	0	4	535243 125000
	Bedrock Aquifer Designations Aquifer Designation: Secondary Aquifer - A	A13NE (NE)	0	4	535243 124869
	Superficial Aquifer Designations Aquifer Designation: Secondary Aquifer - A	A13NW (NW)	0	4	535155 124998
	Extreme Flooding from Rivers or Sea without Defences Type: Extent of Extreme Flooding from Rivers or Sea without Defences Flood Plain Type: Fluvial Models Boundary Accuracy: As Supplied	A13SE (E)	5	2	535427 124813
	Extreme Flooding from Rivers or Sea without Defences Type: Extent of Extreme Flooding from Rivers or Sea without Defences Flood Plain Type: Fluvial Models Boundary Accuracy: As Supplied	A13NW (NW)	13	2	535152 124996
	Extreme Flooding from Rivers or Sea without Defences Type: Extent of Extreme Flooding from Rivers or Sea without Defences Flood Plain Type: Fluvial Models Boundary Accuracy: As Supplied	A13NW (W)	18	2	535013 124920
	Extreme Flooding from Rivers or Sea without Defences Type: Extent of Extreme Flooding from Rivers or Sea without Defences Flood Plain Type: Fluvial Models Boundary Accuracy: As Supplied	A13SE (SE)	53	2	535406 124774
	Extreme Flooding from Rivers or Sea without Defences Type: Extent of Extreme Flooding from Rivers or Sea without Defences Flood Plain Type: Fluvial Models Boundary Accuracy: As Supplied	A13SE (SE)	94	2	535343 124633
	Extreme Flooding from Rivers or Sea without Defences Type: Extent of Extreme Flooding from Rivers or Sea without Defences Flood Plain Type: Fluvial Models Boundary Accuracy: As Supplied	A12SE (W)	171	2	534899 124803
	Extreme Flooding from Rivers or Sea without Defences Type: Extent of Extreme Flooding from Rivers or Sea without Defences Flood Plain Type: Fluvial Models Boundary Accuracy: As Supplied	A14NW (E)	226	2	535654 124999
	Flooding from Rivers or Sea without Defences Type: Extent of Flooding from Rivers or Sea without Defences Flood Plain Type: Fluvial Models Boundary Accuracy: As Supplied	A13SE (E)	10	2	535439 124838
	Flooding from Rivers or Sea without Defences Type: Extent of Flooding from Rivers or Sea without Defences Flood Plain Type: Fluvial Models Boundary Accuracy: As Supplied	A13NW (N)	14	2	535181 125023
	Flooding from Rivers or Sea without Defences Type: Extent of Flooding from Rivers or Sea without Defences Flood Plain Type: Fluvial Models Boundary Accuracy: As Supplied	A13NW (W)	18	2	535012 124920

Map ID	Details	Quadrant Reference (Compass Direction)	Estimated Distance From Site	Contact	NGR
	Flooding from Rivers or Sea without Defences Type: Extent of Flooding from Rivers or Sea without Defences Flood Plain Type: Fluvial Models Boundary Accuracy: As Supplied	A13SE (SE)	70	2	535388 124724
	Flooding from Rivers or Sea without Defences Type: Extent of Flooding from Rivers or Sea without Defences Flood Plain Type: Fluvial Models Boundary Accuracy: As Supplied	A13SE (SE)	96	2	535348 124634
	Flooding from Rivers or Sea without Defences Type: Extent of Flooding from Rivers or Sea without Defences Flood Plain Type: Fluvial Models Boundary Accuracy: As Supplied	A14NW (E)	165	2	535612 124936
	Flooding from Rivers or Sea without Defences Type: Extent of Flooding from Rivers or Sea without Defences Flood Plain Type: Fluvial Models Boundary Accuracy: As Supplied	A12SE (W)	174	2	534893 124805
	Flooding from Rivers or Sea without Defences Type: Extent of Flooding from Rivers or Sea without Defences Flood Plain Type: Fluvial Models Boundary Accuracy: As Supplied	A14NW (E)	226	2	535655 124999
	Areas Benefiting from Flood Defences None				
	Flood Water Storage Areas None				
	Flood Defences Type: Flood Defences Reference: Not Supplied	A13NW (W)	13	2	535024 124927
	Flood Defences Type: Flood Defences Reference: Not Supplied	A13NW (NW)	14	2	535107 124985
	Flood Defences Type: Flood Defences Reference: Not Supplied	A13NW (NW)	19	2	535098 124986
	Flood Defences Type: Flood Defences Reference: Not Supplied	A12SE (W)	174	2	534895 124803
	Flood Defences Type: Flood Defences Reference: Not Supplied	A12SE (W)	179	2	534888 124805
44	OS Water Network Lines Watercourse Form: Inland river Watercourse Length: 84.1 Watercourse Level: On ground surface Permanent: True Watercourse Name: Scrase Stream Catchment Name: Ouse and Uck Primacy: 1	A13NW (W)	16	5	535028 124935
45	OS Water Network Lines Watercourse Form: Inland river Watercourse Length: 141.4 Watercourse Level: Not Supplied Permanent: True Watercourse Name: Not Supplied Catchment Name: Ouse and Uck Primacy: 1	A13NW (W)	21	5	535028 124935
46	OS Water Network Lines Watercourse Form: Inland river Watercourse Length: 250.7 Watercourse Level: On ground surface Permanent: True Watercourse Name: Scrase Stream Catchment Name: Ouse and Uck Primacy: 1	A13NW (NW)	21	5	535142 125006

Map ID	Details	Quadrant Reference (Compass Direction)	Estimated Distance From Site	Contact	NGR
47	OS Water Network Lines Watercourse Form: Inland river Watercourse Length: 259.1 Watercourse Level: On ground surface Permanent: True Watercourse Name: Not Supplied Catchment Name: Ouse and Uck Primacy: 1	A13SE (E)	23	5	535446 124813
48	OS Water Network Lines Watercourse Form: Inland river Watercourse Length: 97.2 Watercourse Level: On ground surface Permanent: True Watercourse Name: Not Supplied Catchment Name: Ouse and Uck Primacy: 1	A13SE (E)	39	5	535444 124803
49	OS Water Network Lines Watercourse Form: Inland river Watercourse Length: 197.9 Watercourse Level: On ground surface Permanent: True Watercourse Name: Not Supplied Catchment Name: Ouse and Uck Primacy: 2	A13SE (E)	39	5	535444 124803
50	OS Water Network Lines Watercourse Form: Inland river Watercourse Length: 303.7 Watercourse Level: On ground surface Permanent: True Watercourse Name: Scrase Stream Catchment Name: Ouse and Uck Primacy: 1	A13NE (N)	62	5	535242 125064
51	OS Water Network Lines Watercourse Form: Inland river Watercourse Length: 77.0 Watercourse Level: On ground surface Permanent: True Watercourse Name: Not Supplied Catchment Name: Ouse and Uck Primacy: 1	A13NW (N)	62	5	535234 125064
52	OS Water Network Lines Watercourse Form: Inland river Watercourse Length: 113.6 Watercourse Level: On ground surface Permanent: True Watercourse Name: Scrase Stream Catchment Name: Ouse and Uck Primacy: 1	A13NW (W)	73	5	534964 124881
53	OS Water Network Lines Watercourse Form: Inland river Watercourse Length: 773.1 Watercourse Level: On ground surface Permanent: True Watercourse Name: Not Supplied Catchment Name: Ouse and Uck Primacy: 1	A13SE (SE)	74	5	535372 124698
54	OS Water Network Lines Watercourse Form: Inland river Watercourse Length: 23.8 Watercourse Level: On ground surface Permanent: True Watercourse Name: Not Supplied Catchment Name: Ouse and Uck Primacy: 1	A13SE (SE)	74	5	535386 124716
55	OS Water Network Lines Watercourse Form: Lake Watercourse Length: 2.6 Watercourse Level: On ground surface Permanent: True Watercourse Name: Not Supplied Catchment Name: Ouse and Uck Primacy: 1	A13SE (SE)	75	5	535374 124700

Map ID	Details	Quadrant Reference (Compass Direction)	Estimated Distance From Site	Contact	NGR
56	OS Water Network Lines Watercourse Form: Lake Watercourse Length: 2.3 Watercourse Level: On ground surface Permanent: True Watercourse Name: Not Supplied Catchment Name: Ouse and Uck Primacy: 1	A13SE (SE)	75	5	535389 124719
57	OS Water Network Lines Watercourse Form: Inland river Watercourse Length: 2.9 Watercourse Level: On ground surface Permanent: True Watercourse Name: Not Supplied Catchment Name: Ouse and Uck Primacy: 1	A13SE (SE)	75	5	535390 124720
58	OS Water Network Lines Watercourse Form: Lake Watercourse Length: 13.7 Watercourse Level: On ground surface Permanent: True Watercourse Name: Not Supplied Catchment Name: Ouse and Uck Primacy: 1	A13SE (SE)	75	5	535392 124722
59	OS Water Network Lines Watercourse Form: Inland river Watercourse Length: 123.1 Watercourse Level: On ground surface Permanent: True Watercourse Name: Not Supplied Catchment Name: Ouse and Uck Primacy: 1	A13NW (NW)	158	5	534927 125034
60	OS Water Network Lines Watercourse Form: Inland river Watercourse Length: 5.5 Watercourse Level: Underground Permanent: True Watercourse Name: Not Supplied Catchment Name: Ouse and Uck Primacy: 1	A14NW (E)	160	5	535608 124935
61	OS Water Network Lines Watercourse Form: Inland river Watercourse Length: 7.7 Watercourse Level: Underground Permanent: True Watercourse Name: Not Supplied Catchment Name: Ouse and Uck Primacy: 2	A14NW (E)	163	5	535616 124898
62	OS Water Network Lines Watercourse Form: Inland river Watercourse Length: 14.4 Watercourse Level: Underground Permanent: True Watercourse Name: Not Supplied Catchment Name: Ouse and Uck Primacy: 1	A14NW (E)	166	5	535614 124936
63	OS Water Network Lines Watercourse Form: Inland river Watercourse Length: 56.5 Watercourse Level: On ground surface Permanent: True Watercourse Name: Not Supplied Catchment Name: Ouse and Uck Primacy: 2	A14NW (E)	166	5	535614 124936
64	OS Water Network Lines Watercourse Form: Inland river Watercourse Length: 74.4 Watercourse Level: On ground surface Permanent: True Watercourse Name: Not Supplied Catchment Name: Ouse and Uck Primacy: 2	A14NW (E)	170	5	535623 124902

Map ID	Details	Quadrant Reference (Compass Direction)	Estimated Distance From Site	Contact	NGR
65	OS Water Network Lines Watercourse Form: Inland river Watercourse Length: 161.5 Watercourse Level: On ground surface Permanent: True Watercourse Name: Scrase Stream Catchment Name: Ouse and Uck Primacy: 1	A12SE (W)	177	5	534891 124803
66	OS Water Network Lines Watercourse Form: Lake Watercourse Length: 53.1 Watercourse Level: On ground surface Permanent: True Watercourse Name: Not Supplied Catchment Name: Ouse and Uck Primacy: 1	A14NW (E)	179	5	535625 124945
67	OS Water Network Lines Watercourse Form: Inland river Watercourse Length: 71.1 Watercourse Level: On ground surface Permanent: True Watercourse Name: Not Supplied Catchment Name: Ouse and Uck Primacy: 1	A14NW (E)	219	5	535651 124991
68	OS Water Network Lines Watercourse Form: Inland river Watercourse Length: 4.8 Watercourse Level: On ground surface Permanent: True Watercourse Name: Not Supplied Catchment Name: Ouse and Uck Primacy: 2	A14NW (E)	222	5	535668 124950
69	OS Water Network Lines Watercourse Form: Inland river Watercourse Length: 20.0 Watercourse Level: Underground Permanent: True Watercourse Name: Not Supplied Catchment Name: Ouse and Uck Primacy: 2	A14NW (E)	226	5	535672 124952
70	OS Water Network Lines Watercourse Form: Inland river Watercourse Length: 9.3 Watercourse Level: Underground Permanent: True Watercourse Name: Not Supplied Catchment Name: Ouse and Uck Primacy: 1	A14NW (E)	244	5	535692 124947
71	OS Water Network Lines Watercourse Form: Inland river Watercourse Length: 59.2 Watercourse Level: On ground surface Permanent: True Watercourse Name: Not Supplied Catchment Name: Ouse and Uck Primacy: 1	A14NW (E)	244	5	535692 124947
72	OS Water Network Lines Watercourse Form: Inland river Watercourse Length: 296.0 Watercourse Level: On ground surface Permanent: True Watercourse Name: Not Supplied Catchment Name: Ouse and Uck Primacy: 1	A14NW (E)	245	5	535694 124938
73	OS Water Network Lines Watercourse Form: Inland river Watercourse Length: 10.0 Watercourse Level: Underground Permanent: True Watercourse Name: Not Supplied Catchment Name: Ouse and Uck Primacy: 1	A12NE (NW)	281	5	534861 125138

Map ID	Details	Quadrant Reference (Compass Direction)	Estimated Distance From Site	Contact	NGR
74	OS Water Network Lines Watercourse Form: Inland river Watercourse Length: 8.9 Watercourse Level: Underground Permanent: True Watercourse Name: Not Supplied Catchment Name: Ouse and Uck Primacy: 1	A14NW (E)	288	5	535711 125024
75	OS Water Network Lines Watercourse Form: Inland river Watercourse Length: 27.4 Watercourse Level: On ground surface Permanent: True Watercourse Name: Not Supplied Catchment Name: Ouse and Uck Primacy: 1	A12NE (NW)	291	5	534855 125146
76	OS Water Network Lines Watercourse Form: Inland river Watercourse Length: 13.9 Watercourse Level: Underground Permanent: True Watercourse Name: Not Supplied Catchment Name: Ouse and Uck Primacy: 1	A14NW (E)	296	5	535720 125025
77	OS Water Network Lines Watercourse Form: Inland river Watercourse Length: 328.3 Watercourse Level: On ground surface Permanent: True Watercourse Name: Not Supplied Catchment Name: Ouse and Uck Primacy: 1	A14NW (E)	296	5	535720 125025
78	OS Water Network Lines Watercourse Form: Inland river Watercourse Length: 10.4 Watercourse Level: On ground surface Permanent: True Watercourse Name: Not Supplied Catchment Name: Ouse and Uck Primacy: 1	A14NW (E)	297	5	535726 125012
79	OS Water Network Lines Watercourse Form: Inland river Watercourse Length: 16.8 Watercourse Level: Underground Permanent: True Watercourse Name: Not Supplied Catchment Name: Ouse and Uck Primacy: 1	A14NW (E)	298	5	535739 124982
80	OS Water Network Lines Watercourse Form: Inland river Watercourse Length: 3.1 Watercourse Level: Underground Permanent: True Watercourse Name: Not Supplied Catchment Name: Ouse and Uck Primacy: 1	A14NW (E)	303	5	535735 125007
81	OS Water Network Lines Watercourse Form: Inland river Watercourse Length: 21.4 Watercourse Level: On ground surface Permanent: True Watercourse Name: Not Supplied Catchment Name: Ouse and Uck Primacy: 1	A14NW (E)	306	5	535738 125006
82	OS Water Network Lines Watercourse Form: Inland river Watercourse Length: 3.6 Watercourse Level: On ground surface Permanent: True Watercourse Name: Not Supplied Catchment Name: Ouse and Uck Primacy: 1	A14NW (E)	313	5	535751 124993

Map ID	Details	Quadrant Reference (Compass Direction)	Estimated Distance From Site	Contact	NGR
83	OS Water Network Lines Watercourse Form: Inland river Watercourse Length: 24.1 Watercourse Level: On ground surface Permanent: True Watercourse Name: Not Supplied Catchment Name: Ouse and Uck Primacy: 1	A14NW (E)	317	5	535754 124994
84	OS Water Network Lines Watercourse Form: Inland river Watercourse Length: 235.4 Watercourse Level: On ground surface Permanent: True Watercourse Name: Not Supplied Catchment Name: Ouse and Uck Primacy: 1	A18SE (N)	324	5	535363 125294
85	OS Water Network Lines Watercourse Form: Inland river Watercourse Length: 472.9 Watercourse Level: On ground surface Permanent: True Watercourse Name: Scrase Stream Catchment Name: Ouse and Uck Primacy: 1	A12SE (W)	329	5	534757 124730
86	OS Water Network Lines Watercourse Form: Inland river Watercourse Length: 114.2 Watercourse Level: On ground surface Permanent: True Watercourse Name: Not Supplied Catchment Name: Ouse and Uck Primacy: 1	A12SE (W)	329	5	534757 124730
87	OS Water Network Lines Watercourse Form: Inland river Watercourse Length: 26.4 Watercourse Level: On ground surface Permanent: True Watercourse Name: Not Supplied Catchment Name: Ouse and Uck Primacy: 1	A18SE (NE)	336	5	535438 125272
88	OS Water Network Lines Watercourse Form: Inland river Watercourse Length: 187.2 Watercourse Level: On ground surface Permanent: True Watercourse Name: Scrase Stream Catchment Name: Ouse and Uck Primacy: 1	A18SE (NE)	336	5	535438 125272
89	OS Water Network Lines Watercourse Form: Inland river Watercourse Length: 6.3 Watercourse Level: Underground Permanent: True Watercourse Name: Not Supplied Catchment Name: Ouse and Uck Primacy: 1	A14NW (E)	337	5	535777 124987
90	OS Water Network Lines Watercourse Form: Inland river Watercourse Length: 50.0 Watercourse Level: On ground surface Permanent: True Watercourse Name: Not Supplied Catchment Name: Ouse and Uck Primacy: 1	A14NW (E)	341	5	535782 124984
91	OS Water Network Lines Watercourse Form: Inland river Watercourse Length: 155.3 Watercourse Level: On ground surface Permanent: True Watercourse Name: Not Supplied Catchment Name: Ouse and Uck Primacy: 1	A18SE (N)	383	5	535304 125382

Map ID	Details	Quadrant Reference (Compass Direction)	Estimated Distance From Site	Contact	NGR
92	OS Water Network Lines Watercourse Form: Inland river Watercourse Length: 88.9 Watercourse Level: On ground surface Permanent: True Watercourse Name: Not Supplied Catchment Name: Ouse and Uck Primacy: 1	A18SE (N)	400	5	535423 125348
93	OS Water Network Lines Watercourse Form: Inland river Watercourse Length: 206.0 Watercourse Level: On ground surface Permanent: True Watercourse Name: Not Supplied Catchment Name: Ouse and Uck Primacy: 1	A18SE (N)	404	5	535438 125346
94	OS Water Network Lines Watercourse Form: Lake Watercourse Length: 8.4 Watercourse Level: On ground surface Permanent: True Watercourse Name: Not Supplied Catchment Name: Ouse and Uck Primacy: 1	A18SE (N)	435	5	535384 125407
95	OS Water Network Lines Watercourse Form: Inland river Watercourse Length: 156.7 Watercourse Level: On ground surface Permanent: True Watercourse Name: Not Supplied Catchment Name: Ouse and Uck Primacy: 1	A12SE (W)	435	5	534690 124641
96	OS Water Network Lines Watercourse Form: Inland river Watercourse Length: 1.8 Watercourse Level: On ground surface Permanent: True Watercourse Name: Not Supplied Catchment Name: Ouse and Uck Primacy: 2	A12SE (W)	435	5	534690 124641
97	OS Water Network Lines Watercourse Form: Inland river Watercourse Length: 2.1 Watercourse Level: Underground Permanent: True Watercourse Name: Not Supplied Catchment Name: Ouse and Uck Primacy: 2	A12SE (W)	437	5	534688 124641
98	OS Water Network Lines Watercourse Form: Inland river Watercourse Length: 381.2 Watercourse Level: On ground surface Permanent: True Watercourse Name: Not Supplied Catchment Name: Ouse and Uck Primacy: 2	A12SE (W)	439	5	534686 124640
99	OS Water Network Lines Watercourse Form: Inland river Watercourse Length: 318.7 Watercourse Level: On ground surface Permanent: True Watercourse Name: Scrase Stream Catchment Name: Ouse and Uck Primacy: 1	A19SW (NE)	467	5	535608 125340
100	OS Water Network Lines Watercourse Form: Inland river Watercourse Length: 6.9 Watercourse Level: On ground surface Permanent: True Watercourse Name: Not Supplied Catchment Name: Ouse and Uck Primacy: 1	A19SW (NE)	467	5	535608 125340

Map ID	Details	Quadrant Reference (Compass Direction)	Estimated Distance From Site	Contact	NGR
101	OS Water Network Lines Watercourse Form: Inland river Watercourse Length: 26.0 Watercourse Level: On ground surface Permanent: True Watercourse Name: Not Supplied Catchment Name: Ouse and Uck Primacy: 1	A19SW (NE)	472	5	535609 125346
102	OS Water Network Lines Watercourse Form: Inland river Watercourse Length: 3.4 Watercourse Level: Underground Permanent: True Watercourse Name: Not Supplied Catchment Name: Ouse and Uck Primacy: 1	A19SW (NE)	489	5	535598 125367
103	OS Water Network Lines Watercourse Form: Inland river Watercourse Length: 515.2 Watercourse Level: On ground surface Permanent: True Watercourse Name: Not Supplied Catchment Name: Ouse and Uck Primacy: 1	A7NE (SW)	548	5	534666 124491
104	OS Water Network Lines Watercourse Form: Inland river Watercourse Length: 7.1 Watercourse Level: Underground Permanent: True Watercourse Name: Not Supplied Catchment Name: Ouse and Uck Primacy: 1	A19SE (NE)	606	5	535962 125225
105	OS Water Network Lines Watercourse Form: Inland river Watercourse Length: 186.6 Watercourse Level: Not Supplied Permanent: True Watercourse Name: Not Supplied Catchment Name: Ouse and Uck Primacy: 2	A19SE (NE)	606	5	535962 125225
106	OS Water Network Lines Watercourse Form: Inland river Watercourse Length: 99.0 Watercourse Level: On ground surface Permanent: True Watercourse Name: Not Supplied Catchment Name: Ouse and Uck Primacy: 1	A19SE (NE)	613	5	535966 125232
107	OS Water Network Lines Watercourse Form: Inland river Watercourse Length: 186.3 Watercourse Level: On ground surface Permanent: True Watercourse Name: Scrase Stream Catchment Name: Ouse and Uck Primacy: 1	A19SW (NE)	678	5	535906 125401
108	OS Water Network Lines Watercourse Form: Inland river Watercourse Length: 158.7 Watercourse Level: On ground surface Permanent: True Watercourse Name: Not Supplied Catchment Name: Ouse and Uck Primacy: 1	A8SW (S)	679	5	535098 124041
109	OS Water Network Lines Watercourse Form: Inland river Watercourse Length: 29.4 Watercourse Level: On ground surface Permanent: True Watercourse Name: Not Supplied Catchment Name: Ouse and Uck Primacy: 1	A8SW (S)	679	5	535098 124041

Map ID	Details	Quadrant Reference (Compass Direction)	Estimated Distance From Site	Contact	NGR
110	OS Water Network Lines Watercourse Form: Inland river Watercourse Length: 617.4 Watercourse Level: On ground surface Permanent: True Watercourse Name: Not Supplied Catchment Name: Ouse and Uck Primacy: 1	A19SW (NE)	685	5	535819 125475
111	OS Water Network Lines Watercourse Form: Inland river Watercourse Length: 185.9 Watercourse Level: On ground surface Permanent: True Watercourse Name: Not Supplied Catchment Name: Ouse and Uck Primacy: 1	A14SE (E)	692	5	536137 124800
112	OS Water Network Lines Watercourse Form: Inland river Watercourse Length: 101.2 Watercourse Level: On ground surface Permanent: True Watercourse Name: Not Supplied Catchment Name: Ouse and Uck Primacy: 1	A9NE (SE)	696	5	535932 124356
113	OS Water Network Lines Watercourse Form: Inland river Watercourse Length: 159.1 Watercourse Level: On ground surface Permanent: True Watercourse Name: Not Supplied Catchment Name: Ouse and Uck Primacy: 1	A9NE (SE)	696	5	535949 124378
114	OS Water Network Lines Watercourse Form: Inland river Watercourse Length: 115.8 Watercourse Level: On ground surface Permanent: True Watercourse Name: Not Supplied Catchment Name: Ouse and Uck Primacy: 1	A19SE (NE)	710	5	536041 125294
115	OS Water Network Lines Watercourse Form: Inland river Watercourse Length: 265.2 Watercourse Level: On ground surface Permanent: True Watercourse Name: Not Supplied Catchment Name: Ouse and Uck Primacy: 1	A19SE (NE)	711	5	536046 125288
116	OS Water Network Lines Watercourse Form: Lake Watercourse Length: 24.1 Watercourse Level: On ground surface Permanent: True Watercourse Name: Not Supplied Catchment Name: Ouse and Uck Primacy: 1	A9NW (SE)	711	5	535870 124281
117	OS Water Network Lines Watercourse Form: Inland river Watercourse Length: 286.7 Watercourse Level: On ground surface Permanent: True Watercourse Name: Not Supplied Catchment Name: Ouse and Uck Primacy: 1	A9NW (SE)	712	5	535870 124281
118	OS Water Network Lines Watercourse Form: Inland river Watercourse Length: 151.0 Watercourse Level: On ground surface Permanent: True Watercourse Name: Scrase Stream Catchment Name: Ouse and Uck Primacy: 1	A12SW (W)	759	5	534341 124594

Map ID	Details	Quadrant Reference (Compass Direction)	Estimated Distance From Site	Contact	NGR
119	OS Water Network Lines Watercourse Form: Inland river Watercourse Length: 6.2 Watercourse Level: On ground surface Permanent: True Watercourse Name: Not Supplied Catchment Name: Ouse and Uck Primacy: 2	A12SW (W)	759	5	534341 124594
120	OS Water Network Lines Watercourse Form: Inland river Watercourse Length: 5.3 Watercourse Level: Underground Permanent: True Watercourse Name: Not Supplied Catchment Name: Ouse and Uck Primacy: 2	A12SW (W)	761	5	534342 124588
121	OS Water Network Lines Watercourse Form: Inland river Watercourse Length: 86.5 Watercourse Level: On ground surface Permanent: True Watercourse Name: Not Supplied Catchment Name: Ouse and Uck Primacy: 2	A12SW (W)	763	5	534343 124583
122	OS Water Network Lines Watercourse Form: Lake Watercourse Length: 12.0 Watercourse Level: On ground surface Permanent: True Watercourse Name: Not Supplied Catchment Name: Ouse and Uck Primacy: 1	A9NE (SE)	771	5	536087 124439
123	OS Water Network Lines Watercourse Form: Inland river Watercourse Length: 235.9 Watercourse Level: On ground surface Permanent: True Watercourse Name: Not Supplied Catchment Name: Ouse and Uck Primacy: 1	A9NE (SE)	783	5	536097 124432
124	OS Water Network Lines Watercourse Form: Inland river Watercourse Length: 6.8 Watercourse Level: Underground Permanent: True Watercourse Name: Not Supplied Catchment Name: Ouse and Uck Primacy: 2	A7NW (W)	793	5	534351 124504
125	OS Water Network Lines Watercourse Form: Lake Watercourse Length: 80.6 Watercourse Level: On ground surface Permanent: True Watercourse Name: Not Supplied Catchment Name: Ouse and Uck Primacy: 1	A9SW (SE)	803	5	535726 124033
126	OS Water Network Lines Watercourse Form: Inland river Watercourse Length: 6.8 Watercourse Level: Underground Permanent: True Watercourse Name: Not Supplied Catchment Name: Ouse and Uck Primacy: 1	A19SE (NE)	804	5	536089 125388
127	OS Water Network Lines Watercourse Form: Inland river Watercourse Length: 9.3 Watercourse Level: On ground surface Permanent: True Watercourse Name: Not Supplied Catchment Name: Ouse and Uck Primacy: 1	A19SE (NE)	808	5	536089 125395

Map ID	Details	Quadrant Reference (Compass Direction)	Estimated Distance From Site	Contact	NGR
128	OS Water Network Lines Watercourse Form: Inland river Watercourse Length: 7.2 Watercourse Level: Underground Permanent: True Watercourse Name: Not Supplied Catchment Name: Ouse and Uck Primacy: 1	A8SW (S)	811	5	534980 123941
129	OS Water Network Lines Watercourse Form: Inland river Watercourse Length: 59.7 Watercourse Level: On ground surface Permanent: True Watercourse Name: Scrase Stream Catchment Name: Ouse and Uck Primacy: 1	A19SE (NE)	813	5	536088 125404
130	OS Water Network Lines Watercourse Form: Inland river Watercourse Length: 4.9 Watercourse Level: On ground surface Permanent: True Watercourse Name: Not Supplied Catchment Name: Ouse and Uck Primacy: 1	A8SW (S)	817	5	534975 123937
131	OS Water Network Lines Watercourse Form: Inland river Watercourse Length: 41.9 Watercourse Level: On ground surface Permanent: True Watercourse Name: Not Supplied Catchment Name: Ouse and Uck Primacy: 1	A8SW (S)	821	5	534971 123934
132	OS Water Network Lines Watercourse Form: Inland river Watercourse Length: 160.4 Watercourse Level: On ground surface Permanent: True Watercourse Name: Not Supplied Catchment Name: Ouse and Uck Primacy: 1	A19NW (N)	825	5	535586 125742
133	OS Water Network Lines Watercourse Form: Inland river Watercourse Length: 149.6 Watercourse Level: On ground surface Permanent: True Watercourse Name: Not Supplied Catchment Name: Ouse and Uck Primacy: 1	A9SW (SE)	827	5	535673 123973
134	OS Water Network Lines Watercourse Form: Lake Watercourse Length: 6.1 Watercourse Level: On ground surface Permanent: True Watercourse Name: Not Supplied Catchment Name: Ouse and Uck Primacy: 1	A8SW (S)	858	5	534940 123906
135	OS Water Network Lines Watercourse Form: Inland river Watercourse Length: 126.1 Watercourse Level: On ground surface Permanent: True Watercourse Name: Not Supplied Catchment Name: Ouse and Uck Primacy: 1	A19NW (NE)	860	5	535710 125722
136	OS Water Network Lines Watercourse Form: Inland river Watercourse Length: 21.1 Watercourse Level: Underground Permanent: True Watercourse Name: Not Supplied Catchment Name: Ouse and Uck Primacy: 1	A8SW (S)	864	5	534935 123902

Map ID	Details	Quadrant Reference (Compass Direction)	Estimated Distance From Site	Contact	NGR
137	OS Water Network Lines Watercourse Form: Inland river Watercourse Length: 2.5 Watercourse Level: On ground surface Permanent: True Watercourse Name: Not Supplied Catchment Name: Ouse and Uck Primacy: 1	A19SE (NE)	866	5	536135 125430
138	OS Water Network Lines Watercourse Form: Inland river Watercourse Length: 553.8 Watercourse Level: On ground surface Permanent: True Watercourse Name: Not Supplied Catchment Name: Ouse and Uck Primacy: 1	A11NE (W)	867	5	534201 125172
139	OS Water Network Lines Watercourse Form: Inland river Watercourse Length: 487.1 Watercourse Level: On ground surface Permanent: True Watercourse Name: Scrase Stream Catchment Name: Ouse and Uck Primacy: 1	A19SE (NE)	867	5	536137 125429
140	OS Water Network Lines Watercourse Form: Inland river Watercourse Length: 17.9 Watercourse Level: On ground surface Permanent: True Watercourse Name: Not Supplied Catchment Name: Ouse and Uck Primacy: 1	A8SW (S)	868	5	534908 123910
141	OS Water Network Lines Watercourse Form: Inland river Watercourse Length: 294.2 Watercourse Level: On ground surface Permanent: True Watercourse Name: River Ouse Catchment Name: Ouse and Uck Primacy: 1	A19NW (NE)	869	5	535913 125634
142	OS Water Network Lines Watercourse Form: Inland river Watercourse Length: 98.8 Watercourse Level: On ground surface Permanent: True Watercourse Name: Not Supplied Catchment Name: Ouse and Uck Primacy: 1	A15SW (E)	874	5	536312 124738
143	OS Water Network Lines Watercourse Form: Inland river Watercourse Length: 27.0 Watercourse Level: On ground surface Permanent: True Watercourse Name: Not Supplied Catchment Name: Ouse and Uck Primacy: 1	A15SW (E)	874	5	536312 124738
144	OS Water Network Lines Watercourse Form: Inland river Watercourse Length: 1.4 Watercourse Level: On ground surface Permanent: True Watercourse Name: Not Supplied Catchment Name: Ouse and Uck Primacy: 1	A8SW (S)	879	5	534916 123894
145	OS Water Network Lines Watercourse Form: Inland river Watercourse Length: 79.7 Watercourse Level: On ground surface Permanent: True Watercourse Name: Not Supplied Catchment Name: Ouse and Uck Primacy: 1	A8SW (S)	880	5	534915 123893

Map ID	Details	Quadrant Reference (Compass Direction)	Estimated Distance From Site	Contact	NGR
146	OS Water Network Lines Watercourse Form: Inland river Watercourse Length: 311.1 Watercourse Level: Not Supplied Permanent: True Watercourse Name: Not Supplied Catchment Name: Ouse and Uck Primacy: 2	A17SW (NW)	881	5	534249 125322
147	OS Water Network Lines Watercourse Form: Inland river Watercourse Length: 277.2 Watercourse Level: On ground surface Permanent: True Watercourse Name: Scrase Stream Catchment Name: Ouse and Uck Primacy: 1	A11SE (W)	886	5	534202 124596
148	OS Water Network Lines Watercourse Form: Inland river Watercourse Length: 13.6 Watercourse Level: On ground surface Permanent: True Watercourse Name: Not Supplied Catchment Name: Ouse and Uck Primacy: 1	A11SE (W)	886	5	534202 124596
149	OS Water Network Lines Watercourse Form: Inland river Watercourse Length: 9.8 Watercourse Level: Underground Permanent: True Watercourse Name: Not Supplied Catchment Name: Ouse and Uck Primacy: 1	A11SE (W)	899	5	534191 124589
150	OS Water Network Lines Watercourse Form: Inland river Watercourse Length: 308.3 Watercourse Level: On ground surface Permanent: True Watercourse Name: Not Supplied Catchment Name: Ouse and Uck Primacy: 1	A11SE (W)	909	5	534183 124584
151	OS Water Network Lines Watercourse Form: Inland river Watercourse Length: 8.0 Watercourse Level: On ground surface Permanent: True Watercourse Name: Not Supplied Catchment Name: Ouse and Uck Primacy: 2	A16SE (W)	914	5	534195 125285
152	OS Water Network Lines Watercourse Form: Inland river Watercourse Length: 12.5 Watercourse Level: On ground surface Permanent: True Watercourse Name: Not Supplied Catchment Name: Ouse and Uck Primacy: 1	A16SE (W)	915	5	534191 125278
153	OS Water Network Lines Watercourse Form: Inland river Watercourse Length: 1.4 Watercourse Level: Underground Permanent: True Watercourse Name: Not Supplied Catchment Name: Ouse and Uck Primacy: 1	A10NW (E)	919	5	536266 124460
154	OS Water Network Lines Watercourse Form: Inland river Watercourse Length: 258.1 Watercourse Level: Not Supplied Permanent: True Watercourse Name: Not Supplied Catchment Name: Ouse and Uck Primacy: 1	A16SE (W)	920	5	534190 125291

Map ID	Details	Quadrant Reference (Compass Direction)	Estimated Distance From Site	Contact	NGR
155	OS Water Network Lines Watercourse Form: Inland river Watercourse Length: 7.0 Watercourse Level: Underground Permanent: True Watercourse Name: Not Supplied Catchment Name: Ouse and Uck Primacy: 1	A4NW (S)	920	5	535611 123841
156	OS Water Network Lines Watercourse Form: Inland river Watercourse Length: 77.7 Watercourse Level: On ground surface Permanent: True Watercourse Name: Not Supplied Catchment Name: Ouse and Uck Primacy: 1	A10NW (E)	920	5	536267 124461
157	OS Water Network Lines Watercourse Form: Inland river Watercourse Length: 719.6 Watercourse Level: On ground surface Permanent: True Watercourse Name: River Ouse Catchment Name: Ouse and Uck Primacy: 1	A19NE (NE)	924	5	536022 125625
158	OS Water Network Lines Watercourse Form: Inland river Watercourse Length: 8.4 Watercourse Level: On ground surface Permanent: True Watercourse Name: Not Supplied Catchment Name: Ouse and Uck Primacy: 1	A19NE (NE)	924	5	536022 125625
159	OS Water Network Lines Watercourse Form: Lake Watercourse Length: 56.3 Watercourse Level: On ground surface Permanent: True Watercourse Name: Not Supplied Catchment Name: Ouse and Uck Primacy: 1	A4NW (S)	924	5	535608 123835
160	OS Water Network Lines Watercourse Form: Inland river Watercourse Length: 2.2 Watercourse Level: Underground Permanent: True Watercourse Name: Not Supplied Catchment Name: Ouse and Uck Primacy: 1	A19NE (NE)	928	5	536018 125632
161	OS Water Network Lines Watercourse Form: Inland river Watercourse Length: 39.3 Watercourse Level: On ground surface Permanent: True Watercourse Name: Not Supplied Catchment Name: Ouse and Uck Primacy: 1	A19NE (NE)	929	5	536008 125641
162	OS Water Network Lines Watercourse Form: Inland river Watercourse Length: 271.6 Watercourse Level: Not Supplied Permanent: True Watercourse Name: Not Supplied Catchment Name: Ouse and Uck Primacy: 1	A7SE (S)	937	5	534839 123867
163	OS Water Network Lines Watercourse Form: Inland river Watercourse Length: 6.6 Watercourse Level: On ground surface Permanent: True Watercourse Name: Not Supplied Catchment Name: Ouse and Uck Primacy: 1	A3NE (S)	944	5	535567 123800

Map ID	Details	Quadrant Reference (Compass Direction)	Estimated Distance From Site	Contact	NGR
164	OS Water Network Lines Watercourse Form: Inland river Watercourse Length: 2.2 Watercourse Level: On ground surface Permanent: True Watercourse Name: Not Supplied Catchment Name: Ouse and Uck Primacy: 1	A19NE (NE)	946	5	536005 125665
165	OS Water Network Lines Watercourse Form: Inland river Watercourse Length: 16.7 Watercourse Level: On ground surface Permanent: True Watercourse Name: Not Supplied Catchment Name: Ouse and Uck Primacy: 1	A19NE (NE)	946	5	536005 125665
166	OS Water Network Lines Watercourse Form: Lake Watercourse Length: 17.1 Watercourse Level: On ground surface Permanent: True Watercourse Name: Not Supplied Catchment Name: Ouse and Uck Primacy: 1	A3NE (S)	946	5	535562 123795
167	OS Water Network Lines Watercourse Form: Inland river Watercourse Length: 3.5 Watercourse Level: Underground Permanent: True Watercourse Name: Not Supplied Catchment Name: Ouse and Uck Primacy: 1	A19NE (NE)	948	5	536005 125667
168	OS Water Network Lines Watercourse Form: Inland river Watercourse Length: 46.1 Watercourse Level: On ground surface Permanent: True Watercourse Name: Not Supplied Catchment Name: Ouse and Uck Primacy: 1	A19NE (NE)	950	5	536004 125670
169	OS Water Network Lines Watercourse Form: Inland river Watercourse Length: 296.7 Watercourse Level: On ground surface Permanent: True Watercourse Name: River Ouse Catchment Name: Ouse and Uck Primacy: 1	A19NW (NE)	957	5	535814 125784
170	OS Water Network Lines Watercourse Form: Inland river Watercourse Length: 14.6 Watercourse Level: Underground Permanent: True Watercourse Name: Not Supplied Catchment Name: Ouse and Uck Primacy: 1	A19NW (NE)	957	5	535814 125784
171	OS Water Network Lines Watercourse Form: Inland river Watercourse Length: 3.3 Watercourse Level: Underground Permanent: True Watercourse Name: Not Supplied Catchment Name: Ouse and Uck Primacy: 1	A19NE (NE)	962	5	536017 125675
172	OS Water Network Lines Watercourse Form: Inland river Watercourse Length: 11.5 Watercourse Level: On ground surface Permanent: True Watercourse Name: Not Supplied Catchment Name: Ouse and Uck Primacy: 1	A3NE (S)	962	5	535561 123778

Map ID	Details	Quadrant Reference (Compass Direction)	Estimated Distance From Site	Contact	NGR
173	OS Water Network Lines Watercourse Form: Inland river Watercourse Length: 28.1 Watercourse Level: On ground surface Permanent: True Watercourse Name: Not Supplied Catchment Name: Ouse and Uck Primacy: 1	A19NE (NE)	965	5	536020 125677
174	OS Water Network Lines Watercourse Form: Inland river Watercourse Length: 19.8 Watercourse Level: On ground surface Permanent: True Watercourse Name: Not Supplied Catchment Name: Ouse and Uck Primacy: 1	A19NW (NE)	970	5	535826 125794
175	OS Water Network Lines Watercourse Form: Lake Watercourse Length: 14.0 Watercourse Level: On ground surface Permanent: True Watercourse Name: Not Supplied Catchment Name: Ouse and Uck Primacy: 1	A3NE (S)	973	5	535560 123767
176	OS Water Network Lines Watercourse Form: Inland river Watercourse Length: 13.4 Watercourse Level: On ground surface Permanent: True Watercourse Name: Not Supplied Catchment Name: Ouse and Uck Primacy: 1	A3NE (S)	983	5	535554 123755
177	OS Water Network Lines Watercourse Form: Inland river Watercourse Length: 8.2 Watercourse Level: On ground surface Permanent: True Watercourse Name: Not Supplied Catchment Name: Ouse and Uck Primacy: 1	A11SE (W)	984	5	534051 124816
178	OS Water Network Lines Watercourse Form: Inland river Watercourse Length: 22.6 Watercourse Level: On ground surface Permanent: True Watercourse Name: Not Supplied Catchment Name: Ouse and Uck Primacy: 1	A19NE (NE)	984	5	535978 125730
179	OS Water Network Lines Watercourse Form: Inland river Watercourse Length: 2.8 Watercourse Level: Underground Permanent: True Watercourse Name: Not Supplied Catchment Name: Ouse and Uck Primacy: 1	A19NE (NE)	984	5	535999 125715
180	OS Water Network Lines Watercourse Form: Inland river Watercourse Length: 3.4 Watercourse Level: Underground Permanent: True Watercourse Name: Not Supplied Catchment Name: Ouse and Uck Primacy: 1	A19NE (NE)	984	5	536047 125682
181	OS Water Network Lines Watercourse Form: Lake Watercourse Length: 14.8 Watercourse Level: On ground surface Permanent: True Watercourse Name: Not Supplied Catchment Name: Ouse and Uck Primacy: 1	A19NW (NE)	986	5	535843 125804

Map ID	Details	Quadrant Reference (Compass Direction)	Estimated Distance From Site	Contact	NGR
182	OS Water Network Lines Watercourse Form: Inland river Watercourse Length: 24.2 Watercourse Level: On ground surface Permanent: True Watercourse Name: Not Supplied Catchment Name: Ouse and Uck Primacy: 1	A19NE (NE)	987	5	536050 125683
183	OS Water Network Lines Watercourse Form: Inland river Watercourse Length: 49.3 Watercourse Level: On ground surface Permanent: True Watercourse Name: Scrase Stream Catchment Name: Ouse and Uck Primacy: 1	A11SE (W)	990	5	534045 124813
184	OS Water Network Lines Watercourse Form: Inland river Watercourse Length: 182.2 Watercourse Level: On ground surface Permanent: True Watercourse Name: Not Supplied Catchment Name: Ouse and Uck Primacy: 1	A10NW (E)	992	5	536344 124455
185	OS Water Network Lines Watercourse Form: Lake Watercourse Length: 50.9 Watercourse Level: On ground surface Permanent: True Watercourse Name: Not Supplied Catchment Name: Ouse and Uck Primacy: 1	A3NE (S)	994	5	535550 123742
186	OS Water Network Lines Watercourse Form: Inland river Watercourse Length: 79.7 Watercourse Level: On ground surface Permanent: True Watercourse Name: Not Supplied Catchment Name: Ouse and Uck Primacy: 1	A19NW (NE)	996	5	535857 125808

Map ID	Details	Quadrant Reference (Compass Direction)	Estimated Distance From Site	Contact	NGR
187	BGS Recorded Landfill Sites Site Name: Old Sewage Works Location: Easton Road, LINDFIELD, Sussex Authority: British Geological Survey, National Geoscience Information Service Ground Water: Information not available Surface Water: Information not available Geology: N/A Positional Accuracy: Positioned by the supplier Boundary Accuracy: Moderate	A13NW (N)	68	-	535237 125069
188	Historical Landfill Sites Licence Holder: Not Supplied Location: Lindfield, Sussex Name: Eastern Road Operator Location: Not Supplied Boundary Accuracy: As Supplied Provider Reference: EAHLD20018 First Input Date: 31st December 1945 Last Input Date: 31st July 1972 Specified Waste Type: Deposited Waste included Inert, Commercial, Household and Special Waste EA Waste Ref: 0 Regis Ref: Not Supplied WRC Ref: 3800/8124 BGS Ref: 442 Other Ref: 27/123, WD27/159	A13NW (N)	68	2	535237 125069
	Local Authority Landfill Coverage Name: Mid Sussex District Council - Has supplied landfill data		0	3	535243 124869
	Local Authority Landfill Coverage Name: West Sussex County Council - Has supplied landfill data		0	6	535243 124869
189	Local Authority Recorded Landfill Sites Location: Eastern Road Sewage Works, Lindfield Reference: 27/159 Authority: Mid Sussex District Council, Environmental Services Section Last Reported Status: Closed Types of Waste: Not Supplied Date of Closure: Not Supplied Positional Accuracy: Positioned by the supplier Boundary Quality: Moderate	A13NW (N)	60	3	535238 125061
190	Local Authority Recorded Landfill Sites Location: Eastern Road, Lindfield Reference: Not Supplied Authority: West Sussex County Council, Environment & Development Last Reported Status: Unknown Types of Waste: Not Supplied Date of Closure: Not Supplied Positional Accuracy: Positioned by the supplier Boundary Quality: Moderate	A13NW (N)	60	6	535238 125061
191	Potentially Infilled Land (Non-Water) Bearing Ref: N Use: Unknown Filled Ground (Pit, quarry etc) Date of Mapping: 1976	A23SE (N)	906	-	535367 125905
192	Potentially Infilled Land (Water) Use: Unknown Filled Ground (Pond, marsh, river, stream, dock etc) Date of Mapping: 1950	A13NW (NW)	151	-	535069 125100
193	Potentially Infilled Land (Water) Use: Unknown Filled Ground (Pond, marsh, river, stream, dock etc) Date of Mapping: 1950	A12NE (W)	405	-	534628 124965
194	Potentially Infilled Land (Water) Use: Unknown Filled Ground (Pond, marsh, river, stream, dock etc) Date of Mapping: 1950	A17SE (NW)	531	-	534836 125410
195	Potentially Infilled Land (Water) Use: Unknown Filled Ground (Pond, marsh, river, stream, dock etc) Date of Mapping: 1950	A17SE (NW)	533	-	534695 125328
196	Potentially Infilled Land (Water) Use: Unknown Filled Ground (Pond, marsh, river, stream, dock etc) Date of Mapping: 1950	A18NW (N)	620	-	535074 125623

Map ID	Details	Quadrant Reference (Compass Direction)	Estimated Distance From Site	Contact	NGR
197	Potentially Infilled Land (Water) Use: Unknown Filled Ground (Pond, marsh, river, stream, dock etc) Date of Mapping: 1950	A18NE (N)	652	-	535359 125646
198	Potentially Infilled Land (Water) Use: Unknown Filled Ground (Pond, marsh, river, stream, dock etc) Date of Mapping: 1899	A19SE (NE)	716	-	535995 125364
199	Potentially Infilled Land (Water) Use: Unknown Filled Ground (Pond, marsh, river, stream, dock etc) Date of Mapping: 1950	A19SW (NE)	733	-	535828 125527
200	Potentially Infilled Land (Water) Use: Unknown Filled Ground (Pond, marsh, river, stream, dock etc) Date of Mapping: 1950	A18NE (N)	777	-	535342 125778
201	Potentially Infilled Land (Water) Use: Unknown Filled Ground (Pond, marsh, river, stream, dock etc) Date of Mapping: 1961	A15SW (E)	900	-	536339 124738
202	Potentially Infilled Land (Water) Use: Unknown Filled Ground (Pond, marsh, river, stream, dock etc) Date of Mapping: 1961	A3NE (S)	917	-	535298 123780
203	Potentially Infilled Land (Water) Use: Unknown Filled Ground (Pond, marsh, river, stream, dock etc) Date of Mapping: 1950	A16SE (W)	924	-	534192 125304

Map ID	Details	Quadrant Reference (Compass Direction)	Estimated Distance From Site	Contact	NGR
	BGS 1:625,000 Solid Geology Description: Wealden Group	A13NE (NE)	0	1	535243 124869
	BGS Estimated Soil Chemistry Source: British Geological Survey, National Geoscience Information Service Soil Sample Type: Sediment Arsenic Concentration: 15 - 25 mg/kg Cadmium Concentration: <1.8 mg/kg Chromium Concentration: 60 - 90 mg/kg Lead Concentration: <100 mg/kg Nickel Concentration: 15 - 30 mg/kg	A13NE (NE)	0	1	535243 124869
	BGS Estimated Soil Chemistry Source: British Geological Survey, National Geoscience Information Service Soil Sample Type: Sediment Arsenic Concentration: <15 mg/kg Cadmium Concentration: <1.8 mg/kg Chromium Concentration: 60 - 90 mg/kg Lead Concentration: <100 mg/kg Nickel Concentration: 15 - 30 mg/kg	A13NE (N)	0	1	535243 125000
	BGS Estimated Soil Chemistry Source: British Geological Survey, National Geoscience Information Service Soil Sample Type: Sediment Arsenic Concentration: 15 - 25 mg/kg Cadmium Concentration: <1.8 mg/kg Chromium Concentration: 60 - 90 mg/kg Lead Concentration: <100 mg/kg Nickel Concentration: 15 - 30 mg/kg	A13NW (NW)	73	1	535010 125000
	BGS Estimated Soil Chemistry Source: British Geological Survey, National Geoscience Information Service Soil Sample Type: Sediment Arsenic Concentration: 15 - 25 mg/kg Cadmium Concentration: <1.8 mg/kg Chromium Concentration: 60 - 90 mg/kg Lead Concentration: <100 mg/kg Nickel Concentration: 15 - 30 mg/kg	A19NW (NE)	821	1	535708 125681
	BGS Estimated Soil Chemistry Source: British Geological Survey, National Geoscience Information Service Soil Sample Type: Sediment Arsenic Concentration: 15 - 25 mg/kg Cadmium Concentration: <1.8 mg/kg Chromium Concentration: 60 - 90 mg/kg Lead Concentration: <100 mg/kg Nickel Concentration: 15 - 30 mg/kg	A23SE (N)	985	1	535243 126000
204	BGS Recorded Mineral Sites Site Name: Gravelye Farm Pit Location: Haywards Heath, West Sussex Source: British Geological Survey, National Geoscience Information Service Reference: 152320 Type: Opencast Status: Ceased Operator: Unknown Operator Operator Location: Not Supplied Periodic Type: Cretaceous Geology: Upper Tunbridge Wells Sand Commodity: Iron Ore - Ironstone Positional Accuracy: Located by supplier to within 10m	A8NW (SW)	301	1	535024 124516

Map ID	Details	Quadrant Reference (Compass Direction)	Estimated Distance From Site	Contact	NGR
205	BGS Recorded Mineral Sites Site Name: Gravellye Farm Pit Location: Haywards Heath, West Sussex Source: British Geological Survey, National Geoscience Information Service Reference: 152321 Type: Opencast Status: Ceased Operator: Unknown Operator Operator Location: Not Supplied Periodic Type: Cretaceous Geology: Upper Tunbridge Wells Sand Commodity: Iron Ore - Ironstone Positional Accuracy: Located by supplier to within 10m	A8NW (SW)	344	1	534976 124501
206	BGS Recorded Mineral Sites Site Name: Gravellye Farm Pit Location: Haywards Heath, West Sussex Source: British Geological Survey, National Geoscience Information Service Reference: 152322 Type: Opencast Status: Ceased Operator: Unknown Operator Operator Location: Not Supplied Periodic Type: Cretaceous Geology: Upper Tunbridge Wells Sand Commodity: Iron Ore - Ironstone Positional Accuracy: Located by supplier to within 10m	A8NW (SW)	365	1	535006 124447
207	BGS Recorded Mineral Sites Site Name: Walstead Place Pits Location: Haywards Heath, West Sussex Source: British Geological Survey, National Geoscience Information Service Reference: 152323 Type: Opencast Status: Ceased Operator: Unknown Operator Operator Location: Not Supplied Periodic Type: Cretaceous Geology: Upper Tunbridge Wells Sand Commodity: Iron Ore - Ironstone Positional Accuracy: Located by supplier to within 10m	A8NE (SE)	510	1	535565 124278
207	BGS Recorded Mineral Sites Site Name: Walstead Place Pits Location: Haywards Heath, West Sussex Source: British Geological Survey, National Geoscience Information Service Reference: 152324 Type: Opencast Status: Ceased Operator: Unknown Operator Operator Location: Not Supplied Periodic Type: Cretaceous Geology: Upper Tunbridge Wells Sand Commodity: Iron Ore - Ironstone Positional Accuracy: Located by supplier to within 10m	A9NW (SE)	535	1	535586 124262
208	BGS Recorded Mineral Sites Site Name: Home Copse Pit Location: Haywards Heath, West Sussex Source: British Geological Survey, National Geoscience Information Service Reference: 152326 Type: Opencast Status: Ceased Operator: Unknown Operator Operator Location: Not Supplied Periodic Type: Cretaceous Geology: Upper Tunbridge Wells Sand Commodity: Sandstone Positional Accuracy: Located by supplier to within 10m	A9NE (SE)	887	1	536124 124290
209	BGS Recorded Mineral Sites Site Name: Lindfield Sand Pit Location: Lindfield, Haywards Heath, West Sussex Source: British Geological Survey, National Geoscience Information Service Reference: 152361 Type: Opencast Status: Ceased Operator: Unknown Operator Operator Location: Not Supplied Periodic Type: Cretaceous Geology: Upper Tunbridge Wells Sand Commodity: Sand Positional Accuracy: Located by supplier to within 10m	A23SE (N)	903	1	535341 125906

Map ID	Details	Quadrant Reference (Compass Direction)	Estimated Distance From Site	Contact	NGR
210	BGS Recorded Mineral Sites Site Name: Nether Walstead House Pit Location: Haywards Heath, West Sussex Source: British Geological Survey, National Geoscience Information Service Reference: 152325 Type: Opencast Status: Ceased Operator: Unknown Operator Operator Location: Not Supplied Periodic Type: Cretaceous Geology: Upper Tunbridge Wells Sand Commodity: Mineral Positional Accuracy: Located by supplier to within 10m	A15SW (E)	931	1	536370 124737
211	BGS Recorded Mineral Sites Site Name: Bedales Pits Location: Haywards Heath, West Sussex Source: British Geological Survey, National Geoscience Information Service Reference: 152331 Type: Opencast Status: Ceased Operator: Unknown Operator Operator Location: Not Supplied Periodic Type: Cretaceous Geology: Upper Tunbridge Wells Sand Commodity: Iron Ore - Ironstone Positional Accuracy: Located by supplier to within 10m	A3NE (S)	955	1	535487 123766
212	BGS Recorded Mineral Sites Site Name: Bedales Pits Location: Haywards Heath, West Sussex Source: British Geological Survey, National Geoscience Information Service Reference: 152332 Type: Opencast Status: Ceased Operator: Unknown Operator Operator Location: Not Supplied Periodic Type: Cretaceous Geology: Upper Tunbridge Wells Sand Commodity: Iron Ore - Ironstone Positional Accuracy: Located by supplier to within 10m	A4NW (S)	956	1	535632 123811
	BGS Measured Urban Soil Chemistry No data available				
	BGS Urban Soil Chemistry Averages No data available				
	Coal Mining Affected Areas In an area that might not be affected by coal mining				
	Mining Instability Mining Evidence: Inconclusive Iron Ore Mining Source: Ove Arup & Partners Boundary Quality: As Supplied	A13NE (NE)	0	-	535243 124869
	Non Coal Mining Areas of Great Britain No Hazard				
	Potential for Collapsible Ground Stability Hazards Hazard Potential: Very Low Source: British Geological Survey, National Geoscience Information Service	A13NE (N)	0	1	535243 125000
	Potential for Collapsible Ground Stability Hazards Hazard Potential: No Hazard Source: British Geological Survey, National Geoscience Information Service	A13NW (NW)	0	1	535155 124998
	Potential for Collapsible Ground Stability Hazards Hazard Potential: Very Low Source: British Geological Survey, National Geoscience Information Service	A13NE (NE)	0	1	535243 124869
	Potential for Collapsible Ground Stability Hazards Hazard Potential: No Hazard Source: British Geological Survey, National Geoscience Information Service	A13NW (NW)	10	1	535158 125000
	Potential for Collapsible Ground Stability Hazards Hazard Potential: No Hazard Source: British Geological Survey, National Geoscience Information Service	A13NW (W)	30	1	535000 124872
	Potential for Collapsible Ground Stability Hazards Hazard Potential: Very Low Source: British Geological Survey, National Geoscience Information Service	A13NW (W)	49	1	535000 124869

Map ID	Details	Quadrant Reference (Compass Direction)	Estimated Distance From Site	Contact	NGR
	Potential for Collapsible Ground Stability Hazards Hazard Potential: Very Low Source: British Geological Survey, National Geoscience Information Service	A13NW (NW)	73	1	535000 124989
	Potential for Collapsible Ground Stability Hazards Hazard Potential: Very Low Source: British Geological Survey, National Geoscience Information Service	A13NW (NW)	81	1	535010 125000
	Potential for Collapsible Ground Stability Hazards Hazard Potential: Very Low Source: British Geological Survey, National Geoscience Information Service	A13NW (NW)	86	1	535111 125062
	Potential for Collapsible Ground Stability Hazards Hazard Potential: Very Low Source: British Geological Survey, National Geoscience Information Service	A13NW (NW)	91	1	535000 125000
	Potential for Compressible Ground Stability Hazards Hazard Potential: No Hazard Source: British Geological Survey, National Geoscience Information Service	A13NE (N)	0	1	535243 125000
	Potential for Compressible Ground Stability Hazards Hazard Potential: No Hazard Source: British Geological Survey, National Geoscience Information Service	A13NE (NE)	0	1	535243 124869
	Potential for Compressible Ground Stability Hazards Hazard Potential: Moderate Source: British Geological Survey, National Geoscience Information Service	A13NW (NW)	0	1	535155 124998
	Potential for Compressible Ground Stability Hazards Hazard Potential: Moderate Source: British Geological Survey, National Geoscience Information Service	A13NW (NW)	10	1	535158 125000
	Potential for Compressible Ground Stability Hazards Hazard Potential: Moderate Source: British Geological Survey, National Geoscience Information Service	A13NW (W)	30	1	535000 124872
	Potential for Compressible Ground Stability Hazards Hazard Potential: No Hazard Source: British Geological Survey, National Geoscience Information Service	A13NW (W)	49	1	535000 124869
	Potential for Compressible Ground Stability Hazards Hazard Potential: No Hazard Source: British Geological Survey, National Geoscience Information Service	A13NW (NW)	73	1	535000 124989
	Potential for Compressible Ground Stability Hazards Hazard Potential: No Hazard Source: British Geological Survey, National Geoscience Information Service	A13NW (NW)	81	1	535010 125000
	Potential for Compressible Ground Stability Hazards Hazard Potential: No Hazard Source: British Geological Survey, National Geoscience Information Service	A13NW (NW)	86	1	535111 125062
	Potential for Compressible Ground Stability Hazards Hazard Potential: No Hazard Source: British Geological Survey, National Geoscience Information Service	A13NW (NW)	91	1	535000 125000
	Potential for Ground Dissolution Stability Hazards Hazard Potential: No Hazard Source: British Geological Survey, National Geoscience Information Service	A13NE (NE)	0	1	535243 124869
	Potential for Ground Dissolution Stability Hazards Hazard Potential: No Hazard Source: British Geological Survey, National Geoscience Information Service	A13NE (N)	0	1	535243 125000
	Potential for Ground Dissolution Stability Hazards Hazard Potential: No Hazard Source: British Geological Survey, National Geoscience Information Service	A13NW (W)	30	1	535000 124869
	Potential for Ground Dissolution Stability Hazards Hazard Potential: No Hazard Source: British Geological Survey, National Geoscience Information Service	A13NW (NW)	91	1	535000 125000
	Potential for Landslide Ground Stability Hazards Hazard Potential: Very Low Source: British Geological Survey, National Geoscience Information Service	A13NE (NE)	0	1	535243 124869
	Potential for Landslide Ground Stability Hazards Hazard Potential: Very Low Source: British Geological Survey, National Geoscience Information Service	A13NE (N)	0	1	535243 125000
	Potential for Landslide Ground Stability Hazards Hazard Potential: Very Low Source: British Geological Survey, National Geoscience Information Service	A13NW (W)	30	1	535000 124869

Map ID	Details	Quadrant Reference (Compass Direction)	Estimated Distance From Site	Contact	NGR
	Potential for Landslide Ground Stability Hazards Hazard Potential: Very Low Source: British Geological Survey, National Geoscience Information Service	A13NW (NW)	91	1	535000 125000
	Potential for Running Sand Ground Stability Hazards Hazard Potential: Low Source: British Geological Survey, National Geoscience Information Service	A13NW (NW)	0	1	535155 124998
	Potential for Running Sand Ground Stability Hazards Hazard Potential: No Hazard Source: British Geological Survey, National Geoscience Information Service	A13NE (N)	0	1	535243 125000
	Potential for Running Sand Ground Stability Hazards Hazard Potential: No Hazard Source: British Geological Survey, National Geoscience Information Service	A13NE (NE)	0	1	535243 124869
	Potential for Running Sand Ground Stability Hazards Hazard Potential: Low Source: British Geological Survey, National Geoscience Information Service	A13NW (NW)	10	1	535158 125000
	Potential for Running Sand Ground Stability Hazards Hazard Potential: Low Source: British Geological Survey, National Geoscience Information Service	A13NW (W)	30	1	535000 124872
	Potential for Running Sand Ground Stability Hazards Hazard Potential: No Hazard Source: British Geological Survey, National Geoscience Information Service	A13NW (W)	49	1	535000 124869
	Potential for Running Sand Ground Stability Hazards Hazard Potential: No Hazard Source: British Geological Survey, National Geoscience Information Service	A13NW (NW)	73	1	535000 124989
	Potential for Running Sand Ground Stability Hazards Hazard Potential: No Hazard Source: British Geological Survey, National Geoscience Information Service	A13NW (NW)	81	1	535010 125000
	Potential for Running Sand Ground Stability Hazards Hazard Potential: No Hazard Source: British Geological Survey, National Geoscience Information Service	A13NW (NW)	86	1	535111 125062
	Potential for Running Sand Ground Stability Hazards Hazard Potential: No Hazard Source: British Geological Survey, National Geoscience Information Service	A13NW (NW)	91	1	535000 125000
	Potential for Shrinking or Swelling Clay Ground Stability Hazards Hazard Potential: Very Low Source: British Geological Survey, National Geoscience Information Service	A13NW (NW)	0	1	535155 124998
	Potential for Shrinking or Swelling Clay Ground Stability Hazards Hazard Potential: No Hazard Source: British Geological Survey, National Geoscience Information Service	A13NE (NE)	0	1	535243 124869
	Potential for Shrinking or Swelling Clay Ground Stability Hazards Hazard Potential: No Hazard Source: British Geological Survey, National Geoscience Information Service	A13NE (N)	0	1	535243 125000
	Potential for Shrinking or Swelling Clay Ground Stability Hazards Hazard Potential: Very Low Source: British Geological Survey, National Geoscience Information Service	A13NW (NW)	10	1	535158 125000
	Potential for Shrinking or Swelling Clay Ground Stability Hazards Hazard Potential: Very Low Source: British Geological Survey, National Geoscience Information Service	A13NW (W)	30	1	535000 124872
	Potential for Shrinking or Swelling Clay Ground Stability Hazards Hazard Potential: No Hazard Source: British Geological Survey, National Geoscience Information Service	A13NW (W)	49	1	535000 124869
	Potential for Shrinking or Swelling Clay Ground Stability Hazards Hazard Potential: No Hazard Source: British Geological Survey, National Geoscience Information Service	A13NW (NW)	73	1	535000 124989
	Potential for Shrinking or Swelling Clay Ground Stability Hazards Hazard Potential: No Hazard Source: British Geological Survey, National Geoscience Information Service	A13NW (NW)	81	1	535010 125000
	Potential for Shrinking or Swelling Clay Ground Stability Hazards Hazard Potential: No Hazard Source: British Geological Survey, National Geoscience Information Service	A13NW (NW)	86	1	535111 125062
	Potential for Shrinking or Swelling Clay Ground Stability Hazards Hazard Potential: No Hazard Source: British Geological Survey, National Geoscience Information Service	A13NW (NW)	91	1	535000 125000

Map ID	Details	Quadrant Reference (Compass Direction)	Estimated Distance From Site	Contact	NGR
	Radon Potential - Radon Affected Areas Affected Area: The property is in a Lower probability radon area (less than 1% of homes are estimated to be at or above the Action Level). Source: British Geological Survey, National Geoscience Information Service	A13NE (N)	0	1	535243 125000
	Radon Potential - Radon Affected Areas Affected Area: The property is in a Lower probability radon area (less than 1% of homes are estimated to be at or above the Action Level). Source: British Geological Survey, National Geoscience Information Service	A13NE (NE)	0	1	535243 124869
	Radon Potential - Radon Protection Measures Protection Measure: No radon protective measures are necessary in the construction of new dwellings or extensions Source: British Geological Survey, National Geoscience Information Service	A13NE (N)	0	1	535243 125000
	Radon Potential - Radon Protection Measures Protection Measure: No radon protective measures are necessary in the construction of new dwellings or extensions Source: British Geological Survey, National Geoscience Information Service	A13NE (NE)	0	1	535243 124869

Map ID	Details	Quadrant Reference (Compass Direction)	Estimated Distance From Site	Contact	NGR
213	Contemporary Trade Directory Entries Name: Bruce Copen Laboratories Ltd Location: Unit 4, Lindfield Enterprise Park, Lewes Road, Lindfield, HAYWARDS HEATH, West Sussex, RH16 2LX Classification: Laboratory Equipment, Instruments & Supplies Status: Inactive Positional Accuracy: Automatically positioned to the address	A13NW (W)	44	-	535020 124957
213	Contemporary Trade Directory Entries Name: Harbeth Audio Ltd Location: Unit 3, Lindfield Enterprise Park, Lewes Road, Lindfield, Haywards Heath, RH16 2LH Classification: Sound Equipment Systems Manufacturers Status: Active Positional Accuracy: Automatically positioned to the address	A13NW (W)	50	-	535017 124962
213	Contemporary Trade Directory Entries Name: Harbeth Audio Ltd. Location: Unit 3, Lindfield Enterprise Park, Lewes Road, Lindfield, Haywards Heath, West Sussex, RH16 2LH Classification: Sound Equipment Systems Manufacturers Status: Inactive Positional Accuracy: Automatically positioned to the address	A13NW (NW)	52	-	535017 124964
213	Contemporary Trade Directory Entries Name: Kaycee Veterinary Products Ltd Location: Unit 14, Lindfield Enterprise Park, Lewes Road, Lindfield, Haywards Heath, West Sussex, RH16 2LH Classification: Veterinary Equipment Manufacturers Status: Inactive Positional Accuracy: Automatically positioned to the address	A13NW (NW)	55	-	535078 124994
213	Contemporary Trade Directory Entries Name: A J D Instruments Location: Unit 9, Lindfield Enterprise Park, Lewes Road, Lindfield, Haywards Heath, West Sussex, RH16 2LH Classification: Gauge Manufacturers & Distributors Status: Inactive Positional Accuracy: Automatically positioned to the address	A13NW (NW)	57	-	535047 124986
213	Contemporary Trade Directory Entries Name: Ian Duffell Location: Unit 10, Lindfield Enterprise Park, Lewes Road, Lindfield, Haywards Heath, RH16 2LH Classification: Joinery Manufacturers Status: Inactive Positional Accuracy: Automatically positioned to the address	A13NW (NW)	57	-	535053 124988
213	Contemporary Trade Directory Entries Name: Switchpoint Ltd Location: Unit 2, Lindfield Enterprise Park, Lewes Road, Lindfield, Haywards Heath, West Sussex, RH16 2LH Classification: Control Panel Manufacturers Status: Inactive Positional Accuracy: Automatically positioned to the address	A13NW (NW)	58	-	535013 124969
213	Contemporary Trade Directory Entries Name: Sentinel Laboratories Ltd Location: Unit 12-13, Lindfield Enterprise Park, Lewes Road, Lindfield, HAYWARDS HEATH, West Sussex, RH16 2LH Classification: Laboratory Equipment, Instruments & Supplies Status: Active Positional Accuracy: Automatically positioned to the address	A13NW (NW)	60	-	535067 124997
213	Contemporary Trade Directory Entries Name: Campanile Location: Clock Tower, Lindfield Enterprise Park, Lewes Road, Lindfield, Haywards Heath, West Sussex, RH16 2LH Classification: Stone Products - Manufacturers Status: Inactive Positional Accuracy: Manually positioned to the address or location	A13NW (NW)	67	-	535029 124989
213	Contemporary Trade Directory Entries Name: Lindfield Garage Location: MacWalter House, Lewes Road, Lindfield, HAYWARDS HEATH, West Sussex, RH16 2LQ Classification: Car Dealers Status: Inactive Positional Accuracy: Automatically positioned to the address	A13NW (NW)	87	-	535004 124998

Map ID	Details	Quadrant Reference (Compass Direction)	Estimated Distance From Site	Contact	NGR
214	Contemporary Trade Directory Entries Name: Lindfield Autobarn Location: Flat 1, MacWalder House, Lewes Road, Lindfield, Haywards Heath, West Sussex, RH16 2LQ Classification: Car Dealers Status: Inactive Positional Accuracy: Automatically positioned to the address	A13NW (NW)	85	-	534996 124992
215	Contemporary Trade Directory Entries Name: Cws Commericals Ltd Location: 5, Noahs Ark Lane, Haywards Heath, West Sussex, RH16 2LU Classification: Car Body Repairs Status: Inactive Positional Accuracy: Automatically positioned to the address	A13NW (NW)	159	-	535002 125077
216	Contemporary Trade Directory Entries Name: Walstead Location: Lewes Rd, Lindfield, Haywards Heath, West Sussex, RH16 2LE Classification: Cemeteries & Crematoria Status: Inactive Positional Accuracy: Manually positioned to the address or location	A14SW (E)	348	-	535738 124680
217	Contemporary Trade Directory Entries Name: Lindfield Motors Location: Lewes Road, Lindfield, Haywards Heath, RH16 2LG Classification: Garage Services Status: Active Positional Accuracy: Automatically positioned to the address	A17SE (NW)	361	-	534845 125224
217	Contemporary Trade Directory Entries Name: Lindfield Motors Location: Lewes Road, Lindfield, HAYWARDS HEATH, West Sussex, RH16 2LG Classification: Garage Services Status: Inactive Positional Accuracy: Automatically positioned to the address	A17SE (NW)	363	-	534843 125225
218	Contemporary Trade Directory Entries Name: W E Upton Location: Walstead Forge, East Mascalls Lane, Lindfield, Haywards Heath, West Sussex, RH16 2QJ Classification: Blacksmiths & Forgemasters Status: Inactive Positional Accuracy: Automatically positioned to the address	A14NW (E)	390	-	535831 124990
219	Contemporary Trade Directory Entries Name: Tisburys Cleaning Services Location: 44, Newton Road, Lindfield, Haywards Heath, RH16 2ND Classification: Cleaning Services - Domestic Status: Inactive Positional Accuracy: Automatically positioned to the address	A18SW (NW)	412	-	534976 125362
220	Contemporary Trade Directory Entries Name: Yves Lebrech Location: Milton House, Black Hill, Haywards Heath, West Sussex, RH16 2HE Classification: Printers Status: Inactive Positional Accuracy: Automatically positioned to the address	A17SW (NW)	596	-	534526 125232
221	Contemporary Trade Directory Entries Name: Lindfield Location: 4, Denmans Lane, Haywards Heath, West Sussex, RH16 2LB Classification: Dry Cleaners Status: Inactive Positional Accuracy: Automatically positioned to the address	A17SE (NW)	647	-	534646 125435
222	Contemporary Trade Directory Entries Name: Carter & Faraday Associates Location: Unit 3-5, Pelham Farm, East Mascalls Lane, Lindfield, Haywards Heath, West Sussex, RH16 2QJ Classification: Commercial Cleaning Services Status: Active Positional Accuracy: Automatically positioned to the address	A14NE (E)	698	-	536149 124942
223	Contemporary Trade Directory Entries Name: Clean Machine Location: 52, Wilmington Way, Haywards Heath, RH16 3UJ Classification: Commercial Cleaning Services Status: Inactive Positional Accuracy: Automatically positioned to the address	A7NW (SW)	709	-	534485 124456

Map ID	Details	Quadrant Reference (Compass Direction)	Estimated Distance From Site	Contact	NGR
224	Contemporary Trade Directory Entries Name: Sussex Carpet Cleaners Location: 43, Denmans Lane, Lindfield, Haywards Heath, West Sussex, RH16 2JN Classification: Carpet, Curtain & Upholstery Cleaners Status: Inactive Positional Accuracy: Automatically positioned to the address	A17SW (NW)	809	-	534435 125462
225	Contemporary Trade Directory Entries Name: Emerald Cleaning Ltd Location: 18, Hanbury Lane, Haywards Heath, West Sussex, RH16 3HU Classification: Commercial Cleaning Services Status: Inactive Positional Accuracy: Automatically positioned to the address	A7NW (SW)	822	-	534436 124338
226	Contemporary Trade Directory Entries Name: Return To Comforts Location: 3, Kiln Lane, Lindfield, Haywards Heath, West Sussex, RH16 2SZ Classification: Cleaning Services - Domestic Status: Inactive Positional Accuracy: Automatically positioned to the address	A7SE (SW)	877	-	534587 124125
227	Contemporary Trade Directory Entries Name: Pro Audio Cabinet Services Location: High St, Lindfield, Haywards Heath, West Sussex, RH16 2HU Classification: Sound Equipment Systems Manufacturers Status: Inactive Positional Accuracy: Manually positioned to the road within the address or location	A22SE (N)	939	-	534876 125897
228	Contemporary Trade Directory Entries Name: T F Awcock Location: Chimney Corner, High Street, Lindfield, Haywards Heath, West Sussex, RH16 2HU Classification: Car Body Repairs Status: Inactive Positional Accuracy: Automatically positioned to the address	A23SW (N)	995	-	535009 125992
228	Contemporary Trade Directory Entries Name: Lakers Of Lindfield Location: Chimney Corner, High Street, Lindfield, Haywards Heath, West Sussex, RH16 2HU Classification: Garage Services Status: Inactive Positional Accuracy: Automatically positioned to the address	A23SW (N)	995	-	535009 125992
229	Fuel Station Entries Name: Lindfield Motors Location: Lewes Road , Lindfield Village , Haywards Heath, West Sussex, RH16 2LG Brand: Obsolete Premises Type: Not Applicable Status: Obsolete Positional Accuracy: Approximate location provided by supplier	A18SW (NW)	320	-	534980 125250
230	Points of Interest - Commercial Services Name: Sussex Mobile Mechanics Location: 32 East Wick, Lindfield, Haywards Heath, RH16 2TH Category: Repair and Servicing Class Code: Vehicle Repair, Testing and Servicing Positional Accuracy: Positioned to address or location	A13NW (NW)	116	7	535019 125038
231	Points of Interest - Commercial Services Name: Lindfield Pest Control Location: 65 Newton Road, Lindfield, Haywards Heath, RH16 2NB Category: Contract Services Class Code: Pest and Vermin Control Positional Accuracy: Positioned to address or location	A18SW (N)	296	7	535154 125307
232	Points of Interest - Commercial Services Name: Lindfield Motors Location: Lewes Road, Lindfield, RH16 2LG Category: Repair and Servicing Class Code: Vehicle Repair, Testing and Servicing Positional Accuracy: Positioned to address or location	A17SE (NW)	361	7	534845 125224
232	Points of Interest - Commercial Services Name: Lindfield Motors Location: Lewes Road, Lindfield, Haywards Heath, RH16 2LG Category: Repair and Servicing Class Code: Vehicle Repair, Testing and Servicing Positional Accuracy: Positioned to address or location	A17SE (NW)	363	7	534843 125225

Map ID	Details	Quadrant Reference (Compass Direction)	Estimated Distance From Site	Contact	NGR
232	Points of Interest - Commercial Services Name: Lindfield Motors Location: Lewes Road, Lindfield, Haywards Heath, RH16 2LG Category: Repair and Servicing Class Code: Vehicle Repair, Testing and Servicing Positional Accuracy: Positioned to address or location	A17SE (NW)	363	7	534843 125225
233	Points of Interest - Commercial Services Name: W E Upton Location: East Mascalls Lane, Lindfield, RH16 2QJ Category: Construction Services Class Code: Metalworkers Including Blacksmiths Positional Accuracy: Positioned to address or location	A14NW (E)	396	7	535839 124982
234	Points of Interest - Commercial Services Name: Roy Pontifex Ltd Location: 106 High Street, Lindfield, RH16 2HS Category: Recycling Services Class Code: Recycling, Reclamation and Disposal Positional Accuracy: Positioned to address or location	A17NE (NW)	805	7	534841 125737
235	Points of Interest - Commercial Services Name: T F Awcock Location: Chimney Corner, High Street, Lindfield, Haywards Heath, RH16 2HU Category: Repair and Servicing Class Code: Vehicle Repair, Testing and Servicing Positional Accuracy: Positioned to address or location	A23SW (N)	995	7	535009 125992
235	Points of Interest - Commercial Services Name: T F Awcock Location: Chimney Corner, High Street, Lindfield, Haywards Heath, RH16 2HU Category: Repair and Servicing Class Code: Vehicle Repair, Testing and Servicing Positional Accuracy: Positioned to address or location	A23SW (N)	995	7	535009 125992
236	Points of Interest - Manufacturing and Production Name: Enterprise Park Location: RH16 Category: Industrial Features Class Code: Business Parks and Industrial Estates Positional Accuracy: Positioned to an adjacent address or location	A13NW (NW)	39	7	535060 124972
237	Points of Interest - Manufacturing and Production Name: Tank Location: RH16 Category: Industrial Features Class Code: Tanks (Generic) Positional Accuracy: Positioned to an adjacent address or location	A8NE (S)	281	7	535319 124419
238	Points of Interest - Public Infrastructure Name: Weir Location: RH16 Category: Water Class Code: Weirs, Sluices and Dams Positional Accuracy: Positioned to an adjacent address or location	A13SE (SE)	74	7	535396 124728
239	Points of Interest - Public Infrastructure Name: Walstead Cemetery Location: RH16 Category: Infrastructure and Facilities Class Code: Cemeteries and Crematoria Positional Accuracy: Positioned to an adjacent address or location	A14SW (E)	348	7	535736 124676
239	Points of Interest - Public Infrastructure Name: Walstead Cemetery Location: Lewes Rd, Lindfield, Haywards Heath, West Sussex, RH16 2LE Category: Infrastructure and Facilities Class Code: Cemeteries and Crematoria Positional Accuracy: Positioned to address or location	A14SW (E)	348	7	535738 124680
239	Points of Interest - Public Infrastructure Name: Walstead Cemetery Location: Lewes Road, Lindfield, Haywards Heath, RH16 2LE Category: Infrastructure and Facilities Class Code: Cemeteries and Crematoria Positional Accuracy: Positioned to address or location	A14SW (E)	348	7	535738 124680
240	Points of Interest - Public Infrastructure Name: Weir Location: RH16 Category: Water Class Code: Weirs, Sluices and Dams Positional Accuracy: Positioned to an adjacent address or location	A12SE (W)	414	7	534659 124730

Map ID	Details	Quadrant Reference (Compass Direction)	Estimated Distance From Site	Contact	NGR
240	Points of Interest - Public Infrastructure Name: Weir Location: RH16 Category: Water Class Code: Weirs, Sluices and Dams Positional Accuracy: Positioned to an adjacent address or location	A12SE (W)	417	7	534656 124728
241	Points of Interest - Public Infrastructure Name: Weir Location: RH16 Category: Water Class Code: Weirs, Sluices and Dams Positional Accuracy: Positioned to an adjacent address or location	A12SW (W)	708	7	534394 124603
241	Points of Interest - Public Infrastructure Name: Weir Location: RH16 Category: Water Class Code: Weirs, Sluices and Dams Positional Accuracy: Positioned to an adjacent address or location	A12SW (W)	711	7	534391 124602
242	Points of Interest - Public Infrastructure Name: Weir Location: RH16 Category: Water Class Code: Weirs, Sluices and Dams Positional Accuracy: Positioned to an adjacent address or location	A11SE (W)	959	7	534092 124713
242	Points of Interest - Public Infrastructure Name: Weir Location: RH16 Category: Water Class Code: Weirs, Sluices and Dams Positional Accuracy: Positioned to an adjacent address or location	A11SE (W)	961	7	534090 124712
243	Points of Interest - Recreational and Environmental Name: Play Area Location: RH16 Category: Recreational Class Code: Playgrounds Positional Accuracy: Positioned to an adjacent address or location	A13SW (SW)	160	7	535126 124615
244	Points of Interest - Recreational and Environmental Name: Playground Location: Not Supplied Category: Recreational Class Code: Playgrounds Positional Accuracy: Positioned to an adjacent address or location	A12NE (NW)	383	7	534743 125168
244	Points of Interest - Recreational and Environmental Name: Playground Location: Old School Court, RH16 Category: Recreational Class Code: Playgrounds Positional Accuracy: Positioned to an adjacent address or location	A12NE (NW)	388	7	534736 125168
245	Points of Interest - Recreational and Environmental Name: Play Area Location: RH16 Category: Recreational Class Code: Playgrounds Positional Accuracy: Positioned to an adjacent address or location	A18SW (N)	516	7	535135 125527
246	Points of Interest - Recreational and Environmental Name: Play Area Location: RH16 Category: Recreational Class Code: Playgrounds Positional Accuracy: Positioned to an adjacent address or location	A8SW (S)	566	7	535093 124160
247	Points of Interest - Recreational and Environmental Name: Play Area Location: Lexington Drive, RH16 Category: Recreational Class Code: Playgrounds Positional Accuracy: Positioned to address or location	A7NW (SW)	677	7	534522 124461
247	Points of Interest - Recreational and Environmental Name: Playground Location: Not Supplied Category: Recreational Class Code: Playgrounds Positional Accuracy: Positioned to an adjacent address or location	A7NW (SW)	706	7	534524 124413

Map ID	Details	Quadrant Reference (Compass Direction)	Estimated Distance From Site	Contact	NGR
248	Points of Interest - Recreational and Environmental Name: Playground Location: Not Supplied Category: Recreational Class Code: Playgrounds Positional Accuracy: Positioned to an adjacent address or location	A7NW (SW)	778	7	534387 124475
248	Points of Interest - Recreational and Environmental Name: Playground Location: Portland Close, RH16 Category: Recreational Class Code: Playgrounds Positional Accuracy: Positioned to an adjacent address or location	A7NW (SW)	784	7	534381 124474
249	Points of Interest - Recreational and Environmental Name: Playground Location: America Lane, RH16 Category: Recreational Class Code: Playgrounds Positional Accuracy: Positioned to address or location	A7NW (SW)	864	7	534393 124323
249	Points of Interest - Recreational and Environmental Name: Playground Location: Not Supplied Category: Recreational Class Code: Playgrounds Positional Accuracy: Positioned to an adjacent address or location	A7NW (SW)	865	7	534391 124323
249	Points of Interest - Recreational and Environmental Name: Play Area Location: RH16 Category: Recreational Class Code: Playgrounds Positional Accuracy: Positioned to an adjacent address or location	A7NW (SW)	936	7	534318 124301

Map ID	Details	Quadrant Reference (Compass Direction)	Estimated Distance From Site	Contact	NGR
250	Ancient Woodland Name: Little Walstead Wood Reference: 1479471 Area(m²): 28987.13 Type: Ancient and Semi-Natural Woodland	A13NE (NE)	0	8	535360 124934
251	Ancient Woodland Name: Snowflakes Wood Reference: 1479586 Area(m²): 11787.12 Type: Ancient and Semi-Natural Woodland	A14NW (E)	386	8	535833 124960
252	Ancient Woodland Name: Bacckwood Farm Woode Reference: 1479292 Area(m²): 9208.49 Type: Ancient and Semi-Natural Woodland	A12SE (SW)	520	8	534610 124607
253	Ancient Woodland Name: Beech Mead Wood Reference: 1479301 Area(m²): 15901.11 Type: Plantation on Ancient Woodland	A9NE (SE)	691	8	535937 124371
254	Ancient Woodland Name: Beech Mead Wood Reference: 1479300 Area(m²): 15520.35 Type: Ancient and Semi-Natural Woodland	A9NW (SE)	706	8	535813 124240
255	Ancient Woodland Name: Sluts Lane Wood Reference: 1479585 Area(m²): 23887.53 Type: Ancient and Semi-Natural Woodland	A9SW (SE)	794	8	535724 124043
256	Ancient Woodland Name: Bacckwood Farm Woodw Reference: 1479293 Area(m²): 9525.27 Type: Ancient and Semi-Natural Woodland	A7NW (W)	808	8	534333 124504
257	Ancient Woodland Name: Home Copse Reference: 1479439 Area(m²): 16620.05 Type: Ancient and Semi-Natural Woodland	A9NE (SE)	870	8	536103 124291
258	Ancient Woodland Name: Hangmans Acre Shaw Reference: 1479698 Area(m²): 6705.81 Type: Ancient and Semi-Natural Woodland	A19NW (NE)	917	8	535858 125720
259	Ancient Woodland Name: Hangmans Acre Copse Reference: 1479699 Area(m²): 4833.13 Type: Ancient and Semi-Natural Woodland	A19NW (NE)	943	8	535693 125823
260	Ancient Woodland Name: Henfields Wood Reference: 1480630 Area(m²): 404630.79 Type: Ancient and Semi-Natural Woodland	A15SW (E)	960	8	536353 124563
261	Areas of Outstanding Natural Beauty Name: High Weald Multiple Areas: Y Total Area (m2): 1461737820.6571908 Designation Date: 30th October 1983 Source: Natural England	A19NW (NE)	871	8	535908 125642
262	Local Nature Reserves Name: Eastern Road Nature Reserve Multiple Area: N Area (m2): 35177.07 Source: Natural England Designation Date: Not Supplied	A13NW (N)	61	8	535237 125062

Map ID	Details	Quadrant Reference (Compass Direction)	Estimated Distance From Site	Contact	NGR
263	Local Nature Reserves Name: Scrase Valley Multiple Area: N Area (m2): 80246.69 Source: Natural England Designation Date: 1st January 1990	A12SE (W)	321	8	534764 124733

Agency & Hydrological	Version	Update Cycle
Contaminated Land Register Entries and Notices Environment Agency - Head Office Lewes District Council - Environmental Health Department Mid Sussex District Council - Environmental Services Section Wealden District Council - Environmental Health Department	November 2023 October 2017 October 2017 October 2017	Annually Annual Rolling Update Annual Rolling Update Annual Rolling Update
Discharge Consents Environment Agency - Southern Region	October 2023	Quarterly
Enforcement and Prohibition Notices Environment Agency - Southern Region	March 2013	
Integrated Pollution Controls Environment Agency - Southern Region	January 2009	
Integrated Pollution Prevention And Control Environment Agency - South East Region - Solent & South Downs Area Environment Agency - Southern Region	January 2023 January 2023	Quarterly Quarterly
Local Authority Integrated Pollution Prevention And Control Mid Sussex District Council - Environmental Services Section Wealden District Council - Environmental Health Department Lewes District Council - Environmental Health Department	December 2020 December 2020 June 2016	Variable Variable Variable
Local Authority Pollution Prevention and Controls Mid Sussex District Council - Environmental Services Section Wealden District Council - Environmental Health Department Lewes District Council - Environmental Health Department	December 2020 December 2020 June 2016	Annual Rolling Update Annual Rolling Update Annual Rolling Update
Local Authority Pollution Prevention and Control Enforcements Wealden District Council - Environmental Health Department Lewes District Council - Environmental Health Department Mid Sussex District Council - Environmental Services Section	June 2014 June 2016 September 2014	Variable Variable Variable
Nearest Surface Water Feature Ordnance Survey	December 2023	
Pollution Incidents to Controlled Waters Environment Agency - Southern Region	December 1999	
Prosecutions Relating to Authorised Processes Environment Agency - Southern Region	July 2015	
Prosecutions Relating to Controlled Waters Environment Agency - Southern Region	March 2013	
Registered Radioactive Substances Environment Agency - Southern Region Environment Agency - Head Office	June 2016 May 2023	As notified Quarterly
River Quality Environment Agency - Head Office	November 2001	Not Applicable
River Quality Biology Sampling Points Environment Agency - Head Office	April 2012	
River Quality Chemistry Sampling Points Environment Agency - Head Office	April 2012	
Substantiated Pollution Incident Register Environment Agency - South East Region - Solent & South Downs Area Environment Agency - Southern Region - Kent and East Sussex Environment Agency - Southern Region - Solent and South Downs Environment Agency - Southern Region - Sussex Area	October 2023 October 2023 October 2023 October 2023	Quarterly Quarterly Quarterly Quarterly
Water Abstractions Environment Agency - Southern Region	October 2023	Quarterly
Water Industry Act Referrals Environment Agency - Southern Region	October 2017	

Agency & Hydrological	Version	Update Cycle
Groundwater Vulnerability Map Environment Agency - Head Office	June 2018	As notified
Bedrock Aquifer Designations Environment Agency - Head Office	January 2018	As notified
Superficial Aquifer Designations Environment Agency - Head Office	January 2018	As notified
Source Protection Zones Environment Agency - Head Office	September 2022	Bi-Annually
Extreme Flooding from Rivers or Sea without Defences Environment Agency - Head Office	December 2023	Quarterly
Flooding from Rivers or Sea without Defences Environment Agency - Head Office	December 2023	Quarterly
Areas Benefiting from Flood Defences Environment Agency - Head Office	February 2023	Quarterly
Flood Water Storage Areas Environment Agency - Head Office	January 2024	Quarterly
Flood Defences Environment Agency - Head Office	August 2022	Quarterly
OS Water Network Lines Ordnance Survey	January 2024	Quarterly
Surface Water 1 in 30 year Flood Extent Environment Agency - Head Office	May 2018	Annually
Surface Water 1 in 100 year Flood Extent Environment Agency - Head Office	May 2018	Annually
Surface Water 1 in 1000 year Flood Extent Environment Agency - Head Office	May 2018	Annually
Surface Water Suitability Environment Agency - Head Office	February 2016	Annually
BGS Groundwater Flooding Susceptibility British Geological Survey - National Geoscience Information Service	May 2013	As notified

Waste	Version	Update Cycle
BGS Recorded Landfill Sites British Geological Survey - National Geoscience Information Service	November 2002	As notified
Historical Landfill Sites Environment Agency - Head Office	July 2023	Quarterly
Integrated Pollution Control Registered Waste Sites Environment Agency - Southern Region	January 2009	Not Applicable
Licensed Waste Management Facilities (Landfill Boundaries) Environment Agency - South East Region - Solent & South Downs Area Environment Agency - Southern Region - Kent and East Sussex Environment Agency - Southern Region - Solent and South Downs Environment Agency - Southern Region - Sussex Area	January 2024 January 2024 January 2024 January 2024	Quarterly Quarterly Quarterly Quarterly
Licensed Waste Management Facilities (Locations) Environment Agency - South East Region - Solent & South Downs Area Environment Agency - Southern Region - Kent and East Sussex Environment Agency - Southern Region - Solent and South Downs Environment Agency - Southern Region - Sussex Area	January 2023 January 2023 January 2023 January 2023	Quarterly Quarterly Quarterly Quarterly
Local Authority Landfill Coverage East Sussex County Council - Waste Management Group Lewes District Council Mid Sussex District Council - Environmental Services Section Wealden District Council - Environmental Health Department West Sussex County Council - Environment & Development	February 2003 February 2003 February 2003 February 2003 February 2003	Not Applicable Not Applicable Not Applicable Not Applicable Not Applicable
Local Authority Recorded Landfill Sites East Sussex County Council - Waste Management Group Lewes District Council Mid Sussex District Council - Environmental Services Section Wealden District Council - Environmental Health Department West Sussex County Council - Environment & Development	October 2018 October 2018 October 2018 October 2018 October 2018	
Potentially Infilled Land (Non-Water) Landmark Information Group Limited	December 1999	
Potentially Infilled Land (Water) Landmark Information Group Limited	December 1999	
Registered Landfill Sites Environment Agency - Southern Region - Kent and East Sussex Environment Agency - Southern Region - Solent and South Downs Environment Agency - Southern Region - Sussex Area	March 2006 March 2006 March 2006	Not Applicable Not Applicable Not Applicable
Registered Waste Transfer Sites Environment Agency - Southern Region - Kent and East Sussex Environment Agency - Southern Region - Solent and South Downs Environment Agency - Southern Region - Sussex Area	April 2018 April 2018 April 2018	
Registered Waste Treatment or Disposal Sites Environment Agency - Southern Region - Kent and East Sussex Environment Agency - Southern Region - Solent and South Downs Environment Agency - Southern Region - Sussex Area	June 2015 June 2015 June 2015	

Hazardous Substances	Version	Update Cycle
Control of Major Accident Hazards Sites (COMAH) Health and Safety Executive	March 2023	Bi-Annually
Explosive Sites Health and Safety Executive	March 2017	
Notification of Installations Handling Hazardous Substances (NIHHS) Health and Safety Executive	August 2001	
Planning Hazardous Substance Enforcements Lewes District Council - Planning Department Wealden District Council East Sussex County Council - Development Minerals & Waste Mid Sussex District Council West Sussex County Council - Environment & Development	February 2016 February 2016 February 2023 January 2016 October 2006	Variable Variable Variable Variable Annual Rolling Update
Planning Hazardous Substance Consents Lewes District Council - Planning Department Wealden District Council East Sussex County Council - Development Minerals & Waste Mid Sussex District Council West Sussex County Council - Environment & Development	February 2016 February 2016 February 2023 January 2016 October 2006	Variable Variable Variable Variable Annual Rolling Update
Geological	Version	Update Cycle
BGS 1:625,000 Solid Geology British Geological Survey - National Geoscience Information Service	January 2009	As notified
BGS Estimated Soil Chemistry British Geological Survey - National Geoscience Information Service	December 2015	As notified
BGS Recorded Mineral Sites British Geological Survey - National Geoscience Information Service	January 2024	Bi-Annually
CBSCB Compensation District Cheshire Brine Subsidence Compensation Board (CBSCB) Cheshire Brine Subsidence Compensation Board (CBSCB)	August 2011 November 2020	As notified
Coal Mining Affected Areas The Coal Authority - Property Searches	February 2023	Annual Rolling Update
Mining Instability Ove Arup & Partners	June 1998	Not Applicable
Non Coal Mining Areas of Great Britain British Geological Survey - National Geoscience Information Service	May 2015	Not Applicable
Potential for Collapsible Ground Stability Hazards British Geological Survey - National Geoscience Information Service	April 2020	As notified
Potential for Compressible Ground Stability Hazards British Geological Survey - National Geoscience Information Service	January 2019	As notified
Potential for Ground Dissolution Stability Hazards British Geological Survey - National Geoscience Information Service	January 2019	As notified
Potential for Landslide Ground Stability Hazards British Geological Survey - National Geoscience Information Service	January 2019	As notified
Potential for Running Sand Ground Stability Hazards British Geological Survey - National Geoscience Information Service	January 2019	As notified
Potential for Shrinking or Swelling Clay Ground Stability Hazards British Geological Survey - National Geoscience Information Service	January 2019	As notified
Radon Potential - Radon Affected Areas British Geological Survey - National Geoscience Information Service	October 2023	Annually
Radon Potential - Radon Protection Measures British Geological Survey - National Geoscience Information Service	October 2023	Annually

Industrial Land Use	Version	Update Cycle
Contemporary Trade Directory Entries Thomson Directories	October 2023	Quarterly
Fuel Station Entries Catalist Ltd - Experian	November 2023	Quarterly
Gas Pipelines National Grid	October 2021	Bi-Annually
Points of Interest - Commercial Services PointX	December 2023	Quarterly
Points of Interest - Education and Health PointX	December 2023	Quarterly
Points of Interest - Manufacturing and Production PointX	December 2023	Quarterly
Points of Interest - Public Infrastructure PointX	December 2023	Quarterly
Points of Interest - Recreational and Environmental PointX	December 2023	Quarterly
Underground Electrical Cables National Grid	February 2023	Bi-Annually

Sensitive Land Use	Version	Update Cycle
Ancient Woodland Natural England	October 2023	Bi-Annually
Areas of Adopted Green Belt Lewes District Council - Planning Department Mid Sussex District Council Wealden District Council	August 2023 August 2023 August 2023	Quarterly Quarterly Quarterly
Areas of Unadopted Green Belt Lewes District Council - Planning Department Mid Sussex District Council Wealden District Council	August 2023 August 2023 August 2023	Quarterly Quarterly Quarterly
Areas of Outstanding Natural Beauty Natural England	November 2023	Bi-Annually
Environmentally Sensitive Areas Natural England	August 2023	
Forest Parks Forestry Commission	May 2023	Not Applicable
Local Nature Reserves Natural England	August 2023	Bi-Annually
Marine Nature Reserves Natural England	October 2023	Bi-Annually
National Nature Reserves Natural England	August 2023	Bi-Annually
National Parks Natural England	February 2018	Bi-Annually
Nitrate Sensitive Areas Natural England	April 2023	Not Applicable
Nitrate Vulnerable Zones Department for Environment, Food and Rural Affairs (DEFRA - formerly FRCA) Environment Agency - Head Office	April 2016 March 2023	Bi-Annually
Ramsar Sites Natural England	October 2023	Bi-Annually
Sites of Special Scientific Interest Natural England	November 2023	Bi-Annually
Special Areas of Conservation Natural England	October 2023	Bi-Annually
Special Protection Areas Natural England	October 2023	Bi-Annually

A selection of organisations who provide data within this report

Data Supplier	Data Supplier Logo
Ordnance Survey	
Environment Agency	
Scottish Environment Protection Agency	
The Coal Authority	
British Geological Survey	 British Geological Survey NATURAL ENVIRONMENT RESEARCH COUNCIL
Centre for Ecology and Hydrology	 Centre for Ecology & Hydrology NATURAL ENVIRONMENT RESEARCH COUNCIL
Natural Resources Wales	
Scottish Natural Heritage	
Natural England	
Public Health England	
Ove Arup	
Stantec UK Ltd	

Contact	Name and Address	Contact Details
1	British Geological Survey - Enquiry Service British Geological Survey, Environmental Science Centre, Keyworth, Nottingham, Nottinghamshire, NG12 5GG	Telephone: 0115 936 3143 Fax: 0115 936 3276 Email: enquiries@bgs.ac.uk Website: www.bgs.ac.uk
2	Environment Agency - National Customer Contact Centre (NCCC) PO Box 544, Templeborough, Rotherham, S60 1BY	Telephone: 03708 506 506 Email: enquiries@environment-agency.gov.uk
3	Mid Sussex District Council - Environmental Services Section The Oaklands, Oaklands Road, Haywards Heath, West Sussex, RH16 1SS	Telephone: 01444 458166 extn 2288 Fax: 01444 450027 Website: www.midsussex.gov.uk
4	Environment Agency - Head Office Rio House, Waterside Drive, Aztec West, Almondsbury, Bristol, Avon, BS32 4UD	Telephone: 01454 624400 Fax: 01454 624409
5	Ordnance Survey Adanac Drive, Southampton, Hampshire, SO16 0AS	Telephone: 03456 05 05 05 Email: customerservices@ordnancesurvey.co.uk Website: www.ordnancesurvey.gov.uk
6	West Sussex County Council - Environment & Development County Hall, Tower hall, Chichester, West Sussex, PO19 1RH	Telephone: 01243 777100 Website: www.westsussex.gov.uk
7	PointX 7 Abbey Court, Eagle Way, Sowton, Exeter, Devon, EX2 7HY	Website: www.pointx.co.uk
8	Natural England County Hall, Spetchley Road, Worcester, WR5 2NP	Telephone: 0300 060 3900 Email: enquiries@naturalengland.org.uk Website: www.naturalengland.org.uk
-	Public Health England - Radon Survey, Centre for Radiation, Chemical and Environmental Hazards Chilton, Didcot, Oxfordshire, OX11 0RQ	Telephone: 01235 822622 Fax: 01235 833891 Email: radon@phe.gov.uk Website: www.ukradon.org
-	Landmark Information Group Limited Imperium, Imperial Way, Reading, Berkshire, RG2 0TD	Telephone: 0844 844 9952 Fax: 0844 844 9951 Email: customerservices@landmarkinfo.co.uk Website: www.landmarkinfo.co.uk

Please note that the Environment Agency / Natural Resources Wales / SEPA have a charging policy in place for enquiries.

Appendix 2B: Mid Sussex District Council

Contact: Mr Adam Dracott
Direct Line: 01444 477382
Email: adam.dracott@midsussex.gov.uk

Our Ref: AD/SR/20/5517
Your Ref:

Date: 10 December 2020

Ms K Blaydon
Lees Roxburgh Ltd
The Genesis Centre Science Park South
Birchwood
Warrington
WA3 7BH

Dear Madam

Re: Land at Walstead Grange, Lindfield RH16 2QQ

Thank you for your enquiry requesting environmental information concerning the above site and for your payment. Following a search of our records, I can respond to your enquiry as follows:

1. Known pollution incidents which may have affected the site.

There are no records of pollution incidents within 500m of the site that may have affected the site.

2. Contaminative activities at the site.

There are no records of contaminative activities at the site as outlined in red on the plan that was provided. However, there are a number of historical contaminative activities on land abutting and immediately to the north and east of the site.

Environmental Health are aware of the following historical uses within a 250m radius of the specified site that have the potential to have caused contamination:

Site Description	First Input	Last Input	X (Easting)	Y (Northing)	Area in m2
Garage	1964	1971	535041	124968	3929.71
Sewage Farm	1896	1910	535286	125228	26867.75
Sewage Works	1937	1962	535264	125236	26858.39
Refuse tip	1970	1970	535308	125218	34265.11
Made ground	1975	1975	535321	125171	16028.15
Scrap Yard	Not listed	Not listed	535063	125019	5231.16
Nurseries	1970	1970	535126	125094	27655.1

3. Pre-licensing or unlicensed landfilling activities within a 500m radius of the site, including landfill location, depth, presence of lining system, age and type of waste deposits.

The following data are held in relation to landfill and infill areas within 500m of the site.

Site Description	First Input	Last Input	X (Easting)	Y (Northing)	Area in m2
Refuse Heap	1962	1962	535384	125226	1115.73
Closed Landfill			535342	125265	25708.97
Hole Unknown	1937	1955	535290	125338	707.91
Refuse Heap	1955	1955	535278	125156	737.47
Refuse Tip	1970	1970	535308	125218	34265.11
Made Ground	1975	1975	535321	125171	16028.15

4. Results of any landfill gas and leachate monitoring.

Environmental Health have no records of any landfill gas and leachate monitoring for the site or it's immediate vicinity. There may be such data in reports submitted to our Planning Department in support of planning applications. These reports are posted on the planning portal which can be accessed at [Simple Search \(midsussex.gov.uk\)](https://midsussex.gov.uk/simple-search)

Immediately to the west of the site, application reference DM/16/5648 contains a ground investigation report that may be of interest to you.

The information contained in this letter is based solely on existing records kept by the District Council. Should you have any reason to suspect that the site may be affected by land contamination, or that any potentially contaminative land use is known to have existed on or near the site, you are strongly advised to undertake or arrange further investigations and/or searches as may be appropriate.

Yours faithfully



Mr Adam Dracott
Team leader Environmental Protection
Environmental Protection

Lees Roxburgh

From: Oliver Benson <Oliver.Benson@midsussex.gov.uk>
Sent: 07 February 2024 11:04
To: Lees Roxburgh
Subject: SR/24/0474 Land At Walstead Grange Scaynes Hill Road Lindfield Haywards Heath West Sussex RH16 2QQ
Attachments: MSDC Bank Details EIR - Contaminated Land.docx

Dear Karen,

Thank you for your enquiry.

Your enquiry should take less than 2 hours, so will come under the [flat rate fee of £80](#) (no VAT is payable) for contaminated land information, which will look to answer queries put forward only using information already held by Environmental Health.

I have conducted a brief review of the data we hold regarding this site and can confirm that we are not aware of any pollution incidents or contaminative activities at the site, aside from the low risk associated with agricultural use. It's worth noting that there is one landfill within a 500-meter radius, namely The Eastern Road Landfill; however, our data on it is limited.


If you still wish to proceed with a contaminated land information request for the site, you can make payment by bankers' card by contacting our office at (01444) 477292 and quoting reference SR/24/0474. Bank details for payment via BACs are also attached. Please send proof of BACS payment to contaminatedland@midsussex.gov.uk.

We are obligated to respond within 20 working days from payment, but we will strive to provide the data as promptly as possible.

If you have any further questions, please don't hesitate to call me at 01444 477 059.

Yours sincerely,

Oliver Benson
Senior Environmental Health Officer
Environmental Protection Team
Tel: 01444 477 059
Email: oliver.benson@midsussex.gov.uk
Website: www.midsussex.gov.uk

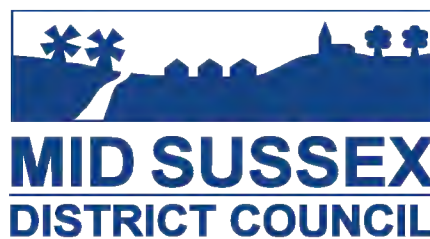

"Working together for a better Mid Sussex"

Appendix E

UTILITY SERVICE PLANS

Utilities Search Report



Monday, 19 May 2025

Brookbanks

Gladman

Walstead Grange

91 Market Street Hoylake Wirral CH47 5AA
Tel. 0151 632 5142
enquiries@cornerstoneprojects.co.uk
www.cornerstoneprojects.co.uk
VAT Reg. No. 851 4941 19
Company No. 5132353

Registered in England. Registered Address : Cornerstone Projects Ltd, 91 Market Street, Hoylake, Wirral CH47 5AA

Table of contents:

Utility / Service	Included	Utility / Service	Included
Basic Search		Independent Utilities	
Gas	Yes	GTC	Yes
Water	Yes	Last Mile	Not Affected
Sewers	Yes	SSE	Not Affected
BT	Yes	Harlaxton	Not Affected
Electricity	Yes	Utility Assets	To Follow
3rd Party Searches*	Yes	UK Power Distribution	Not Affected
		Albion Water	Not Affected
Cable Search		ESP	Not Affected
Vodafone	To Follow	Fulcrum Pipelines	Not Affected
Virgin Media	Yes	Energy Assets	Not Affected
BSkyB	To Follow	Bring Energy	Not Affected
EXA Infrastructure	Not Affected	Leep Utilities	Not Affected
Colt	To Follow	Eclipse Power Networks	Yes
Sota	Not Affected		
CGI Logica	Not Affected	Others	
Neos Networks	Not Affected	CAD Pack	Not Requested
City Fibre	Yes	Smart pdf	Not Requested
Arelion frmly Telia	Not Affected	CA & EA Search	Not Requested
Lumen Technologies	To Follow	allPoints Fibre	Yes
KCom	Not Affected		
Verizon	Yes		
Zayo Group	Not Affected		
Tata Communications	Not Affected		
Gamma	Not Affected		
Gigaclear Plc	Not Affected		
MBNL	Yes		
*Includes Utilibilly and Linesearch			
"Not affected" responses are deemed as such from the 3rd Party Searches			
NB: All plans / responses are valid for a maximum of three months unless noted otherwise			

Order Summary

Summary of your utility search details:

Site Name	Walstead Grange		
Site Ref	Gladman		
Address	Land off Scamps Hill, Lindfield, RH16 2GL		
Postcode	RH16 2GL		
Grid Ref	E 535310	N 124821	
Area Covered			
			

Options Selected		Options Selected	
Gas	✓	Independent utilities search - inc non-chargeable searches	✓
Water	✓	Harlaxton	✓
Sewer	✓	UK Power Distribution	✓
Electric	✓		
BT	✓	Coal Authority search	X
3rd Party searches	✓		
		Other Options	
Cable / Fibre searches inc non-chargeable searches	✓	CAD Pack	X
Virgin Media	✓	CAD OS mapping	X
Vodafone	✓	Smart pdf	X
		Instant Access Plans	X

GAS

Our Ref: 37324868 Your Ref: Gladman

Monday, 19 May 2025

Duncan Phillips
91 Market Street
Hoylake
MSY
CH47 5AA

Dear Duncan Phillips

Thank you for your enquiry dated Monday, 19 May 2025

Please find an extract from our mains records for your proposed work area, any SGN assets are described in the map legend. **On some occasions blank maps may be sent to you, this is due to your proposed work being in a no gas area but within our operational boundaries.**

This mains record only shows the pipes owned by SGN in our role as a Licensed Gas Transporter (GT). Please note that privately owned gas pipes or pipes owned by other GTs may be present in this area and information regarding those pipes needs to be requested from the owners. If we know of any other pipes in the area we will note them on the plans as a shaded area and/or a series of x's.

The information shown on this plan is given without obligation or warranty and the accuracy cannot be guaranteed. Service pipes, valves, siphons, stub connections etc. are not shown but their presence should be anticipated. Your attention is drawn to the information and disclaimer on these plans. The information included on the plan is only valid for 28 days.

On the mains record you may see the low/medium/intermediate pressure gas main near your site. There should be no mechanical excavations taking place above or within 0.5m of a low/medium pressure system or above or within 3.0m of an intermediate pressure system. You should, where required confirm the position using hand dug trial holes.


A colour copy of these plans and the gas safety advice booklet enclosed should be passed to the senior person on site in order to prevent damage to our plant and potential direct or consequential costs to your organisation.

Safe digging practices in accordance with HSE publication HSG47 "Avoiding Danger from Underground Services" must be used to verify and establish the actual position of the mains, pipes, services and other apparatus on site before any mechanical plant is used. It is your responsibility to ensure that this information is provided to all relevant people (direct labour or contractors) working for you on or near gas pipes.

It must be stressed that both direct and consequential damage to gas plant can be dangerous for your employees and the general public and repairs to any such damage will incur a charge to you or the organisation carrying out work on your behalf. Your works should be carried out in such a manner that we are able to gain access to our apparatus throughout the duration of your operations.

If you require any further information please do not hesitate to contact us.

Yours sincerely,
The Safety Admin Team
For more information, visit our Dig Safely pages on sgn.co.uk
Tel: 0800 912 1722

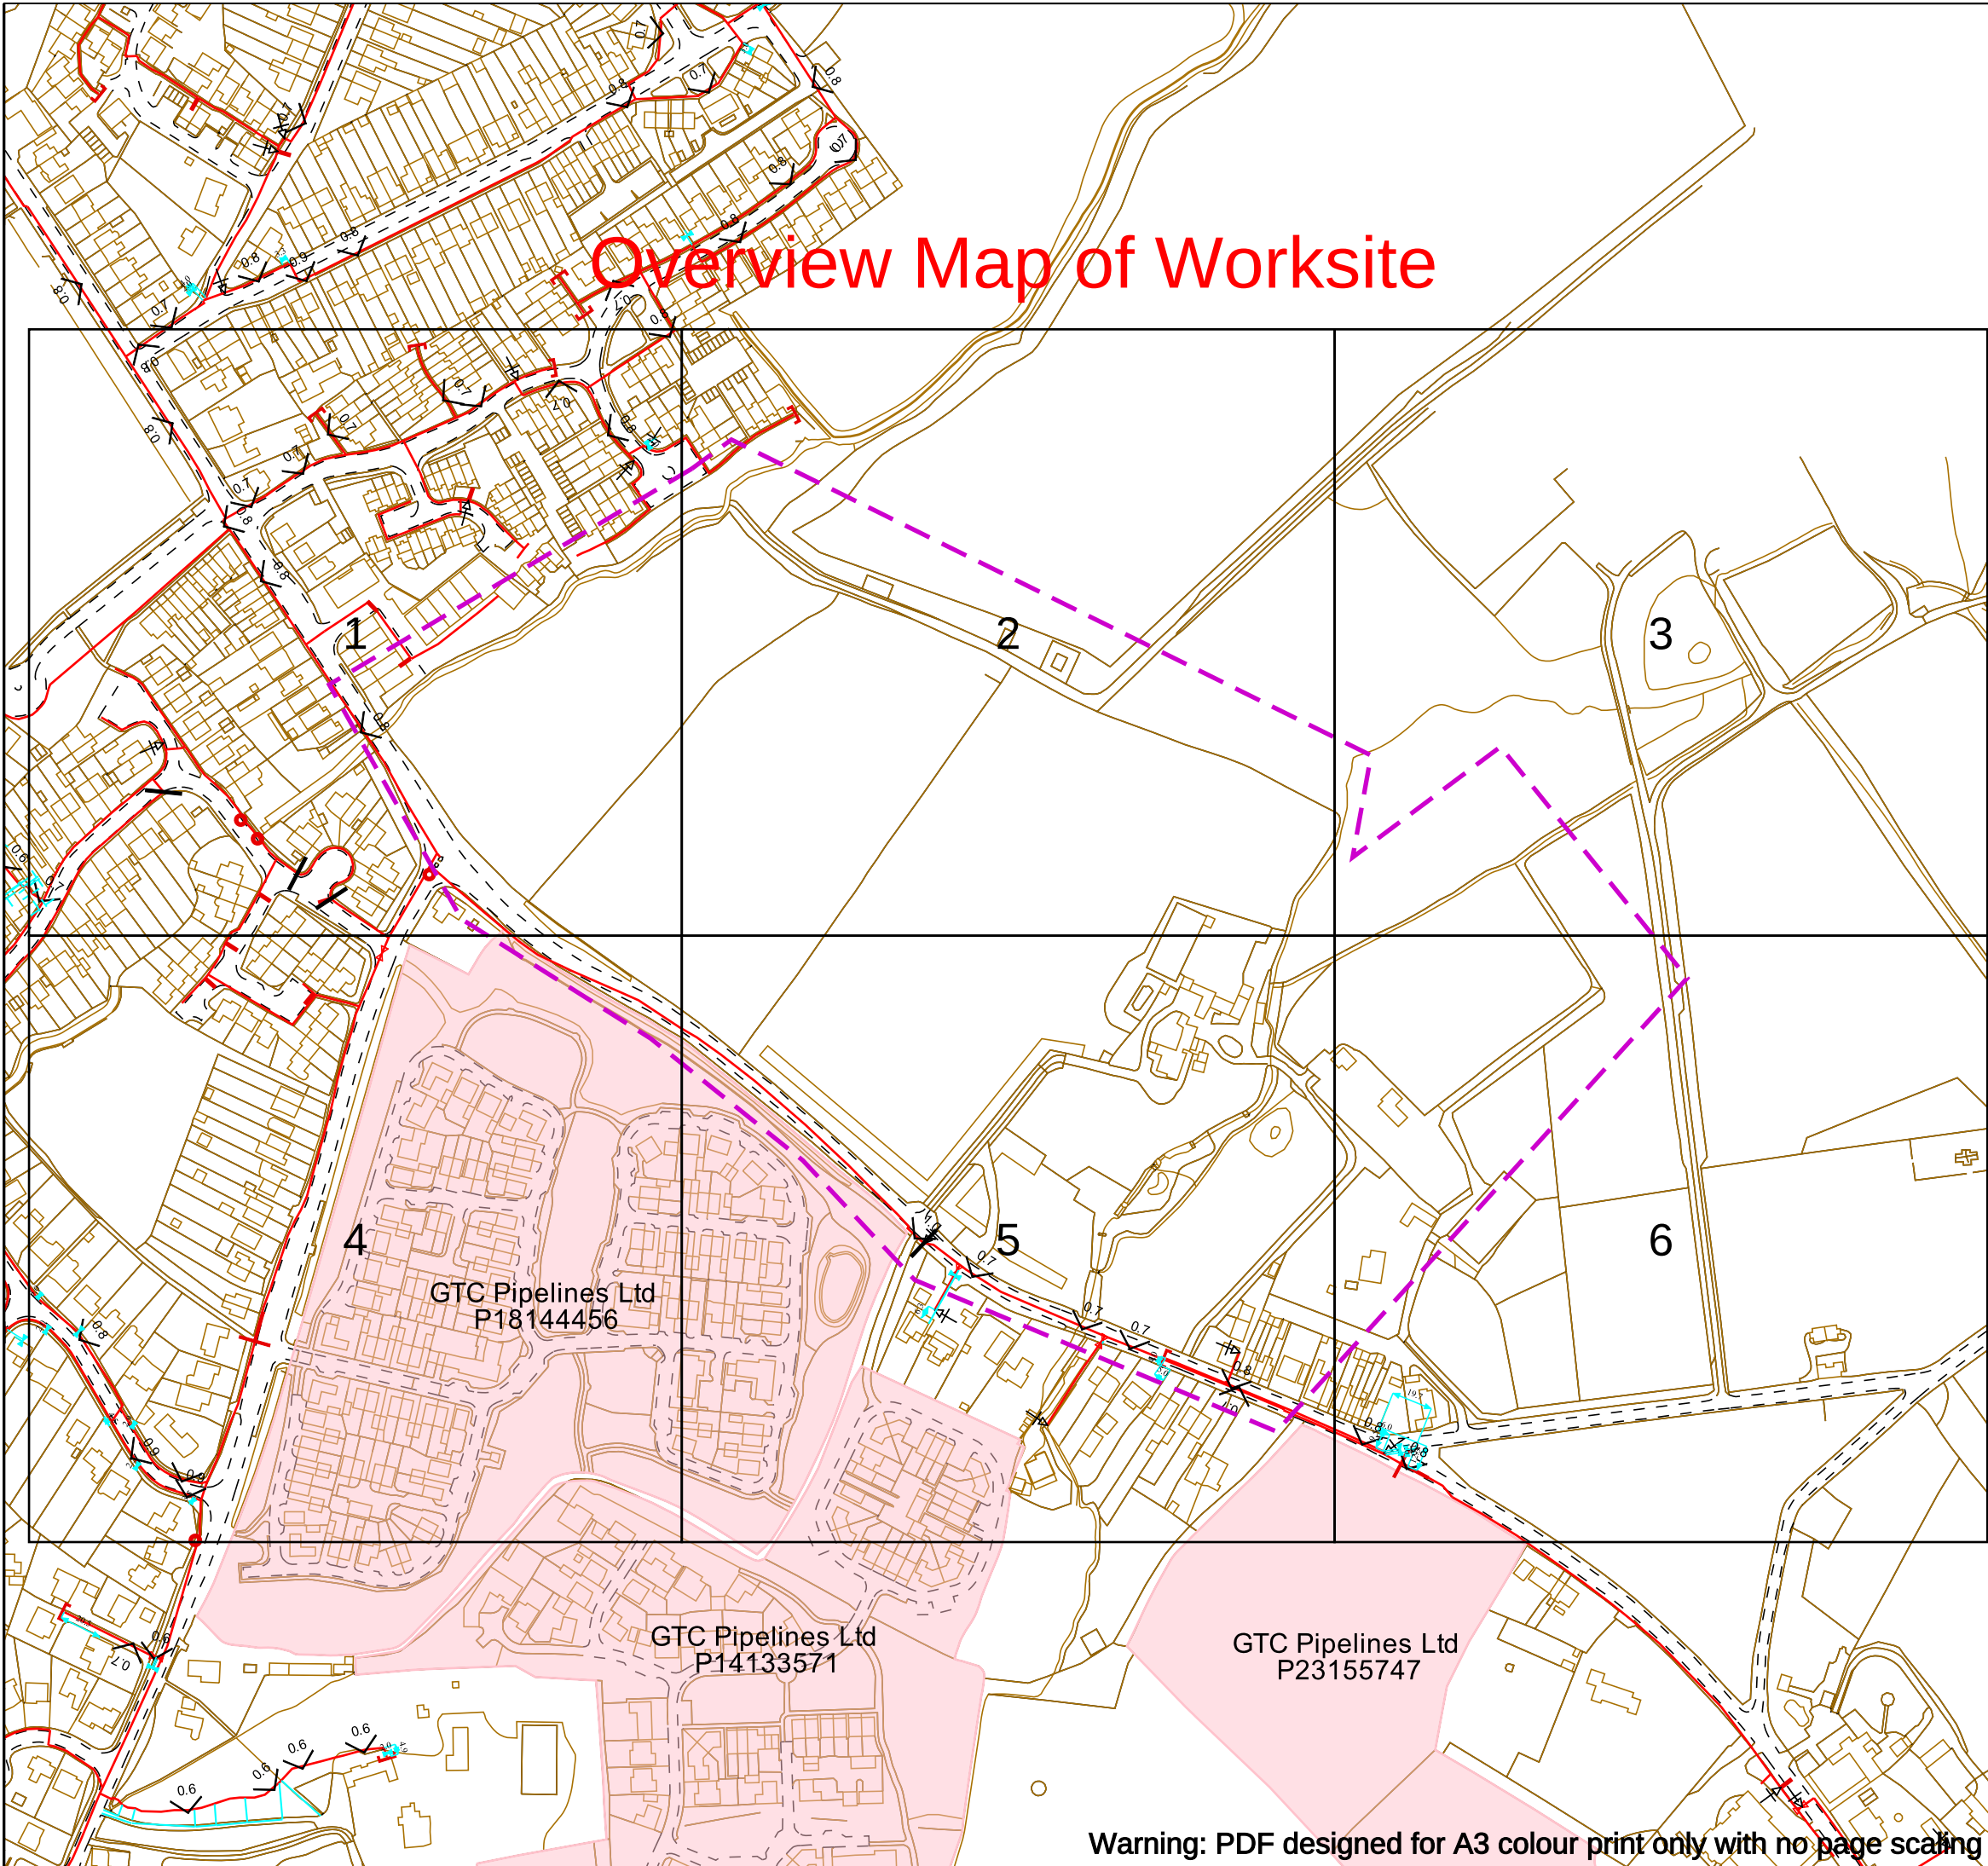

Overview Map of Worksite



SGN
Your gas. Our network.

Contact Us

SGN Safety Admin Team:

0800 912 1722

Email:

plantlocation@sgn.co.uk

Date Requested: 19/05/2025

Job Reference: 37324868

Site Location: 535357 124821

Requested by: Mr Duncan Phillips

Your Scheme/Reference: Gladman

Scale: 1:3075 (When plotted at A3)

This plan shows the location of those pipes owned by Scotia Gas Networks (SGN) by virtue of being a licensed Gas Transporter (GT). Gas pipes owned by other GTs or third parties may also be present in this area but are not shown on this plan. Information with regard to such pipes should be obtained from the relevant owners. No warranties are given with regard to the accuracy of the information shown on this plan. Service pipes, valves, siphons, sub-connections etc. are not shown but their presence should be anticipated. You should be aware that a small percentage of our pipes/assets may be undergoing review and will temporarily be highlighted in yellow. If your proposed works are close to one of these pipes, you should contact the SGN Safety Admin Team on 0800 912 1722 for advice. No liability of any kind whatsoever is accepted by SGN or its agents, servants or sub-contractors for any error or omission contained herein. Safe digging practices, in accordance with HS (G)47, must be used to verify and establish the actual position of mains, pipes, services and other apparatus on site before any mechanical plant is used. It is your responsibility to ensure that plant location information is provided to all persons (whether direct labour or sub-contractors) working for you on or near gas apparatus. Information included on this plan should not be referred to beyond a period of 28 days from the date of issue.

Report damage immediately – KEEP EVERYONE AWAY FROM THE AREA
0800 111 999

Low Pressure Mains

Medium Pressure Mains


Intermediate Pressure Mains

High Pressure Mains

LAs

H100 Hydrogen Network

GTs

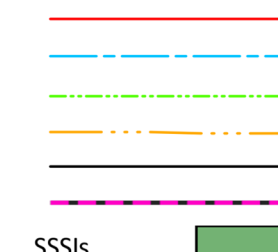

Some Examples Of Plant Items


Valve  Syphon  Depth of Cover  Diameter Change  Material Change 

Digsite: Line:  Area: 



This plan is reproduced from or based on the OS map by Scotia Gas Networks plc, with the sanction of the controller of HM Stationery Office. Crown Copyright Reserved. Southern Gas – 100044373 and Scotland Gas – 100044366.

Warning: PDF designed for A3 colour print only with no page scaling

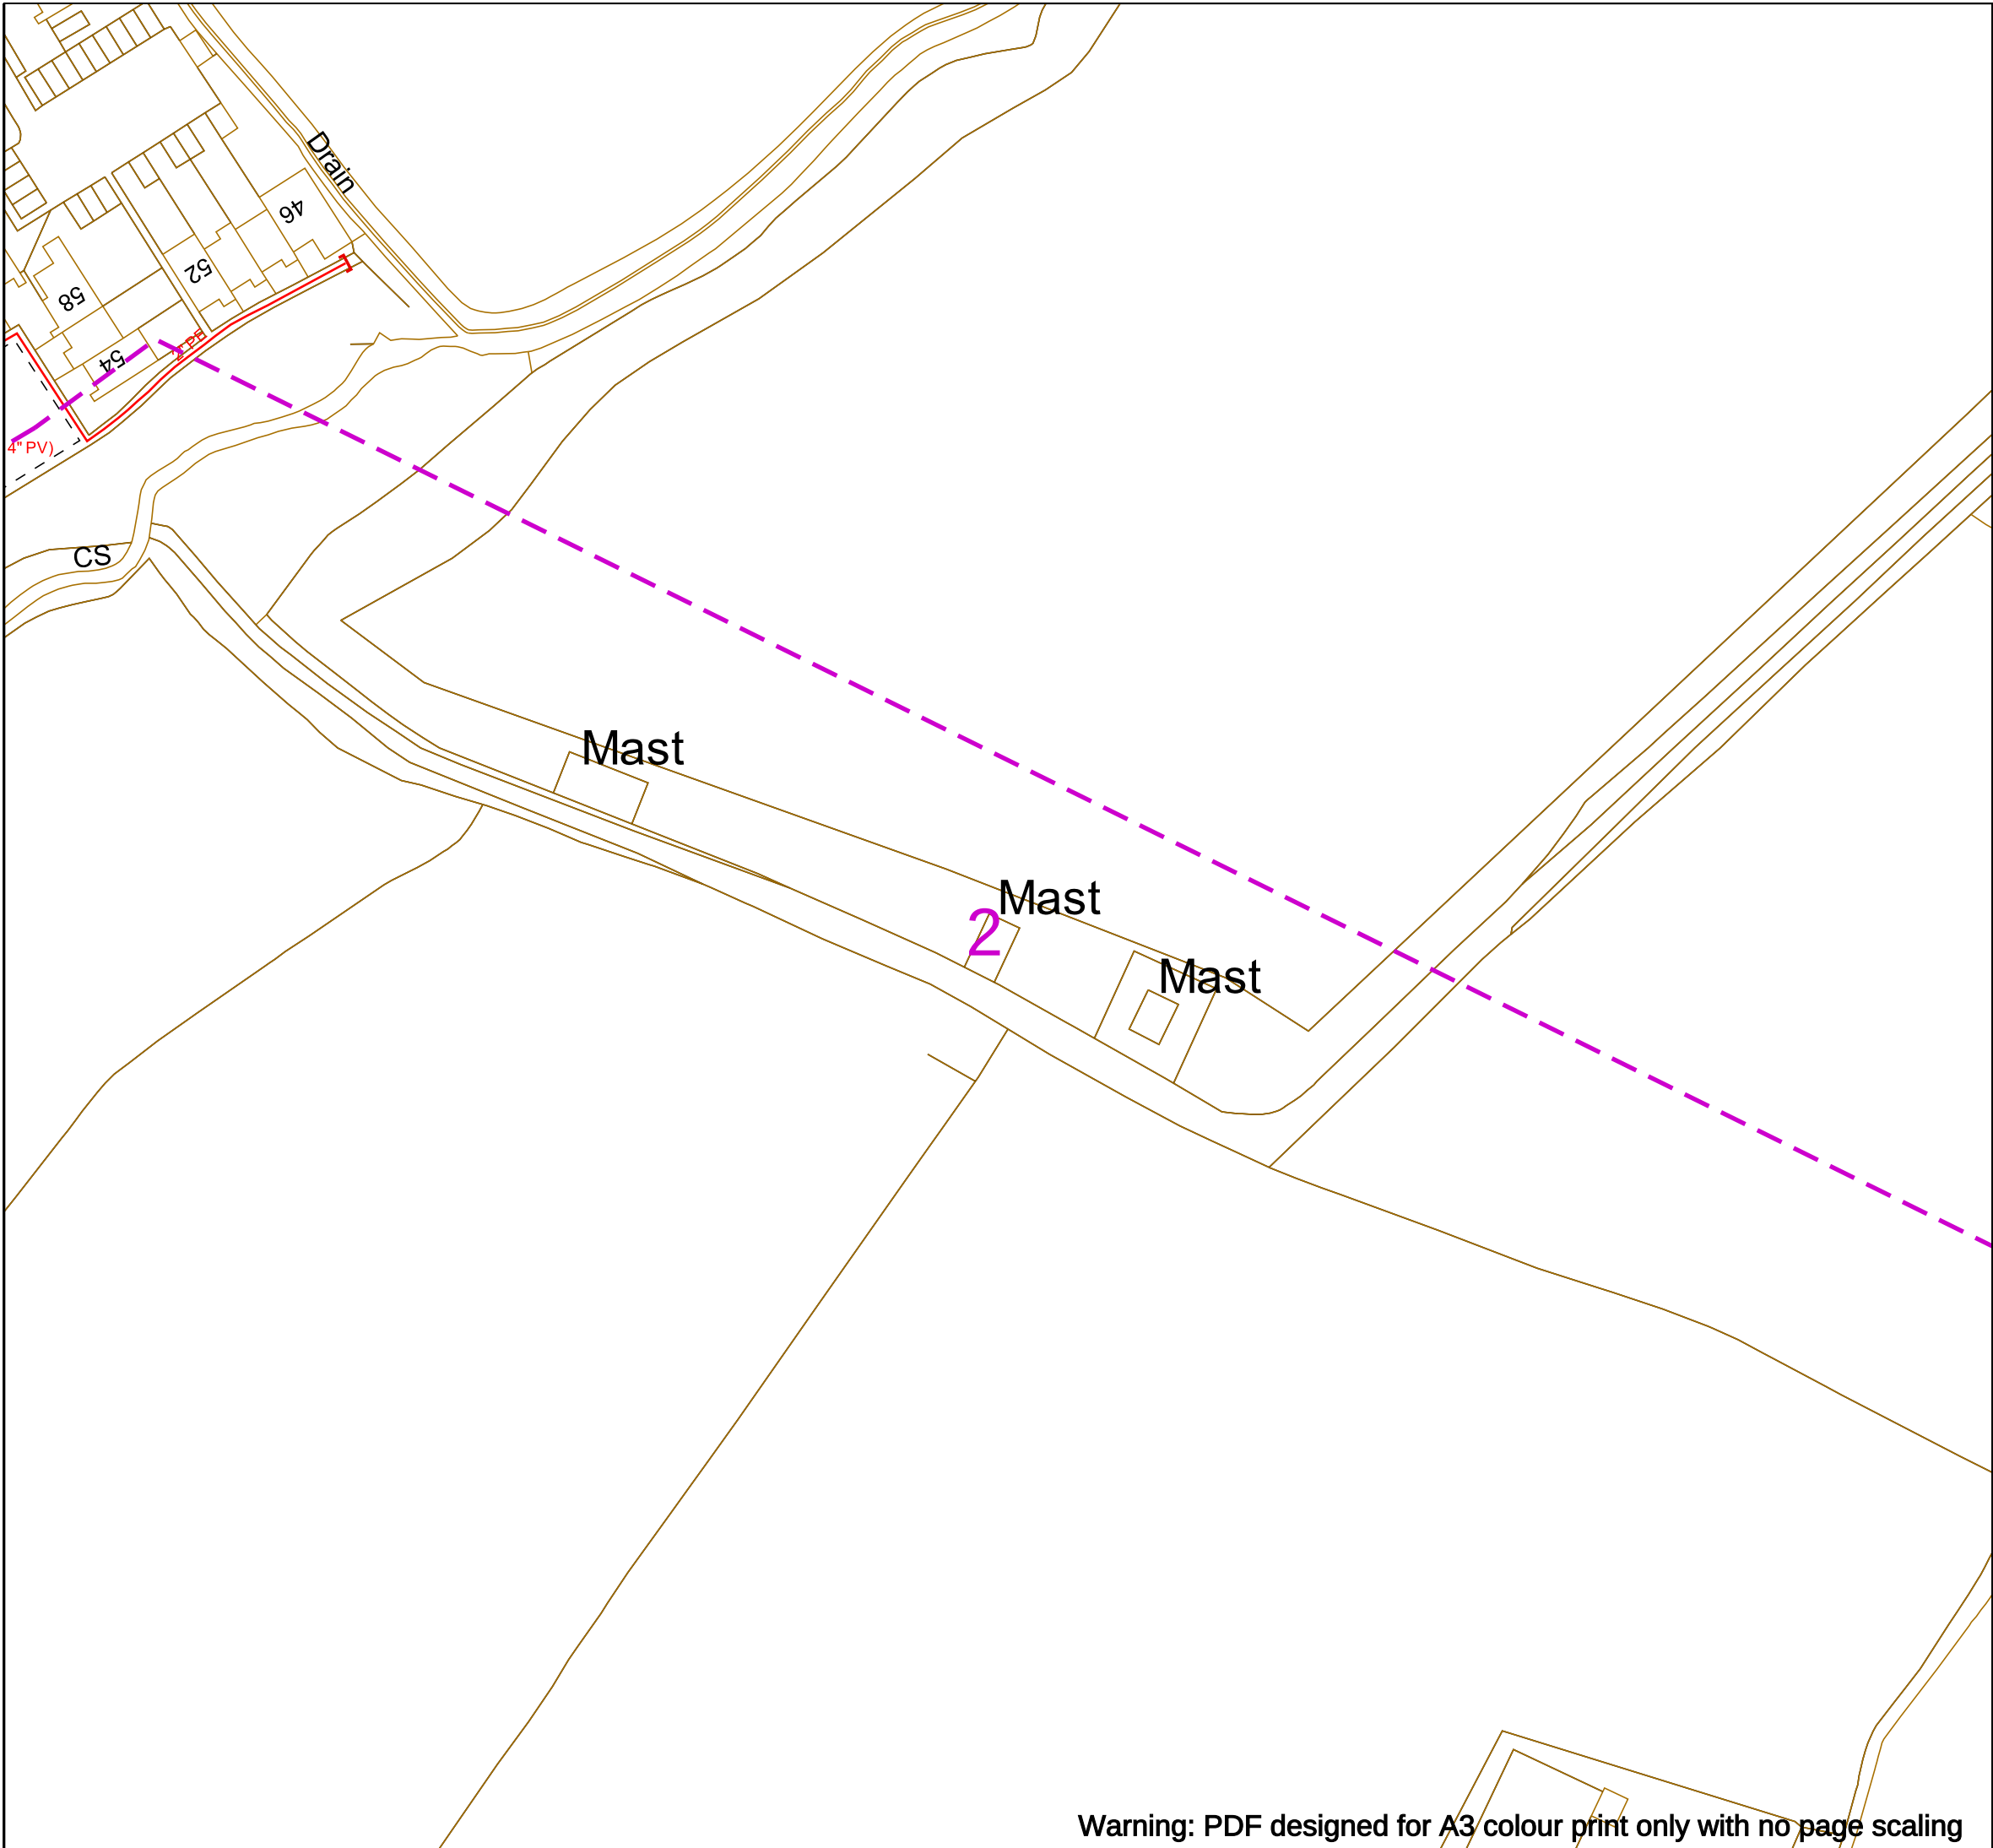

SGN
Your gas. Our network.

Contact Us
SGN Safety Admin Team:
0800 912 1722
Email:
plantlocation@sgn.co.uk

Date Requested: 19/05/2025
Job Reference: 37324868
Site Location: 535357 124821
Requested by: Mr Duncan Phillips

Your Scheme/Reference: Gladman

Scale: 1:1000 (When plotted at A3)

This plan shows the location of those pipes owned by Scotia Gas Networks (SGN) by virtue of being a licensed Gas Transporter (GT). Gas pipes owned by other GTs or third parties may also be present in this area but are not shown on this plan. Information with regard to such pipes should be obtained from the relevant owners. No warranties are given with regard to the accuracy of the information shown on this plan. Service pipes, valves, siphons, sub-connections etc. are not shown but their presence should be anticipated. You should be aware that a small percentage of our pipes/assets may be undergoing review and will temporarily be highlighted in yellow. If your proposed works are close to one of these pipes, you should contact the SGN Safety Admin Team on 0800 912 1722 for advice. No liability of any kind whatsoever is accepted by SGN or its agents, servants or sub-contractors for any error or omission contained herein. Safe digging practices, in accordance with HS (G)47, must be used to verify and establish the actual position of mains, pipes, services and other apparatus on site before any mechanical plant is used. It is your responsibility to ensure that plant location information is provided to all persons (whether direct labour or sub-contractors) working for you on or near gas apparatus. Information included on this plan should not be referred to beyond a period of 28 days from the date of issue.

Report damage immediately – KEEP EVERYONE AWAY FROM THE AREA
0800 111 999

- | | |
|-----------------------------|--|
| Low Pressure Mains | |
| Medium Pressure Mains | |
| Intermediate Pressure Mains | |
| High Pressure Mains | |
| LAs | |
| H100 Hydrogen Network | |
| GTs | |
| SSSIs | |


Some Examples Of Plant Items
Valve Syphon Depth of Cover Diameter Change Material Change

Digsite: Line: Area:



This plan is reproduced from or based on the OS map by Scotia Gas Networks plc, with the sanction of the controller of HM Stationery Office. Crown Copyright Reserved. Southern Gas – 100044373 and Scotland Gas – 100044366.

Warning: PDF designed for A3 colour print only with no page scaling

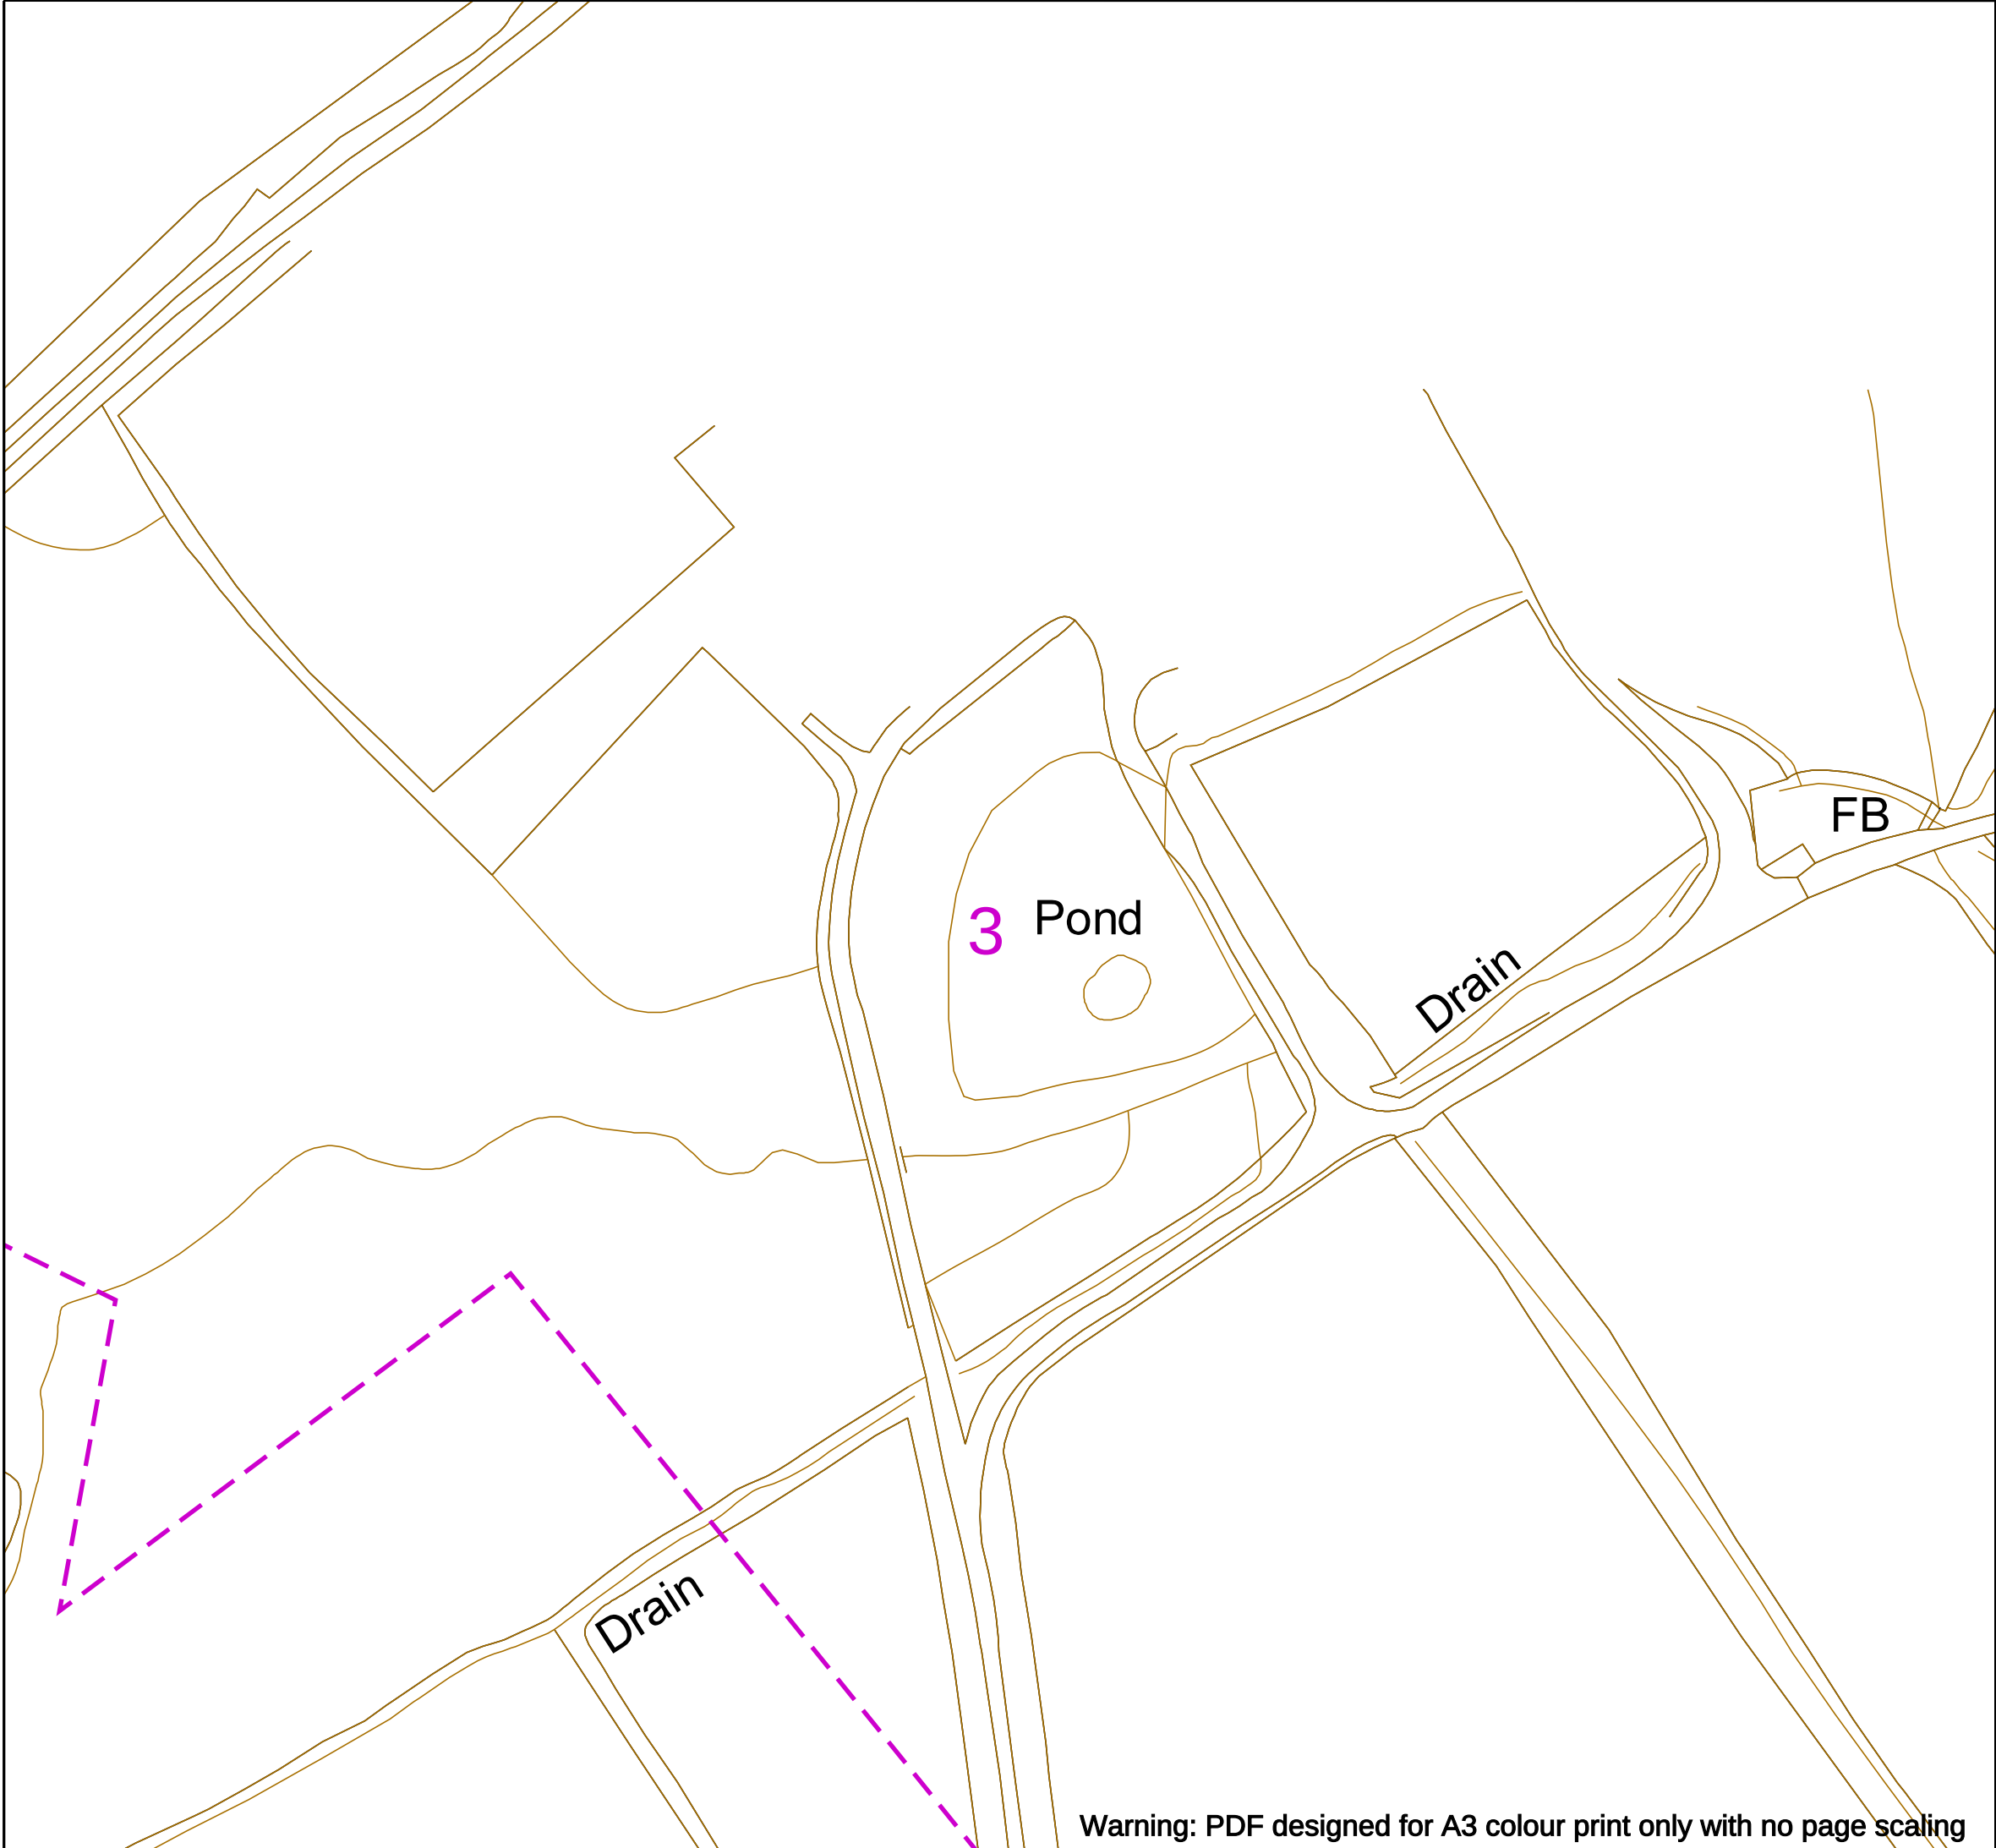

Warning: PDF designed for A3 colour print only with no page scaling



SGN
Your gas. Our network.

Contact Us
SGN Safety Admin Team:
0800 912 1722
Email:
plantlocation@sgn.co.uk

Date Requested: 19/05/2025
Job Reference: 37324868
Site Location: 535357 124821
Requested by: Mr Duncan Phillips

Your Scheme/Reference: Gladman

Scale: 1:1000 (When plotted at A3)

This plan shows the location of those pipes owned by Scotia Gas Networks (SGN) by virtue of being a licensed Gas Transporter (GT). Gas pipes owned by other GTs or third parties may also be present in this area but are not shown on this plan. Information with regard to such pipes should be obtained from the relevant owners. No warranties are given with regard to the accuracy of the information shown on this plan. Service pipes, valves, siphons, sub-connections etc. are not shown but their presence should be anticipated. You should be aware that a small percentage of our pipes/assets may be undergoing review and will temporarily be highlighted in yellow. If your proposed works are close to one of these pipes, you should contact the SGN Safety Admin Team on 0800 912 1722 for advice. No liability of any kind whatsoever is accepted by SGN or its agents, servants or sub-contractors for any error or omission contained herein. Safe digging practices, in accordance with HS (G)47, must be used to verify and establish the actual position of mains, pipes, services and other apparatus on site before any mechanical plant is used. It is your responsibility to ensure that plant location information is provided to all persons (whether direct labour or sub-contractors) working for you on or near gas apparatus. Information included on this plan should not be referred to beyond a period of 28 days from the date of issue.

Report damage immediately – KEEP EVERYONE AWAY FROM THE AREA
0800 111 999

Low Pressure Mains	
Medium Pressure Mains	
Intermediate Pressure Mains	
High Pressure Mains	
LAs	
H100 Hydrogen Network	
GTs	
SSSIs	


Some Examples Of Plant Items

Valve		Syphon		Depth of Cover		Diameter Change		Material Change	
-------	--	--------	--	----------------	--	-----------------	--	-----------------	--

Digsite: Line: Area:



This plan is reproduced from or based on the OS map by Scotia Gas Networks plc, with the sanction of the controller of HM Stationery Office. Crown Copyright Reserved. Southern Gas – 100044373 and Scotland Gas – 100044366.

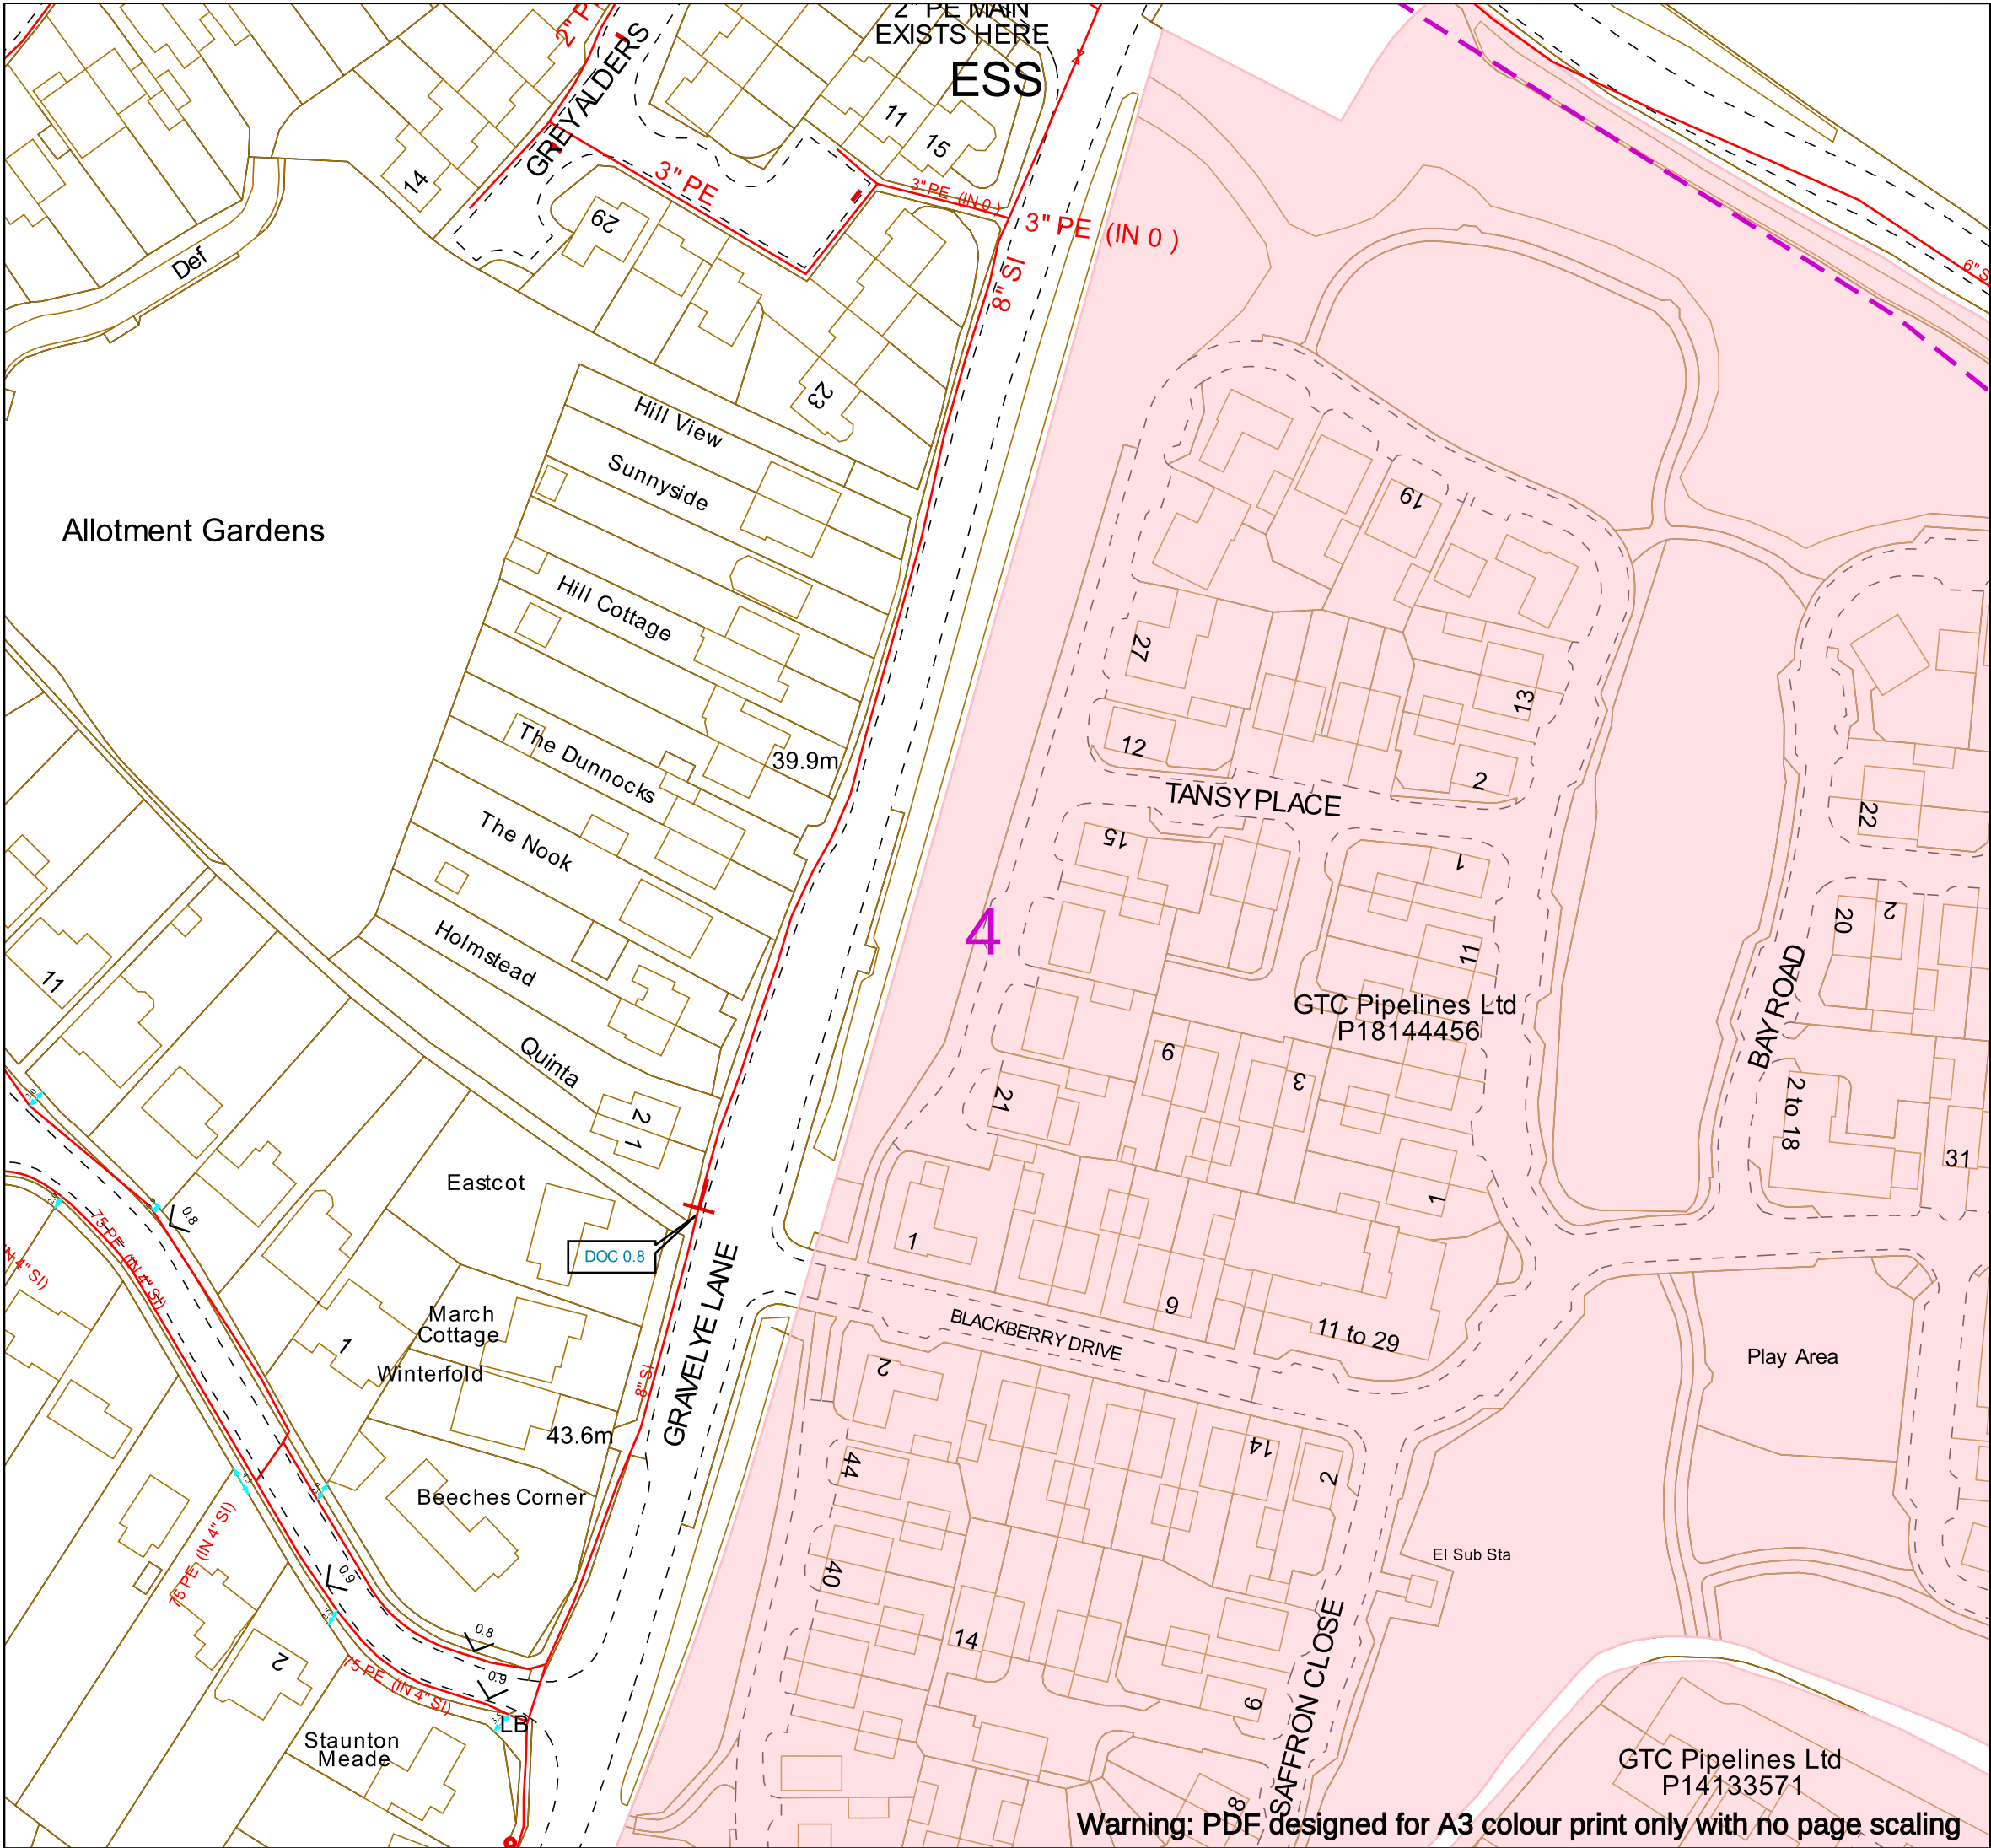

SGN
Your gas. Our network.

Contact Us
SGN Safety Admin Team:
0800 912 1722
Email:
plantlocation@sgn.co.uk

Date Requested: 19/05/2025
Job Reference: 37324868
Site Location: 535357 124821
Requested by: Mr Duncan Phillips

Your Scheme/Reference: Gladman

Scale: 1:1000 (When plotted at A3)

This plan shows the location of those pipes owned by Scotia Gas Networks (SGN) by virtue of being a licensed Gas Transporter (GT). Gas pipes owned by other GTs or third parties may also be present in this area but are not shown on this plan. Information with regard to such pipes should be obtained from the relevant owners. No warranties are given with regard to the accuracy of the information shown on this plan. Service pipes, valves, siphons, sub-connections etc. are not shown but their presence should be anticipated. You should be aware that a small percentage of our pipes/assets may be undergoing review and will temporarily be highlighted in yellow. If your proposed works are close to one of these pipes, you should contact the SGN Safety Admin Team on 0800 912 1722 for advice. No liability of any kind whatsoever is accepted by SGN or its agents, servants or sub-contractors for any error or omission contained herein. Safe digging practices, in accordance with HS (G)47, must be used to verify and establish the actual position of mains, pipes, services and other apparatus on site before any mechanical plant is used. It is your responsibility to ensure that plant location information is provided to all persons (whether direct labour or sub-contractors) working for you on or near gas apparatus. Information included on this plan should not be referred to beyond a period of 28 days from the date of issue.

Report damage immediately – KEEP EVERYONE AWAY FROM THE AREA
0800 111 999

Low Pressure Mains

Medium Pressure Mains

Intermediate Pressure Mains

High Pressure Mains

LAs

H100 Hydrogen Network

GTs

SSSIs

Some Examples Of Plant Items

Valve

Syphon

Depth of Cover

Diameter Change

Material Change

Digsite:


Line:

Area:



This plan is reproduced from or based on the OS map by Scotia Gas Networks plc, with the sanction of the controller of HM Stationery Office. Crown Copyright Reserved. Southern Gas – 100044373 and Scotland Gas – 100044366.

Warning: PDF designed for A3 colour print only with no page scaling

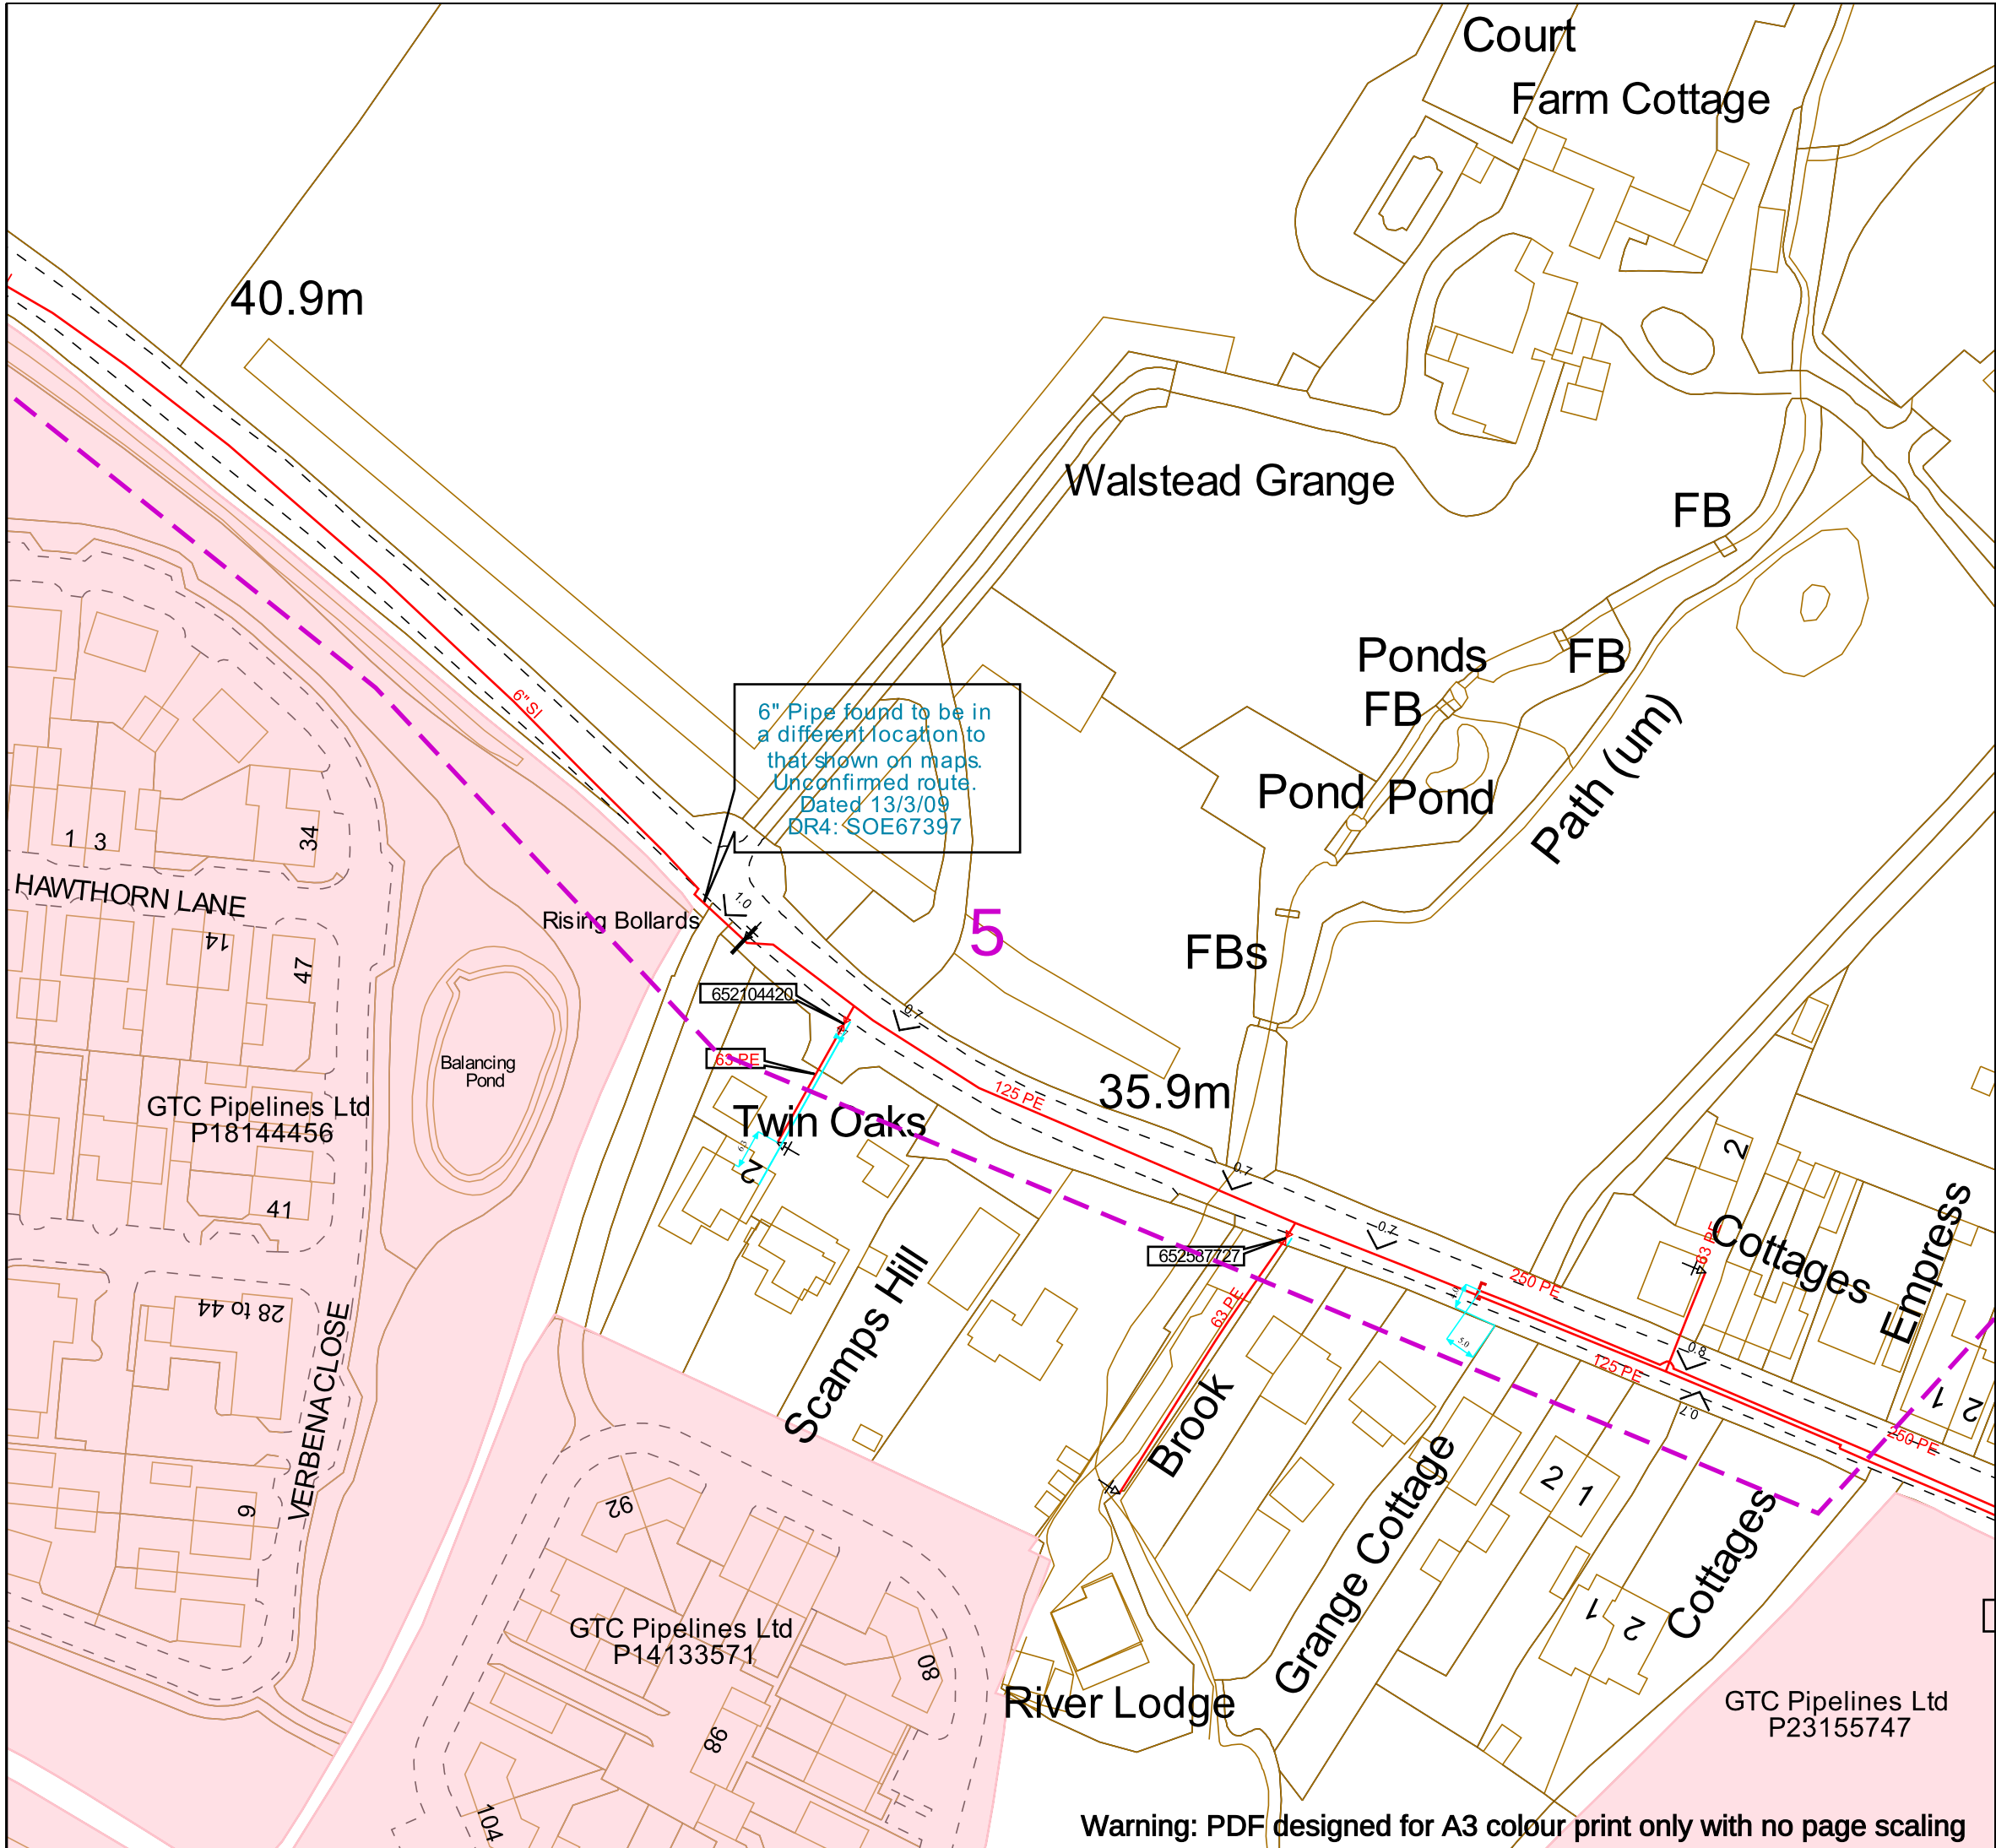

SGN
Your gas. Our network.

Contact Us
SGN Safety Admin Team:
0800 912 1722
Email:
plantlocation@sgn.co.uk

Date Requested: 19/05/2025
Job Reference: 37324868
Site Location: 535357 124821
Requested by: Mr Duncan Phillips

Your Scheme/Reference: Gladman

Scale: 1:1000 (When plotted at A3)

This plan shows the location of those pipes owned by Scotia Gas Networks (SGN) by virtue of being a licensed Gas Transporter (GT). Gas pipes owned by other GTs or third parties may also be present in this area but are not shown on this plan. Information with regard to such pipes should be obtained from the relevant owners. No warranties are given with regard to the accuracy of the information shown on this plan. Service pipes, valves, siphons, sub-connections etc. are not shown but their presence should be anticipated. You should be aware that a small percentage of our pipes/assets may be undergoing review and will temporarily be highlighted in yellow. If your proposed works are close to one of these pipes, you should contact the SGN Safety Admin Team on 0800 912 1722 for advice. No liability of any kind whatsoever is accepted by SGN or its agents, servants or sub-contractors for any error or omission contained herein. Safe digging practices, in accordance with HS (G)47, must be used to verify and establish the actual position of mains, pipes, services and other apparatus on site before any mechanical plant is used. It is your responsibility to ensure that plant location information is provided to all persons (whether direct labour or sub-contractors) working for you on or near gas apparatus. Information included on this plan should not be referred to beyond a period of 28 days from the date of issue.

Report damage immediately – KEEP EVERYONE AWAY FROM THE AREA
0800 111 999

Low Pressure Mains	
Medium Pressure Mains	
Intermediate Pressure Mains	
High Pressure Mains	
LAs	
H100 Hydrogen Network	
GTs	
SSSIs	

Some Examples Of Plant Items


Valve		Syphon		Depth of Cover		Diameter Change		Material Change	
-------	--	--------	--	----------------	--	-----------------	--	-----------------	--

Digsite: Line: Area:



This plan is reproduced from or based on the OS map by Scotia Gas Networks plc, with the sanction of the controller of HM Stationary Office. Crown Copyright Reserved. Southern Gas – 100044373 and Scotland Gas – 100044366.

Warning: PDF designed for A3 colour print only with no page scaling

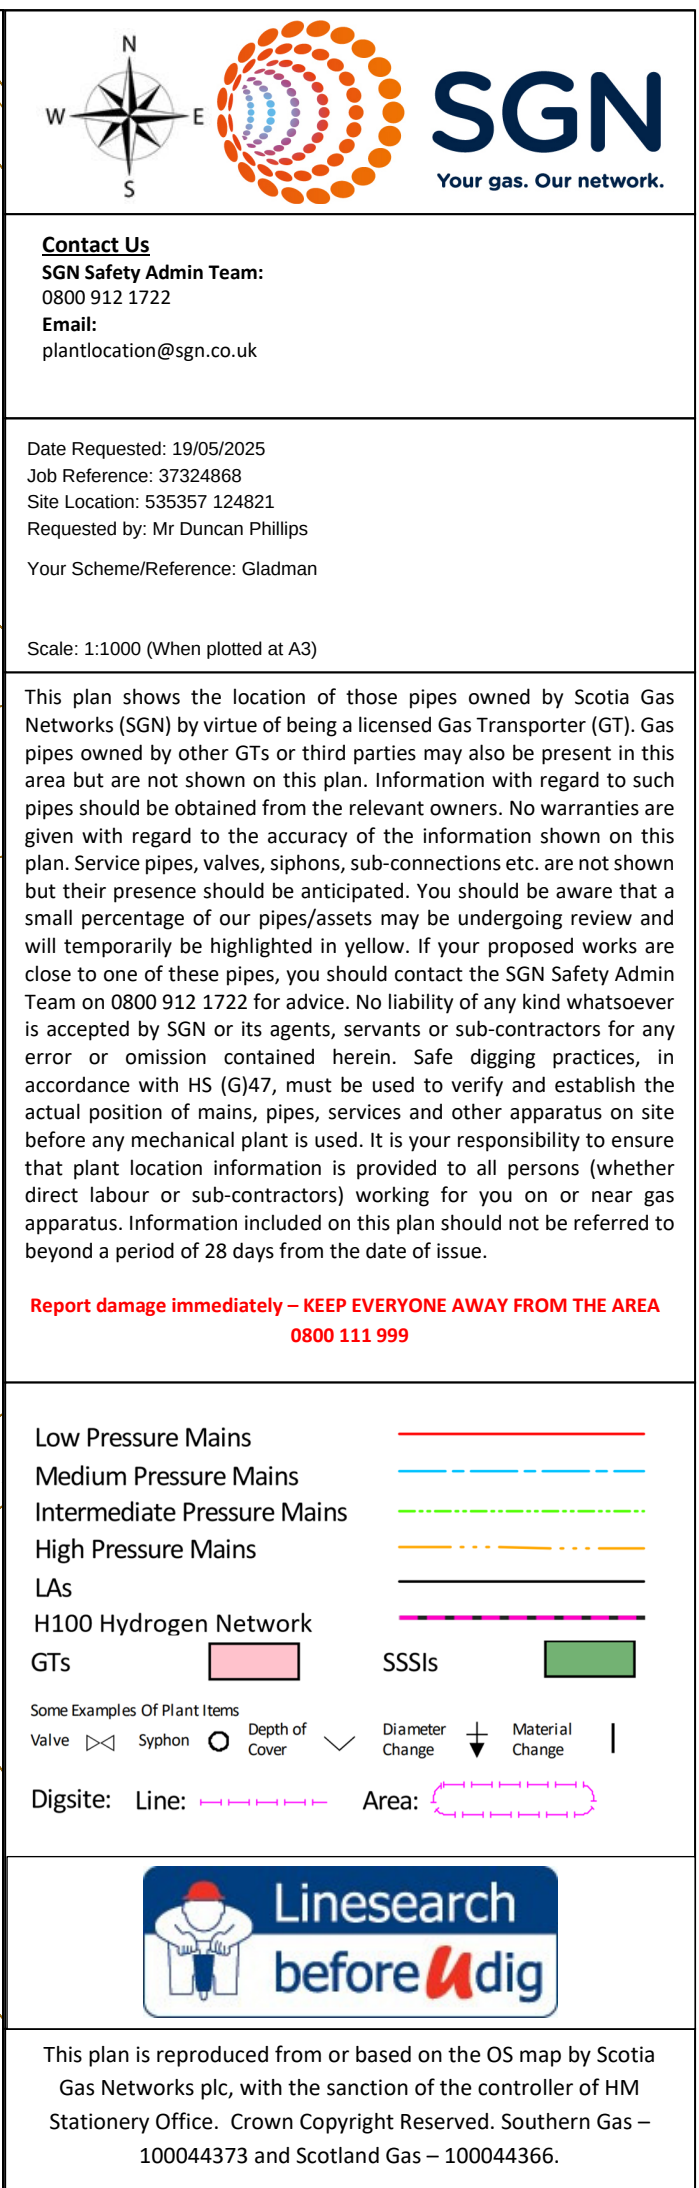

Warning: PDF designed for A3 colour print only with no page scaling

Map Symbols

						
VALVE OPEN	VALVE CLOSED	GOVERNOR	END CLOSURE	SYPHON	REDUCER	TEE
						
TEST POINT	CATHODIC PROTECTION	GENERAL REFERENCE	FLOW MEASURE	DIP POINT	MONO ETHYLENE GLYCOL	OILING POINT
						
FLOW STOP	PRESSURE MEASUREMENT	STAND PIPE	OFFICIAL MINISTRY RECORD	PURGE POINT	GAS CONDITIONER	DRAIN POINT
					LP MAINS	
SKETCH BUBBLE	DEPTH OF COVER	METER	MATERIAL CHANGE		MP MAINS	
					IP MAINS	
					LHP MAINS	
					HISTORY DATA	
					SSSI	
PIG TRAP	CROSSOVER CONNECTION	CHANGE OF DIAMETER	PIPE JOINT		CONTACT ZONE	
						LTS



SGN
Your gas. Our network.

Know what's below

Protecting you and your family

Protecting you and your family

Are you planning on carrying out any home improvements such as building a conservatory, an extension, a new pond, decking, concreting, landscaping, fencing or planting trees in your garden? You must make sure you have drawings/maps showing any pipes or cables around your home. To obtain copies of our gas drawings/maps please visit our **Dig safely** pages on sgn.co.uk and follow the link to our online system.

This service is free of charge.

Our Dig safely page is also where you'll find advice on any protective measures you may need to take before you start work, whether you're planning on doing it yourself or hiring a professional.

Damaging gas pipes is dangerous and could lead to a fire or an explosion. It could also cause large-scale loss of gas supply to the local community and is potentially very expensive.



Responsibilities

It's the responsibility of whoever is doing the work to make sure they've complied with the relevant legislation and Health and Safety Executive (HSE) guidance.

In practice, this means anyone carrying out work must obtain a copy of any available colour drawings showing the position of buried utilities for reference before and during the project.

Non-recording of service pipes >

Individual service pipes are not normally recorded on gas network drawings. This is accepted practice and reinforced by guidance given in Design, construction and installation of service pipes – approved code of practice, published by the HSE, and IGE/TD/4 – Gas Services, published by the Institute of Gas Engineers and Managers.

What you need to do when planning a conservatory or house extension, landscaping, fencing or any other groundworks

It's the responsibility of whoever is undertaking the work to check with utility companies before the work starts.

If you're planning any building or digging work remember that gas pipes, power cables, water pipes and sewers all run underground and could be right beneath your feet. Construction or excavation work can damage underground services or prevent further maintenance.

Remember that obtaining planning permission or a building warrant from your local authority doesn't normally involve consultation with utility companies so you should get in touch with them when you start planning your project. This will help keep everyone safe.

Please visit our **Dig safely** pages on sgn.co.uk for more information and our online mapping system.



< Service entry

Gas services/work in gardens

If you're going to be carrying out work around your home, or a third party is carrying out work on your behalf and you have requested a map from us, **your own gas service may not be marked**. The simplest way to understand the location of your gas service is to know where it enters your house, as pictured.

Your gas service pipe usually takes the shortest route to the gas main, as shown on the sample network map/drawing above.

If you're unsure and need further help, please contact us and we'll arrange for a Plant Protection officer to contact you.



Any damage, however minor, must be reported to the National Gas Emergency Service

Planting a tree or landscaping your garden

Tree roots can damage utilities.

If you're planting trees or shrubs, make sure you consider the type of plant, root type and their location in relation to buried gas pipes to avoid any damage. We may need access to repair and maintain our pipes and equipment in the future, and we reserve the right to remove any tree or bush if we need to.

What happens if you damage a pipe?

If you damage a gas pipe:

- Call the National Gas Emergency Service on **0800 111 999** immediately
- **DON'T** attempt to make repairs yourself
- **DON'T** handle or attempt to alter the position of the exposed pipe

Damaging a gas pipe can result in:

- Major fire/explosion leading to death or serious injury
- Asphyxiation due to gas exposure leading to death or serious injury
- Loss of gas supply to individuals or communities
- Financial costs to you for repair and remedial work
- Enforcement action by the HSE

We will recover all reasonable costs incurred in repairing damaged gas pipes.

Delivering gas safely, reliably and efficiently

Your safety is our top priority

We manage the network that distributes natural and green gas to over 5.9 million customers in Scotland and the south of England.

We own and operate 74,000km of gas mains, and associated plant and equipment. We're committed to delivering gas safely, reliably and efficiently to every one of our customers.



All our engineers and contractors carry a photo ID card with our company logo on it. Don't be afraid to check with our Security team on **0800 015 5170** that the person on your property is supposed to be there.



Service entry



Meter box

Accidental damage to our pipes could put you or members of the public at risk.

Help

If you're planning any work on or around your property and you need more information, you'll find everything you need on our Dig Safely pages.



sgn.co.uk



0800 912 1722

Smell gas? 0800 111 999

Follow these six steps if you smell gas:



DO open windows and doors to help ventilate the gas



DO turn off the gas supply at the meter and make sure any gas appliances are turned off



DO call the **National Gas Emergency** number on **0800 111 999**. Lines are open 24 hours a day, 365 days a year



DON'T smoke or use any naked flames



DON'T touch any electrical switches. Turning a switch on or off could ignite a gas leak



DON'T enter a cellar if you smell gas, even if your gas meter is located in the cellar



Dig safely

Measures to avoid injury
and damage to gas pipes

The following protective and precautionary measures **MUST** be taken when working in the vicinity of gas mains and services.

It is the responsibility of the property owner or company carrying out the work to make sure they've complied with the relevant legislation and Health and Safety Executive (HSE) guidance, eg HS(G)47. In practice, this means that whoever is carrying out the work **MUST** obtain gas mains location information and/or maps showing the indicative position of the gas network before any work takes place.

To avoid injury to yourself, your employees, colleagues and the general public you MUST suitably mark the position of the pipes on site.

HS(G)47 outlines best practice that should be followed to ensure you work safely:

1. Plan the work, obtain maps.
2. Detecting, identifying and marking underground services.
3. Safe excavation and safe digging practices.

In addition to the requirements under the Health and Safety At Work etc. Act 1974 to prevent injuries to employees and others (not employed), it is an offence under regulation 15 of the Pipelines Safety Regulations 1996 to cause damage to a pipeline (which includes gas mains and services as well as higher pressure pipelines) so as to give rise to a danger to persons.

You MUST make sure that current full colour copies of our maps are issued to all relevant personnel on site and they're aware of the presence and location of our gas mains and services prior to any excavation.

In a gas emergency


If you cause a gas leak or suspect a main or service pipe or equipment is leaking, you **MUST** take the following emergency actions immediately:

- Ask people to move away from the area of the gas escape.
- Call **0800 111 999** immediately.

1. Don't attempt to repair the escape or stop the leakage.
2. As gas may enter buildings, ask people in the surrounding premises to leave until it's safe for them to return.
3. Stop anyone going near the immediate vicinity of the gas escape.
4. Prohibit smoking and extinguish all naked flames.
5. Don't use mobile phones or other ignition sources.
6. Assist our representatives and other emergency services such as the police, ambulance, and fire service as requested.

Additional reference material

- SGN guidance for Safe Working in the Vicinity of Pipelines & Associated Installations operating >7barg. Applicable for HP only.
- HS(G)47 **Avoiding Danger from Underground Services** available from hse.gov.uk
- NJUG **Utilities Guidance on Positioning and Colour Coding of Apparatus** available from njug.org.uk

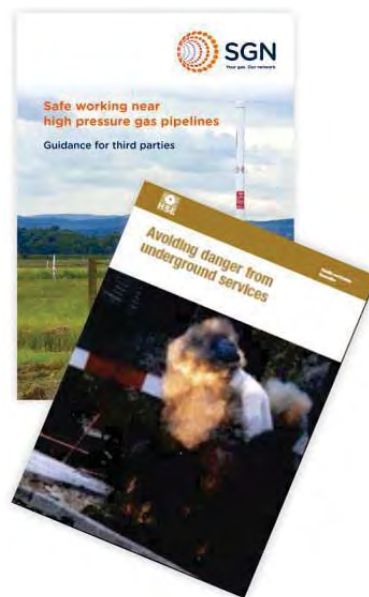

Making an enquiry for gas mains or services maps

Please visit our **Dig safely** pages on sgn.co.uk for plant protection information and links to our online mapping system and other associated information and guidance.


Our simple and easy to use online mapping system is available 24/7, 365 days a year.

You'll need to register/log in and provide a few details about your site location and the work you'll be carrying out. We'll respond immediately by email.

What you're likely to be sent

You'll be sent an email with a map. This will be an extract from our gas mains record, showing your site and any of our gas pipes as well as relevant safety information.

We always send out safety information, however we may forward your enquiry on to a local plant protection officer or a pipelines engineer to make direct contact with you depending on the work location.

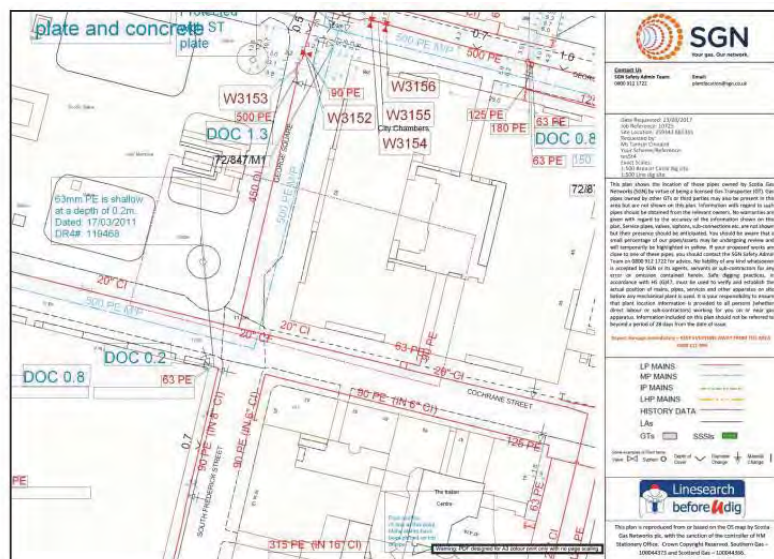

Example of a gas map

Note: Service pipes are not shown on our maps

When working near our gas mains and services

Safe system of work

To satisfy ourselves that work in the vicinity of our gas mains is being carried out safely, we may ask for a copy of your risk assessment and/or method statement paperwork.

Where work falls under the Construction (Design and Management) Regulations 2015 reference to our gas mains and services MUST be made within your site Health and Safety file.

Financial

Every reasonable precaution MUST be taken to avoid personal injury or damage to our gas network at all times.

If we incur any costs to repair direct or consequential damage or divert any gas main or service, you'll be recharged in full.

HSE

Any damage to our gas mains or services will be subject to legislative reporting responsibilities to the Health and Safety Executive under Reporting of Injuries, Diseases & Dangerous Occurrences Regulations 2013, Gas Safety Management Regulations 1996, and the Pipelines Safety Regulations 1996.

Minimum safe working distances

Depending on the activity being undertaken and the gas mains or services you are working within the vicinity of, there are different safe distances that MUST be adhered to. SGN plant protection officers or pipeline engineers will inform you of these if required.

Surface boxes and manholes

Do not bury or move our surface boxes. Free access MUST be maintained during and after your work. No manhole cover or other structure can be built over, around or under a gas main, and no work is to be carried out that results in a reduction or increase in cover or protection without prior written agreement.

Deep excavations

Adequate protection, approved by us, MUST be applied for any deep excavations in the vicinity of our gas mains and services that may affect its security and integrity. Ground movement around gas mains MUST be prevented. We MUST be contacted if a sewer trench or any other water authority is to be constructed at greater than 1.5 metres depth near a buried gas main or service pipe. You MUST give us detailed drawings showing the line and width of the proposed sewer or other trench, together with the soil group classification of the area concerned.



Crossing our mains or services

The placing of heavy construction plant, equipment, materials or the passage of heavy vehicles over our gas mains is prohibited unless specifically agreed protective measures (ie the construction of reinforced crossing points) have been carried out. This is particularly important where reductions in side support or ground cover are planned. You **MUST NOT** carry out any work in servitudes/easements without our prior written consent.

Exposed plant

Where excavations in the vicinity of our gas mains affect its support, the plant **MUST** be adequately supported and protected in consultation with us and to our satisfaction. It **MUST** be protected from impact, restraints and thrust blocks, and supports **MUST NOT** be removed without our agreement.

Hot work

One of our representatives should be present when welding or other hot work involving naked flames is being carried out near our gas mains, as there's potential for heat damage to plastic pipeline/coatings.

Backfilling

Concrete backfill should not be placed closer than 300mm to our mains. No concrete or hard material should be placed under or adjacent to any of our gas mains. Shuttering **MUST** be constructed to maintain the stated clearances and prevent fresh concrete encasing our mains or services. Material used for backfill around our gas mains **MUST** conform to the following:

- If sand, it **MUST** be well-graded in accordance with BS EN 12620:2002.
- It **MUST NOT** contain any sharp particles (stones, bricks, lumps or corrosive materials).
- Foamed concrete **MUST NOT** be used.
- It **MUST** be laid to a minimum depth of 250mm above the crown of the gas main.

Note: Power ramming **MUST NOT** take place until a 300mm hand rammed layer has been completed over the crown of the main.

Access

Free access to our sites, mains and services, including temporary structures and spoil heaps **MUST** be available at all times.





Mechanical excavation

Mechanical excavators (including breaker attachments) **MUST NOT** be used within the following distances from the confirmed location of our gas mains and services shown on our gas maps without prior agreement:

Type of mains and services	Gas map identification	Hand excavation required inside	Pipe pressure indication shown on map
Low Pressure (LP)	0 - 75mbar	0.5 metres	—————
Medium Pressure (MP)	75mbar to 2 bar	0.5 metres	— — — — —
Intermediate Pressure (IP)	2 - 7 bar	3.0 metres	— — — — —
High Pressure (HP)	Above 7 bar	You must seek approval from us prior to any work	— — — — —

Major accident hazard pipelines

High pressure pipeline

No work is to take place near an HP pipeline until it is agreed with us. After agreement and before any work does take place, the location of our pipeline **MUST** be marked up and its position confirmed by digging trial holes with our personnel in attendance.



Pipeline markers

High pressure

We will be involved in any work taking place near high pressure pipelines. We will provide you with additional information that you **MUST** familiarise yourself with before carrying out any work.

The default method of excavating near high pressure gas pipelines MUST always be by hand.

Wind turbines

The UK Onshore Pipelines Operations Association (UKOPA) has identified the appropriate exclusion zone (distance from the base of the wind turbine mast to the edge of the pipeline) as 1.5 times the turbine height. Contact MUST be made with us during the planning stages of a wind turbine or wind farm.



Tree planting

If trees or shrubs are to be planted in the vicinity of our gas mains and services, the selection of tree or shrub type and how it's planted **MUST** be considered carefully. This is to avoid root damage to buried mains or services, and to ensure our subsequent excavations for main repair and maintenance won't damage the trees or shrubs.

Written approval from us **MUST** be obtained before any tree planting is carried out on a servitude/easement. Any approval we grant to plant trees

The following trees and those of similar size (deciduous or evergreen) **MUST NOT** be planted within 6m of the centre line of the main: ash, beech, birch, most conifers, elm, maple, lime, horse chestnut, oak, and sycamore. Apple and pear trees are also included in this category.

Dwarf apple stocks may be planted up to 3m of the centre line of the main.




In cases where screening is required, the following are shallow rooting and may be planted close to the gas mains and services: blackthorn, broom, cotoneaster, elder, hazel, laurel, quickthorn, privet, snowberry and most ornamental shrubs.

Gas main centre


Raspberries, gooseberries and blackcurrants may be planted on the gas main, but a four metre strip, centred on the main, **MUST** be left clear at all times.

on a servitude/easement will be subject to us retaining the right to remove any tree, which in our opinion may become a danger to our mains in the future.

The written consent to plant trees will state what area may be planted and also the type of tree. The diagram details the specific species and the distances they **MUST** be planted from gas mains or services. You **MUST** contact us for further information.

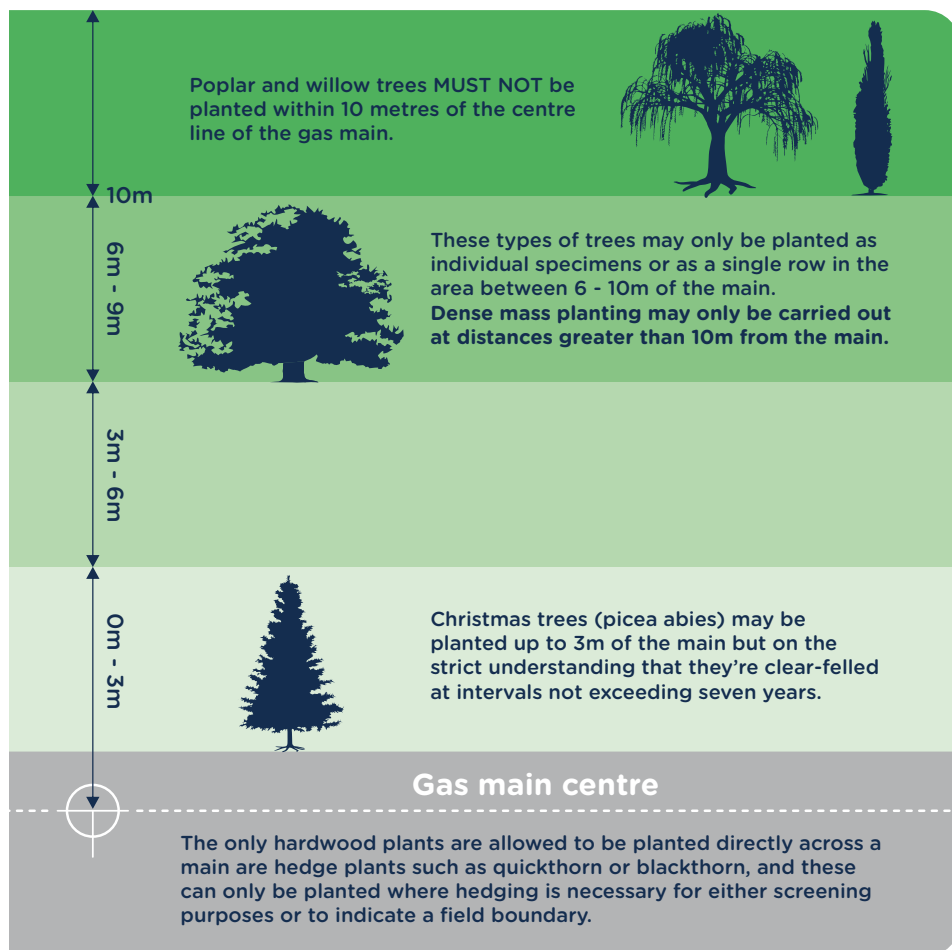

Note: For further guidance, please refer to NJUG 10.

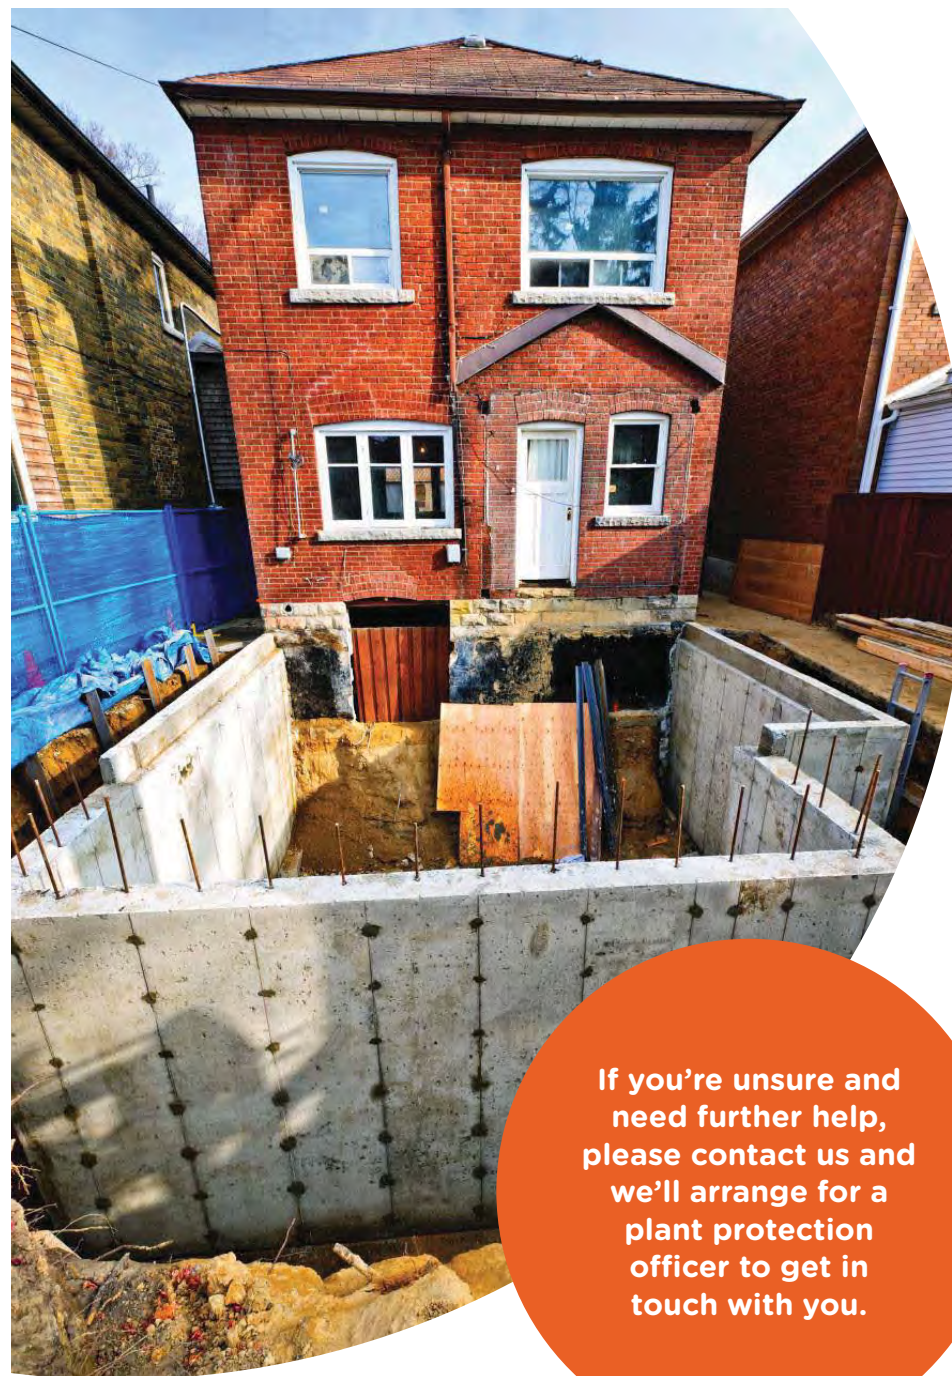


If you're unsure and need further help, please contact us and we'll arrange for a plant protection officer to get in touch with you.


Gas services/work in gardens

If you're going to be carrying out work around your home, or a third party is carrying out work on your behalf, we may send you a site map of our gas mains and services but your own gas service won't be marked.

The simplest way to understand the location of your gas service is to know where it enters your house.

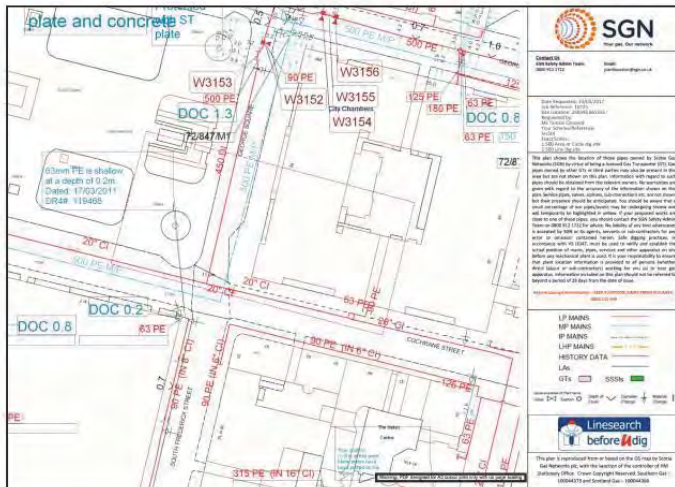

< Your gas service pipe usually takes the shortest route to the gas main, as shown on the sample network map/drawing.

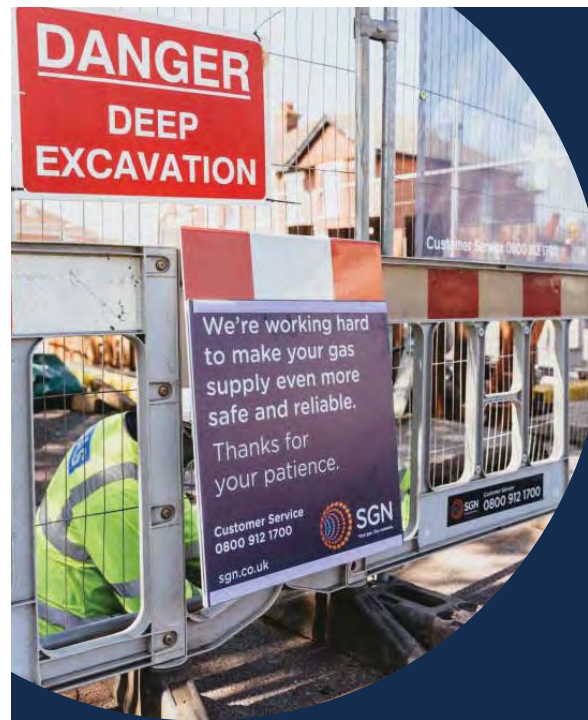

We provide a free plant location enquiry service and we're always happy to help.

[www](http://www.sgn.co.uk) Visit our Dig safely pages on sgn.co.uk

 0800 912 1722 *

*All calls are recorded and may be monitored

Safety Advice - Valves




Guidance when undertaking work near gas valves in our network areas

SGN manages the network that distributes gas to 5.8 million homes and businesses across Scotland and the south of England.

Due to a manufacturing issue, we are currently replacing or upgrading certain valve types that are at risk of bolt failure. In extreme cases, this can lead to gas escapes. This is a safety hazard and we have produced this guide to ensure you undertake adequate safety precautions when working near gas valves.

Identifying gas valves

The images below are an illustration of typical gas valves. Please note, valves come in various colours, shapes and sizes, and you may come across a valve that looks different to those found in the images.

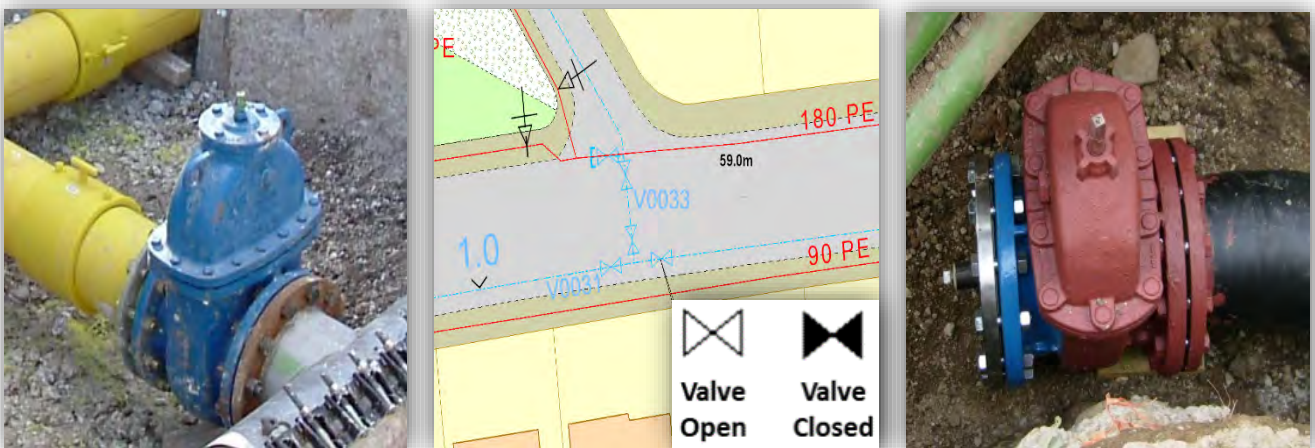

What should you do?

When planning to work in our network areas, please observe the following points:

1. You must contact us before starting any work activity within **3.0m** of a gas valve identified on our maps.
2. If an unexpected gas valve is exposed you must immediately stop excavation works and report this to us.
3. To protect yourself against the risks associated with exposing a valve, we advise that you contact us when in doubt.

Contact details


If you require further information or need assistance please contact us:

Safety Admin Team: **0800 912 1722**
plantlocation@sgn.co.uk

Valve enquiries will be forwarded to a local engineer who will provide further safety information.

WATER

SEWER

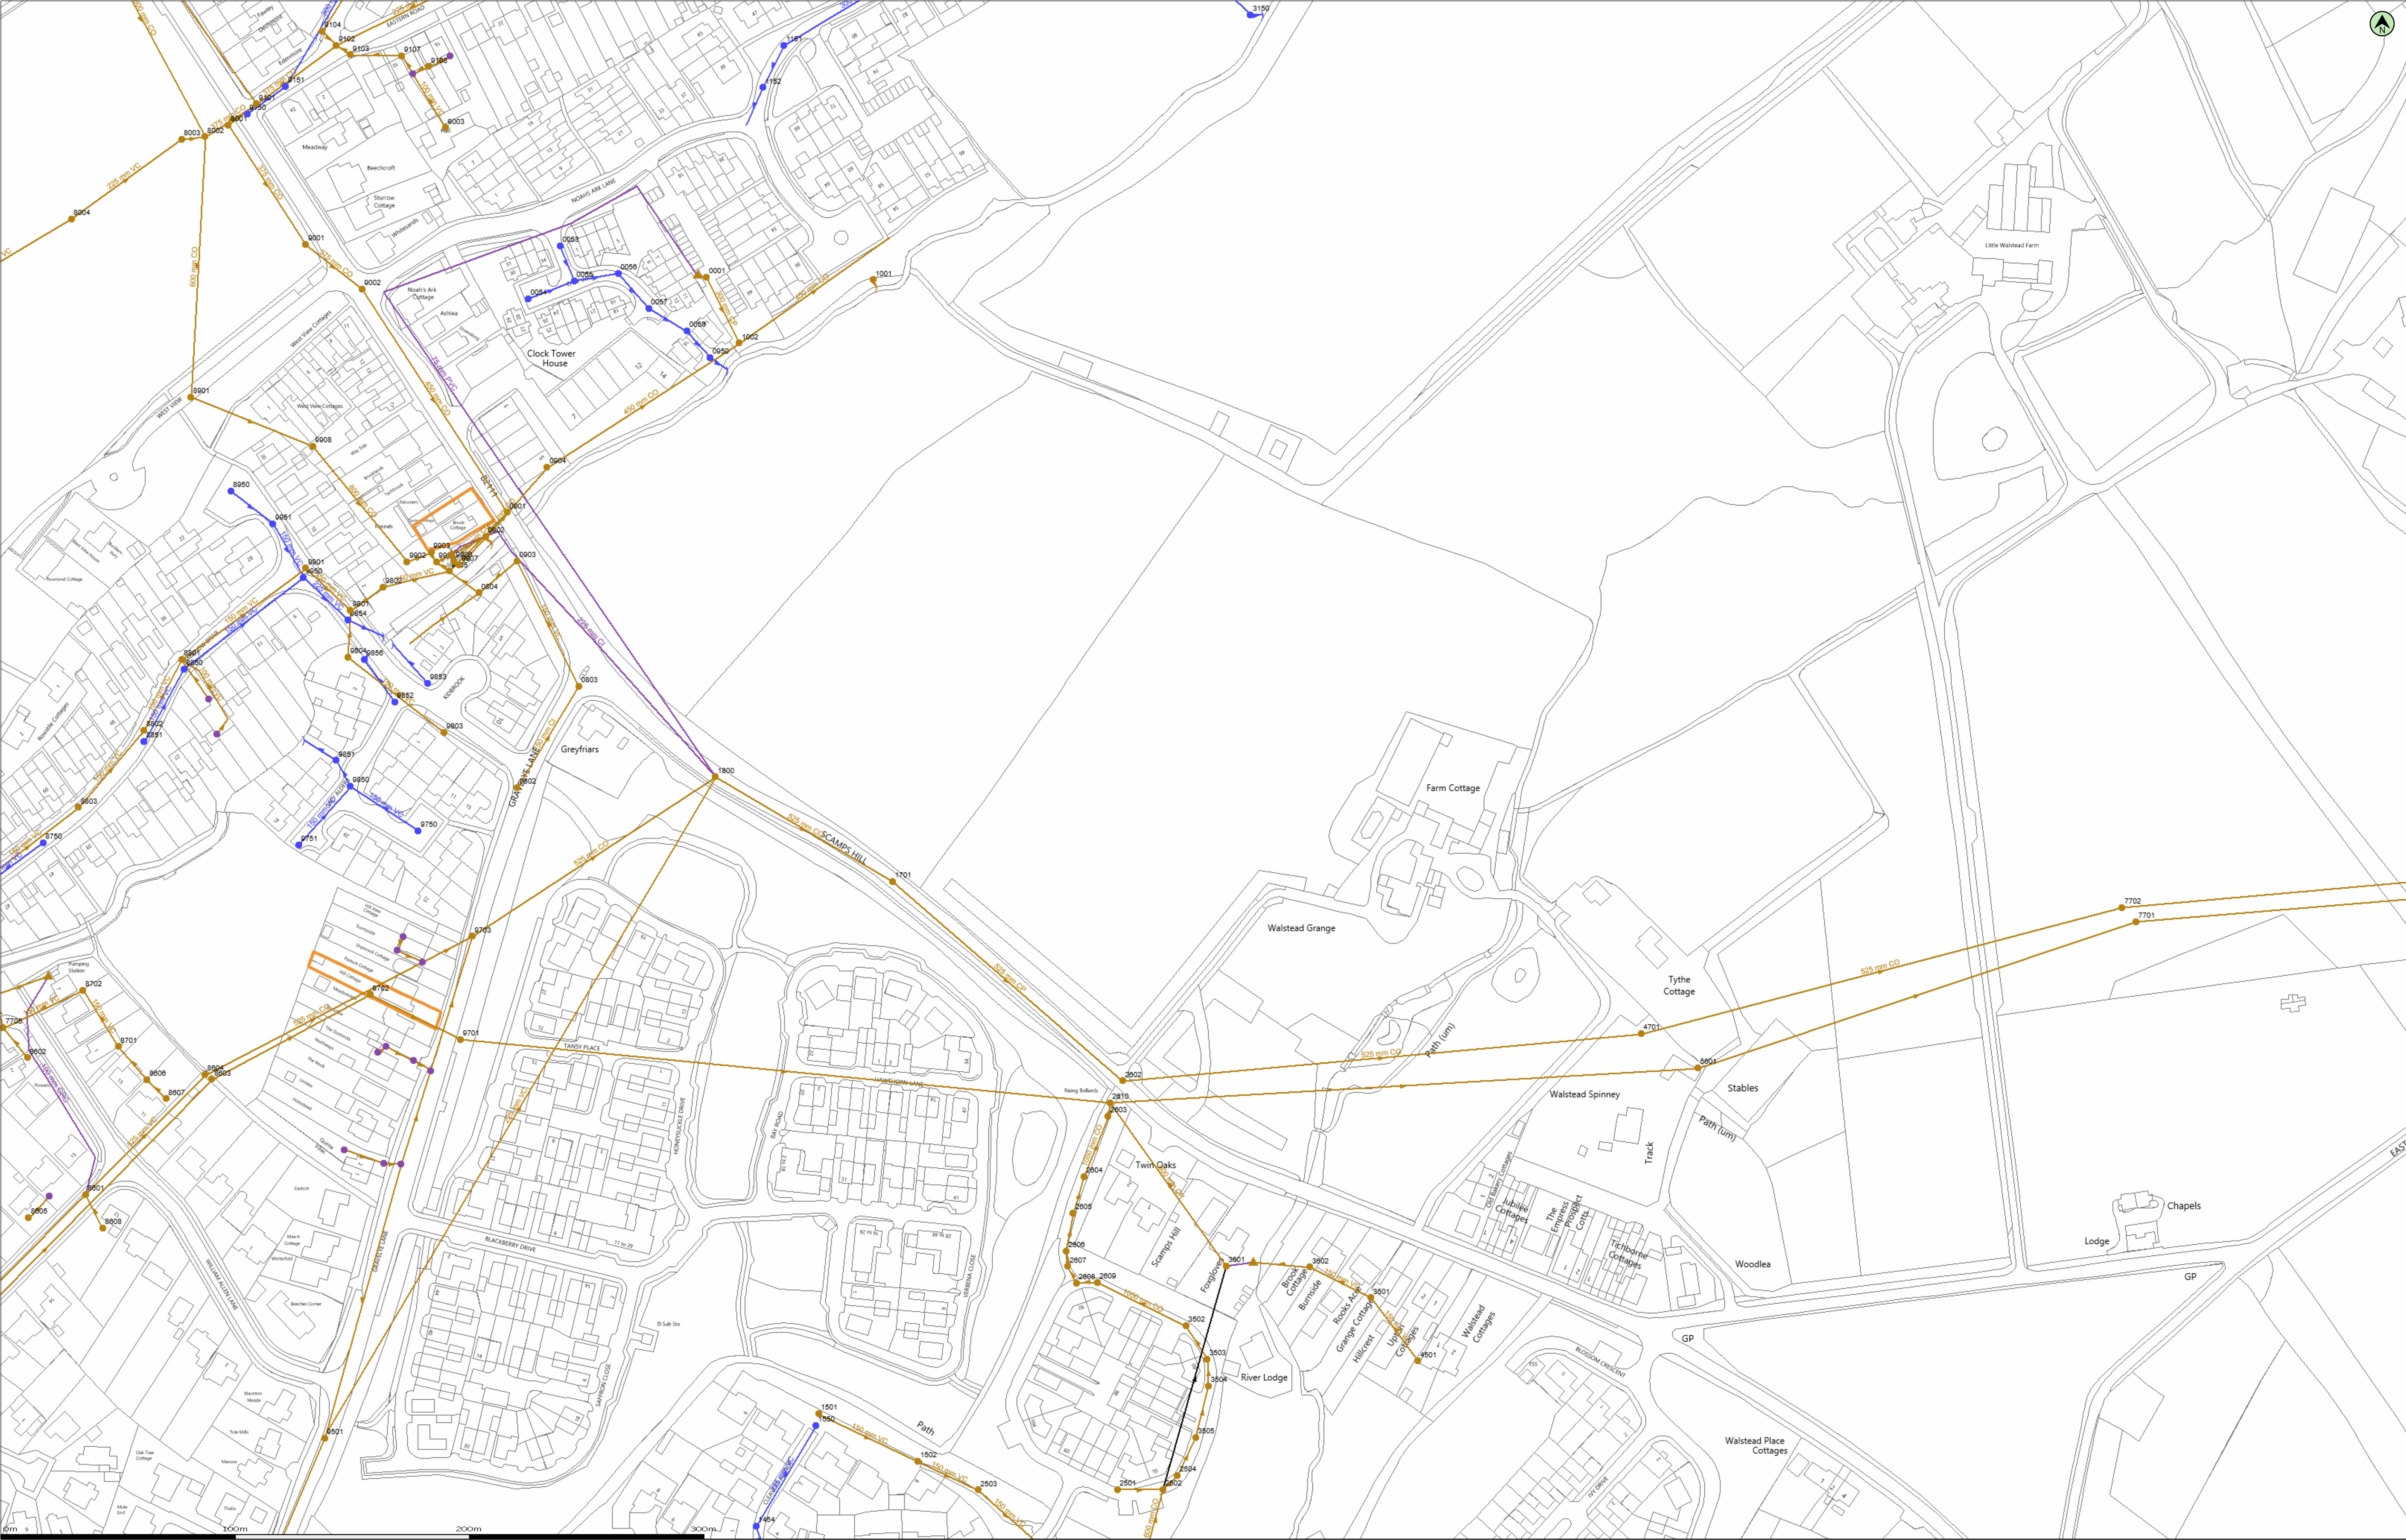

(c) Crown copyright and database rights 2025 Ordnance Survey AC0000808122 Date: 19/05/25 Scale: 1:1250 Map Centre: 535310,124821 Data updated: 20/03/25 Our Ref: 1772846 - 2

The positions of pipes shown on this plan are believed to be correct, but Southern Water Services Ltd accept no responsibility in the event of inaccuracy. The actual positions should be determined on site. This plan is produced by Southern Water Services Ltd (c) Crown copyright and database rights 2025 Ordnance Survey AC0000808122. This map is to be used for the purposes of viewing the location of Southern Water plant only. Any other uses of the map data or further copies is not permitted.

WARNING: BAC pipes are constructed of Bonded Asbestos Cement.

WARNING: Unknown (UNK) materials may include Bonded Asbestos Cement.

duncan@cornerstoneprojects.co.uk
Gladman



Wastewater Plan A1
Powered by digiart

BT

Our Ref: Ref shown on map

email: nnhc@openreach.co.uk

Date of issue shown on map

Dear Customer,

NR & SW ACT 1991 – PROPOSED WORKS AT:

Prior to commencement of work: for free onsite guidance and accurate up to date location of BT plant please contact our Plant Protection Service by the following methods

Email Dial before you dig CBYD@openreach.co.uk

Visit the website www.openreach.co.uk/cbyd

Thank you for your request of describing the above proposals.

Enclosed are copies of our drawing marked up to show the approximate locations of BT apparatus which is present in the immediate vicinity of your works. It is intended for general guidance only. No guarantee is given of its accuracy.

It should not be relied upon in the event of excavations or other works made near to British Telecommunications plc apparatus which may exist at various depths and may deviate from the marked route.

To avoid damage it is recommended that mechanical excavators or borers are not used within 600mm of British Telecommunications plc plant. If scaffolding is erected, please ensure that our equipment is not enclosed, blocked, covered or otherwise obstructed by the scaffolding.

In the event of BT apparatus being in the area of works we recommend that your plant/vehicle crossing is either resited, or apply for a budget estimate by submitting detailed plans to the above address, these will be forwarded to the appropriate department for their comments.

Please ensure you quote our reference on any future correspondence.

Yours faithfully,

Openreach Plant Maps Requested

NewSite Office (addresses can be found on [the New Developments contact page](#))

Dear Sir/Madam,

You have downloaded copies of our drawings marked up to show the approximate location of Openreach apparatus, which is present in the immediate vicinity of your works. It is intended for general guidance only. No guarantee is given of its accuracy. It should not be relied upon in the event of excavations or other works made near to Openreach apparatus, which may, exist at various depths and may deviate, from the marked route.

To avoid damage it is recommended that mechanical excavators or borers are not used within 600mm of Openreach plant. Please ensure that our equipment is not enclosed, blocked, covered or otherwise obstructed by your plant. In the event of clearance not being adequate we anticipate that your plant is either resited, or an order is placed with Openreach for rearrangements of its plant. If there are any difficulties with the Map please email cbyd@openreach.co.uk

Please contact our Network Protection Service by Email on cbyd@openreach.co.uk giving four calendar weeks notice of your commencement date. This will provide you with on-site advice and a check of location for any Openreach apparatus.

Further to this, I hope the following points will assist you at the new development: -

Openreach has a licence obligation to provide service to any end customer requiring a connection. A Developer would not normally be charged for provision of service, our standard connection charges would apply to the end user when orders are placed with the communication provider of choice. However, should a Developer insist on an underground service in an area where Openreach plant is provided overhead, charges may be incurred.

When the Developer has obtained contract and planning permission Openreach would request a 'Clean', scaled Site Layout, Location Map and a covering letter be sent to the relevant newSite Office. We would particularly request that you give details of your programmed site start date and likely first occupancy date where possible. To obtain contact details of the newSite office covering the development area click on the URL below.


<http://www.newdevelopments-openreach.co.uk/ContactUs.aspx>

Where a development affects existing Openreach apparatus in the public highway, the cost of any necessary protection or diversionary works must be borne by the Developer. In this case where a budget estimate is required a Site Plan, Location Map and a covering letter should be forwarded to the Repayments Project Office. Please visit www.openreach.co.uk/alterationscontacts for contact details of the Repayments Office covering the development area.

Yours faithfully,

Openreach newSites

Maps on Demand Plant Information Reply

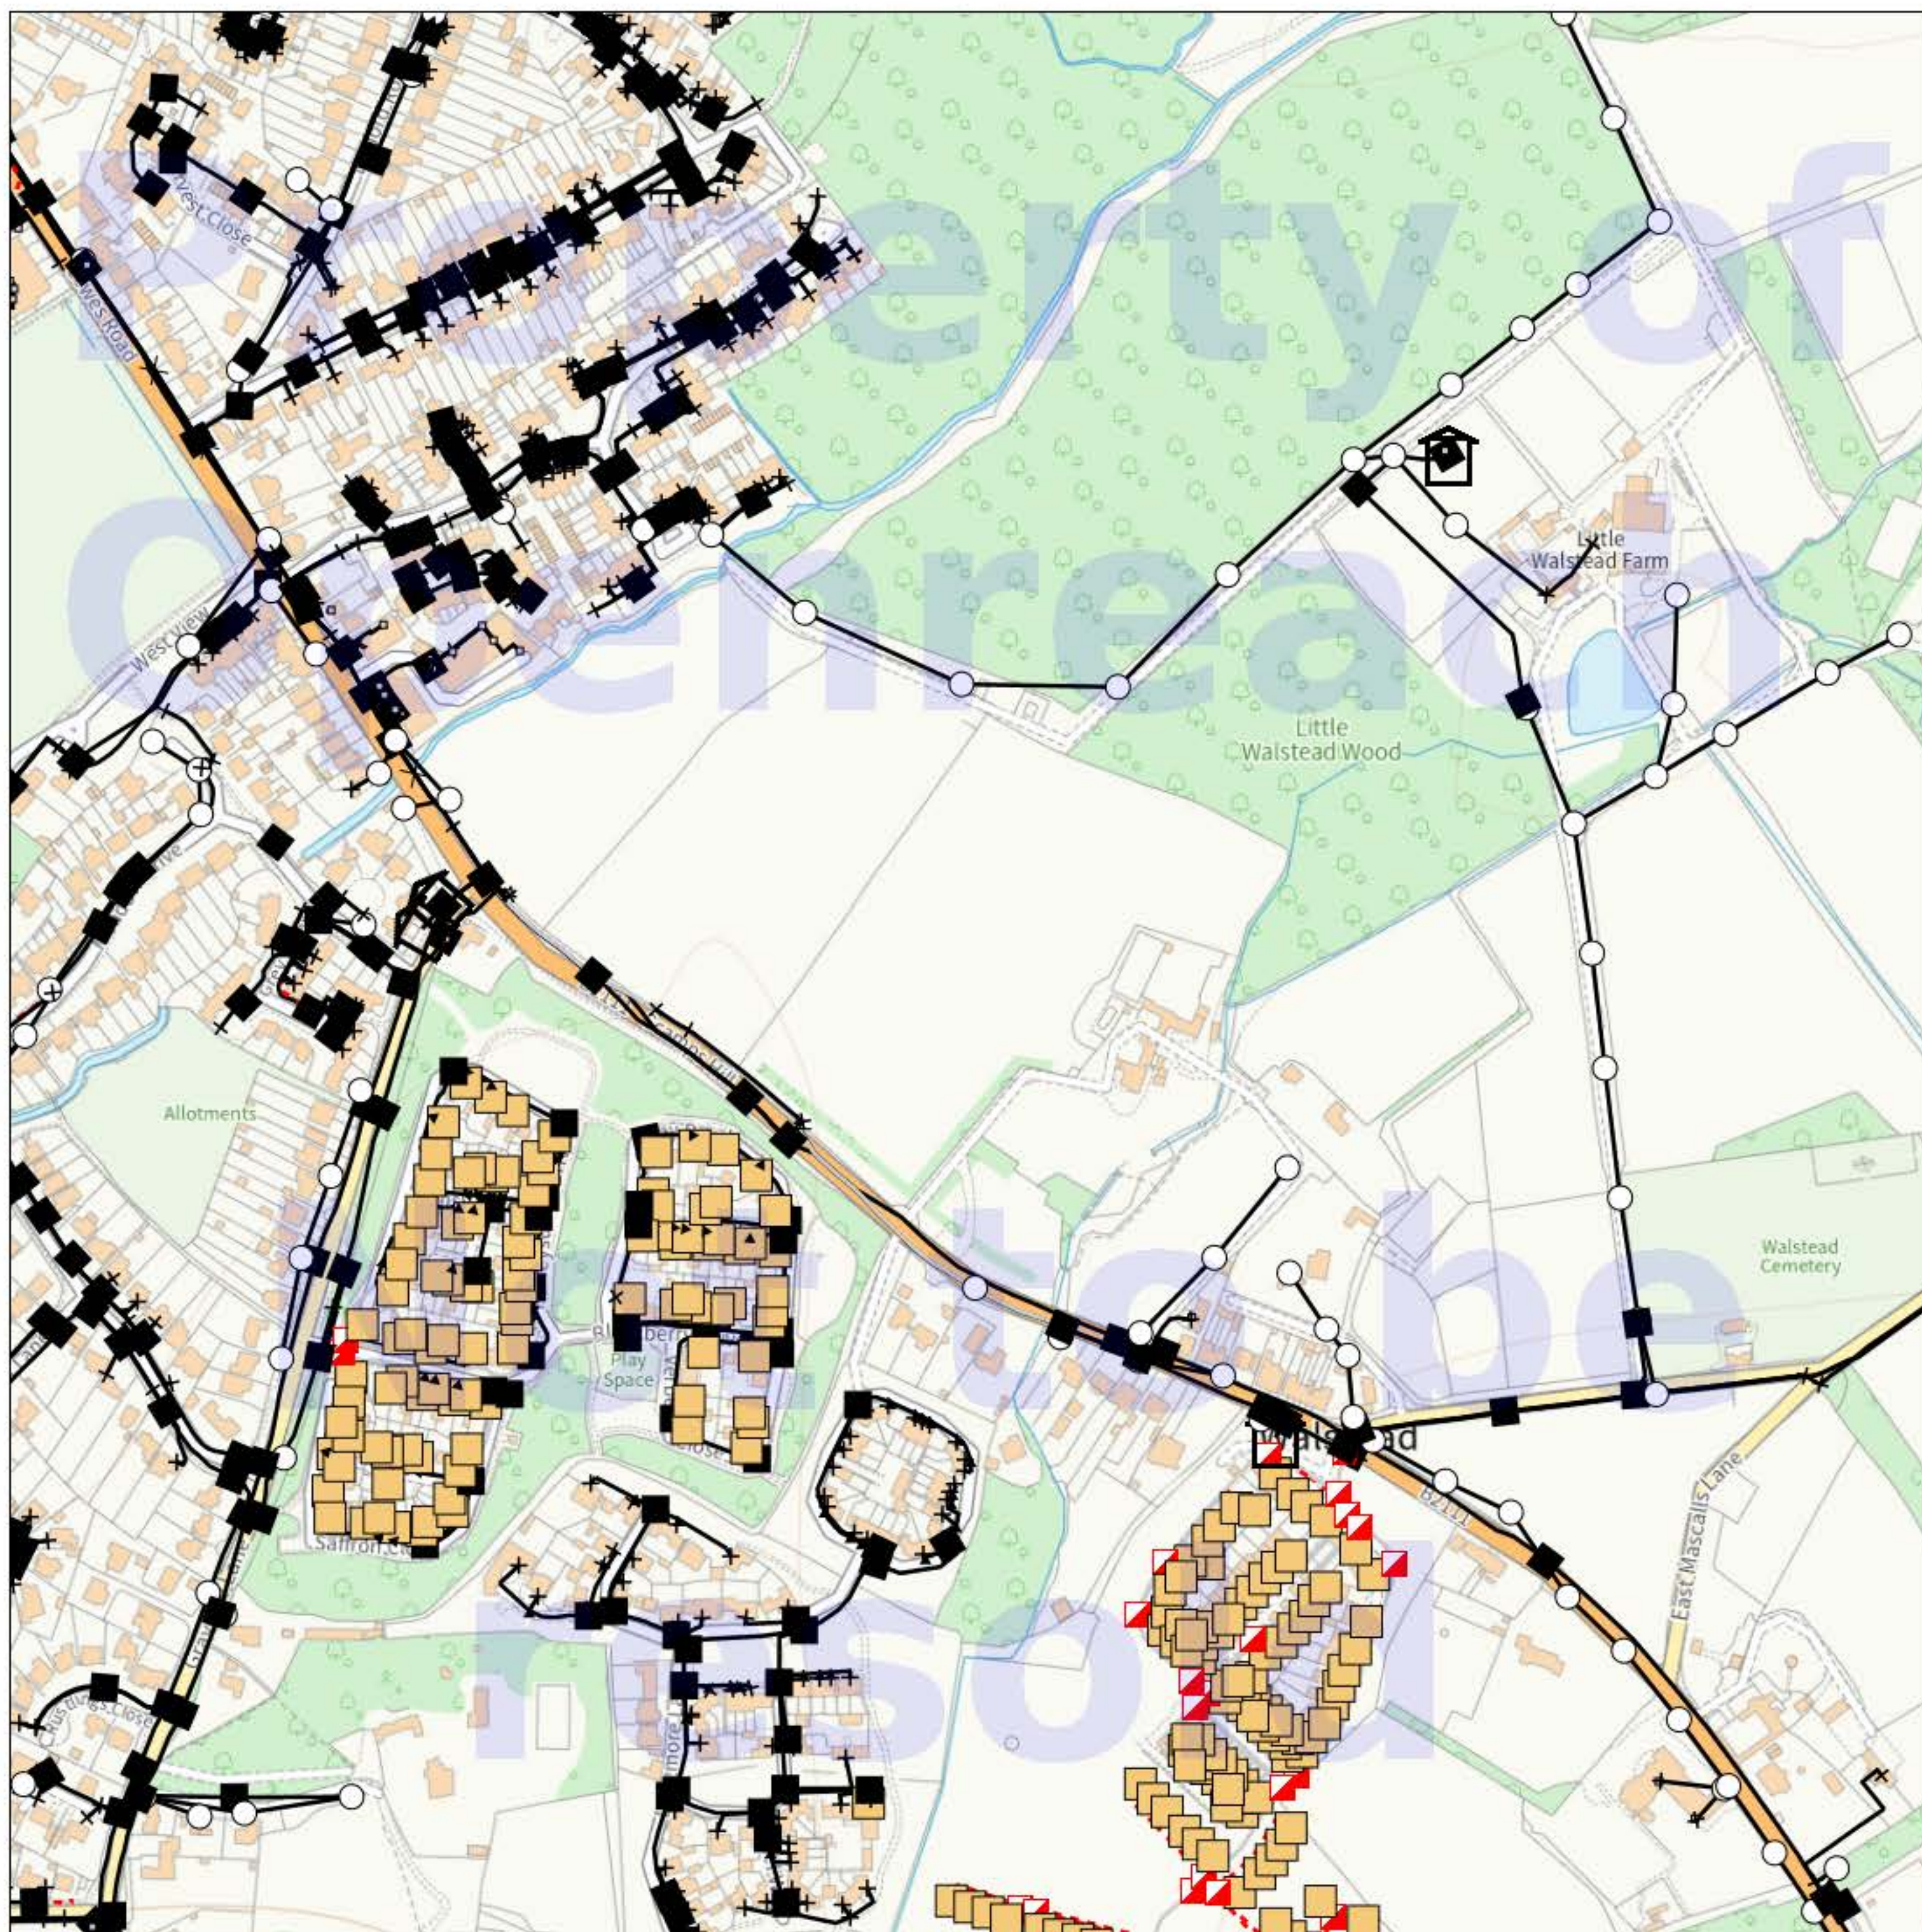

IMPORTANT WARNING

Information regarding the location of BT apparatus is given for your assistance and is intended for general guidance only. No guarantee is given of its accuracy. It should not be relied upon in the event of excavations or other works being made near to BT apparatus which may exist at various depths and may deviate from the marked route.

openreach

CLICK BEFORE YOU DIG

FOR PROFESSIONAL FREE ON SITE ASSISTANCE PRIOR TO COMMENCEMENT OF EXCAVATION WORKS INCLUDING LOCATE AND MARKING SERVICE

email cbyd@openreach.co.uk

ADVANCE NOTICE REQUIRED
(Office hours: Monday - Friday 08.00 to 17.00)
www.openreach.co.uk/cbyd

Accidents happen

If you do damage any Openreach equipment please let us know by calling 0800 023 2023 (opt 1 + opt 1) and we can get it fixed ASAP

© Crown copyright 2023 OS 100028040. You are permitted to use this data solely to enable you to respond to, or interact with, the organisation that provided you with the data. You are not permitted to copy, sub-license, distribute or sell any of this data to third parties in any form.

KEY TO BT SYMBOLS

		Change Of State	+	Hatchings	
		Planned	Live	Split Coupling	
PCP			Duct Tee		
Pole			Building		
Box			Kiosk		
Manhole			Other proposed plant is shown using dashed lines. BT Symbols not listed above may be disregarded. Existing BT Plant may not be recorded. Information valid at time of preparation. Maps are only valid for 90 days after the date of publication.		
Cabinet					
		Pending Add	In Place	Pending Remove	Not In Use
Power Cable					
Power Duct					N/A

BT Ref : CZH09591N

Map Reference : (centre) TQ3531024821

Easting/Northing : (centre) 535310,124821

Scale : 1:1000

Issued : 19/05/2025 09:59:53

WARNING: IF PLANNED WORKS FALL INSIDE HATCHED AREA IT IS ESSENTIAL BEFORE PROCEEDING THAT YOU CONTACT THE NATIONAL NOTICE HANDLING CENTRE. PLEASE SEND E-MAIL TO: nnhc@openreach.co.uk

ELECTRIC

Our Ref: 37324868 Your Ref: Gladman

Monday, 19 May 2025

Duncan Phillips
91 Market Street
Hoylake
MSY
CH47 5AA

Dear Duncan Phillips

Thank you for contacting us regarding UK Power Networks equipment at the above site. I have enclosed a copy of our records which show the electrical lines and/or electrical plant. I hope you find the information useful.

I have also enclosed a fact sheet which contains important information regarding the use of our plans and working around our equipment. Safety around our equipment is our number one priority so please ensure you have completed all workplace risk assessments before you begin any works.

Should your excavation affect our Extra High Voltage equipment (6.6 KV, 22 KV, 33 KV or 132 KV), please contact us to obtain a copy of the primary route drawings and associated cross sections.

If you have any further queries do not hesitate to contact us.

Plan Provision
0800 056 5866



This information is made available to you on the terms set out below. If you do not accept the terms of use set out in this fact sheet please do not use the plans and return them to UK Power Networks.

1. UK Power Networks does not warrant that the information provided to you is correct. You rely upon it at your own risk.
2. UK Power Networks does not exclude or limit its liability if it causes the death of any person or causes personal injury to a person where such death or personal injury is caused by its negligence.
3. Subject to paragraph 2 UK Power Networks has no liability to you in contract, in tort (including negligence), for breach of statutory duty or otherwise how for any loss, damage, costs, claims, demands, or expenses that you or any third party may suffer or incur as a result of using the information provided whether for physical damage to property or for any economic loss (including without limitation loss of profit, loss of opportunity, loss of savings, loss of goodwill, loss of business, loss of use) or any special or consequential loss or damage whatsoever.
4. The information about UK Power Networks electrical plant and/or electric lines provided to you belongs to and remains the property of UK Power Networks. You must not alter it in any respect.
5. The information provided to you about the electrical plant and/or electric lines depicted on the plans may NOT be a complete record of such apparatus belonging to UK Power Networks. The information provided relates to electric lines and/or electrical plant belonging to UK Power Networks that it believes to be present but the plans are not definitive: other electric lines and/or electrical plant may be present and that may or may not belong to UK Power Networks.
6. Other apparatus not belonging to UK Power Networks is not shown on the plan. It is your responsibility to make your own enquiries elsewhere to discover whether apparatus belonging to others is present. It would be prudent to assume that other apparatus is present.
7. You are responsible for ensuring that the information made available to you is passed to those acting on your behalf and that all such persons are made aware of the contents of this letter.
8. Because the information provided to you may not be accurate, you are recommended to ascertain the presence of UK Power Networks electric lines and/or electrical plant by the digging of trial holes. Trial holes should be dug by hand only.

Excavations must be carried out in line with the Health and Safety Executive guidance document HSG 47. We will not undertake this work. A copy of HSG 47 can be obtained from the Health and Safety Executives website.

All electric lines discovered must be considered LIVE and DANGEROUS at all times and must not be cut, resited, suspended, bent or interfered with unless specially authorised by UK Power Networks.

The electric line and electrical plant belonging to UK Power Networks remains so even when made dead and abandoned and any such electric line and/or electrical plant exposed shall be reported to UK Power Networks.

Where your works are likely to affect our electric lines and/or electrical plant an estimate of the price of any protective /diversionary works can be prepared by UK Power Networks Branch at Metropolitan House, Darkes Lane, Potters Bar, Herts. , EN6 1AG, telephone no. 0845 2340040




- 9 Any work near to any overhead electricity lines must be carried out by you in accordance with the Health and Safety Executive guidance document GS6 and the Electricity at Work Regulations.

The GS6 Recommendations may be purchased from HSE Books or downloaded from the Energy Networks Association's website.

If given a reasonable period of prior notice UK Power Networks will attend on site without charge to advise how and where "goal posts" should be erected. If you wish to use this service, in the first instance please telephone: 0845 6014516 between 08:30 and 17:00 Monday to Friday.

10. You are responsible for the security of the information provided to you. It must not be given, sold or made available upon payment of a fee to a third party.
11. If in carrying out work on land in, on, under or over which is installed an electric line and/or electrical plant that belongs to UK Power Networks you and/or anyone working on your behalf damages (however slightly) that apparatus you must inform immediately UK Power Networks by our emergency 24 hour three digit telephone number **105** providing;
- your name, address and telephone number;
 - the date, time and place at which such damage was caused;
 - a description of the electric line and/or electrical plant to which damage was caused;
 - the name of the person whom it appears to you is responsible for that damage;
 - the nature of the damage.
12. The expression "UK Power Networks" includes UK Power Networks (EPN) plc, UK Power Networks (LPN) plc, UK Power Networks (SEPN) plc, UK Power Networks and any of their successors and predecessors in title.



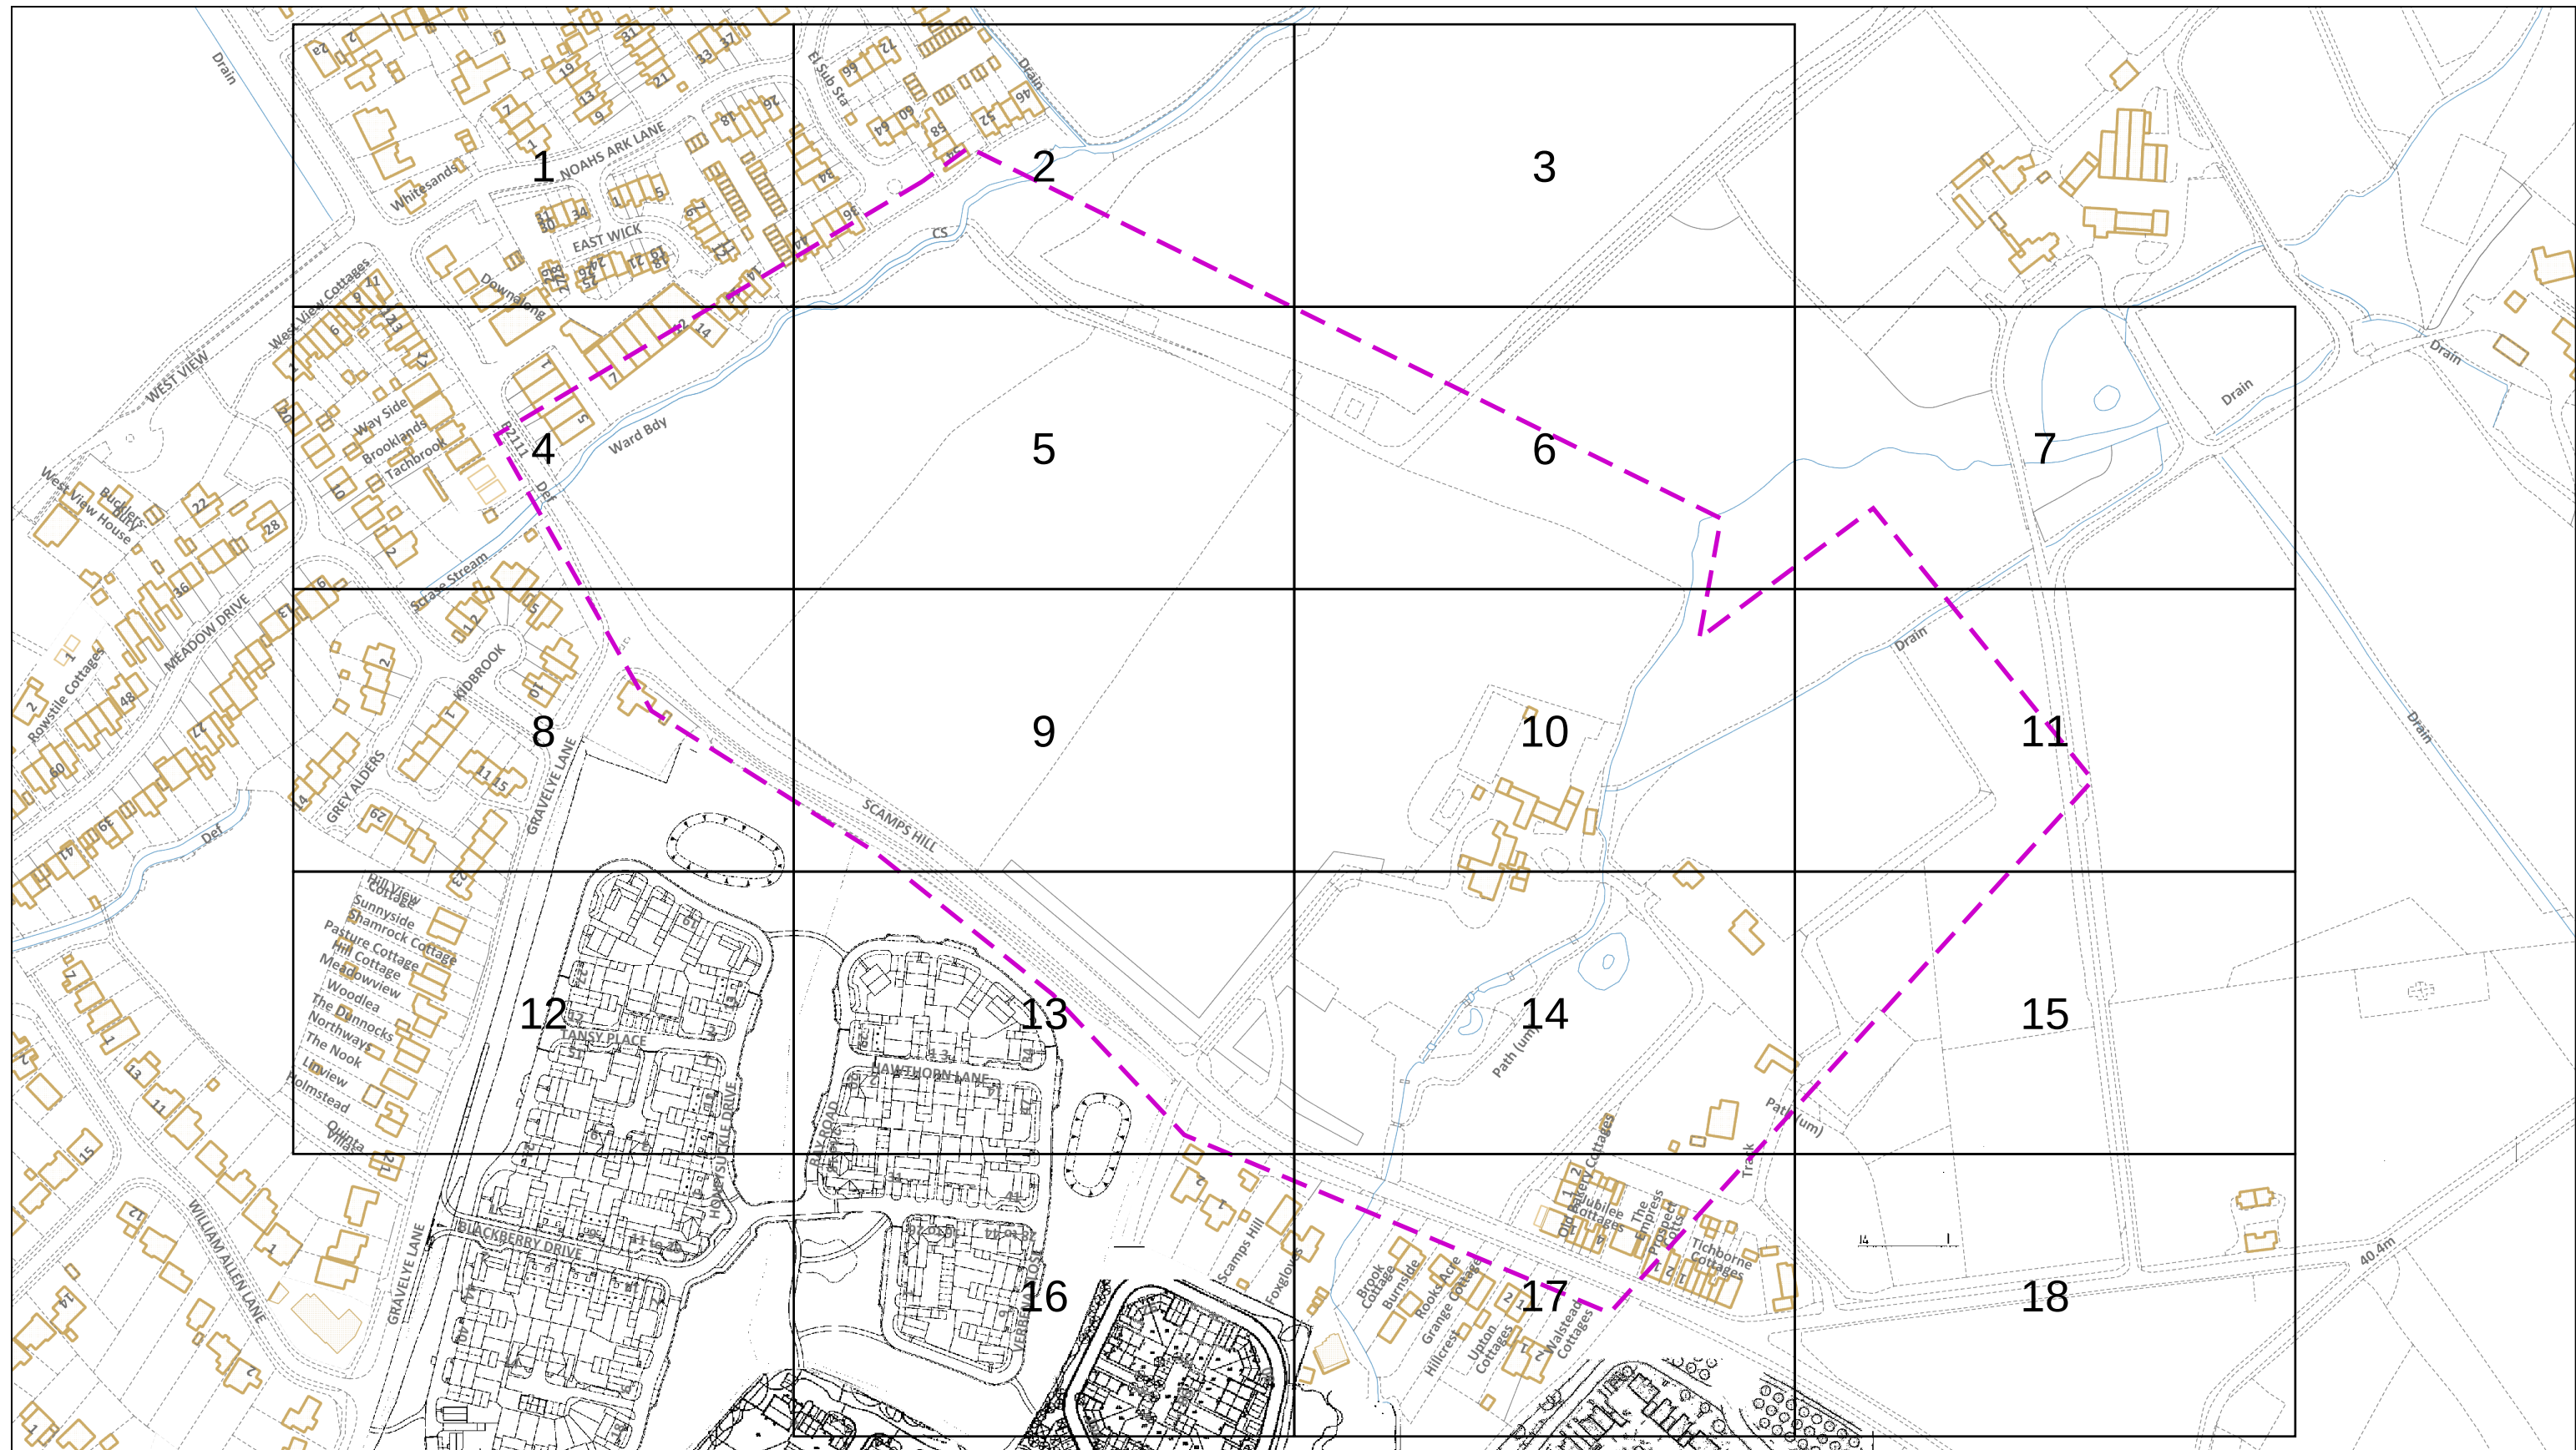

Dig Sites Area:  Line: 

The quality and accuracy of any print will depend on your printer, your computer and its print settings. Measurements scaled from this plan may not match measurements between the same points on the ground.

This plan must be used with
the attached 'Symbols'
document.

Date Requested: 19/05/2025
Job Reference: 37324868
Site Location: 534993 124590
Requested by:
Mr Duncan Phillips
Your Scheme/Reference: Gladman

Scale: 1:2562 (When plotted at A3)

1. The position of the apparatus shown on this drawing is believed to be correct but the original landmarks may have been altered since the apparatus was installed.
2. The exact position of the apparatus should be verified - use approved cable avoidance tools prior to excavation using suitable hand tools.
3. It is essential that trial holes are carefully made avoiding the use of mechanical tools or picks until the exact location of all the cables have been determined.
4. It must be assumed that there is a service cable into each property, lamp column and street sign, etc.
5. All cables must be treated as being live unless proved otherwise by UK Power Networks.
6. The information proved must be given to all people working near UK Power Networks plant and equipment. Do not use plans more than 3 months after the issue date for excavation purposes.
7. Please be aware that electric cables/lines belonging to other owners of licensed electricity distribution systems may be present and it is your responsibility to identify their location.


1. UK Power Networks does not warrant that the information provided to you is correct. You rely upon it at your own risk.
2. UK Power Networks does not exclude or limit its liability if it causes the death of any persons or causes personal injury to a person.
3. Subject to paragraph 2 UK Power Networks has no liability to you in contract, in tort (including negligence), for breach of statutory duty or otherwise for any loss, damage, cost, claims, demands, or expenses that you or any third party may suffer or incur as a result of using the information provided whether for physical damage to property or for any economic loss (including without limitation loss of profit, loss of opportunity, loss of savings, loss of goodwill, loss of business, loss of use) or any special or consequential loss or damage whatsoever.
4. This plan has been provided to you on the basis of the terms of use set out in the covering letter that accompanies this plan. If you do not accept and/or do not understand the terms of use set out in the covering letter you must not use the plan and must return it to the sender of the letter.
5. You are responsible for the security of the information provided to you. It must not be given, sold or made available upon payment of a fee to a third party.



ALWAYS LOOK UP
BEFORE
YOU START WORK
Refer to HSE
Guidance note GS6

IF IN DOUBT - ASK!
PHONE 0800 056 5866
EMERGENCY - If you
damage a cable or line
Phone 0800 783 8838
(24hrs) URGENTLY

Maps produced at 1:2500 scale are Geo-Schematics which show LV mains cables and overhead lines (in some cases all voltages). Prior to carrying out excavations you must refer to the 1:500 records to determine the location of all known underground plant and equipment.

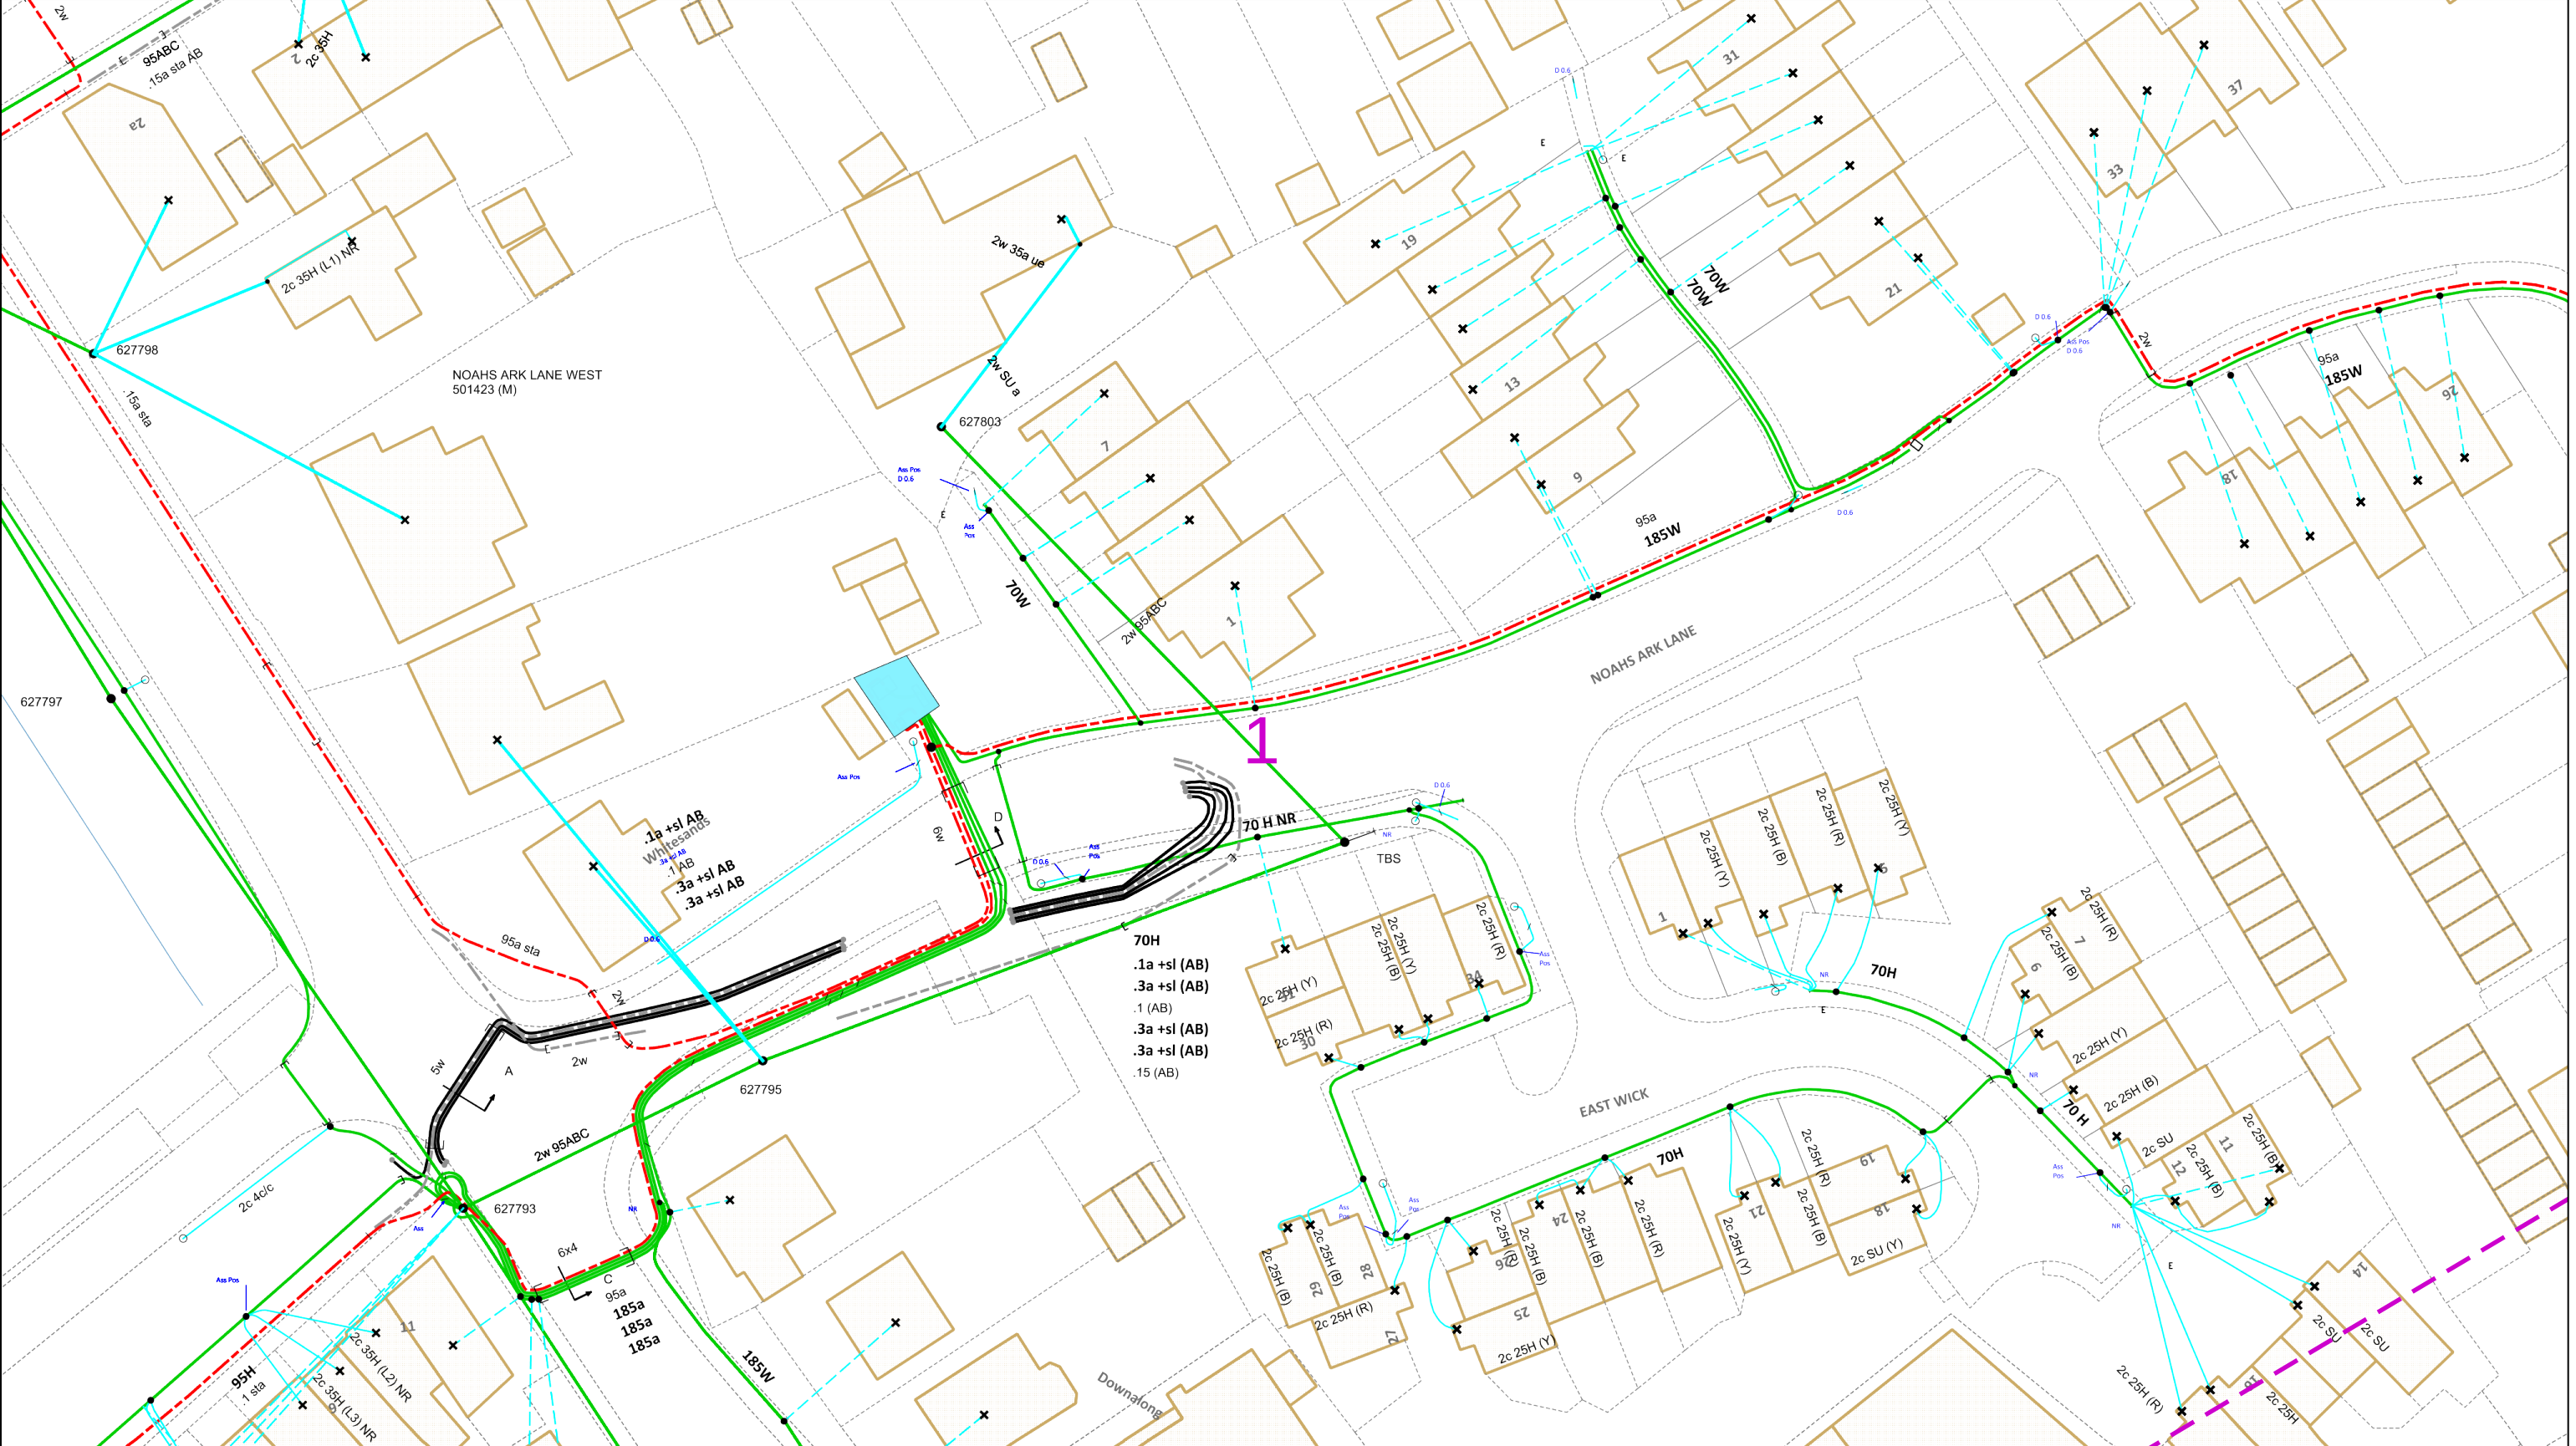

0 25 50

metres

Dig Sites Area: Line:

The quality and accuracy of any print will depend on your printer, your computer and its print settings. Measurements scaled from this plan may not match measurements between the same points on the ground.

This plan must be used with the attached 'Symbols' document.

Date Requested: 19/05/2025
Job Reference: 37324868
Site Location: 534993 124590
Requested by:
Mr Duncan Phillips
Your Scheme/Reference: Gladman

Scale: 1:500 (When plotted at A3)

1. The position of the apparatus shown on this drawing is believed to be correct but the original landmarks may have been altered since the apparatus was installed.

2. The exact position of the apparatus should be verified - use approved cable avoidance tools prior to excavation using suitable hand tools.

3. It is essential that trial holes are carefully made avoiding the use of mechanical tools or picks until the exact location of all the cables have been determined.

4. It must be assumed that there is a service cable into each property, lamp column and street sign, etc.

5. All cables must be treated as being live unless proved otherwise by UK Power Networks.

6. The information proved must be given to all people working near UK Power Networks plant and equipment. Do not use plans more than 3 months after the issue date for excavation purposes.

7. Please be aware that electric cables/lines belonging to other owners of licensed electricity distribution systems may be present and it is your responsibility to identify their location.

1. UK Power Networks does not warrant that the information provided to you is correct. You rely upon it at your own risk.

2. UK Power Networks does not exclude or limit its liability if it causes the death of any persons or causes personal injury to a person.

3. Subject to paragraph 2 UK Power Networks has no liability to you in contract, in tort (including negligence), for breach of statutory duty or otherwise for any loss, damage, cost, claims, demands, or expenses that you or any third party may suffer or incur as a result of using the information provided whether for physical damage to property or for any economic loss (including without limitation loss of profit, loss of opportunity, loss of savings, loss of goodwill, loss of business, loss of use) or any special or consequential loss or damage whatsoever.

4. This plan has been provided to you on the basis of the terms of use set out in the covering letter that accompanies this plan. If you do not accept and/or do not understand the terms of use set out in the covering letter you must not use the plan and must return it to the sender of the letter.

5. You are responsible for the security of the information provided to you. It must not be given, sold or made available upon payment of a fee to a third party.


IF IN DOUBT - ASK!
PHONE 0800 056 5866
EMERGENCY - If you damage a cable or line
Phone 0800 783 8838 (24hrs) URGENTLY

ALWAYS LOOK UP BEFORE YOU START WORK
Refer to HSE Guidance note GS6


Maps produced at 1:2500 scale are Geo-Schematics which show LV mains cables and overhead lines (in some cases all voltages). Prior to carrying out excavations you must refer to the 1:500 records to determine the location of all known underground plant and equipment.

Reproduced by permission of Ordnance Survey on behalf of HMSO. © Crown copyright and database rights 2023. All rights reserved. Ordnance Survey Licence numbers 100019626, 100019826 and 100019450. Data has been added to the Ordnance Survey base map; all proprietary rights in such additional data are and shall remain the exclusive property of © London Power Networks plc or Eastern Power Networks plc or South Eastern Power Networks plc each being a distribution licensee under section 6(1)(c) of the Electricity Act 1989 for the relevant distribution services area as that term is defined in such licensee's distribution licence. All rights in such data reserved.

Plans generated by DigSAFE Pro™ software provided by LinesearchbeforeUdig.

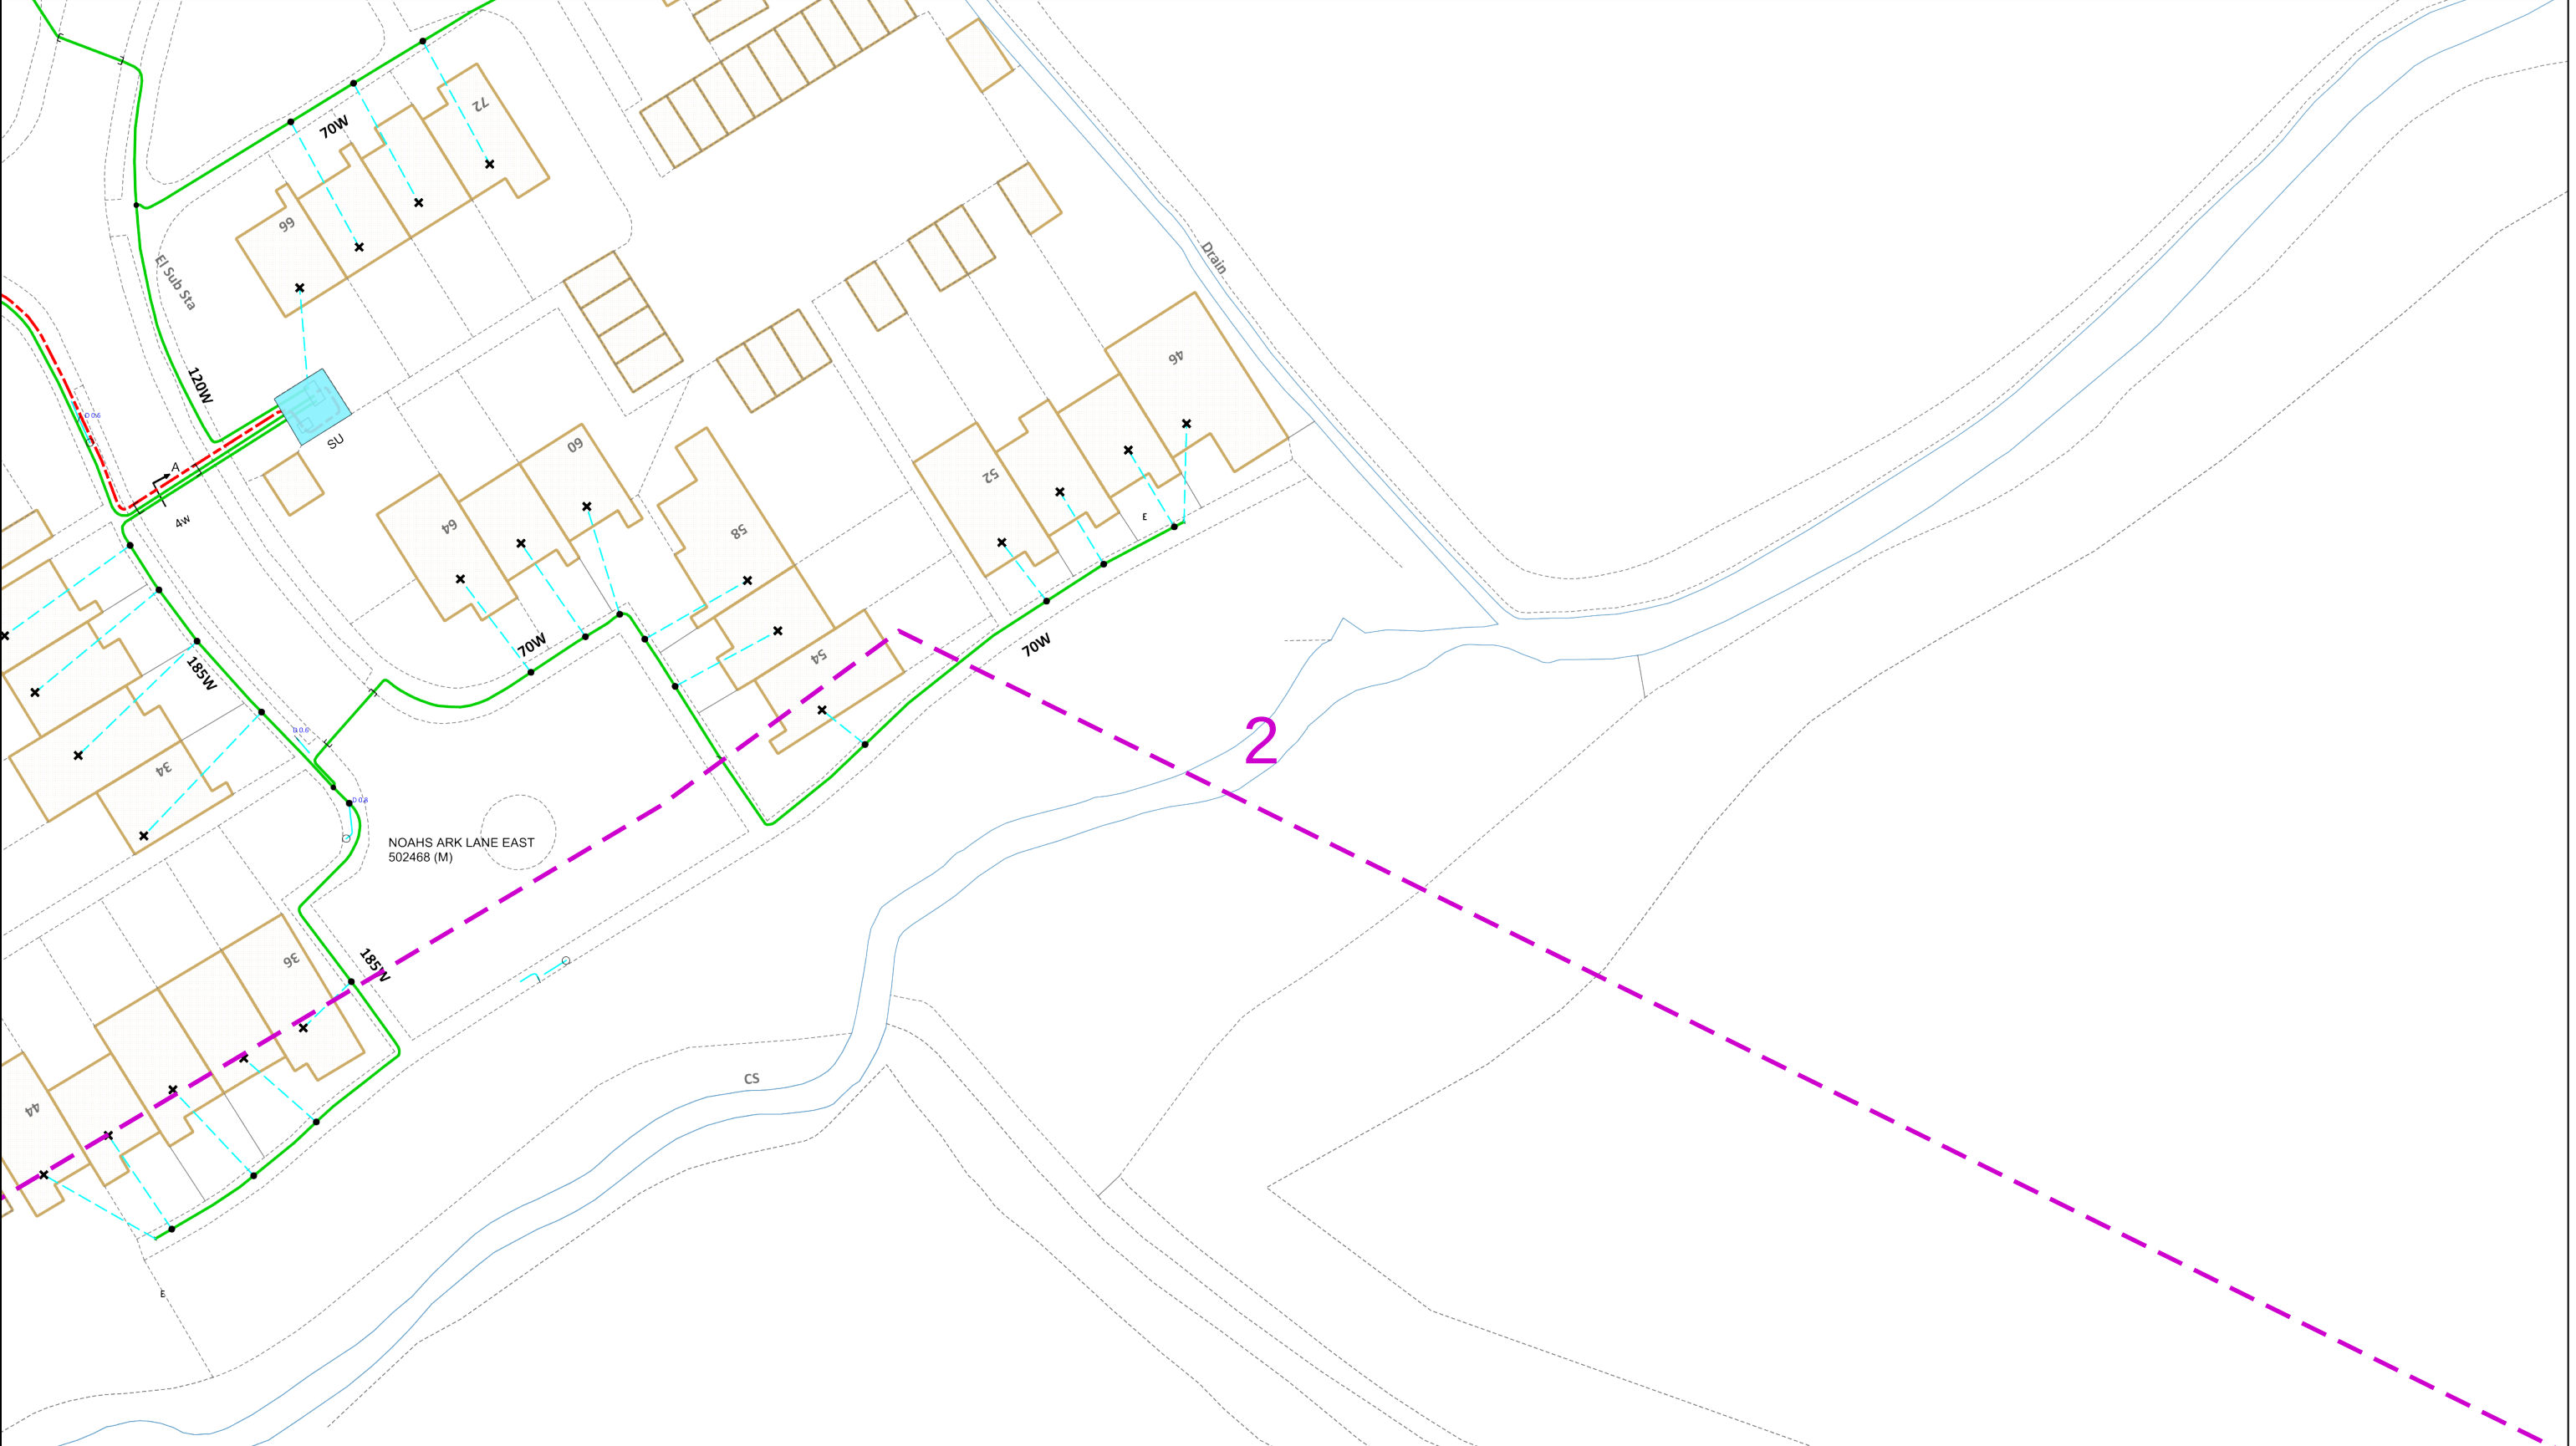

0 25 50 metres		Dig Sites Area:  Line: 		The quality and accuracy of any print will depend on your printer, your computer and its print settings. Measurements scaled from this plan may not match measurements between the same points on the ground.	
This plan must be used with the attached 'Symbols' document.		1. The position of the apparatus shown on this drawing is believed to be correct but the original landmarks may have been altered since the apparatus was installed. 2. The exact position of the apparatus should be verified - use approved cable avoidance tools prior to excavation using suitable hand tools. 3. It is essential that trial holes are carefully made avoiding the use of mechanical tools or picks until the exact location of all the cables have been determined. 4. It must be assumed that there is a service cable into each property, lamp column and street sign, etc. 5. All cables must be treated as being live unless proved otherwise by UK Power Networks. 6. The information proved must be given to all people working near UK Power Networks plant and equipment. Do not use plans more than 3 months after the issue date for excavation purposes. 7. Please be aware that electric cables/lines belonging to other owners of licensed electricity distribution systems may be present and it is your responsibility to identify their location.		1. UK Power Networks does not warrant that the information provided to you is correct. You rely upon it at your own risk. 2. UK Power Networks does not exclude or limit its liability if it causes the death of any persons or causes personal injury to a person. 3. Subject to paragraph 2 UK Power Networks has no liability to you in contract, in tort (including negligence), for breach of statutory duty or otherwise for any loss, damage, cost, claims, demands, or expenses that you or any third party may suffer or incur as a result of using the information provided whether for physical damage to property or for any economic loss (including without limitation loss of profit, loss of opportunity, loss of savings, loss of goodwill, loss of business, loss of use) or any special or consequential loss or damage whatsoever. 4. This plan has been provided to you on the basis of the terms of use set out in the covering letter that accompanies this plan. If you do not accept and/or do not understand the terms of use set out in the covering letter you must not use the plan and must return it to the sender of the letter. 5. You are responsible for the security of the information provided to you. It must not be given, sold or made available upon payment of a fee to a third party.	
Date Requested: 19/05/2025 Job Reference: 37324868 Site Location: 534993 124590 Requested by: Mr Duncan Phillips Your Scheme/Reference: Gladman Scale: 1:500 (When plotted at A3)		IF IN DOUBT - ASK! PHONE 0800 056 5866 EMERGENCY - If you damage a cable or line Phone 0800 783 8838 (24hrs) URGENTLY		ALWAYS LOOK UP BEFORE YOU START WORK Refer to HSE Guidance note GS6	
Maps produced at 1:2500 scale are Geo-Schematics which show LV mains cables and overhead lines (in some cases all voltages). Prior to carrying out excavations you must refer to the 1:500 records to determine the location of all known underground plant and equipment.					
Reproduced by permission of Ordnance Survey on behalf of HMSO. © Crown copyright and database rights 2023. All rights reserved. Ordnance Survey Licence numbers 100019626, 100019826 and 100019450. Data has been added to the Ordnance Survey base map; all proprietary rights in such additional data are and shall remain the exclusive property of © London Power Networks plc or Eastern Power Networks plc or South Eastern Power Networks plc each being a distribution licensee under section 6(1)(c) of the Electricity Act 1989 for the relevant distribution services area as that term is defined in such licensee's distribution licence. All rights in such data reserved. Plans generated by DigSAFE Pro™ software provided by LinesearchbeforeUdig.					

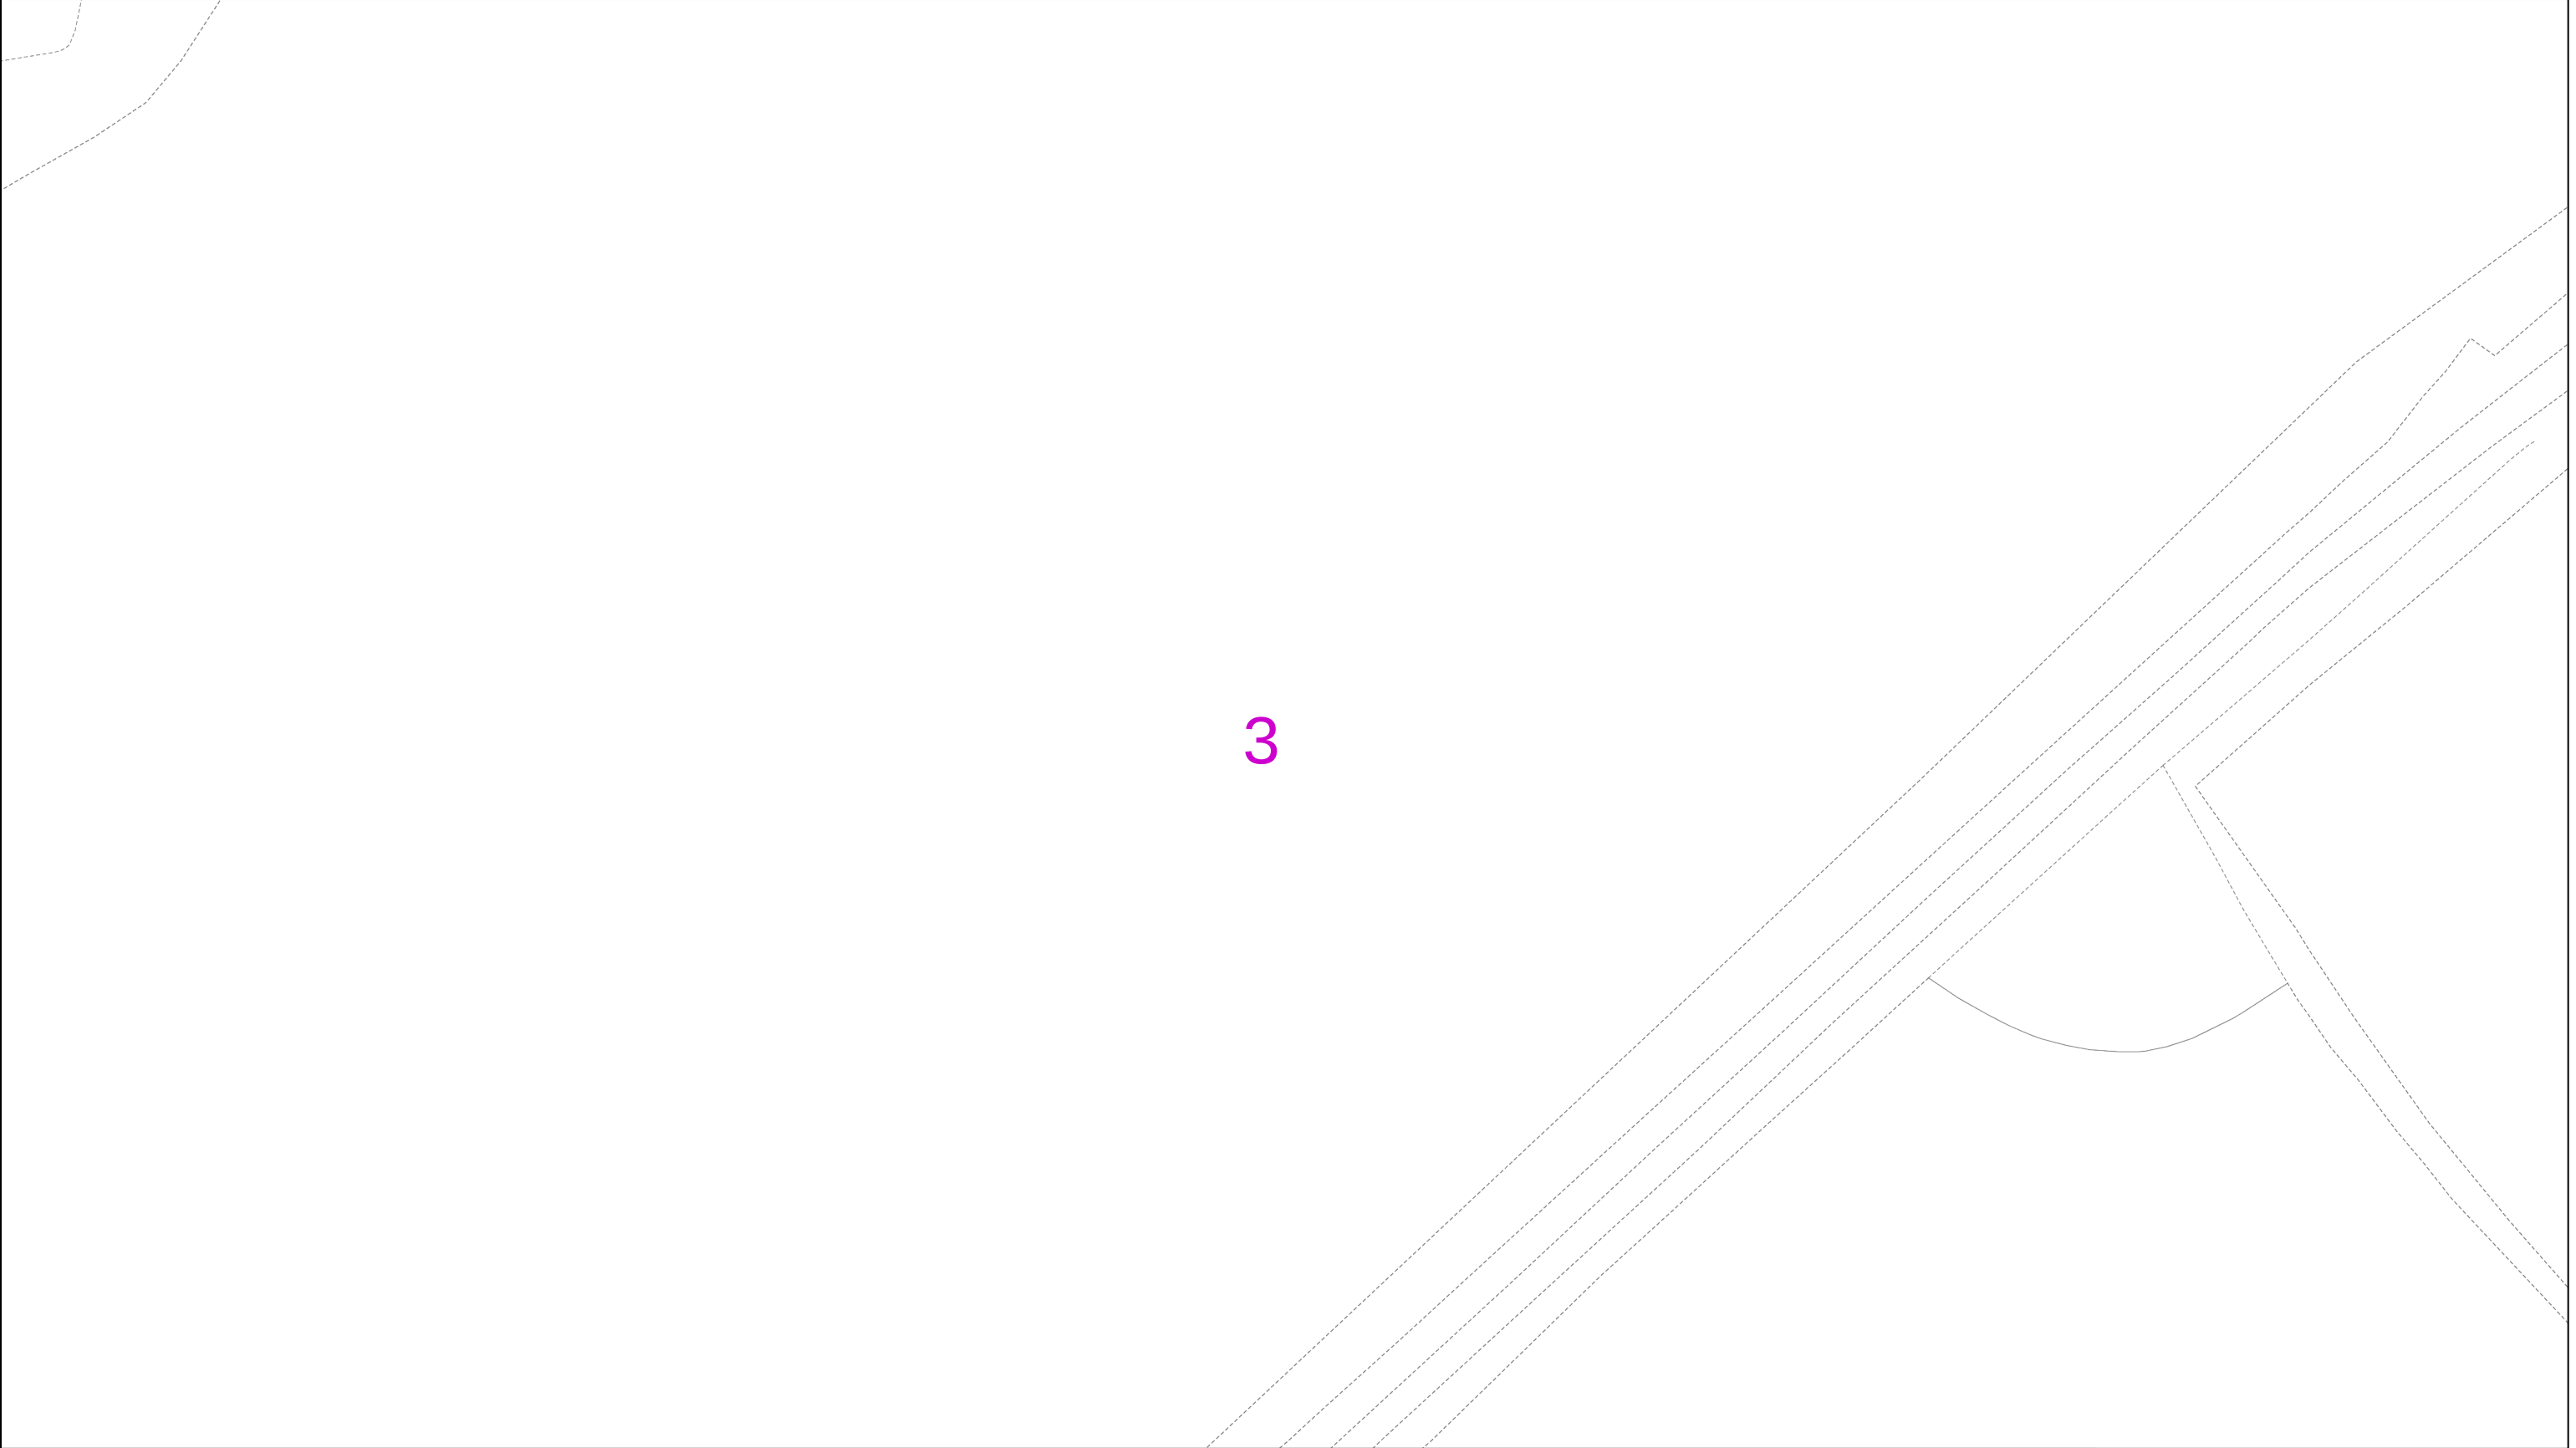

3

0

25

50

metres

Dig Sites

Area:

Line:

The quality and accuracy of any print will depend on your printer, your computer and its print settings. Measurements scaled from this plan may not match measurements between the same points on the ground.

This plan must be used with the attached ‘Symbols’ document.

Date Requested: 19/05/2025

Job Reference: 37324868

Site Location: 534993 124590

Requested by: Mr Duncan Phillips

Your Scheme/Reference: Gladman

Scale: 1:500 (When plotted at A3)

1. The position of the apparatus shown on this drawing is believed to be correct but the original landmarks may have been altered since the apparatus was installed.

2. The exact position of the apparatus should be verified - use approved cable avoidance tools prior to excavation using suitable hand tools.

3. It is essential that trial holes are carefully made avoiding the use of mechanical tools or picks until the exact location of all the cables have been determined.

4. It must be assumed that there is a service cable into each property, lamp column and street sign, etc.

5. All cables must be treated as being live unless proved otherwise by UK Power Networks.

6. The information proved must be given to all people working near UK Power Networks plant and equipment. Do not use plans more than 3 months after the issue date for excavation purposes.

7. Please be aware that electric cables/lines belonging to other owners of licensed electricity distribution systems may be present and it is your responsibility to identify their location.

1. UK Power Networks does not warrant that the information provided to you is correct. You rely upon it at your own risk.

2. UK Power Networks does not exclude or limit its liability if it causes the death of any persons or causes personal injury to a person.

3. Subject to paragraph 2 UK Power Networks has no liability to you in contract, in tort (including negligence), for breach of statutory duty or otherwise for any loss, damage, cost, claims, demands, or expenses that you or any third party may suffer or incur as a result of using the information provided whether for physical damage to property or for any economic loss (including without limitation loss of profit, loss of opportunity, loss of savings, loss of goodwill, loss of business, loss of use) or any special or consequential loss or damage whatsoever.

4. This plan has been provided to you on the basis of the terms of use set out in the covering letter that accompanies this plan. If you do not accept and/or do not understand the terms of use set out in the covering letter you must not use the plan and must return it to the sender of the letter.

5. You are responsible for the security of the information provided to you. It must not be given, sold or made available upon payment of a fee to a third party.

N

E

S

W

IF IN DOUBT - ASK!
PHONE 0800 056 5866
EMERGENCY - If you damage a cable or line
Phone 0800 783 8838
(24hrs) URGENTLY

LOOK OUT

LOOK UP


ALWAYS LOOK UP BEFORE YOU START WORK

Refer to HSE Guidance note GS6

Maps produced at 1:2500 scale are Geo-Schematics which show LV mains cables and overhead lines (in some cases all voltages). Prior to carrying out excavations you must refer to the 1:500 records to determine the location of all known underground plant and equipment.

Reproduced by permission of Ordnance Survey on behalf of HMSO. © Crown copyright and database rights 2023. All rights reserved. Ordnance Survey Licence numbers 100019626, 100019826 and 100019450. Data has been added to the Ordnance Survey base map; all proprietary rights in such additional data are and shall remain the exclusive property of © London Power Networks plc or Eastern Power Networks plc or South Eastern Power Networks plc each being a distribution licensee under section 6(1)(c) of the Electricity Act 1989 for the relevant distribution services area as that term is defined in such licensee’s distribution licence. All rights in such data reserved.

Plans generated by DigSAFE Pro™ software provided by LinesearchbeforeUdig.

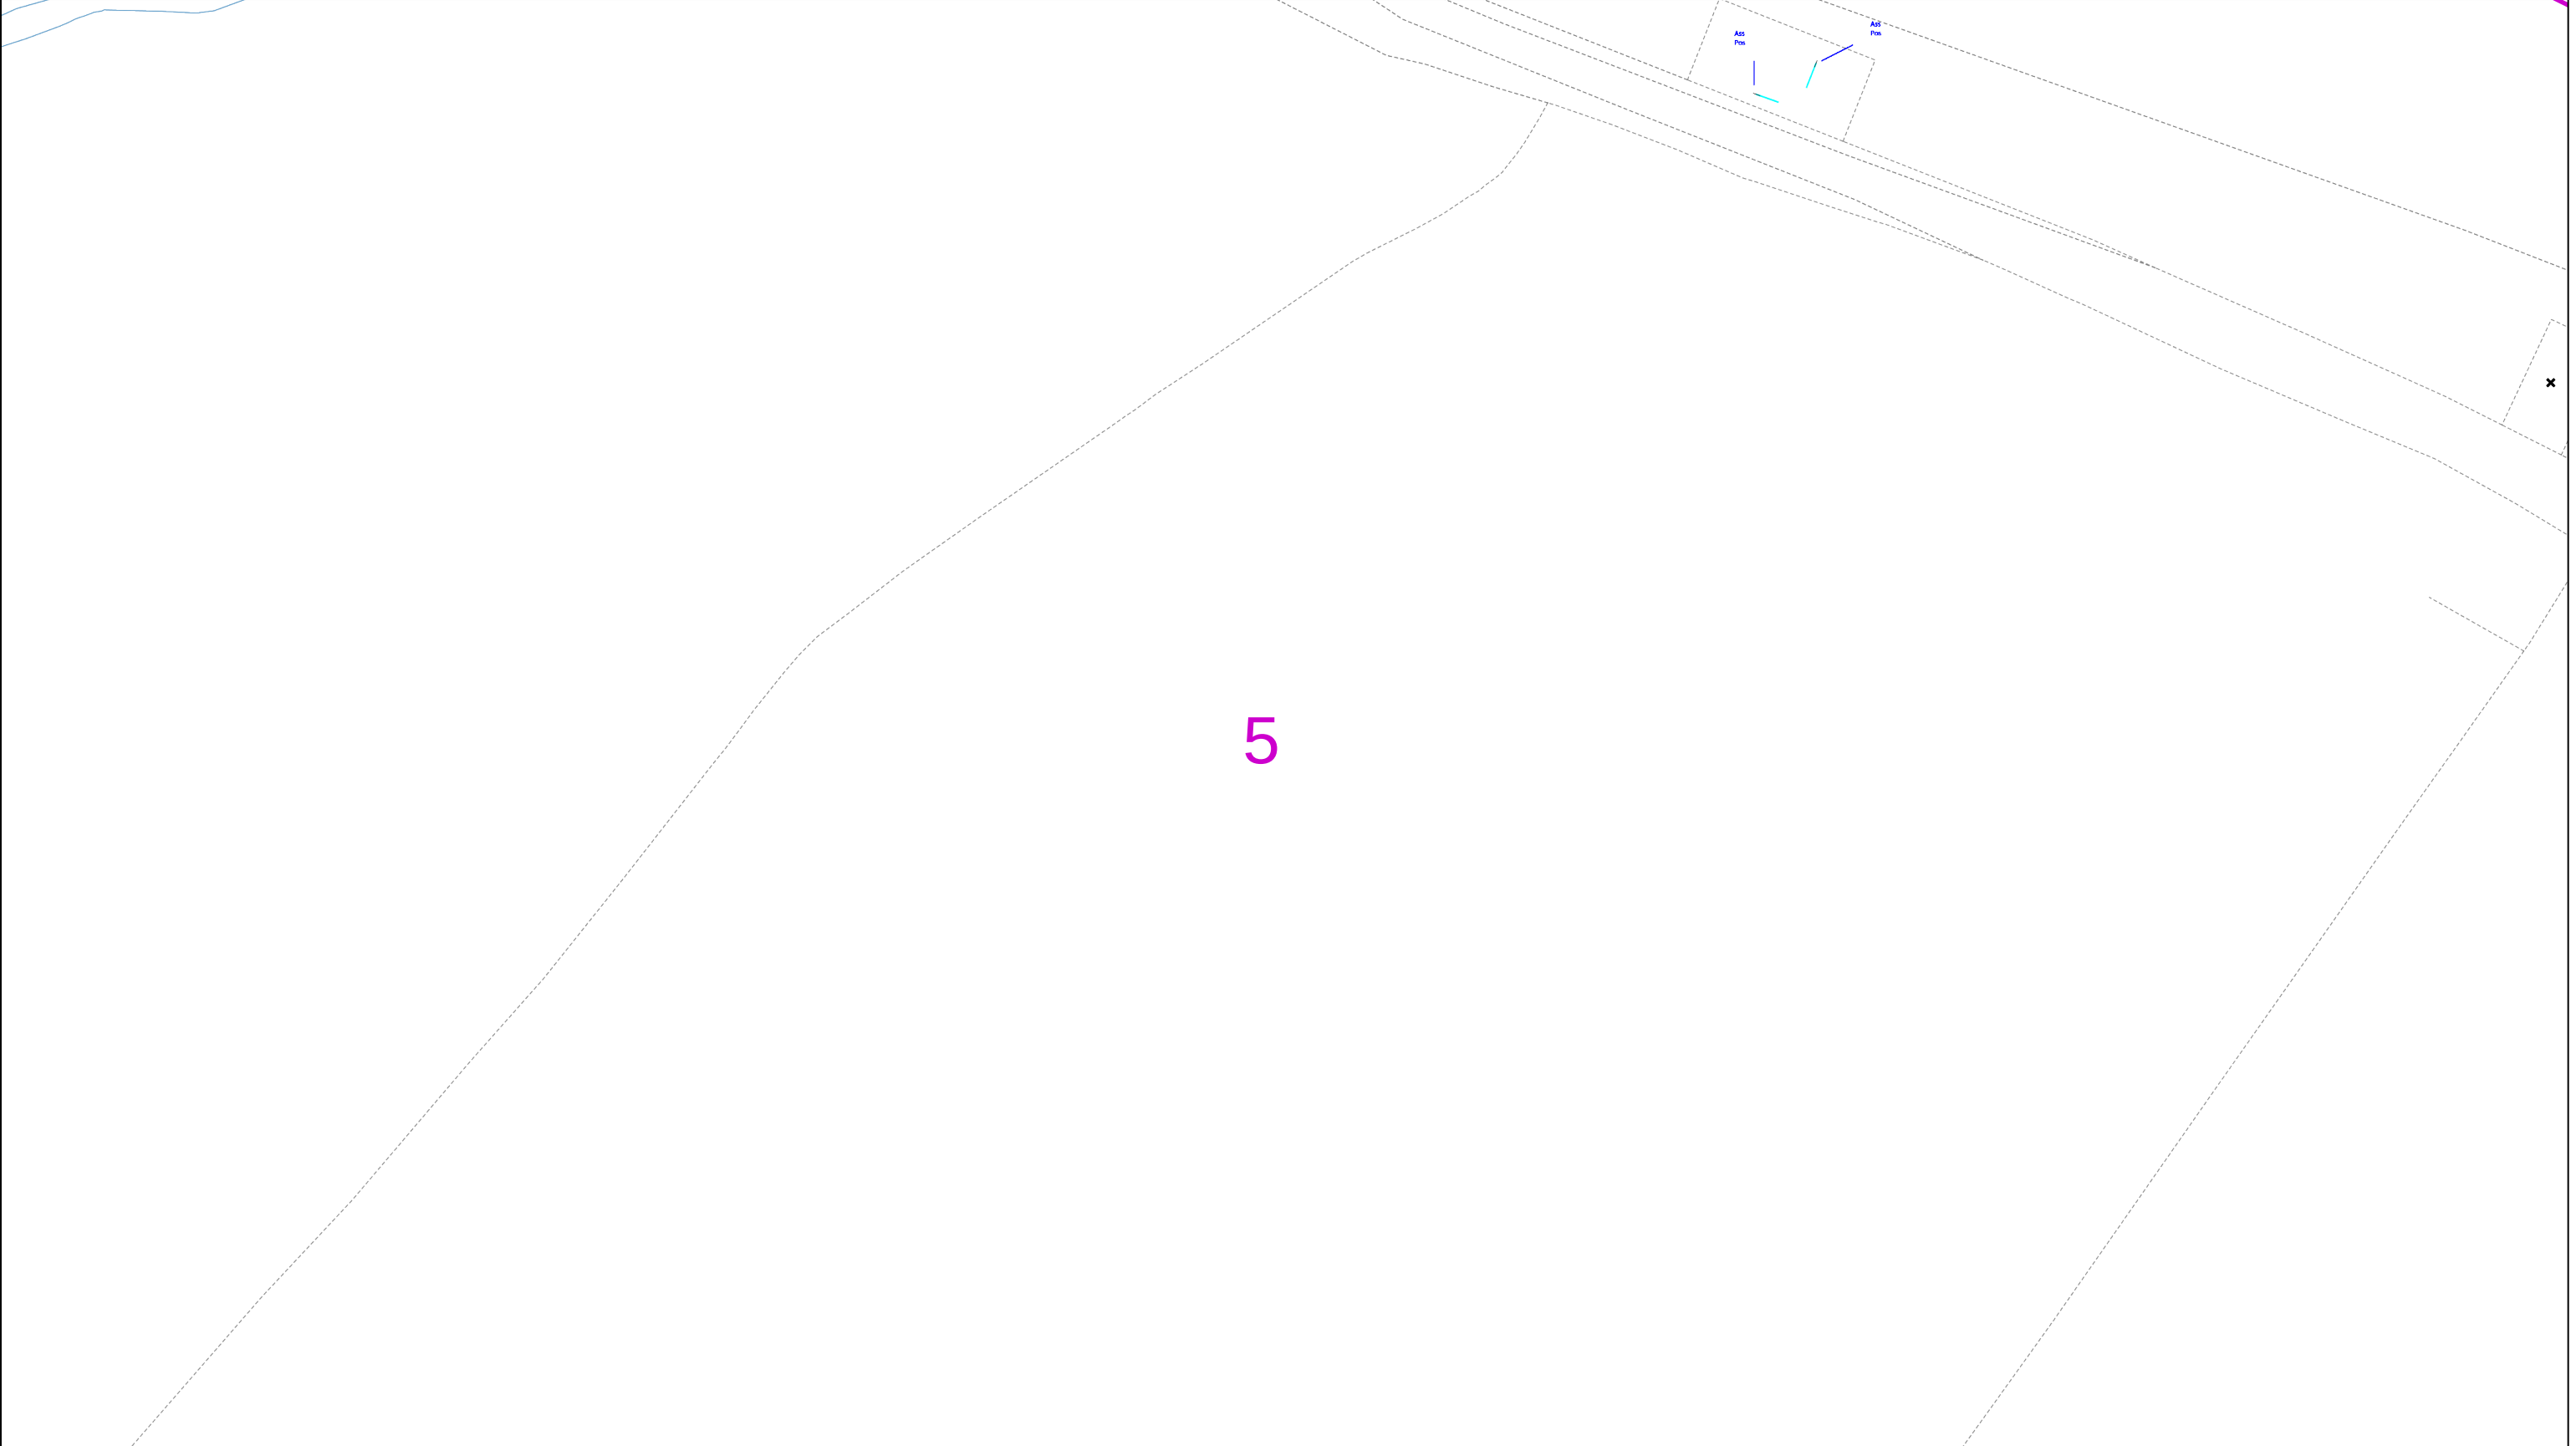

02550metres

Dig SitesArea: Line:

The quality and accuracy of any print will depend on your printer, your computer and its print settings. Measurements scaled from this plan may not match measurements between the same points on the ground.

This plan must be used with the attached ‘Symbols’ document.

Date Requested: 19/05/2025
Job Reference: 37324868
Site Location: 534993 124590
Requested by:
Mr Duncan Phillips
Your Scheme/Reference: Gladman

Scale: 1:500 (When plotted at A3)

1. The position of the apparatus shown on this drawing is believed to be correct but the original landmarks may have been altered since the apparatus was installed.

2. The exact position of the apparatus should be verified - use approved cable avoidance tools prior to excavation using suitable hand tools.

3. It is essential that trial holes are carefully made avoiding the use of mechanical tools or picks until the exact location of all the cables have been determined.

4. It must be assumed that there is a service cable into each property, lamp column and street sign, etc.

5. All cables must be treated as being live unless proved otherwise by UK Power Networks.

6. The information proved must be given to all people working near UK Power Networks plant and equipment. Do not use plans more than 3 months after the issue date for excavation purposes.

7. Please be aware that electric cables/lines belonging to other owners of licensed electricity distribution systems may be present and it is your responsibility to identify their location.

1. UK Power Networks does not warrant that the information provided to you is correct. You rely upon it at your own risk.

2. UK Power Networks does not exclude or limit its liability if it causes the death of any persons or causes personal injury to a person.

3. Subject to paragraph 2 UK Power Networks has no liability to you in contract, in tort (including negligence), for breach of statutory duty or otherwise for any loss, damage, cost, claims, demands, or expenses that you or any third party may suffer or incur as a result of using the information provided whether for physical damage to property or for any economic loss (including without limitation loss of profit, loss of opportunity, loss of savings, loss of goodwill, loss of business, loss of use) or any special or consequential loss or damage whatsoever.

4. This plan has been provided to you on the basis of the terms of use set out in the covering letter that accompanies this plan. If you do not accept and/or do not understand the terms of use set out in the covering letter you must not use the plan and must return it to the sender of the letter.

5. You are responsible for the security of the information provided to you. It must not be given, sold or made available upon payment of a fee to a third party.


IF IN DOUBT - ASK!
PHONE 0800 056 5866
EMERGENCY - If you damage a cable or line
Phone 0800 783 8838
(24hrs) URGENTLY

ALWAYS LOOK UP BEFORE YOU START WORK
Refer to HSE Guidance note GS6

Maps produced at 1:2500 scale are Geo-Schematics which show LV mains cables and overhead lines (in some cases all voltages). Prior to carrying out excavations you must refer to the 1:500 records to determine the location of all known underground plant and equipment.

Reproduced by permission of Ordnance Survey on behalf of HMSO. © Crown copyright and database rights 2023. All rights reserved. Ordnance Survey Licence numbers 100019626, 100019826 and 100019450. Data has been added to the Ordnance Survey base map; all proprietary rights in such additional data are and shall remain the exclusive property of © London Power Networks plc or Eastern Power Networks plc or South Eastern Power Networks plc each being a distribution licensee under section 6(1)(c) of the Electricity Act 1989 for the relevant distribution services area as that term is defined in such licensee’s distribution licence. All rights in such data reserved.

Plans generated by DigSAFE Pro™ software provided by LinesearchbeforeUdig.

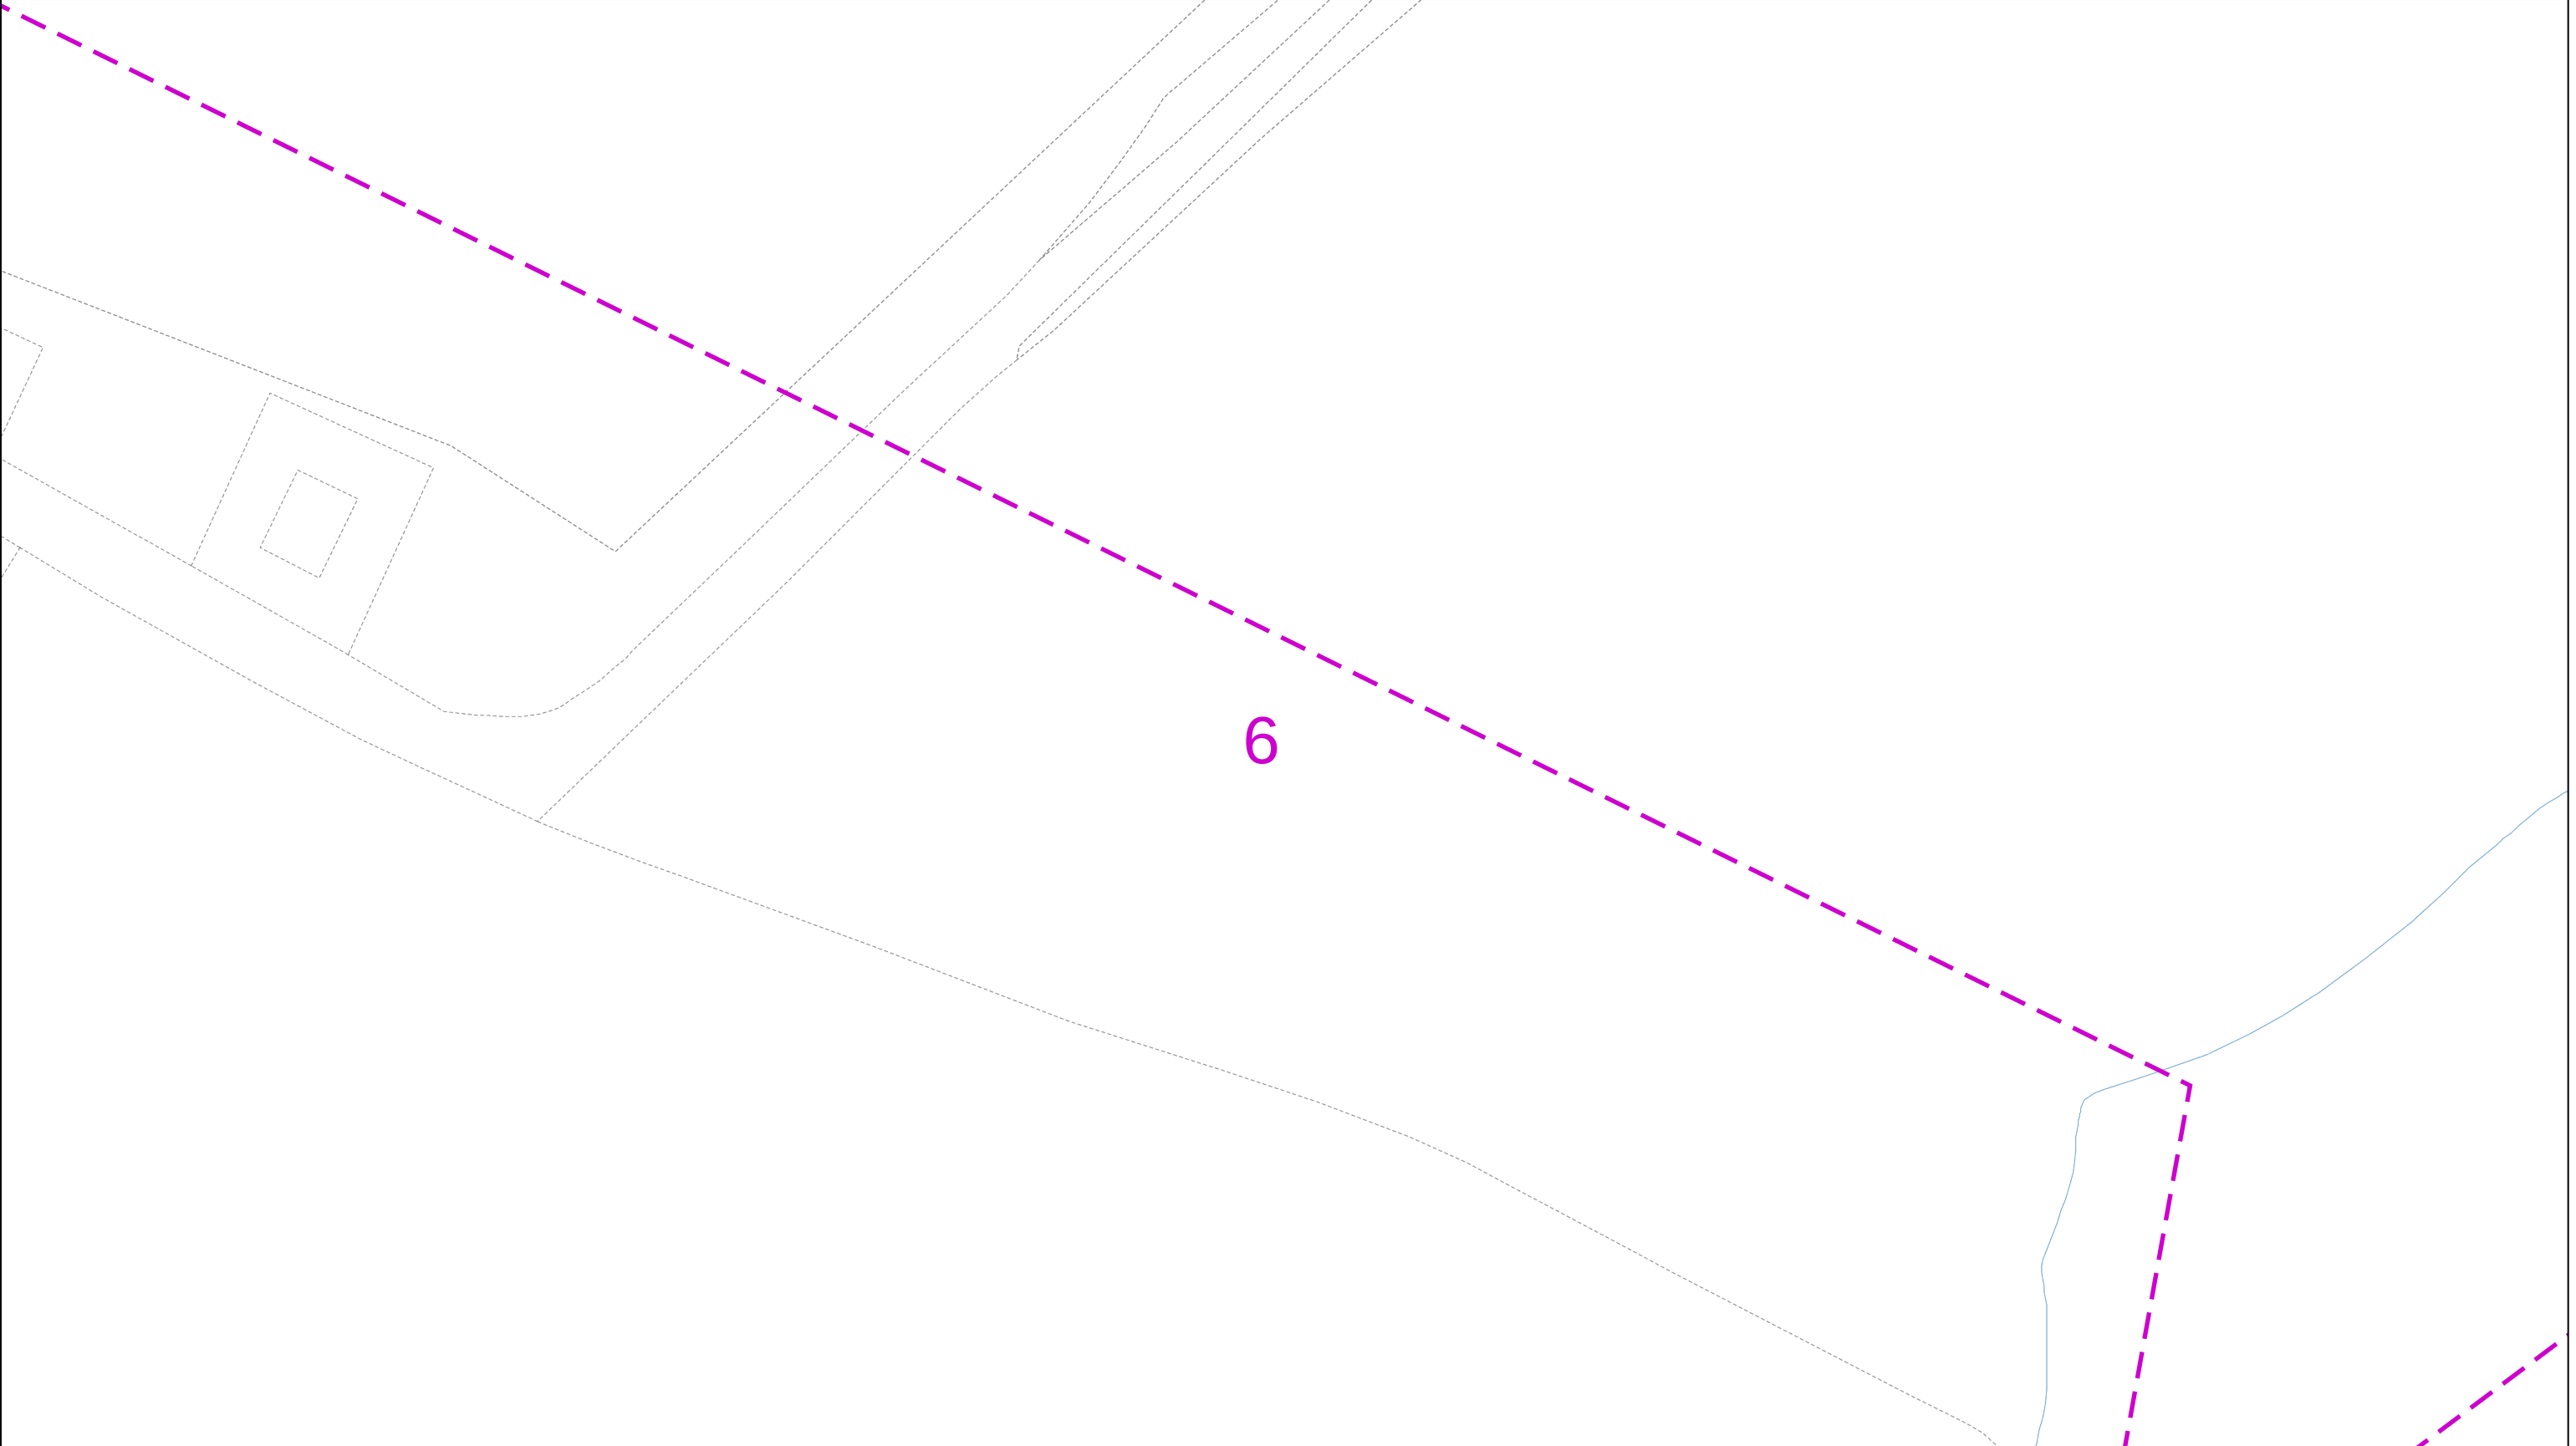

02550metres

Dig SitesArea: [dashed magenta box] Line: [dashed magenta line]

The quality and accuracy of any print will depend on your printer, your computer and its print settings. Measurements scaled from this plan may not match measurements between the same points on the ground.

This plan must be used with the attached ‘Symbols’ document.

Date Requested: 19/05/2025
Job Reference: 37324868
Site Location: 534993 124590
Requested by: Mr Duncan Phillips
Your Scheme/Reference: Gladman

Scale: 1:500 (When plotted at A3)

1. The position of the apparatus shown on this drawing is believed to be correct but the original landmarks may have been altered since the apparatus was installed.

2. The exact position of the apparatus should be verified - use approved cable avoidance tools prior to excavation using suitable hand tools.

3. It is essential that trial holes are carefully made avoiding the use of mechanical tools or picks until the exact location of all the cables have been determined.

4. It must be assumed that there is a service cable into each property, lamp column and street sign, etc.

5. All cables must be treated as being live unless proved otherwise by UK Power Networks.

6. The information proved must be given to all people working near UK Power Networks plant and equipment. Do not use plans more than 3 months after the issue date for excavation purposes.

7. Please be aware that electric cables/lines belonging to other owners of licensed electricity distribution systems may be present and it is your responsibility to identify their location.

1. UK Power Networks does not warrant that the information provided to you is correct. You rely upon it at your own risk.

2. UK Power Networks does not exclude or limit its liability if it causes the death of any persons or causes personal injury to a person.

3. Subject to paragraph 2 UK Power Networks has no liability to you in contract, in tort (including negligence), for breach of statutory duty or otherwise for any loss, damage, cost, claims, demands, or expenses that you or any third party may suffer or incur as a result of using the information provided whether for physical damage to property or for any economic loss (including without limitation loss of profit, loss of opportunity, loss of savings, loss of goodwill, loss of business, loss of use) or any special or consequential loss or damage whatsoever.

4. This plan has been provided to you on the basis of the terms of use set out in the covering letter that accompanies this plan. If you do not accept and/or do not understand the terms of use set out in the covering letter you must not use the plan and must return it to the sender of the letter.

5. You are responsible for the security of the information provided to you. It must not be given, sold or made available upon payment of a fee to a third party.

IF IN DOUBT - ASK!
PHONE 0800 056 5866
EMERGENCY - If you damage a cable or line
Phone 0800 783 8838
(24hrs) URGENTLY

ALWAYS LOOK UP BEFORE YOU START WORK
Refer to HSE Guidance note GS6

Maps produced at 1:2500 scale are Geo-Schematics which show LV mains cables and overhead lines (in some cases all voltages). Prior to carrying out excavations you must refer to the 1:500 records to determine the location of all known underground plant and equipment.

Reproduced by permission of Ordnance Survey on behalf of HMSO. © Crown copyright and database rights 2023. All rights reserved. Ordnance Survey Licence numbers 100019626, 100019826 and 100019450. Data has been added to the Ordnance Survey base map; all proprietary rights in such additional data are and shall remain the exclusive property of © London Power Networks plc or Eastern Power Networks plc or South Eastern Power Networks plc each being a distribution licensee under section 6(1)(c) of the Electricity Act 1989 for the relevant distribution services area as that term is defined in such licensee’s distribution licence. All rights in such data reserved.
Plans generated by DigSAFE Pro™ software provided by LinesearchbeforeUdig.



0

25

50

metres

Dig Sites

Area:

Line:

This plan must be used with the attached ‘Symbols’ document.

Date Requested: 19/05/2025

Job Reference: 37324868

Site Location: 534993 124590

Requested by: Mr Duncan Phillips

Your Scheme/Reference: Gladman

Scale: 1:500 (When plotted at A3)

1. The position of the apparatus shown on this drawing is believed to be correct but the original landmarks may have been altered since the apparatus was installed.

2. The exact position of the apparatus should be verified - use approved cable avoidance tools prior to excavation using suitable hand tools.

3. It is essential that trial holes are carefully made avoiding the use of mechanical tools or picks until the exact location of all the cables have been determined.

4. It must be assumed that there is a service cable into each property, lamp column and street sign, etc.

5. All cables must be treated as being live unless proved otherwise by UK Power Networks.

6. The information proved must be given to all people working near UK Power Networks plant and equipment. Do not use plans more than 3 months after the issue date for excavation purposes.

7. Please be aware that electric cables/lines belonging to other owners of licensed electricity distribution systems may be present and it is your responsibility to identify their location.

1. UK Power Networks does not warrant that the information provided to you is correct. You rely upon it at your own risk.

2. UK Power Networks does not exclude or limit its liability if it causes the death of any persons or causes personal injury to a person.

3. Subject to paragraph 2 UK Power Networks has no liability to you in contract, in tort (including negligence), for breach of statutory duty or otherwise for any loss, damage, cost, claims, demands, or expenses that you or any third party may suffer or incur as a result of using the information provided whether for physical damage to property or for any economic loss (including without limitation loss of profit, loss of opportunity, loss of savings, loss of goodwill, loss of business, loss of use) or any special or consequential loss or damage whatsoever.

4. This plan has been provided to you on the basis of the terms of use set out in the covering letter that accompanies this plan. If you do not accept and/or do not understand the terms of use set out in the covering letter you must not use the plan and must return it to the sender of the letter.

5. You are responsible for the security of the information provided to you. It must not be given, sold or made available upon payment of a fee to a third party.

UK Power Networks


IF IN DOUBT - ASK!
PHONE 0800 056 5866
EMERGENCY - If you damage a cable or line
Phone 0800 783 8838 (24hrs) URGENTLY

ALWAYS LOOK UP BEFORE YOU START WORK
Refer to HSE Guidance note GS6

Maps produced at 1:2500 scale are Geo-Schematics which show LV mains cables and overhead lines (in some cases all voltages). Prior to carrying out excavations you must refer to the 1:500 records to determine the location of all known underground plant and equipment.

Reproduced by permission of Ordnance Survey on behalf of HMSO. © Crown copyright and database rights 2023. All rights reserved. Ordnance Survey Licence numbers 100019626, 100019826 and 100019450. Data has been added to the Ordnance Survey base map; all proprietary rights in such additional data are and shall remain the exclusive property of © London Power Networks plc or Eastern Power Networks plc or South Eastern Power Networks plc each being a distribution licensee under section 6(1)(c) of the Electricity Act 1989 for the relevant distribution services area as that term is defined in such licensee’s distribution licence. All rights in such data reserved.

Plans generated by DigSAFE Pro™ software provided by LinesearchbeforeUdig.

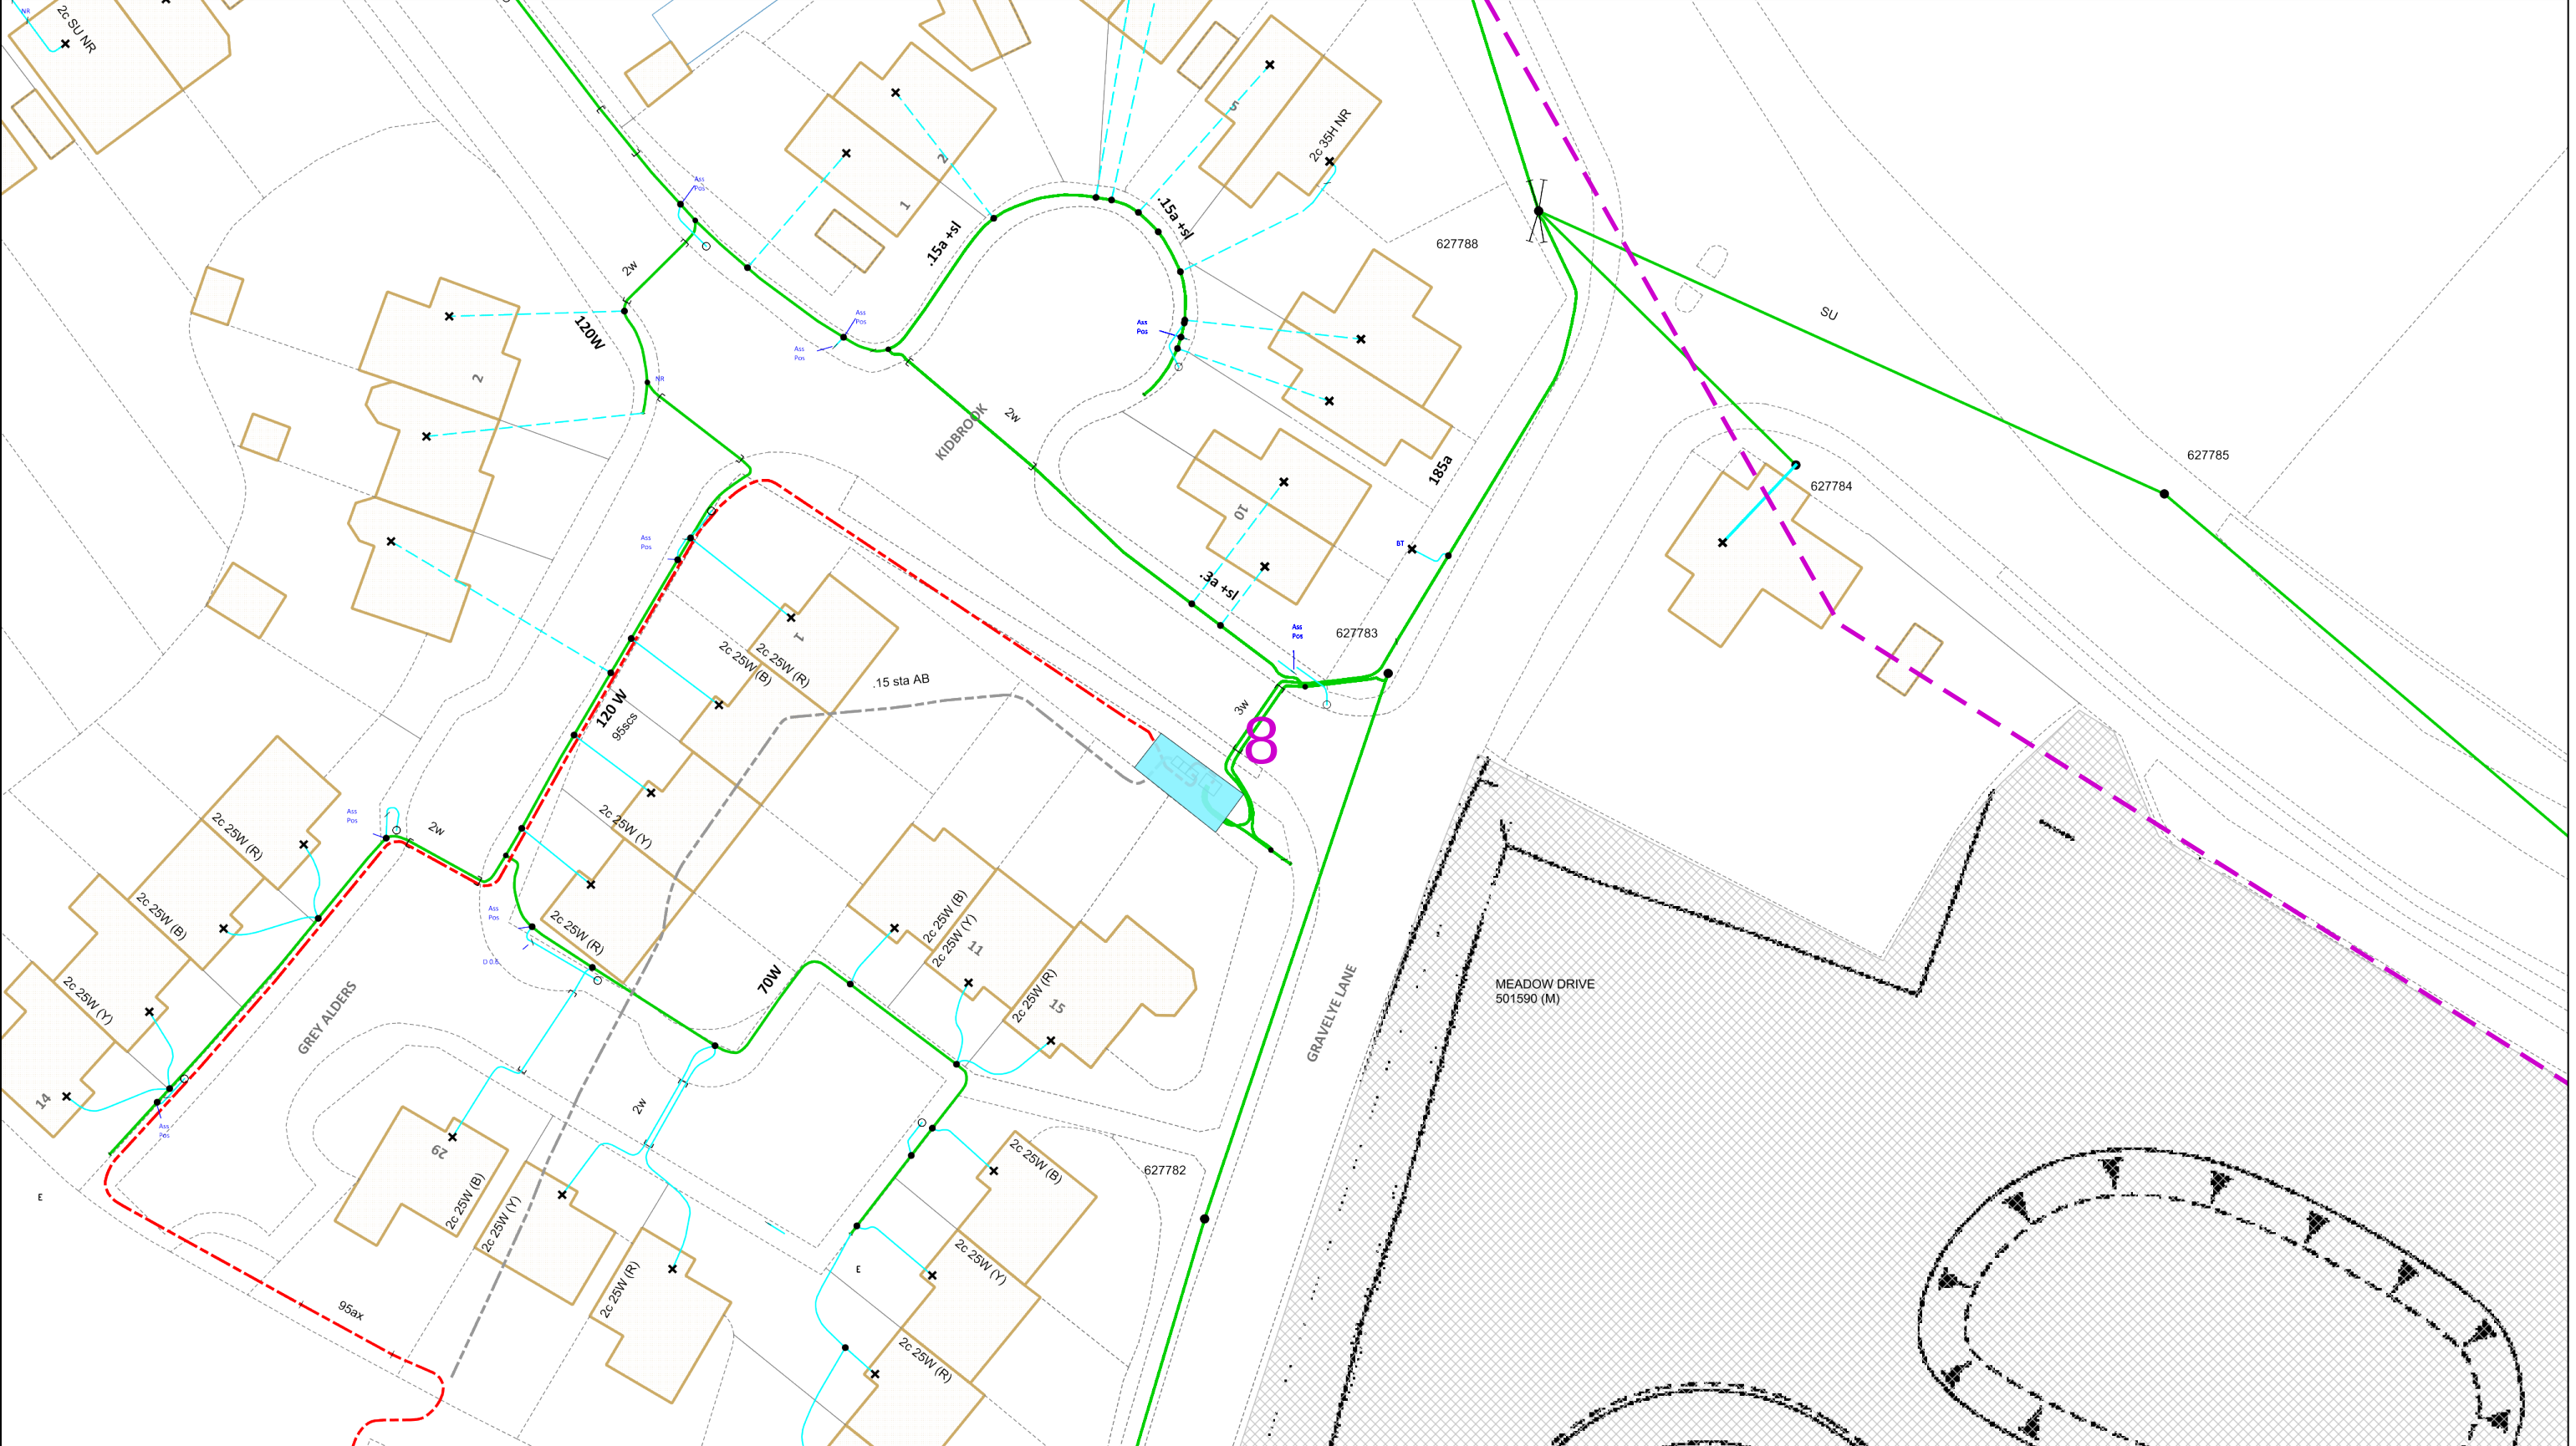

02550metres

Dig SitesArea: ---Line: ---

The quality and accuracy of any print will depend on your printer, your computer and its print settings. Measurements scaled from this plan may not match measurements between the same points on the ground.

This plan must be used with the attached ‘Symbols’ document.

Date Requested: 19/05/2025
Job Reference: 37324868
Site Location: 534993 124590
Requested by:
Mr Duncan Phillips
Your Scheme/Reference: Gladman

Scale: 1:500 (When plotted at A3)

1. The position of the apparatus shown on this drawing is believed to be correct but the original landmarks may have been altered since the apparatus was installed.

2. The exact position of the apparatus should be verified - use approved cable avoidance tools prior to excavation using suitable hand tools.

3. It is essential that trial holes are carefully made avoiding the use of mechanical tools or picks until the exact location of all the cables have been determined.

4. It must be assumed that there is a service cable into each property, lamp column and street sign, etc.

5. All cables must be treated as being live unless proved otherwise by UK Power Networks.

6. The information proved must be given to all people working near UK Power Networks plant and equipment. Do not use plans more than 3 months after the issue date for excavation purposes.

7. Please be aware that electric cables/lines belonging to other owners of licensed electricity distribution systems may be present and it is your responsibility to identify their location.

1. UK Power Networks does not warrant that the information provided to you is correct. You rely upon it at your own risk.

2. UK Power Networks does not exclude or limit its liability if it causes the death of any persons or causes personal injury to a person.

3. Subject to paragraph 2 UK Power Networks has no liability to you in contract, in tort (including negligence), for breach of statutory duty or otherwise for any loss, damage, cost, claims, demands, or expenses that you or any third party may suffer or incur as a result of using the information provided whether for physical damage to property or for any economic loss (including without limitation loss of profit, loss of opportunity, loss of savings, loss of goodwill, loss of business, loss of use) or any special or consequential loss or damage whatsoever.

4. This plan has been provided to you on the basis of the terms of use set out in the covering letter that accompanies this plan. If you do not accept and/or do not understand the terms of use set out in the covering letter you must not use the plan and must return it to the sender of the letter.

5. You are responsible for the security of the information provided to you. It must not be given, sold or made available upon payment of a fee to a third party.

N

W

E

S

IF IN DOUBT - ASK!
PHONE 0800 056 5866
EMERGENCY - If you damage a cable or line
Phone 0800 783 8838
(24hrs) URGENTLY


UK Power Networks

LOOK OUT
LOOK UP

ALWAYS LOOK UP BEFORE YOU START WORK
Refer to HSE Guidance note GS6

Maps produced at 1:2500 scale are Geo-Schematics which show LV mains cables and overhead lines (in some cases all voltages). Prior to carrying out excavations you must refer to the 1:500 records to determine the location of all known underground plant and equipment.

Reproduced by permission of Ordnance Survey on behalf of HMSO. © Crown copyright and database rights 2023. All rights reserved. Ordnance Survey Licence numbers 100019626, 100019826 and 100019450. Data has been added to the Ordnance Survey base map; all proprietary rights in such additional data are and shall remain the exclusive property of © London Power Networks plc or Eastern Power Networks plc or South Eastern Power Networks plc each being a distribution licensee under section 6(1)(c) of the Electricity Act 1989 for the relevant distribution services area as that term is defined in such licensee’s distribution licence. All rights in such data reserved.
Plans generated by DigSAFE Pro™ software provided by LinesearchbeforeUdig.

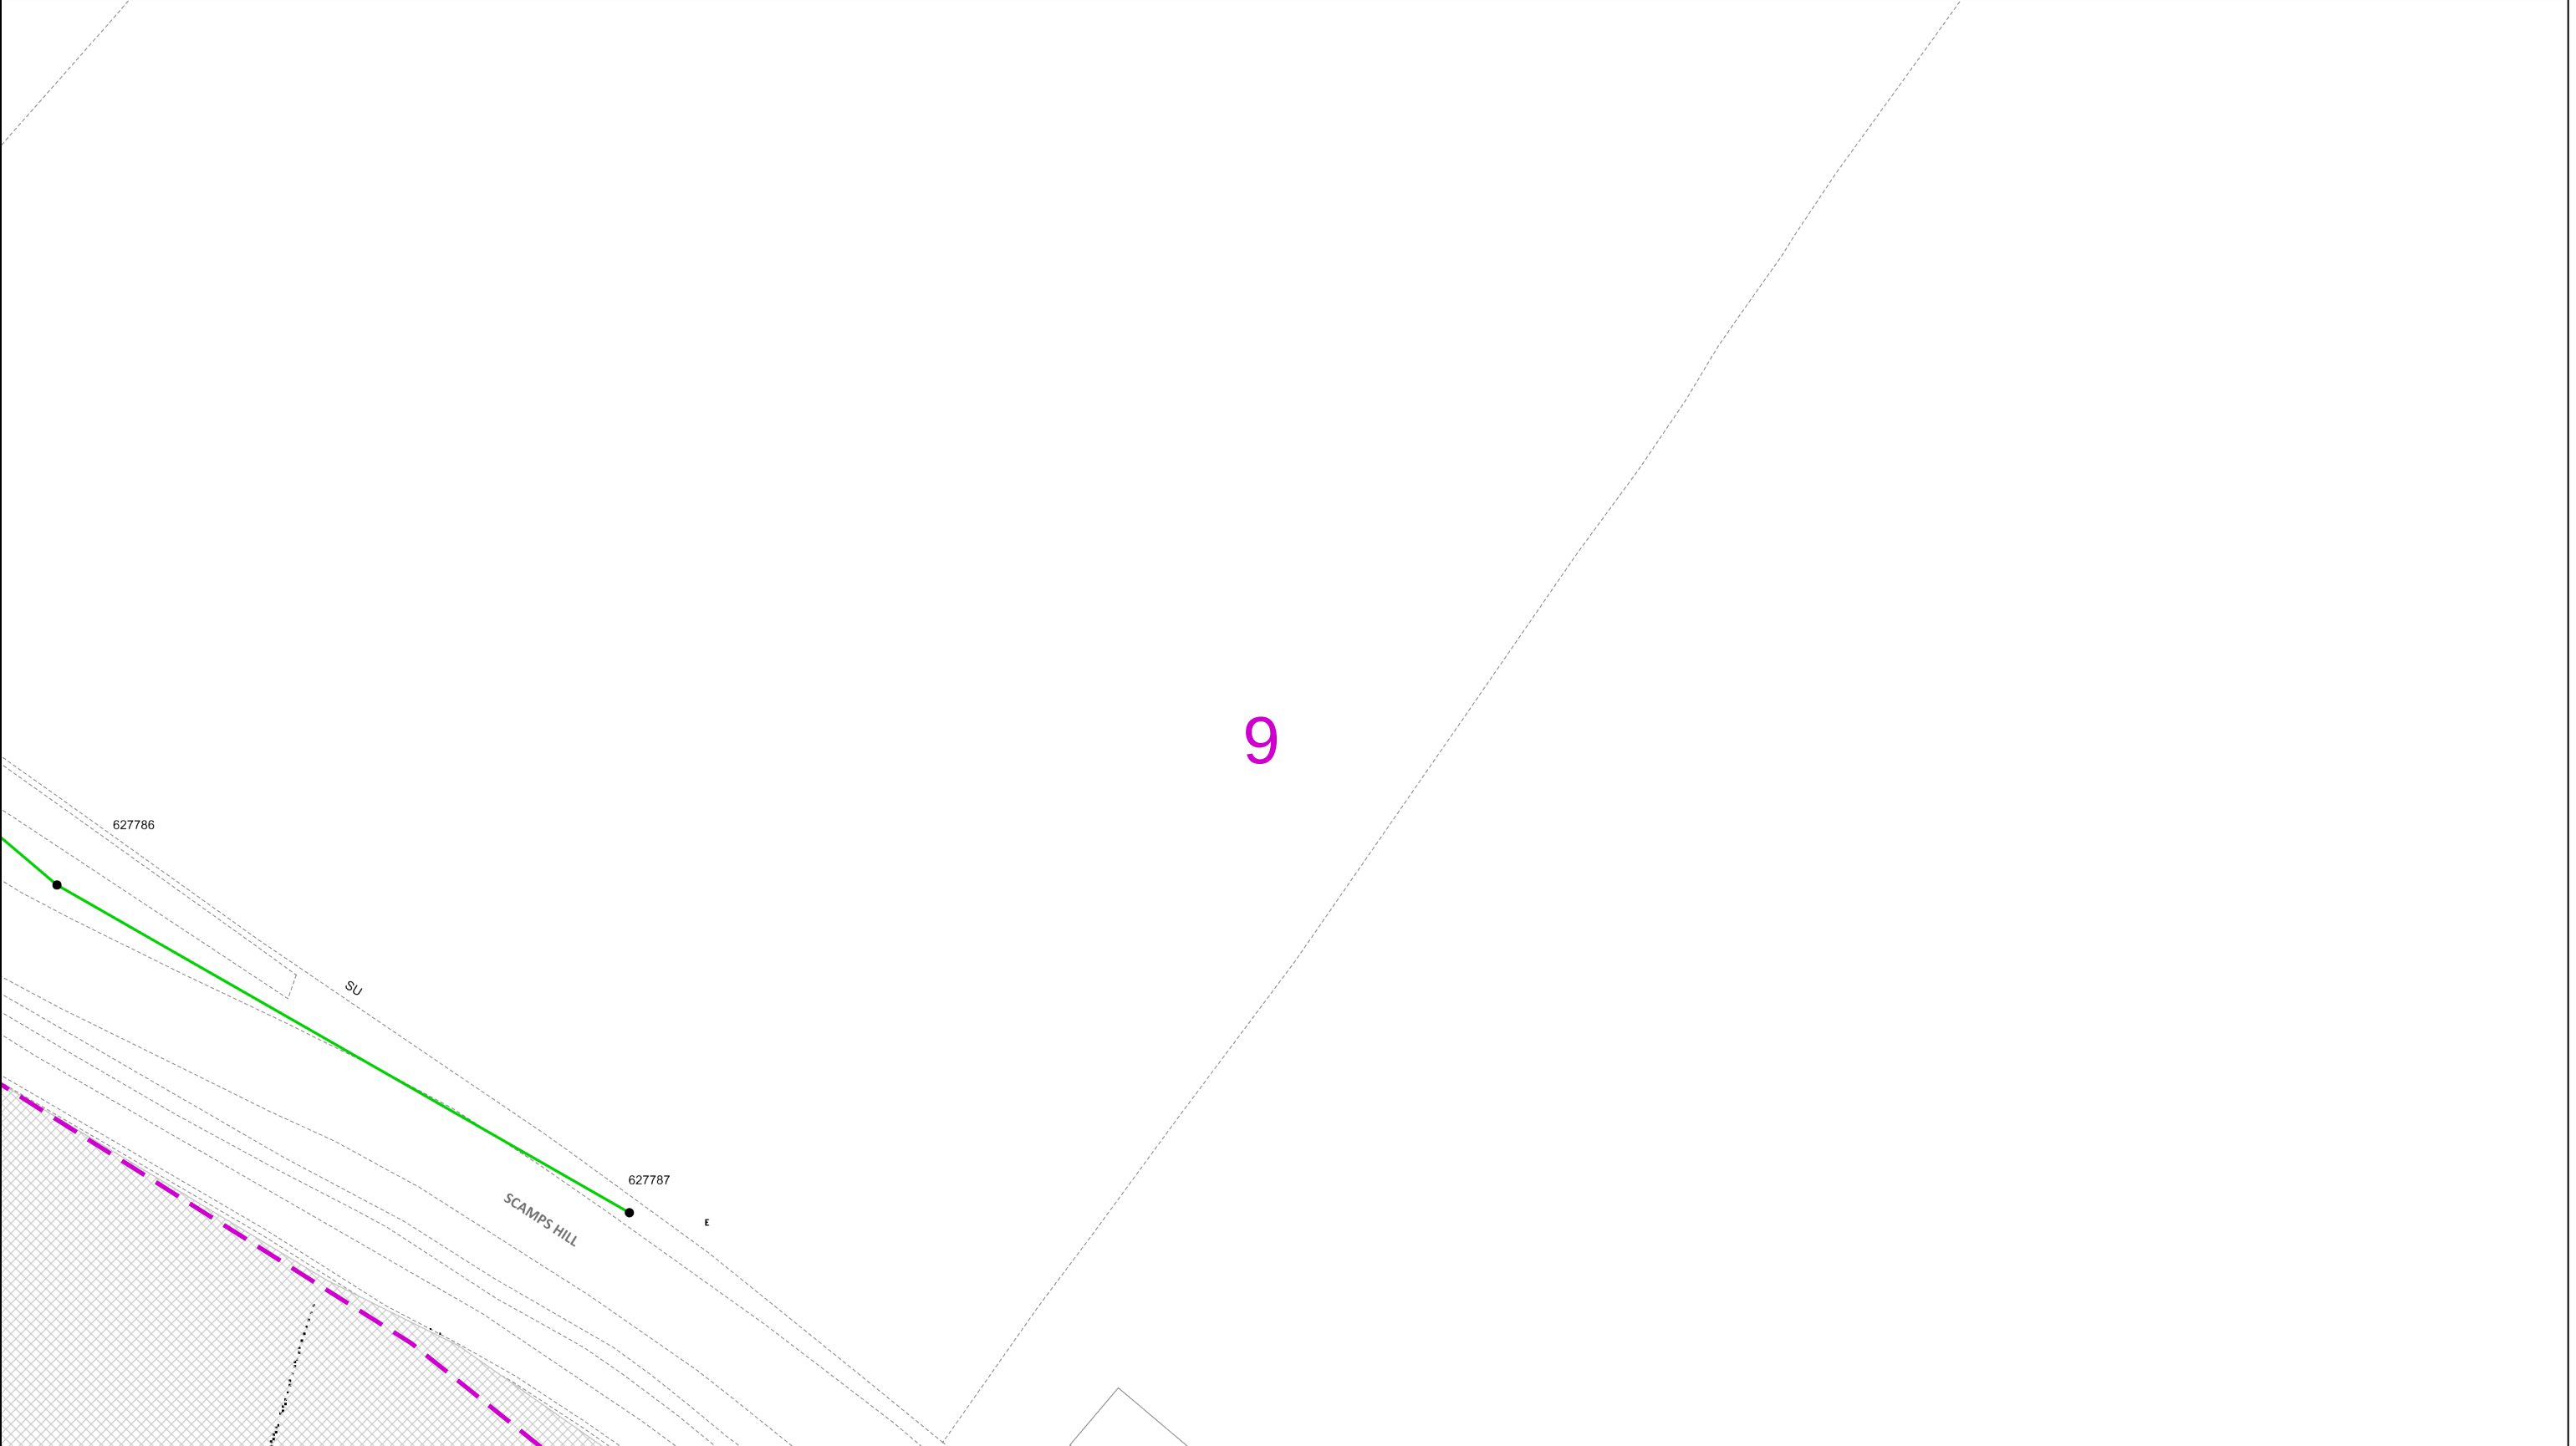

02550metres

Dig SitesArea: [dashed magenta box] Line: [dashed magenta line]

This plan must be used with the attached ‘Symbols’ document.

Date Requested: 19/05/2025

Job Reference: 37324868

Site Location: 534993 124590

Requested by: Mr Duncan Phillips

Your Scheme/Reference: Gladman

Scale: 1:500 (When plotted at A3)

1. The position of the apparatus shown on this drawing is believed to be correct but the original landmarks may have been altered since the apparatus was installed.

2. The exact position of the apparatus should be verified - use approved cable avoidance tools prior to excavation using suitable hand tools.

3. It is essential that trial holes are carefully made avoiding the use of mechanical tools or picks until the exact location of all the cables have been determined.

4. It must be assumed that there is a service cable into each property, lamp column and street sign, etc.

5. All cables must be treated as being live unless proved otherwise by UK Power Networks.

6. The information proved must be given to all people working near UK Power Networks plant and equipment. Do not use plans more than 3 months after the issue date for excavation purposes.

7. Please be aware that electric cables/lines belonging to other owners of licensed electricity distribution systems may be present and it is your responsibility to identify their location.

1. UK Power Networks does not warrant that the information provided to you is correct. You rely upon it at your own risk.

2. UK Power Networks does not exclude or limit its liability if it causes the death of any persons or causes personal injury to a person.

3. Subject to paragraph 2 UK Power Networks has no liability to you in contract, in tort (including negligence), for breach of statutory duty or otherwise for any loss, damage, cost, claims, demands, or expenses that you or any third party may suffer or incur as a result of using the information provided whether for physical damage to property or for any economic loss (including without limitation loss of profit, loss of opportunity, loss of savings, loss of goodwill, loss of business, loss of use) or any special or consequential loss or damage whatsoever.

4. This plan has been provided to you on the basis of the terms of use set out in the covering letter that accompanies this plan. If you do not accept and/or do not understand the terms of use set out in the covering letter you must not use the plan and must return it to the sender of the letter.


5. You are responsible for the security of the information provided to you. It must not be given, sold or made available upon payment of a fee to a third party.

IF IN DOUBT - ASK!
PHONE 0800 056 5866
EMERGENCY - If you damage a cable or line
Phone 0800 783 8838
(24hrs) URGENTLY

ALWAYS LOOK UP BEFORE YOU START WORK
Refer to HSE Guidance note GS6

Maps produced at 1:2500 scale are Geo-Schematics which show LV mains cables and overhead lines (in some cases all voltages). Prior to carrying out excavations you must refer to the 1:500 records to determine the location of all known underground plant and equipment.

Reproduced by permission of Ordnance Survey on behalf of HMSO. © Crown copyright and database rights 2023. All rights reserved. Ordnance Survey Licence numbers 100019626, 100019826 and 100019450. Data has been added to the Ordnance Survey base map; all proprietary rights in such additional data are and shall remain the exclusive property of © London Power Networks plc or Eastern Power Networks plc or South Eastern Power Networks plc each being a distribution licensee under section 6(1)(c) of the Electricity Act 1989 for the relevant distribution services area as that term is defined in such licensee’s distribution licence. All rights in such data reserved.
Plans generated by DigSAFE Pro™ software provided by LinesearchbeforeUdig.

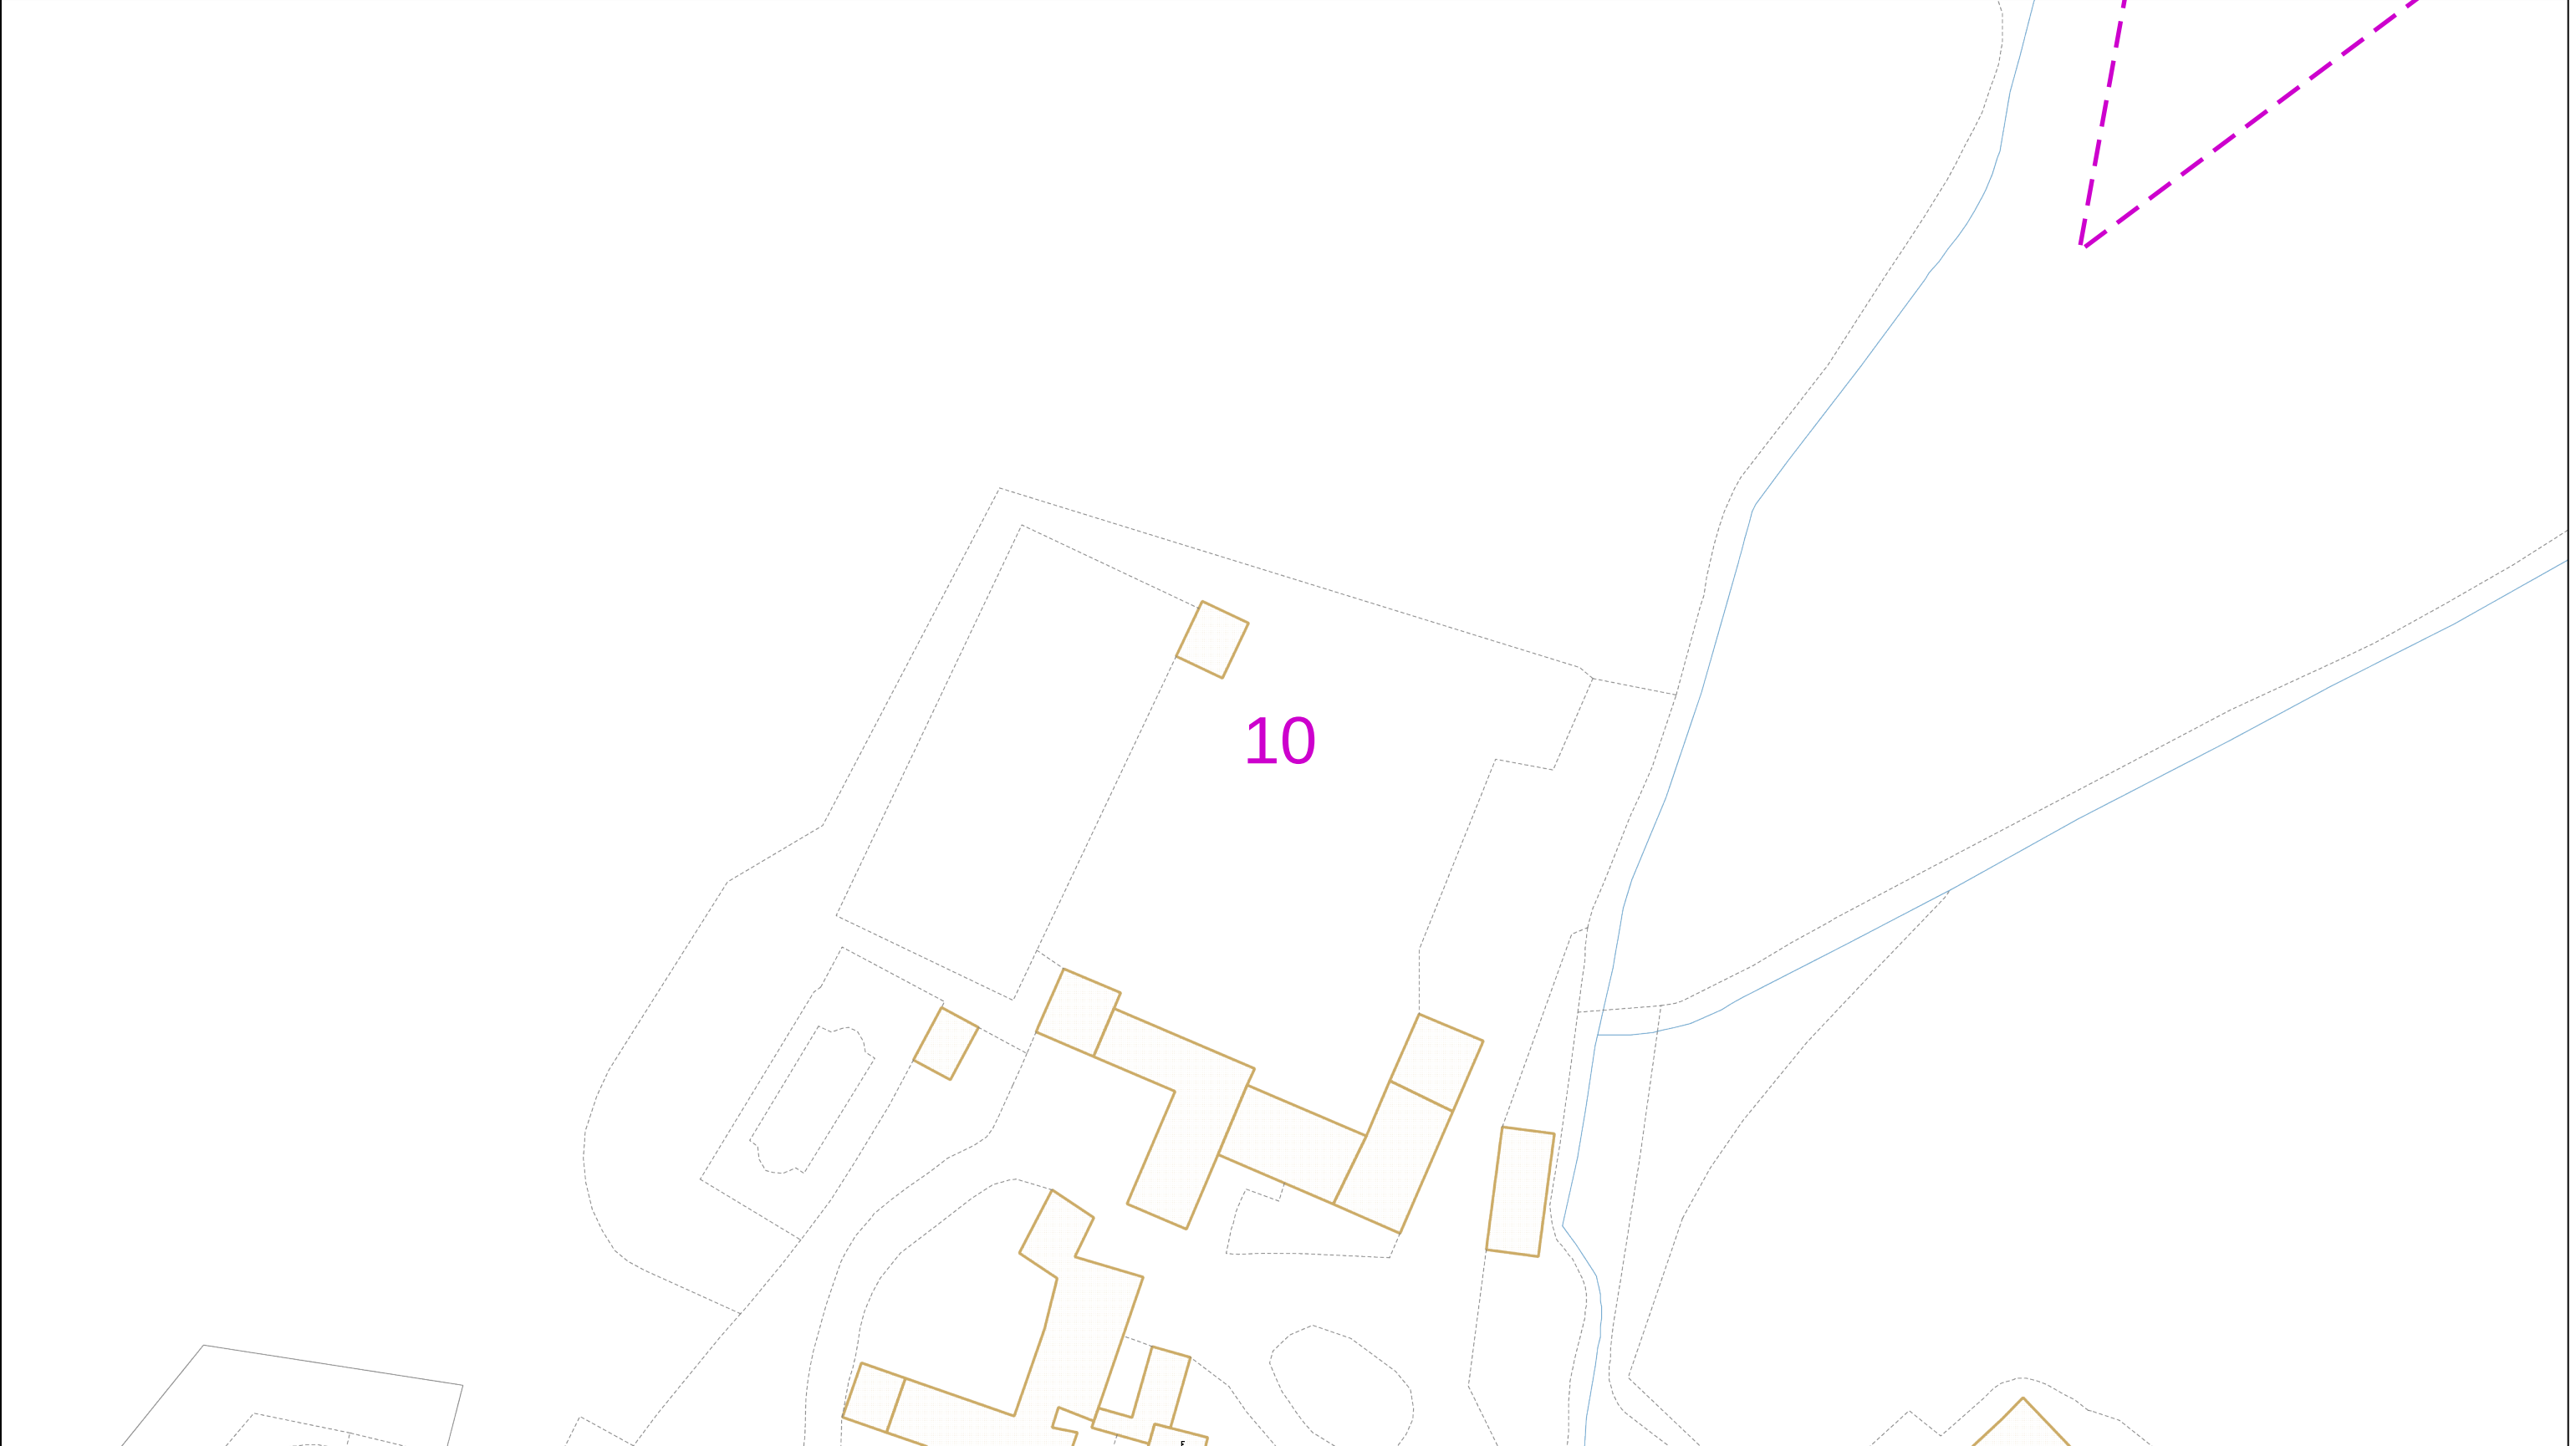

02550metres

Dig SitesArea: Line:

The quality and accuracy of any print will depend on your printer, your computer and its print settings. Measurements scaled from this plan may not match measurements between the same points on the ground.

This plan must be used with the attached ‘Symbols’ document.

Date Requested: 19/05/2025
Job Reference: 37324868
Site Location: 534993 124590
Requested by: Mr Duncan Phillips
Your Scheme/Reference: Gladman

Scale: 1:500 (When plotted at A3)

1. The position of the apparatus shown on this drawing is believed to be correct but the original landmarks may have been altered since the apparatus was installed.

2. The exact position of the apparatus should be verified - use approved cable avoidance tools prior to excavation using suitable hand tools.

3. It is essential that trial holes are carefully made avoiding the use of mechanical tools or picks until the exact location of all the cables have been determined.

4. It must be assumed that there is a service cable into each property, lamp column and street sign, etc.

5. All cables must be treated as being live unless proved otherwise by UK Power Networks.

6. The information proved must be given to all people working near UK Power Networks plant and equipment. Do not use plans more than 3 months after the issue date for excavation purposes.

7. Please be aware that electric cables/lines belonging to other owners of licensed electricity distribution systems may be present and it is your responsibility to identify their location.

1. UK Power Networks does not warrant that the information provided to you is correct. You rely upon it at your own risk.

2. UK Power Networks does not exclude or limit its liability if it causes the death of any persons or causes personal injury to a person.

3. Subject to paragraph 2 UK Power Networks has no liability to you in contract, in tort (including negligence), for breach of statutory duty or otherwise for any loss, damage, cost, claims, demands, or expenses that you or any third party may suffer or incur as a result of using the information provided whether for physical damage to property or for any economic loss (including without limitation loss of profit, loss of opportunity, loss of savings, loss of goodwill, loss of business, loss of use) or any special or consequential loss or damage whatsoever.

4. This plan has been provided to you on the basis of the terms of use set out in the covering letter that accompanies this plan. If you do not accept and/or do not understand the terms of use set out in the covering letter you must not use the plan and must return it to the sender of the letter.

5. You are responsible for the security of the information provided to you. It must not be given, sold or made available upon payment of a fee to a third party.

UK Power Networks


IF IN DOUBT - ASK!
PHONE 0800 056 5866
EMERGENCY - If you damage a cable or line
Phone 0800 783 8838 (24hrs) URGENTLY

ALWAYS LOOK UP BEFORE YOU START WORK
Refer to HSE Guidance note GS6

Maps produced at 1:2500 scale are Geo-Schematics which show LV mains cables and overhead lines (in some cases all voltages). Prior to carrying out excavations you must refer to the 1:500 records to determine the location of all known underground plant and equipment.

Reproduced by permission of Ordnance Survey on behalf of HMSO. © Crown copyright and database rights 2023. All rights reserved. Ordnance Survey Licence numbers 100019626, 100019826 and 100019450. Data has been added to the Ordnance Survey base map; all proprietary rights in such additional data are and shall remain the exclusive property of © London Power Networks plc or Eastern Power Networks plc or South Eastern Power Networks plc each being a distribution licensee under section 6(1)(c) of the Electricity Act 1989 for the relevant distribution services area as that term is defined in such licensee’s distribution licence. All rights in such data reserved.

Plans generated by DigSAFE Pro™ software provided by LinesearchbeforeUdig.

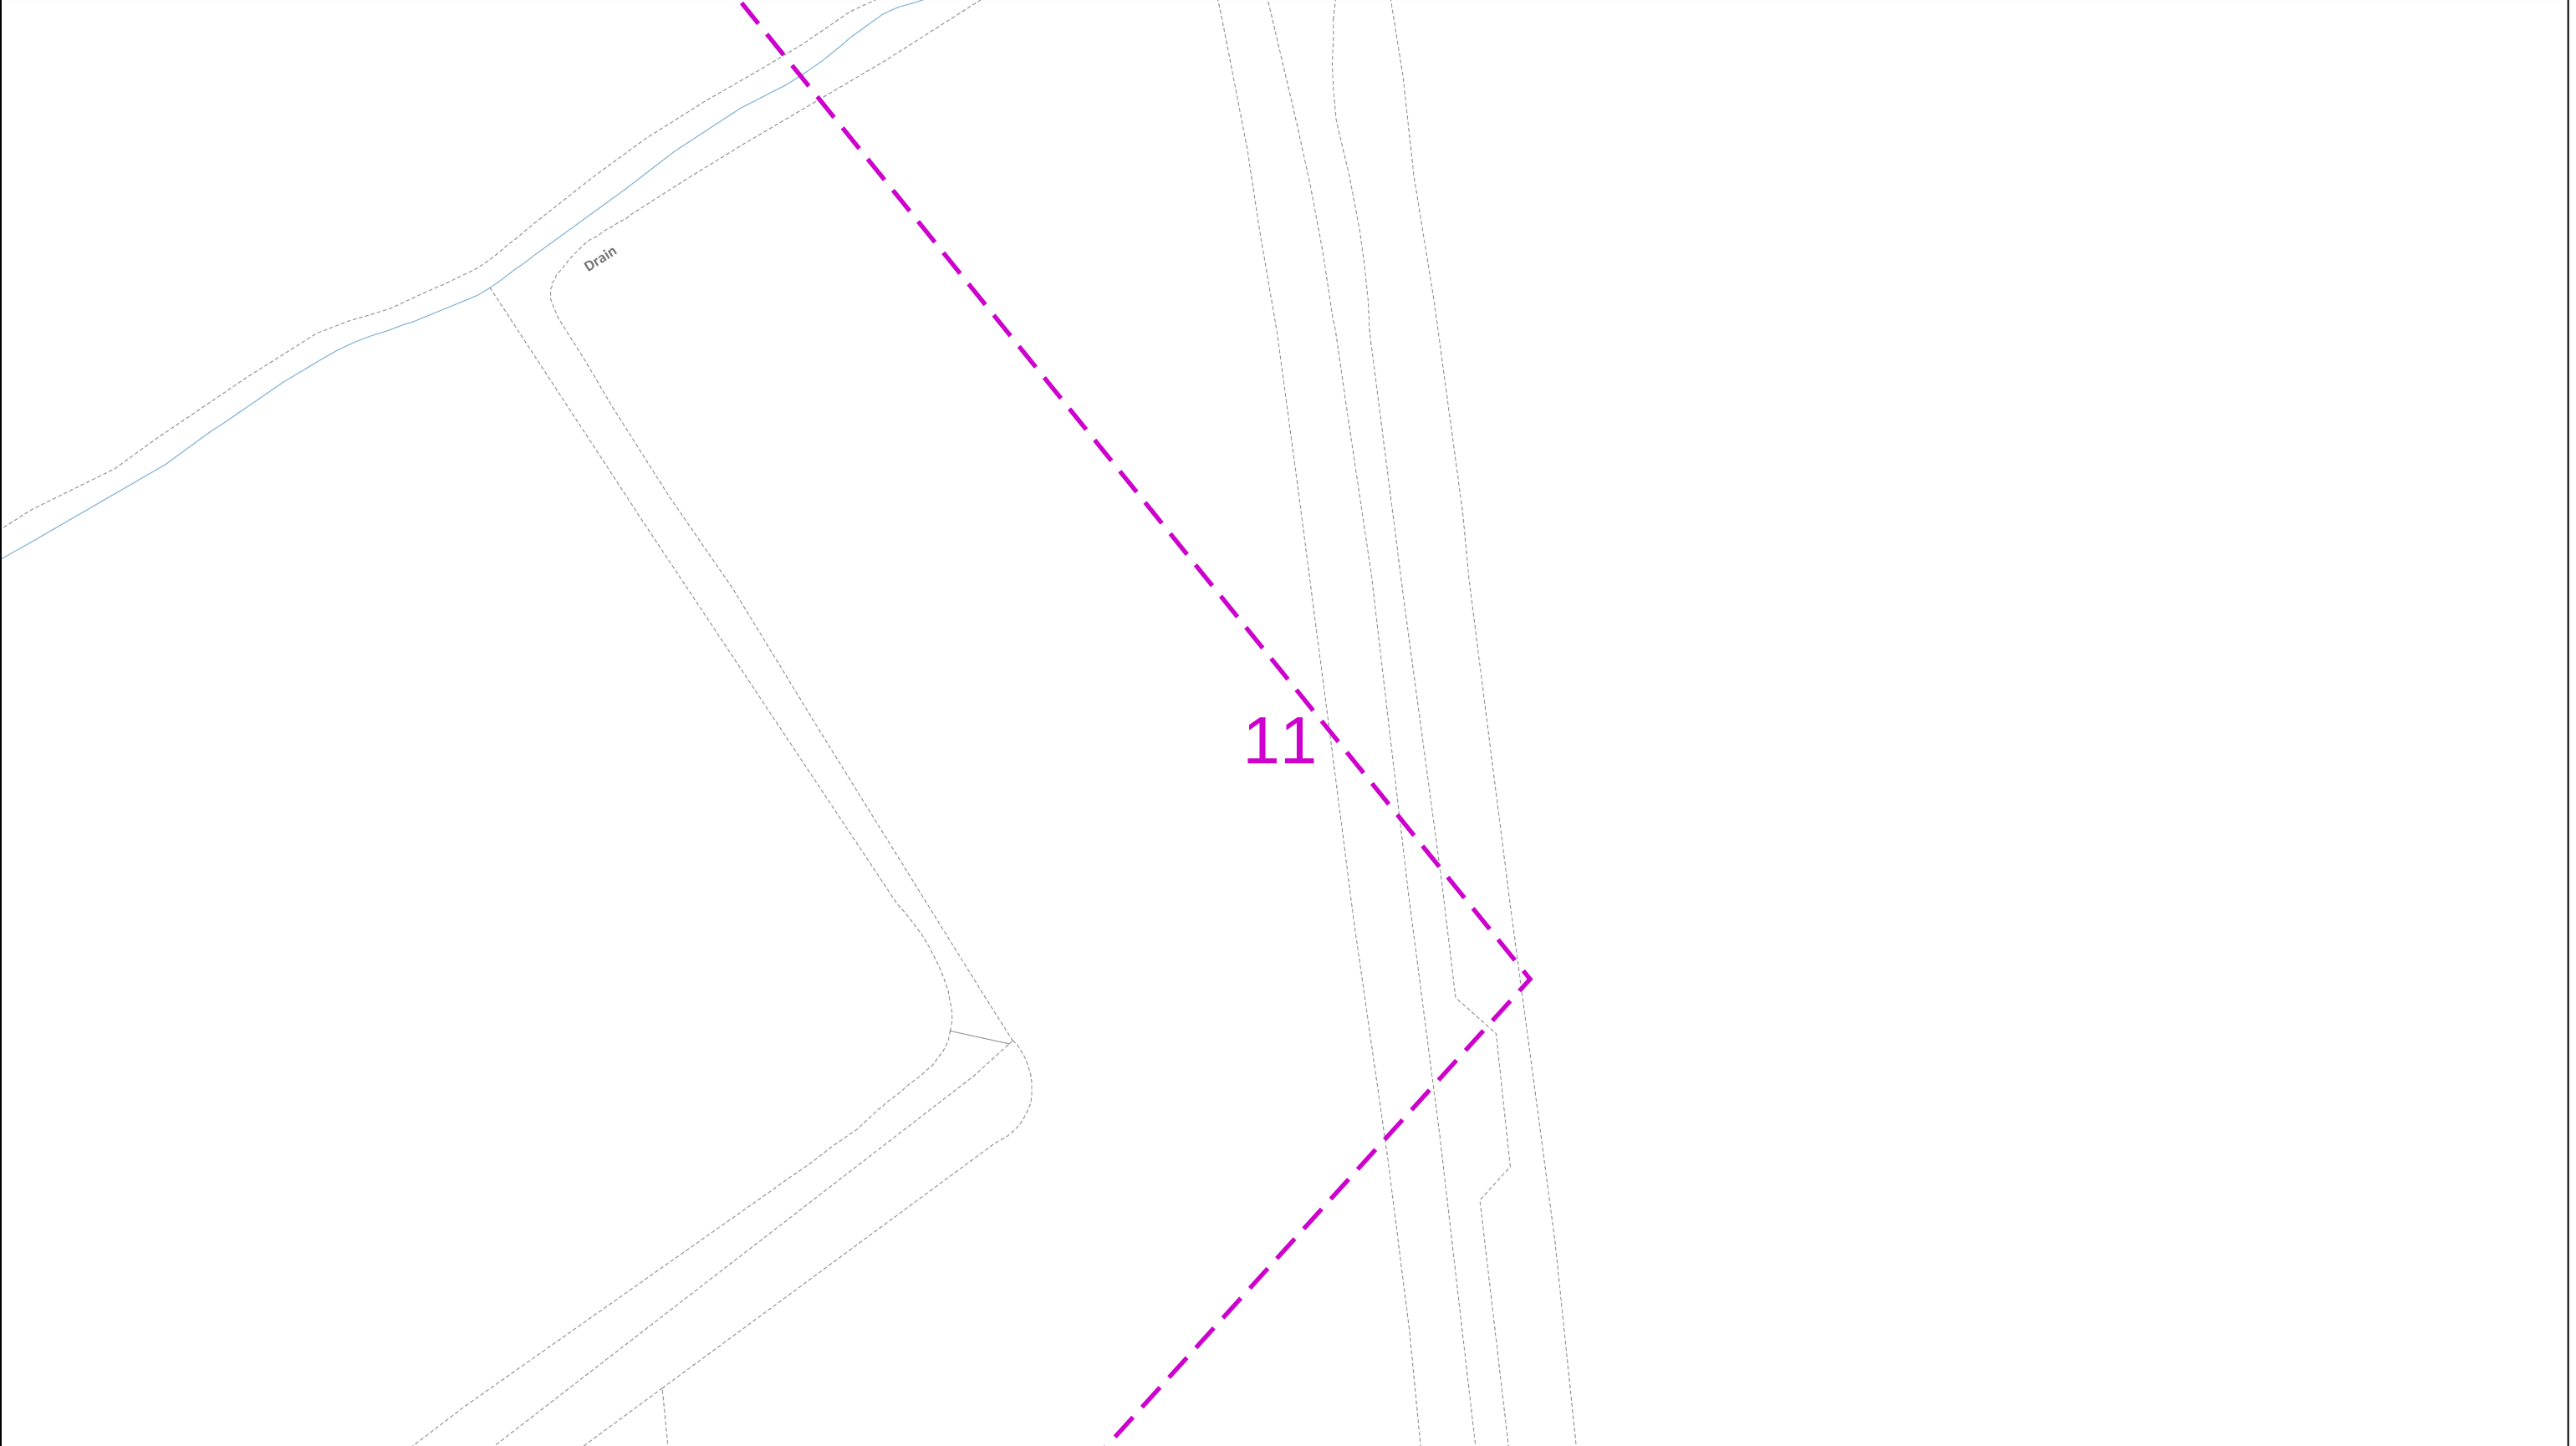

0

25

50

metres

Dig Sites

Area:

Line:

The quality and accuracy of any print will depend on your printer, your computer and its print settings. Measurements scaled from this plan may not match measurements between the same points on the ground.

This plan must be used with the attached ‘Symbols’ document.

Date Requested: 19/05/2025

Job Reference: 37324868

Site Location: 534993 124590

Requested by: Mr Duncan Phillips

Your Scheme/Reference: Gladman

Scale: 1:500 (When plotted at A3)

1. The position of the apparatus shown on this drawing is believed to be correct but the original landmarks may have been altered since the apparatus was installed.

2. The exact position of the apparatus should be verified - use approved cable avoidance tools prior to excavation using suitable hand tools.

3. It is essential that trial holes are carefully made avoiding the use of mechanical tools or picks until the exact location of all the cables have been determined.

4. It must be assumed that there is a service cable into each property, lamp column and street sign, etc.

5. All cables must be treated as being live unless proved otherwise by UK Power Networks.

6. The information proved must be given to all people working near UK Power Networks plant and equipment. Do not use plans more than 3 months after the issue date for excavation purposes.

7. Please be aware that electric cables/lines belonging to other owners of licensed electricity distribution systems may be present and it is your responsibility to identify their location.

1. UK Power Networks does not warrant that the information provided to you is correct. You rely upon it at your own risk.

2. UK Power Networks does not exclude or limit its liability if it causes the death of any persons or causes personal injury to a person.

3. Subject to paragraph 2 UK Power Networks has no liability to you in contract, in tort (including negligence), for breach of statutory duty or otherwise for any loss, damage, cost, claims, demands, or expenses that you or any third party may suffer or incur as a result of using the information provided whether for physical damage to property or for any economic loss (including without limitation loss of profit, loss of opportunity, loss of savings, loss of goodwill, loss of business, loss of use) or any special or consequential loss or damage whatsoever.

4. This plan has been provided to you on the basis of the terms of use set out in the covering letter that accompanies this plan. If you do not accept and/or do not understand the terms of use set out in the covering letter you must not use the plan and must return it to the sender of the letter.

5. You are responsible for the security of the information provided to you. It must not be given, sold or made available upon payment of a fee to a third party.

UK Power Networks


IF IN DOUBT - ASK!
PHONE 0800 056 5866
EMERGENCY - If you damage a cable or line
Phone 0800 783 8838
(24hrs) URGENTLY

ALWAYS LOOK UP BEFORE YOU START WORK
Refer to HSE Guidance note GS6

Maps produced at 1:2500 scale are Geo-Schematics which show LV mains cables and overhead lines (in some cases all voltages). Prior to carrying out excavations you must refer to the 1:500 records to determine the location of all known underground plant and equipment.

Reproduced by permission of Ordnance Survey on behalf of HMSO. © Crown copyright and database rights 2023. All rights reserved. Ordnance Survey Licence numbers 100019626, 100019826 and 100019450. Data has been added to the Ordnance Survey base map; all proprietary rights in such additional data are and shall remain the exclusive property of © London Power Networks plc or Eastern Power Networks plc or South Eastern Power Networks plc each being a distribution licensee under section 6(1)(c) of the Electricity Act 1989 for the relevant distribution services area as that term is defined in such licensee’s distribution licence. All rights in such data reserved.

Plans generated by DigSAFE Pro™ software provided by LinesearchbeforeUdig.

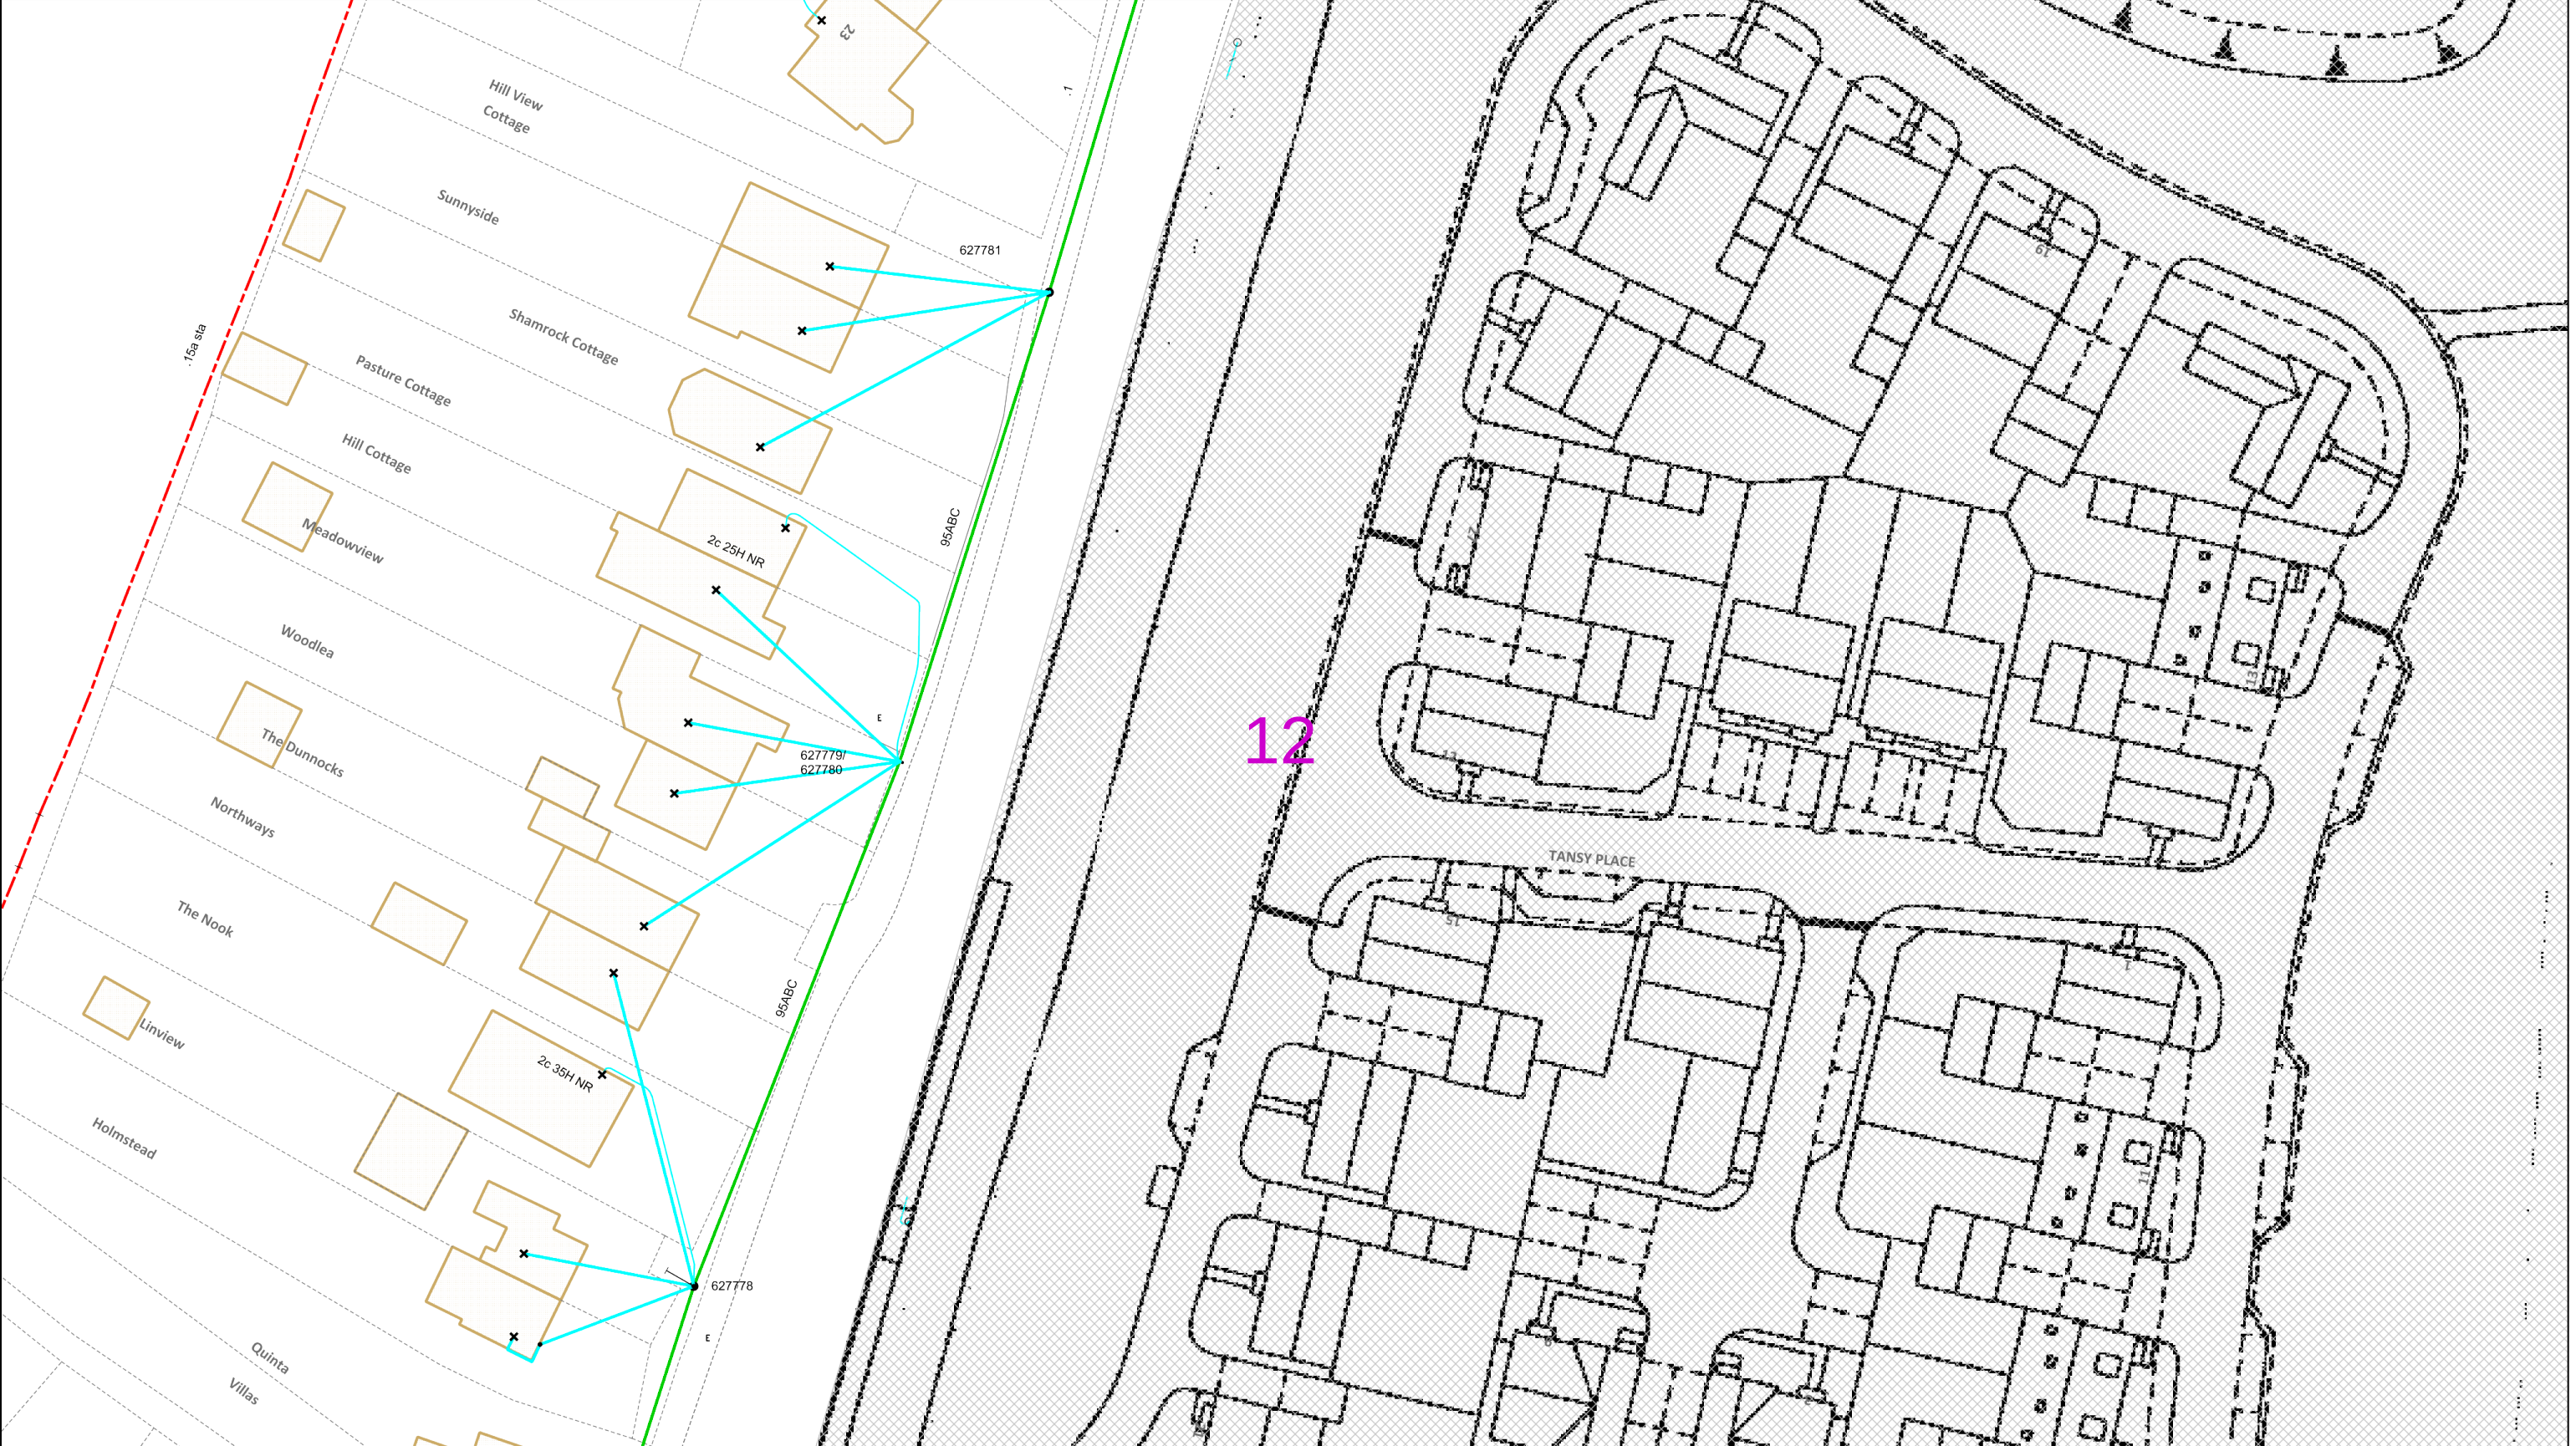

02550metres

This plan must be used with the attached 'Symbols' document.

Date Requested: 19/05/2025
Job Reference: 37324868
Site Location: 534993 124590
Requested by:
Mr Duncan Phillips
Your Scheme/Reference: Gladman

Scale: 1:500 (When plotted at A3)

Dig SitesArea: Line:

1. The position of the apparatus shown on this drawing is believed to be correct but the original landmarks may have been altered since the apparatus was installed.

2. The exact position of the apparatus should be verified - use approved cable avoidance tools prior to excavation using suitable hand tools.

3. It is essential that trial holes are carefully made avoiding the use of mechanical tools or picks until the exact location of all the cables have been determined.

4. It must be assumed that there is a service cable into each property, lamp column and street sign, etc.

5. All cables must be treated as being live unless proved otherwise by UK Power Networks.

6. The information proved must be given to all people working near UK Power Networks plant and equipment. Do not use plans more than 3 months after the issue date for excavation purposes.

7. Please be aware that electric cables/lines belonging to other owners of licensed electricity distribution systems may be present and it is your responsibility to identify their location.

The quality and accuracy of any print will depend on your printer, your computer and its print settings. Measurements scaled from this plan may not match measurements between the same points on the ground.

1. UK Power Networks does not warrant that the information provided to you is correct. You rely upon it at your own risk.

2. UK Power Networks does not exclude or limit its liability if it causes the death of any persons or causes personal injury to a person.

3. Subject to paragraph 2 UK Power Networks has no liability to you in contract, in tort (including negligence), for breach of statutory duty or otherwise for any loss, damage, cost, claims, demands, or expenses that you or any third party may suffer or incur as a result of using the information provided whether for physical damage to property or for any economic loss (including without limitation loss of profit, loss of opportunity, loss of savings, loss of goodwill, loss of business, loss of use) or any special or consequential loss or damage whatsoever.

4. This plan has been provided to you on the basis of the terms of use set out in the covering letter that accompanies this plan. If you do not accept and/or do not understand the terms of use set out in the covering letter you must not use the plan and must return it to the sender of the letter.

5. You are responsible for the security of the information provided to you. It must not be given, sold or made available upon payment of a fee to a third party.

UK Power Networks



IF IN DOUBT - ASK!
PHONE 0800 056 5866
EMERGENCY - If you damage a cable or line
Phone 0800 783 8838
(24hrs) URGENTLY

ALWAYS LOOK UP BEFORE YOU START WORK
Refer to HSE
Guidance note GS6

Maps produced at 1:2500 scale are Geo-Schematics which show LV mains cables and overhead lines (in some cases all voltages). Prior to carrying out excavations you must refer to the 1:500 records to determine the location of all known underground plant and equipment.

Reproduced by permission of Ordnance Survey on behalf of HMSO. © Crown copyright and database rights 2023. All rights reserved. Ordnance Survey Licence numbers 100019626, 100019826 and 100019450. Data has been added to the Ordnance Survey base map; all proprietary rights in such additional data are and shall remain the exclusive property of © London Power Networks plc or Eastern Power Networks plc or South Eastern Power Networks plc each being a distribution licensee under section 6(1)(c) of the Electricity Act 1989 for the relevant distribution services area as that term is defined in such licensee's distribution licence. All rights in such data reserved.

Plans generated by DigSAFE Pro™ software provided by LinesearchbeforeUdig.

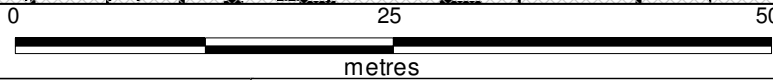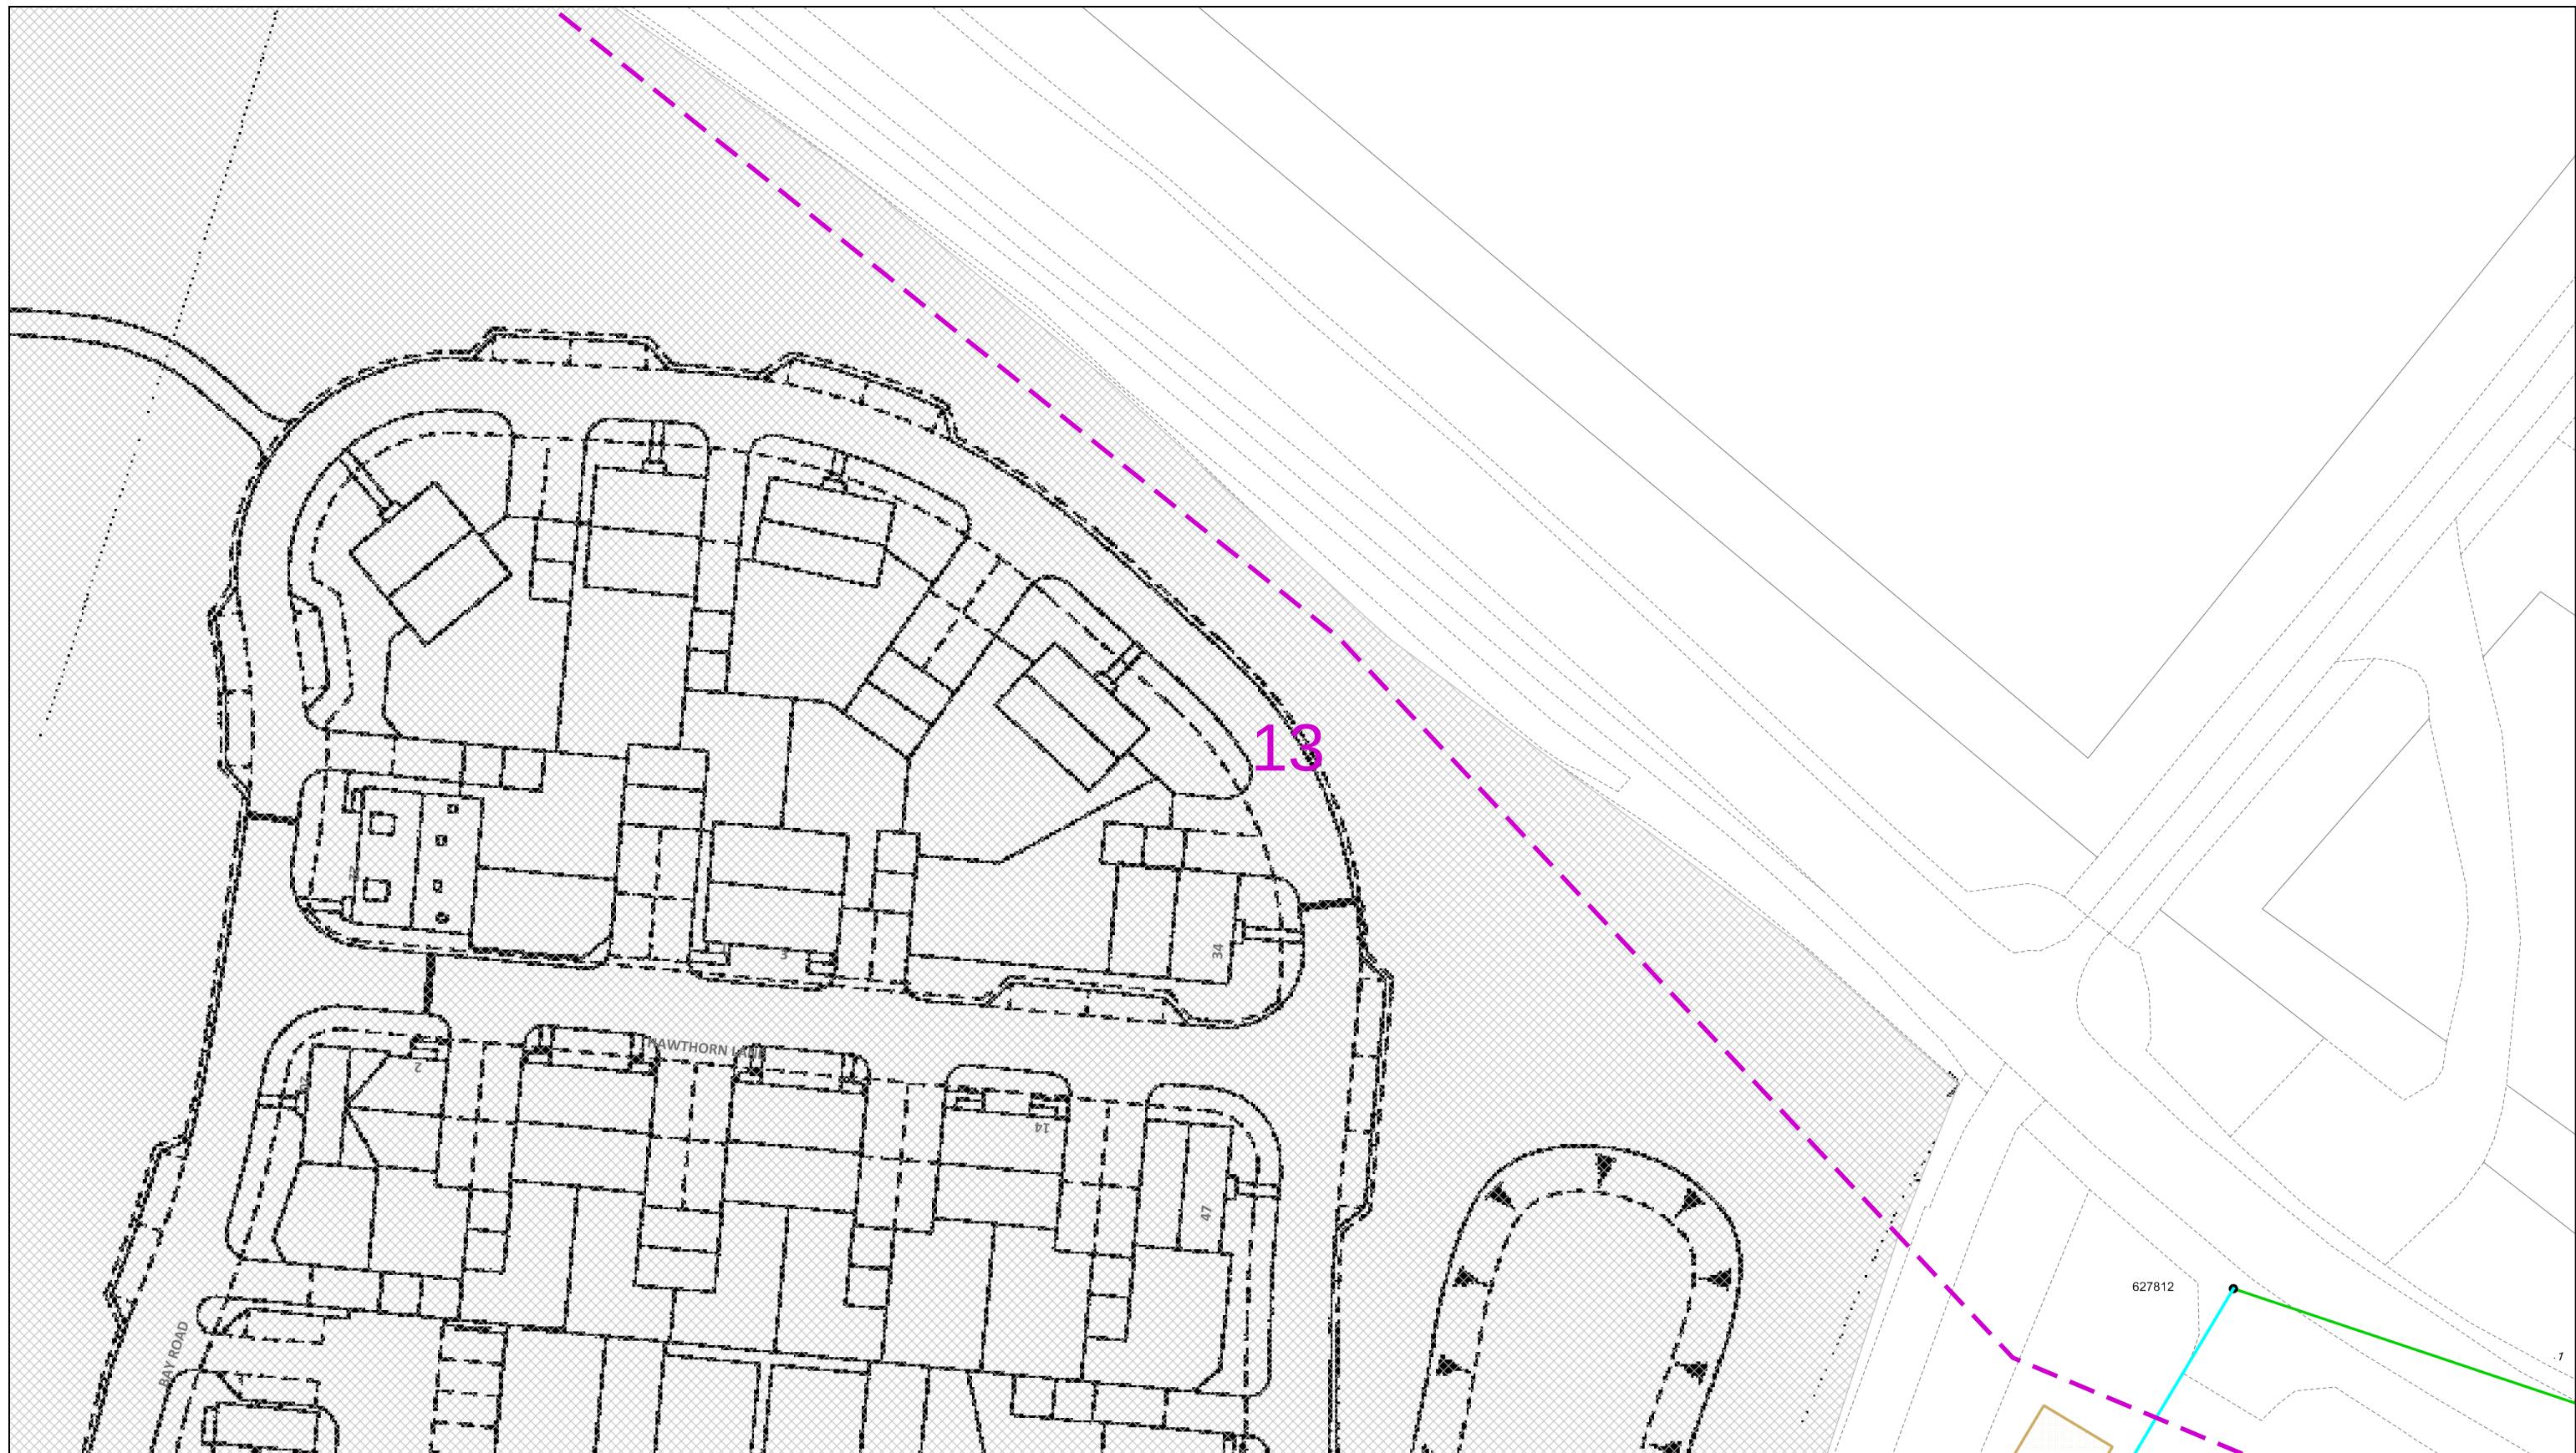

Dig Sites Area: Line:

The quality and accuracy of any print will depend on your printer, your computer and its print settings. Measurements scaled from this plan may not match measurements between the same points on the ground.

This plan must be used with
the attached 'Symbols'
document.

Date Requested: 19/05/2025
Job Reference: 37324868
Site Location: 534993 124590
Requested by:
Mr Duncan Phillips
Your Scheme/Reference: Gladman

Scale: 1:500 (When plotted at A3)

1. The position of the apparatus shown on this drawing is believed to be correct but the original landmarks may have been altered since the apparatus was installed.
2. The exact position of the apparatus should be verified - use approved cable avoidance tools prior to excavation using suitable hand tools.
3. It is essential that trial holes are carefully made avoiding the use of mechanical tools or picks until the exact location of all the cables have been determined.
4. It must be assumed that there is a service cable into each property, lamp column and street sign, etc.
5. All cables must be treated as being live unless proved otherwise by UK Power Networks.
6. The information proved must be given to all people working near UK Power Networks plant and equipment. Do not use plans more than 3 months after the issue date for excavation purposes.
7. Please be aware that electric cables/lines belonging to other owners of licensed electricity distribution systems may be present and it is your responsibility to identify their location.


1. UK Power Networks does not warrant that the information provided to you is correct. You rely upon it at your own risk.
2. UK Power Networks does not exclude or limit its liability if it causes the death of any persons or causes personal injury to a person.
3. Subject to paragraph 2 UK Power Networks has no liability to you in contract, in tort (including negligence), for breach of statutory duty or otherwise for any loss, damage, cost, claims, demands, or expenses that you or any third party may suffer or incur as a result of using the information provided whether for physical damage to property or for any economic loss (including without limitation loss of profit, loss of opportunity, loss of savings, loss of goodwill, loss of business, loss of use) or any special or consequential loss or damage whatsoever.
4. This plan has been provided to you on the basis of the terms of use set out in the covering letter that accompanies this plan. If you do not accept and/or do not understand the terms of use set out in the covering letter you must not use the plan and must return it to the sender of the letter.
5. You are responsible for the security of the information provided to you. It must not be given, sold or made available upon payment of a fee to a third party.



ALWAYS LOOK UP
BEFORE
YOU START WORK
Refer to HSE
Guidance note GS6

IF IN DOUBT - ASK!
PHONE 0800 056 5866
EMERGENCY - If you
damage a cable or line
Phone 0800 783 8838
(24hrs) URGENTLY


Maps produced at 1:2500 scale are Geo-Schematics which show LV mains cables and overhead lines (in some cases all voltages). Prior to carrying out excavations you must refer to the 1:500 records to determine the location of all known underground plant and equipment.

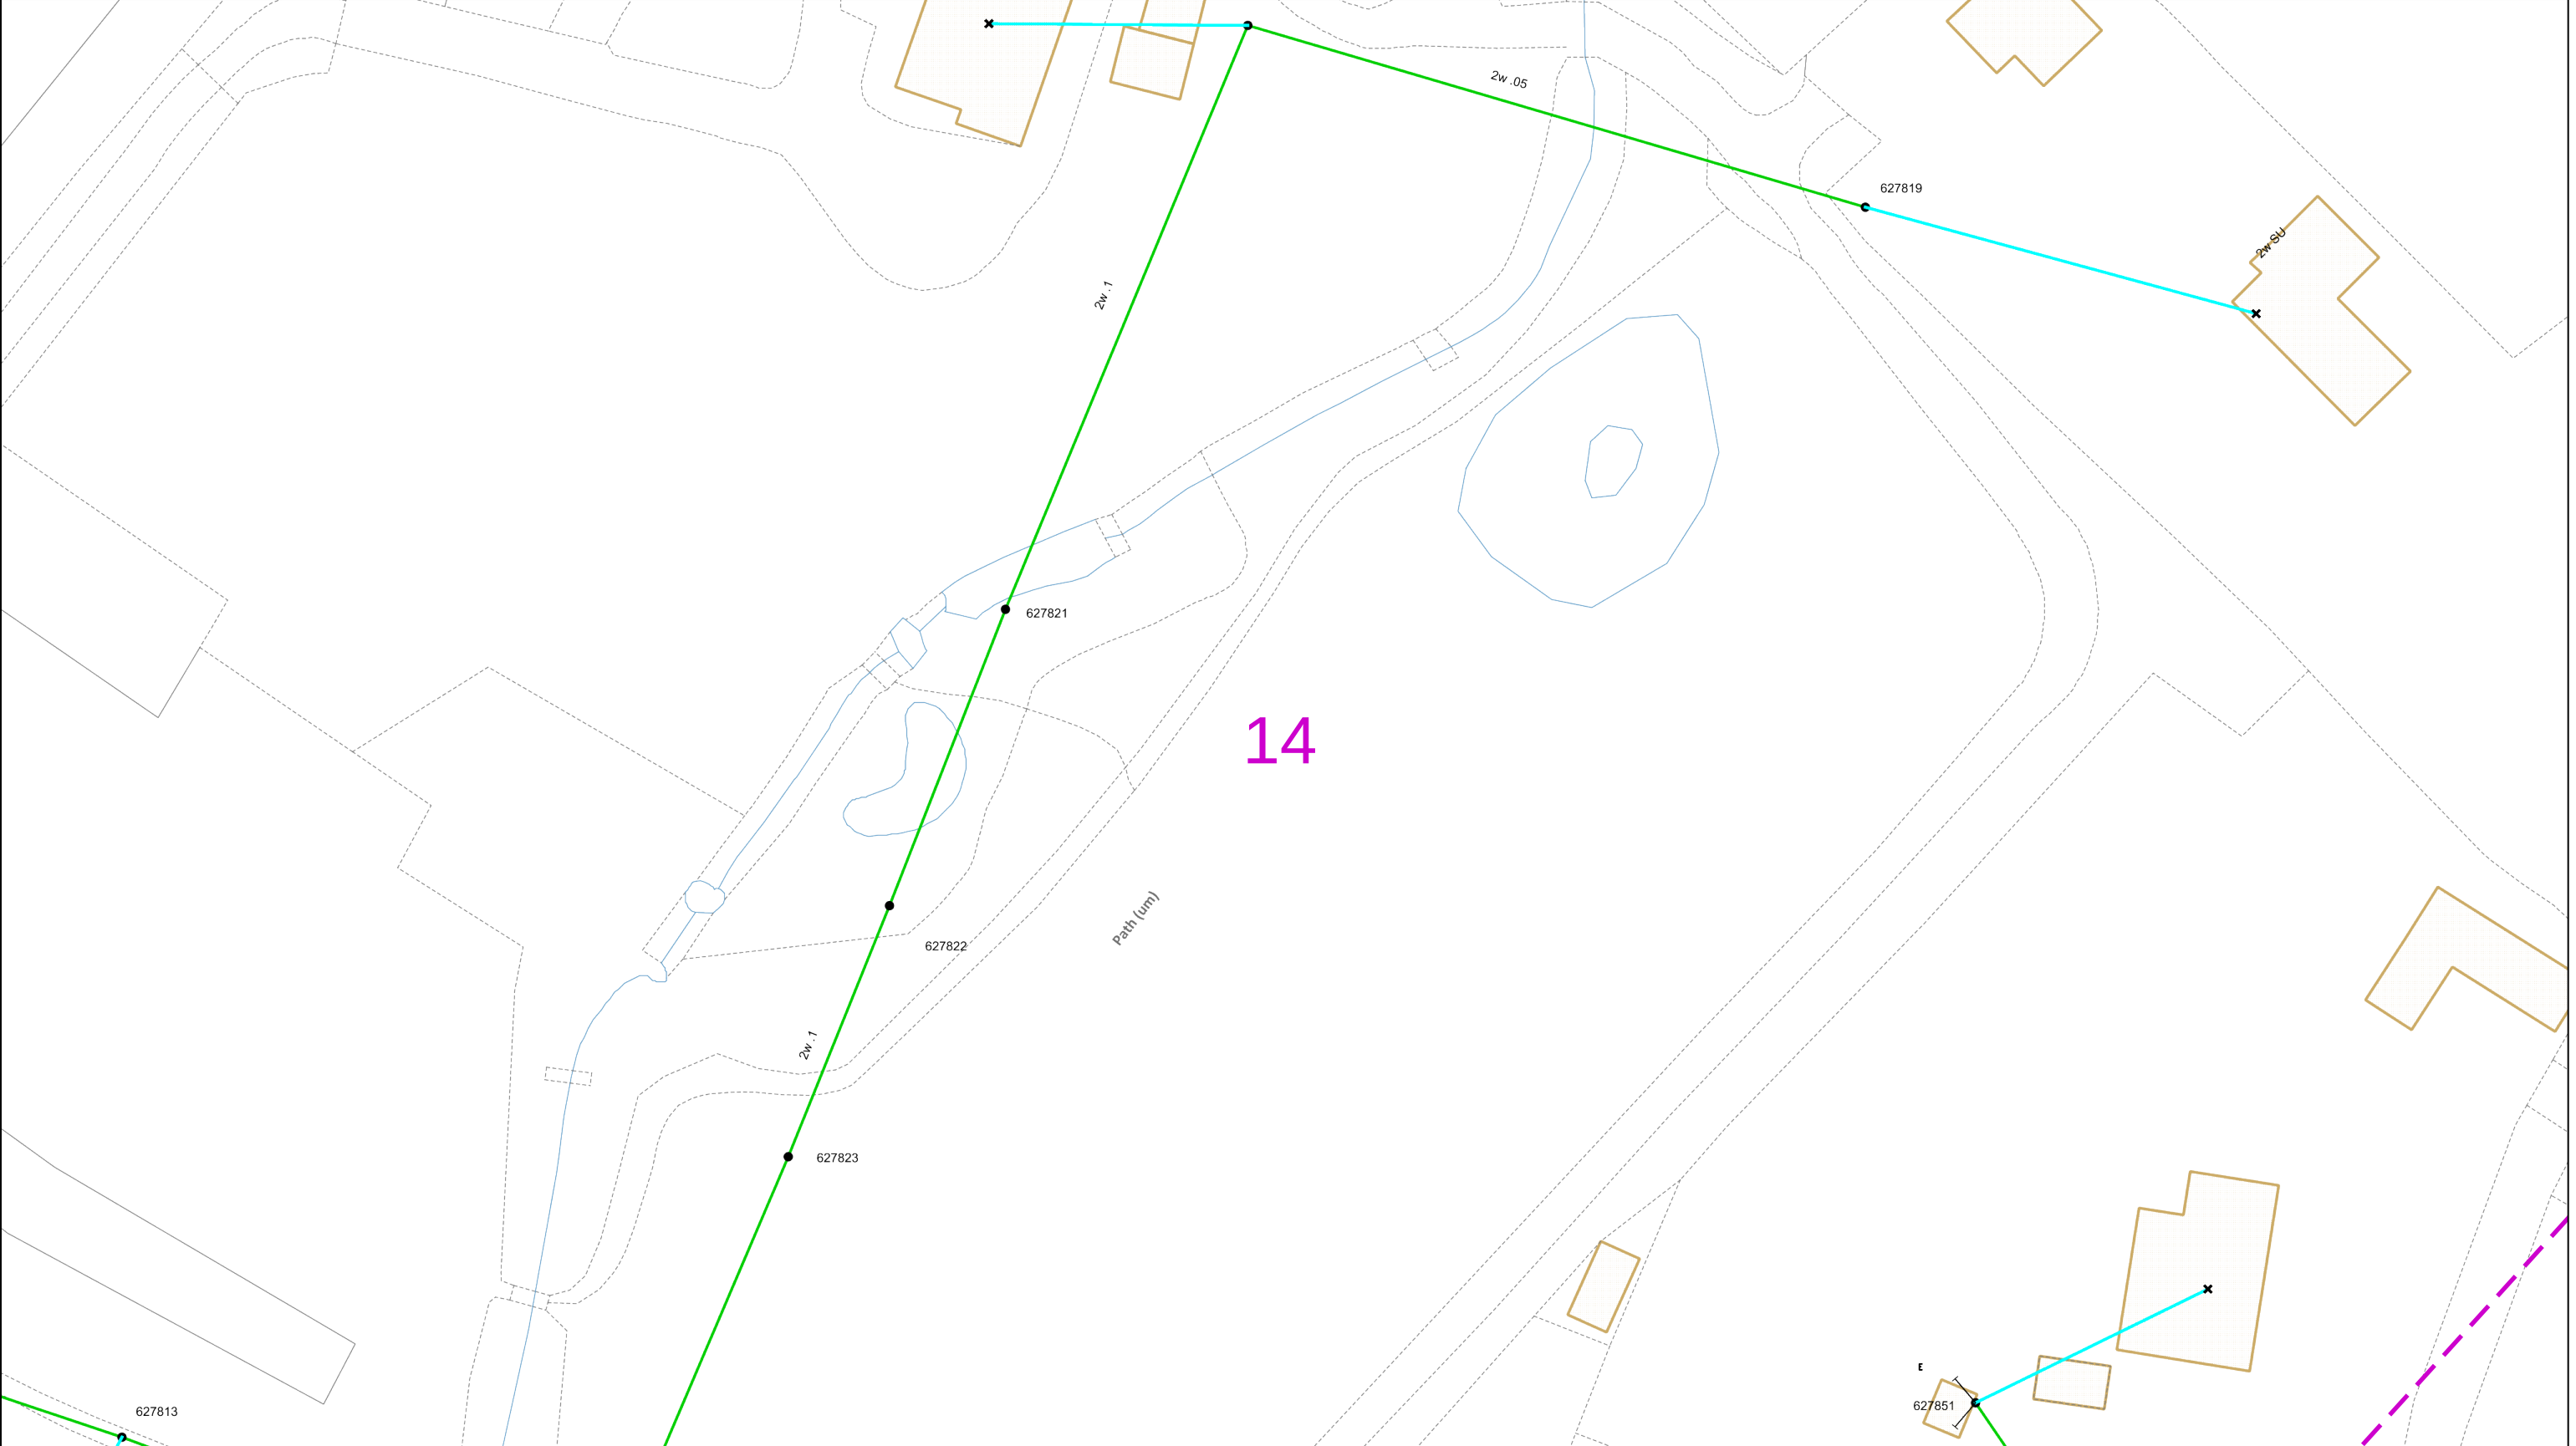

0 25 50 metres		Dig Sites Area: Line: The quality and accuracy of any print will depend on your printer, your computer and its print settings. Measurements scaled from this plan may not match measurements between the same points on the ground.									
This plan must be used with the attached ‘Symbols’ document.		1. The position of the apparatus shown on this drawing is believed to be correct but the original landmarks may have been altered since the apparatus was installed. 2. The exact position of the apparatus should be verified - use approved cable avoidance tools prior to excavation using suitable hand tools. 3. It is essential that trial holes are carefully made avoiding the use of mechanical tools or picks until the exact location of all the cables have been determined. 4. It must be assumed that there is a service cable into each property, lamp column and street sign, etc. 5. All cables must be treated as being live unless proved otherwise by UK Power Networks. 6. The information proved must be given to all people working near UK Power Networks plant and equipment. Do not use plans more than 3 months after the issue date for excavation purposes. 7. Please be aware that electric cables/lines belonging to other owners of licensed electricity distribution systems may be present and it is your responsibility to identify their location.		1. UK Power Networks does not warrant that the information provided to you is correct. You rely upon it at your own risk. 2. UK Power Networks does not exclude or limit its liability if it causes the death of any persons or causes personal injury to a person. 3. Subject to paragraph 2 UK Power Networks has no liability to you in contract, in tort (including negligence), for breach of statutory duty or otherwise for any loss, damage, cost, claims, demands, or expenses that you or any third party may suffer or incur as a result of using the information provided whether for physical damage to property or for any economic loss (including without limitation loss of profit, loss of opportunity, loss of savings, loss of goodwill, loss of business, loss of use) or any special or consequential loss or damage whatsoever. 4. This plan has been provided to you on the basis of the terms of use set out in the covering letter that accompanies this plan. If you do not accept and/or do not understand the terms of use set out in the covering letter you must not use the plan and must return it to the sender of the letter. 5. You are responsible for the security of the information provided to you. It must not be given, sold or made available upon payment of a fee to a third party.		IF IN DOUBT - ASK! PHONE 0800 056 5866 EMERGENCY - If you damage a cable or line Phone 0800 783 8838 (24hrs) URGENTLY				ALWAYS LOOK UP BEFORE YOU START WORK Refer to HSE Guidance note GS6	
Date Requested: 19/05/2025 Job Reference: 37324868 Site Location: 534993 124590 Requested by: Mr Duncan Phillips Your Scheme/Reference: Gladman Scale: 1:500 (When plotted at A3)						Maps produced at 1:2500 scale are Geo-Schematics which show LV mains cables and overhead lines (in some cases all voltages). Prior to carrying out excavations you must refer to the 1:500 records to determine the location of all known underground plant and equipment.					

Reproduced by permission of Ordnance Survey on behalf of HMSO. © Crown copyright and database rights 2023. All rights reserved. Ordnance Survey Licence numbers 100019626, 100019826 and 100019450. Data has been added to the Ordnance Survey base map; all proprietary rights in such additional data are and shall remain the exclusive property of © London Power Networks plc or Eastern Power Networks plc or South Eastern Power Networks plc each being a distribution licensee under section 6(1)(c) of the Electricity Act 1989 for the relevant distribution services area as that term is defined in such licensee’s distribution licence. All rights in such data reserved.

Plans generated by DigSAFE Pro™ software provided by LinesearchbeforeUdig.

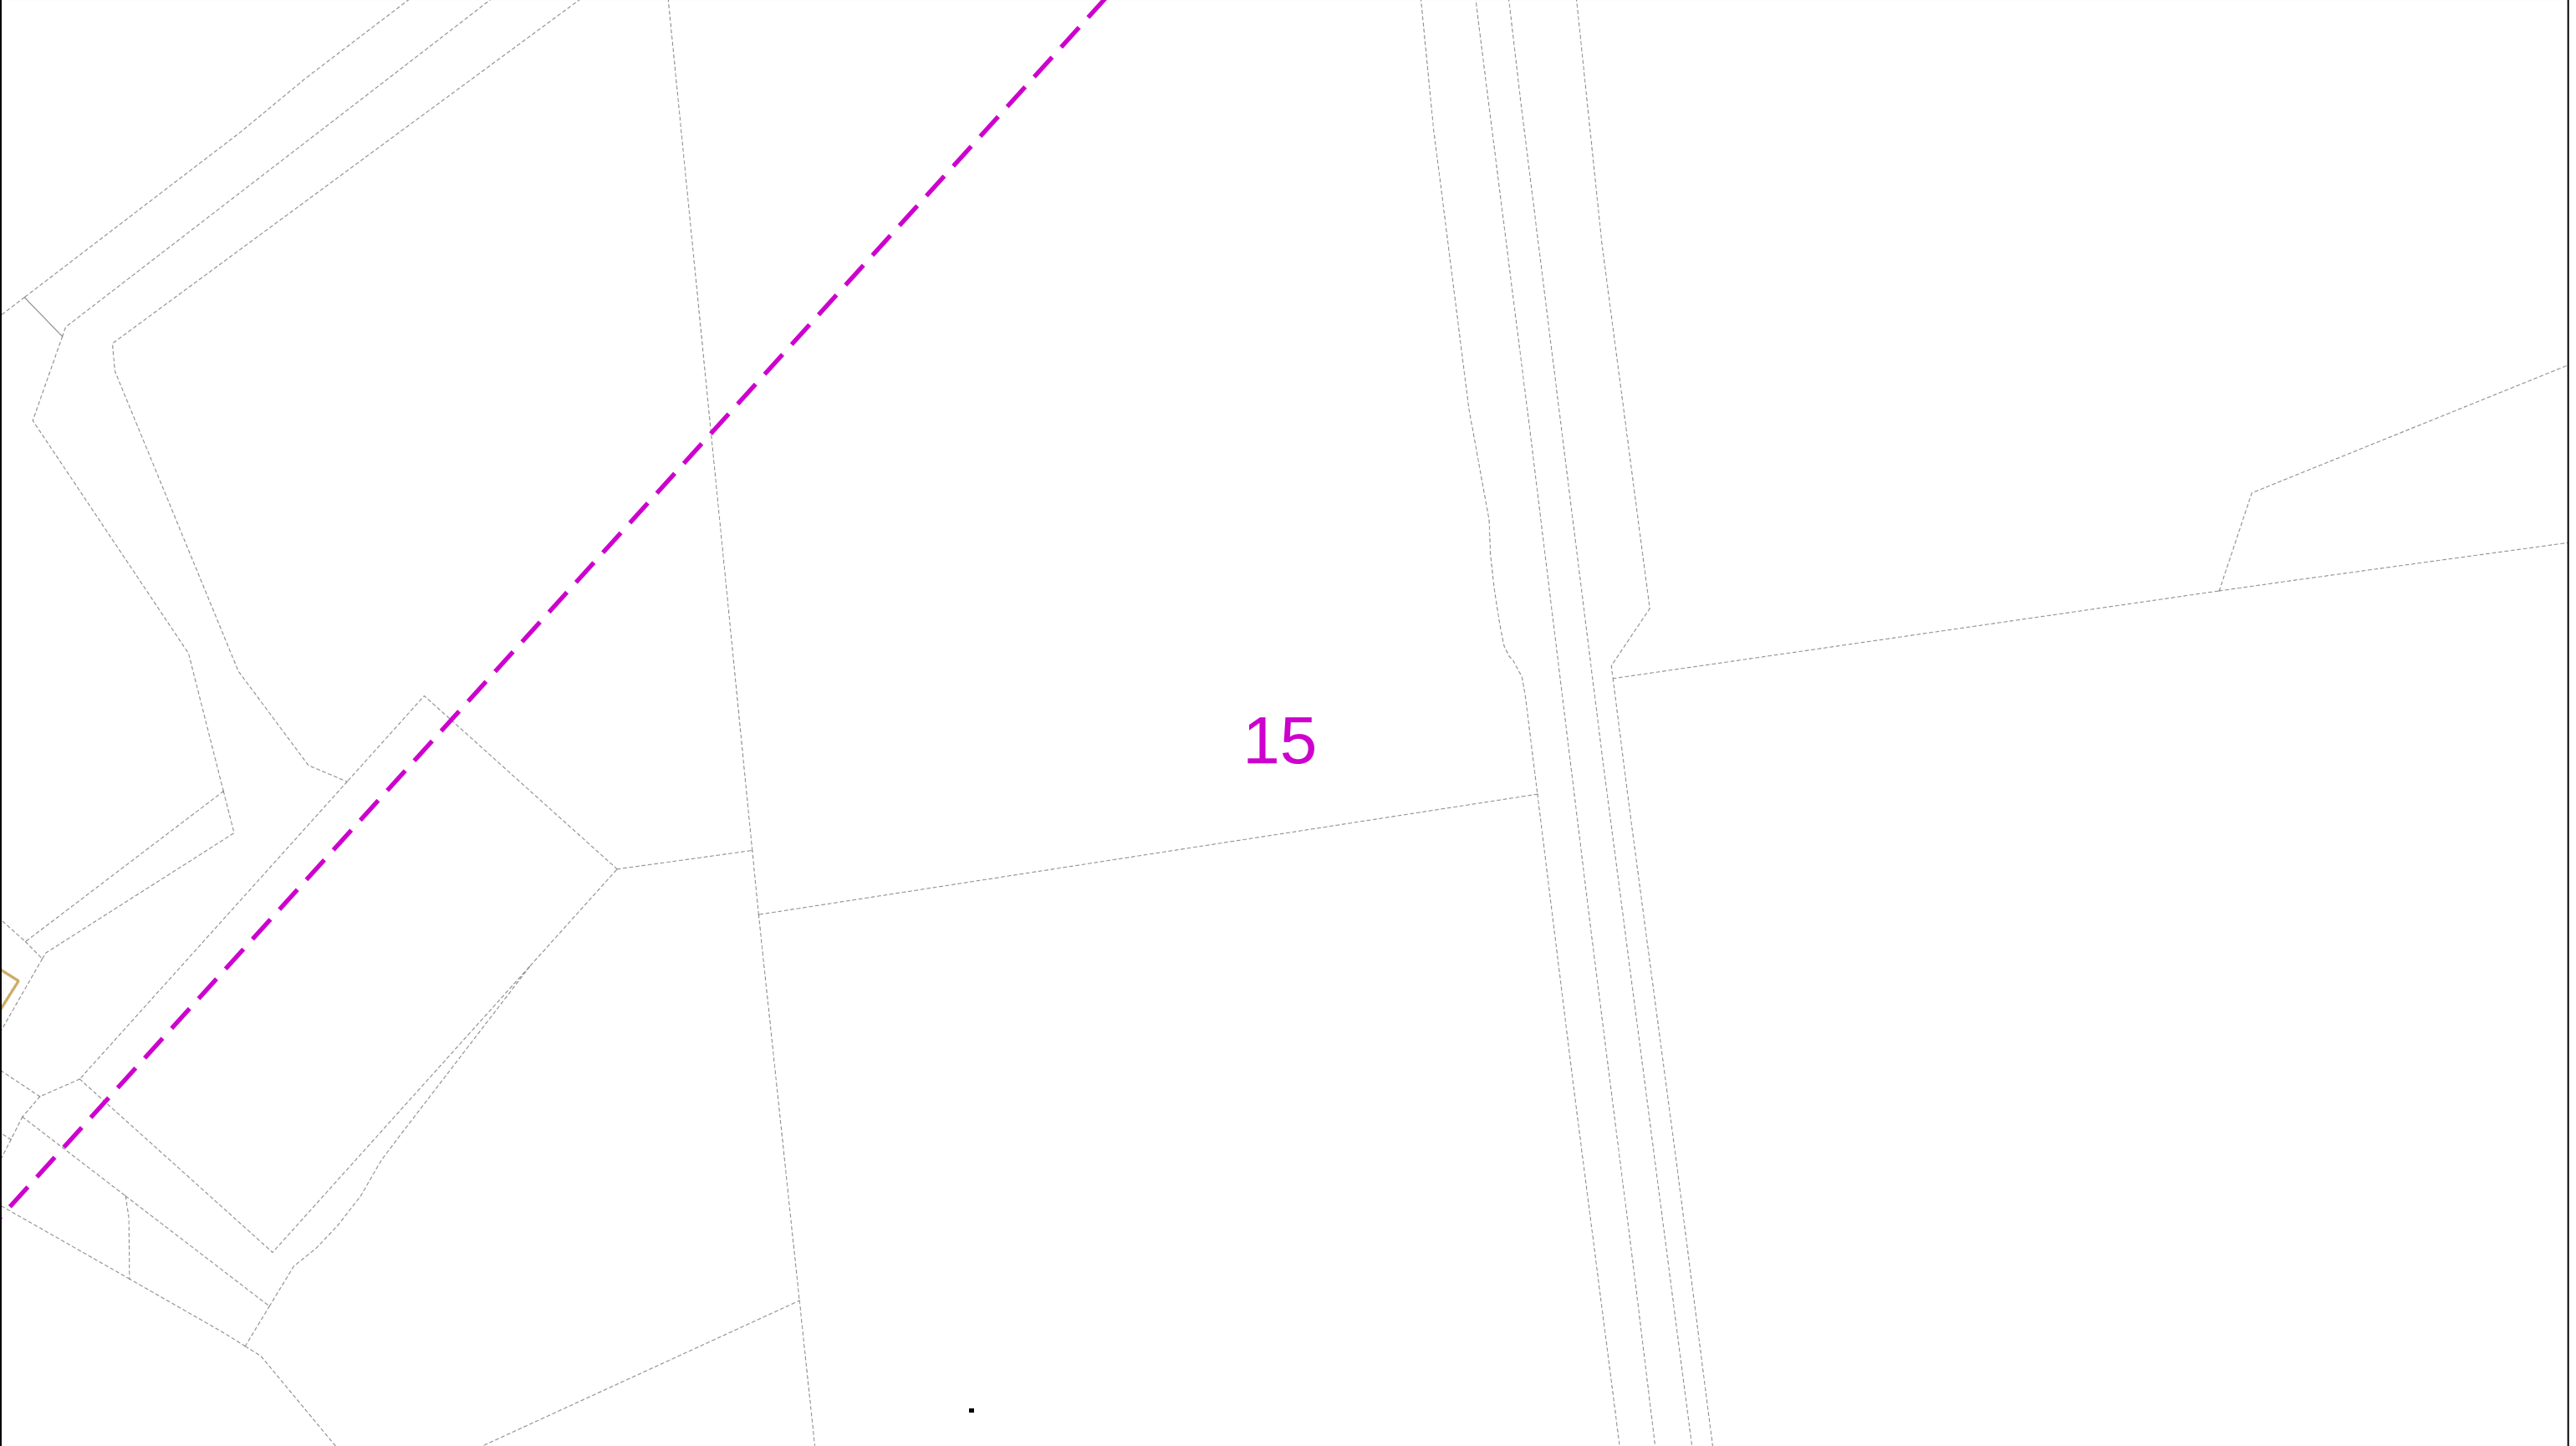

02550metres

Dig SitesArea: [dashed magenta box] Line: [dashed magenta line]

This plan must be used with the attached ‘Symbols’ document.

Date Requested: 19/05/2025Job Reference: 37324868Site Location: 534993 124590Requested by: Mr Duncan PhillipsYour Scheme/Reference: Gladman

Scale: 1:500 (When plotted at A3)

1. The position of the apparatus shown on this drawing is believed to be correct but the original landmarks may have been altered since the apparatus was installed.

2. The exact position of the apparatus should be verified - use approved cable avoidance tools prior to excavation using suitable hand tools.

3. It is essential that trial holes are carefully made avoiding the use of mechanical tools or picks until the exact location of all the cables have been determined.

4. It must be assumed that there is a service cable into each property, lamp column and street sign, etc.

5. All cables must be treated as being live unless proved otherwise by UK Power Networks.

6. The information proved must be given to all people working near UK Power Networks plant and equipment. Do not use plans more than 3 months after the issue date for excavation purposes.

7. Please be aware that electric cables/lines belonging to other owners of licensed electricity distribution systems may be present and it is your responsibility to identify their location.

1. UK Power Networks does not warrant that the information provided to you is correct. You rely upon it at your own risk.

2. UK Power Networks does not exclude or limit its liability if it causes the death of any persons or causes personal injury to a person.

3. Subject to paragraph 2 UK Power Networks has no liability to you in contract, in tort (including negligence), for breach of statutory duty or otherwise for any loss, damage, cost, claims, demands, or expenses that you or any third party may suffer or incur as a result of using the information provided whether for physical damage to property or for any economic loss (including without limitation loss of profit, loss of opportunity, loss of savings, loss of goodwill, loss of business, loss of use) or any special or consequential loss or damage whatsoever.

4. This plan has been provided to you on the basis of the terms of use set out in the covering letter that accompanies this plan. If you do not accept and/or do not understand the terms of use set out in the covering letter you must not use the plan and must return it to the sender of the letter.

5. You are responsible for the security of the information provided to you. It must not be given, sold or made available upon payment of a fee to a third party.

UK Power Networks

IF IN DOUBT - ASK!PHONE 0800 056 5866EMERGENCY - If you damage a cable or linePhone 0800 783 8838 (24hrs) URGENTLY

ALWAYS LOOK UP BEFORE YOU START WORKRefer to HSE Guidance note GS6

Maps produced at 1:2500 scale are Geo-Schematics which show LV mains cables and overhead lines (in some cases all voltages). Prior to carrying out excavations you must refer to the 1:500 records to determine the location of all known underground plant and equipment.

Reproduced by permission of Ordnance Survey on behalf of HMSO. © Crown copyright and database rights 2023. All rights reserved. Ordnance Survey Licence numbers 100019626, 100019826 and 100019450. Data has been added to the Ordnance Survey base map; all proprietary rights in such additional data are and shall remain the exclusive property of © London Power Networks plc or Eastern Power Networks plc or South Eastern Power Networks plc each being a distribution licensee under section 6(1)(c) of the Electricity Act 1989 for the relevant distribution services area as that term is defined in such licensee’s distribution licence. All rights in such data reserved.

Plans generated by DigSAFE Pro™ software provided by LinesearchbeforeUdig.