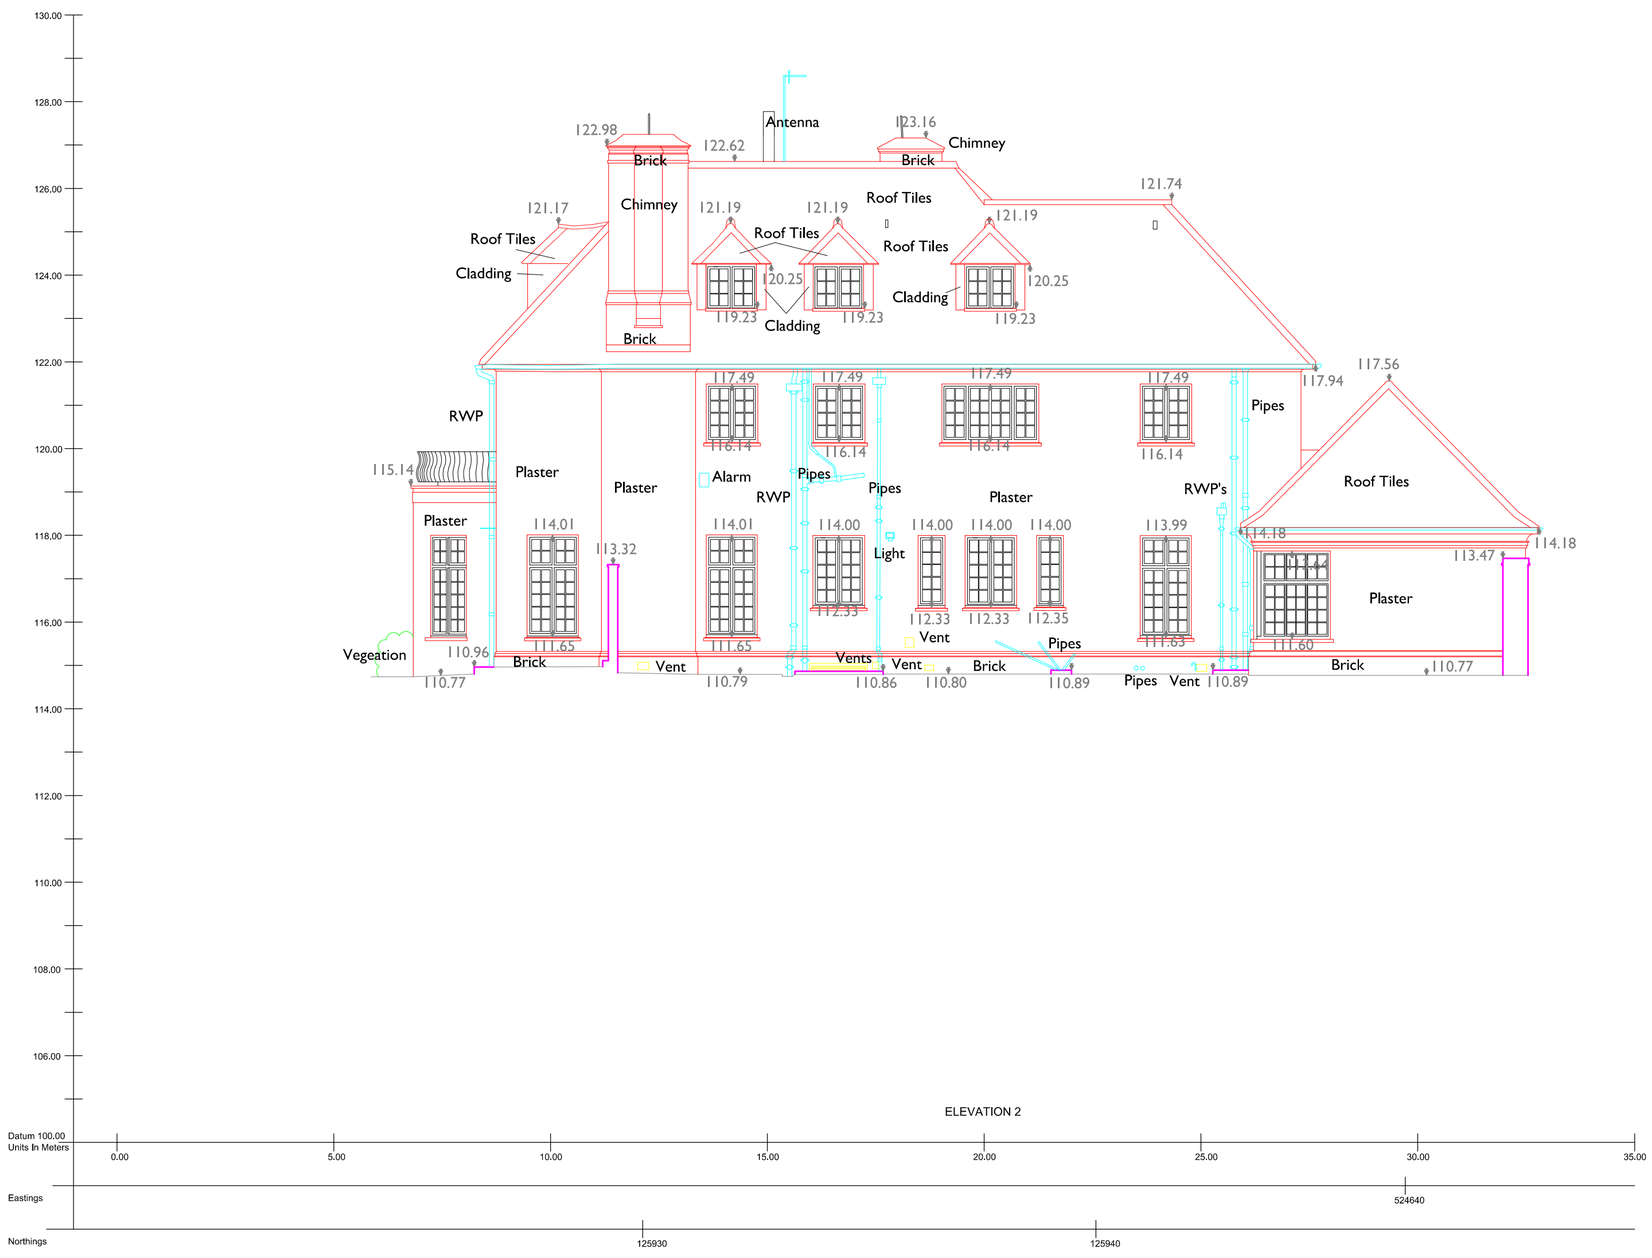


LEGEND

MBS Linework Features

- Air-Con Unit (ACU)
- Barrier
- Beam Line
- Bench
- Bin
- Building Facade
- Building
- Cable Trough
- Canopy
- Ceiling Line
- Column
- Column Bottom Line
- Column Top Line
- Concrete Base/Slab
- Door
- Duct
- Electric Box (EBOX)
- Fence
- Fixture
- Footpath
- Grating
- Grid Line
- Hand Rail
- Hedge
- Kerb Bottom
- Kerb Drop
- Kerb Top
- Land Drain
- Lift
- Opening - Slab
- Overhang
- Parapet
- Partition
- Pipe Line
- Plinth
- Ramp
- Road Edge
- Roof
- Sanitary
- Service
- Sky Light
- Slope Bottom
- Slope Top
- Slot Drain
- Steel Cladding
- Steel Structure
- Step Line
- Surface Change
- Tank
- Telephone Box (TB)
- Top of Fence Line
- Top of Wall Line
- Track
- Trial Pit
- Vegetation Line
- Vent
- Verge Line
- Wall Line
- Window
- Window Glazing

MBS Point Features

- Apex Building
- Arched Ceiling
- Bath
- Bollard
- Bolt
- Borehole
- Bush
- CCTV Camera
- Ceiling Elevation
- Ceiling Height
- Ceiling Height (False)
- Door
- Door - Sliding
- Earth Rod
- Eave
- Electrical Pole
- Floor Level
- Gate
- Gully
- Gully Round
- Inspection Cover
- IC - Round
- Invert Level
- Lamp Post
- Manhole
- MH - Round
- Marker Post
- Microwave Dish
- Pipe - Down
- Pole
- Post
- Radiator
- Road Sign
- Rodding Eye
- Shower
- Sign (General)
- Sink
- Sink - Kitchen
- Sky Light
- Soffit Level
- Spot Height
- Stop Cock
- Telegraph Pole
- Toilet
- Top of Fence Level
- Top of Tree Level
- Top of Wall Level
- Tree (TX.XX SX.XX) T=Trunk Radius(m) S=Spread Radius(m)
- Tree Trunk
- Urinal
- Valve General
- Window
- Window Sash

Special Features

- Datum Point
- Photo Point
- Panoramic Photo Point
- Survey Station
- Scan Target

MBS Abbreviations

AH	Arch Height	FLT	Floodlight
AL	Arch Level	F-C	Floor to Cill Height
ASH	Arch Spring Height	H	Height
ASL	Arch Spring Level	HR	Handrail
BGP	Break Glass Point	L	Light
BH	Beam Height	MAX	Maximum
BSL	Beam Soffit Level	MIN	Minimum
C-H	Cill to Head Height	O/H	Overhead
CONC	Concrete	OSBM	OS Bench Mark
CUP	Cupboard	RAD	Radiator
DH	Door Height	RSJ	Rolled Steel Joist
DRC	Drainage Channel	RWP	Rain Water Pipe
ESG	Electrical Switchgear	SBM	Site Bench Mark
FA	Fire Alarm	SH	Spring Height
FD	Fire Door	SL	Skylight
FE	Fire Extinguisher	V	Vent
FH	Fire Hydrant	VP	Vent Pipe
FHR	Fire Hose Reel	WH	Water Heater

Fence Types

B/W	Barbed Wire	C/L	Chain Link	O/B	Open Boarded
C/B	Close Boarded	H	Heras	P/W	Post and Wire
C/I	Corrugated Iron	I/R	Iron Railings	P/R	Post and Rail

Murphy Surveys Ltd. Disclaimer

The user or recipient of this survey data understands and acknowledges this data may be inaccurate or contain errors or omissions and the user or recipient assumes full responsibility for any risks or damages resulting from, arising from, or in connection with any use of, or reliance upon data displayed herein. Although significant care has been exercised to produce surveys that satisfy survey accuracy standards, these surveys are only as accurate as the source data from which they were compiled. Although all reasonable steps have been taken to locate all features visible at the time of the survey, there is no guarantee that all will be shown on the drawing, as some above ground features may have obstructed the survey. Wherever possible, areas unable to be surveyed will be labelled as "UTS".


The Company shall not be liable for any inaccuracy of the data provided beyond the specified scale or accuracy, or for any matters resulting from their use for purposes other than that stated in the Contract. No liability shall attach to the Surveyor in respect of any consequential loss or damages suffered by the Client.

The Client must promptly notify the Company of any errors in mapping of which it becomes aware. If misleading, inaccurate or otherwise inappropriate information is brought to the Company's attention or the Company itself identifies any such imprecision or error in a survey, it shall use its reasonable endeavours to fix or remove it and if necessary in certain instances, the Company being on notice of any such misleading, inaccurate or otherwise inappropriate information, it will re-conduct the survey and reproduce the data to within the specified scale or accuracy.

Revisions

Rev.	Description	Surveyed by	Drawn by	Checked by
A	First Issue	MZ - 04/09/17	PD - 20/09/17	TM - 20/09/17

Drawing Sheet Layout:

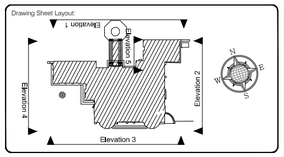

murphy SURVEYS
GLOBAL CONSULTING SURVEYORS
Topographic surveys, Measured Building Surveys, Setting-Out, As-Built Surveys, Hydrographic Surveys, Legal Mapping, Pipeline Surveys, Services Location, Ground Penetrating Radar, Laser Scanning, Rectified Photography
London Warrington Glasgow Belfast Cork Kildare
UK Head Office
9 Devonshire Square
London
EC2M 4YF
Phone: (+44) 020 3178 6644
Email:london@murphysurveys.co.uk
www.murphysurveys.co.uk

Client	Purcell UK
Project	Lydhurst Estate
Site Address	Warninglid, Haywards Heath, West Sussex RH17
Description	Elevation 2 - Building 7
Survey Grid	Localised OSGB36(15) - Scale Factor 1.0
Survey Datum	GNSS - Ordnance Datum Newlyn (ODN)
Drawing Scale	1:100 @ A2
Drawing Number	MSL21712-B7-E2

© Copyright 2017 MURPHY SURVEYS LTD