
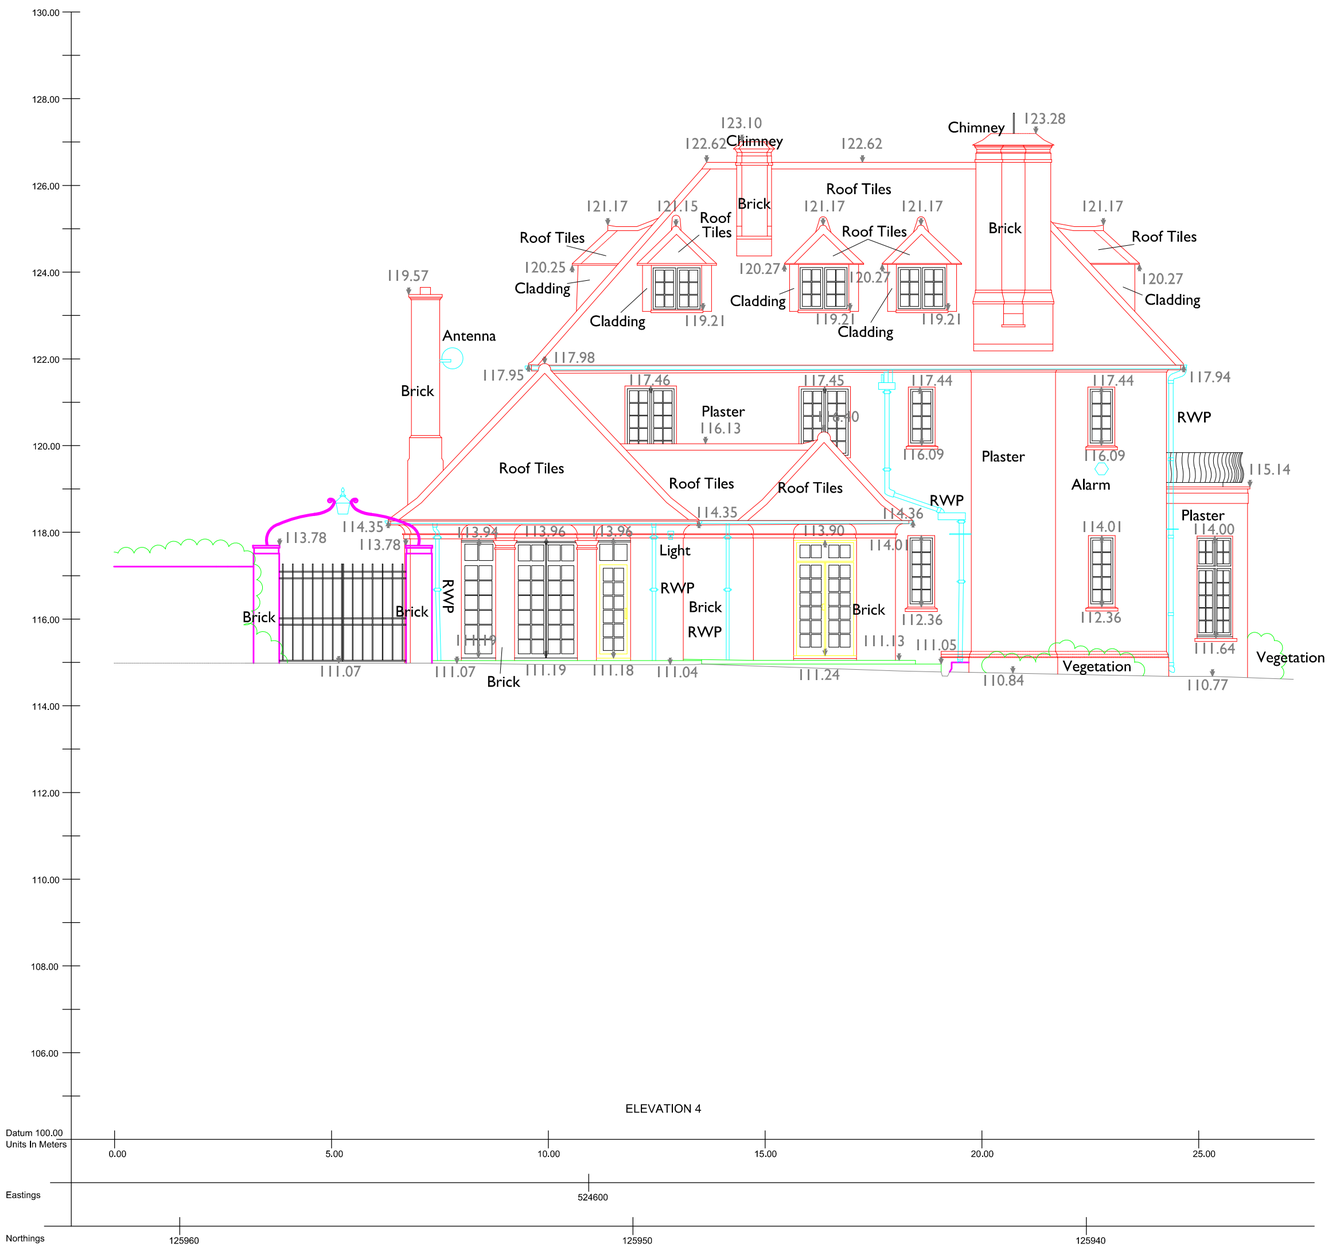


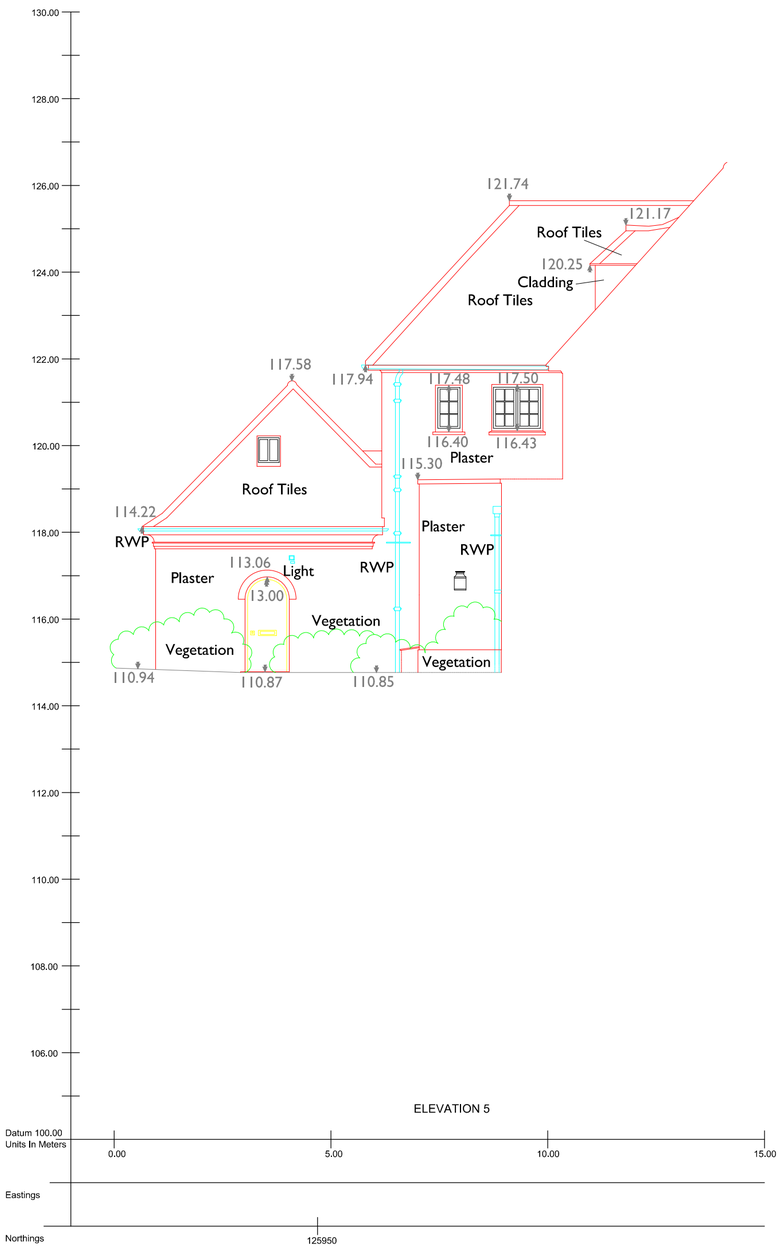

LEGEND

MBS Linework Features

Air-Con Unit (ACU)	Grating	Sky Light
Barrier	Grid Line	Slope Bottom
Beam Line	Hand Rail	Slope Top
Bench	Hedge	Slot Drain
Bin	Kerb Bottom	Steel Cladding
Building Facade	Kerb Drop	Steel Structure
Building	Kerb Top	Step Line
Cable Trough	Land Drain	Surface Change
Canopy	Lift	Tank
Ceiling Line	Opening - Slab	Telephone Box (TB)
Column	Overhang	Top of Fence Line
Column Bottom Line	Parapet	Top of Wall Line
Column Top Line	Partition	Track
Concrete Base/Slab	Pipe Line	Trial Pit
Door	Plinth	Vegetation Line
Duct	Ramp	Vent
Electric Box (EBOX)	Road Edge	Verge Line
Fence	Roof	Wall Line
Fixture	Sanitary	Window
Footpath	Service	Window Glazing

MBS Point Features

Apex Building	Gully	Shower
Arched Ceiling	Gully Round	Sign (General)
Bath	Inspection Cover	Sink
Bollard	IC - Round	Sink - Kitchen
Bolt	Invert Level	Sky Light
Borehole	Lamp Post	Soffit Level
Bush	Manhole	Spot Height
CCTV Camera	MH - Round	Stop Cock
Ceiling Elevation	Marker Post	Telegraph Pole
Ceiling Height	Microwave Dish	Toilet
Ceiling Height (False)	Pipe - Down	Top of Fence Level
Door	Pole	Top of Tree Level
Door - Sliding	Post	Top of Wall Level
Earth Rod	Radiator	Tree (TX.XX SX.XX) T=Trunk Radius(m) S=Spread Radius(m)
Eave	Road Sign	Tree Trunk
Electrical Pole	Rodding Eye	Urinal
Floor Level		Valve General
Gate		Window
		Window Sash

Special Features

Datum Point	Survey Station
Photo Point	
Panoramic Photo Point	Scan Target

MBS Abbreviations

AH	Arch Height	FLT	Floodlight
AL	Arch Level	F-C	Floor to Cill Height
ASH	Arch Spring Height	H	Height
ASL	Arch Spring Level	HR	Handrail
BSP	Break Glass Point	L	Light
BH	Beam Height	MAX	Maximum
BSL	Beam Soffit Level	MIN	Minimum
C-H	Cill to Head Height	O/H	Overhead
CONC	Concrete	OSBM	OS Bench Mark
CUP	Cupboard	RAD	Radiator
DH	Door Height	RSJ	Rolled Steel Joist
DRC	Drainage Channel	RWP	Rain Water Pipe
ESG	Electrical Switchgear	SBM	Site Bench Mark
FA	Fire Alarm	SH	Spring Height
FD	Fire Door	SL	Skylight
FE	Fire Extinguisher	V	Vent
FH	Fire Hydrant	VP	Vent Pipe
FHR	Fire Hose Reel	WH	Water Heater

Fence Types

B/W	Barbed Wire	C/L	Chain Link	O/B	Open Boarded
C/B	Close Boarded	H	Heras	P/W	Post and Wire
C/I	Corrugated Iron	I/R	Iron Railings	P/R	Post and Rail

Murphy Surveys Ltd. Disclaimer

The user or recipient of this survey data understands and acknowledges this data may be inaccurate or contain errors or omissions and the user or recipient assumes full responsibility for any risks or damages resulting from, arising from, or in connection with any use of, or reliance upon data displayed herein. Although significant care has been exercised to produce surveys that satisfy survey accuracy standards, these surveys are only as accurate as the source data from which they were compiled. Although all reasonable steps have been taken to locate all features visible at the time of the survey, there is no guarantee that all will be shown on the drawing, as some above ground features may have obstructed the survey. Wherever possible, areas unable to be surveyed will be labelled as "UTS".


The Company shall not be liable for any inaccuracy of the data provided beyond the specified scale or accuracy, or for any matters resulting from their use for purposes other than that stated in the Contract. No liability shall attach to the Surveyor in respect of any consequential loss or damages suffered by the Client.

The Client must promptly notify the Company of any errors in mapping of which it becomes aware. If misleading, inaccurate or otherwise inappropriate information is brought to the Company's attention or the Company itself identifies any such imprecision or error in a survey, it shall use its reasonable endeavours to fix or remove it and if necessary in certain instances, the Company being on notice of any such misleading, inaccurate or otherwise inappropriate information, it will re-conduct the survey and reproduce the data to within the specified scale or accuracy.

Revisions

Rev.	Description	Surveyed by	Drawn by	Checked by
A	First Issue	MZ - 04/09/17	PD - 20/09/17	TM - 20/09/17

Drawing Sheet Layout:

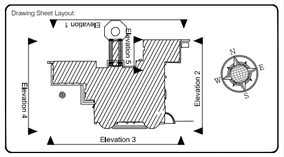

murphy SURVEYS
GLOBAL CONSULTING SURVEYORS

Topographic surveys, Measured Building Surveys, Setting-Out, As-Built Surveys, Hydrographic Surveys, Legal Mapping, Pipeline Surveys, Services Location, Ground Penetrating Radar, Laser Scanning, Rectified Photography

London Warrington Glasgow Belfast Cork Kildare

UK Head Office
9 Devonshire Square
London
EC2M 4YF

Phone: (+44) 020 3178 6644
Email:london@murphysurveys.co.uk

www.murphysurveys.co.uk

Client	Purcell UK
Project	Lydhurst Estate
Site Address	Warninglid, Haywards Heath, West Sussex RH17
Description	Elevations 4 & 5 - Building 7
Survey Grid	Localised OSGB36(15) - Scale Factor 1.0
Survey Datum	GNSS - Ordnance Datum Newlyn (ODN)
Drawing Scale	1:100 @ A2
Drawing Number	MSL21712-B7-E4_5

© Copyright 2017 MURPHY SURVEYS LTD