


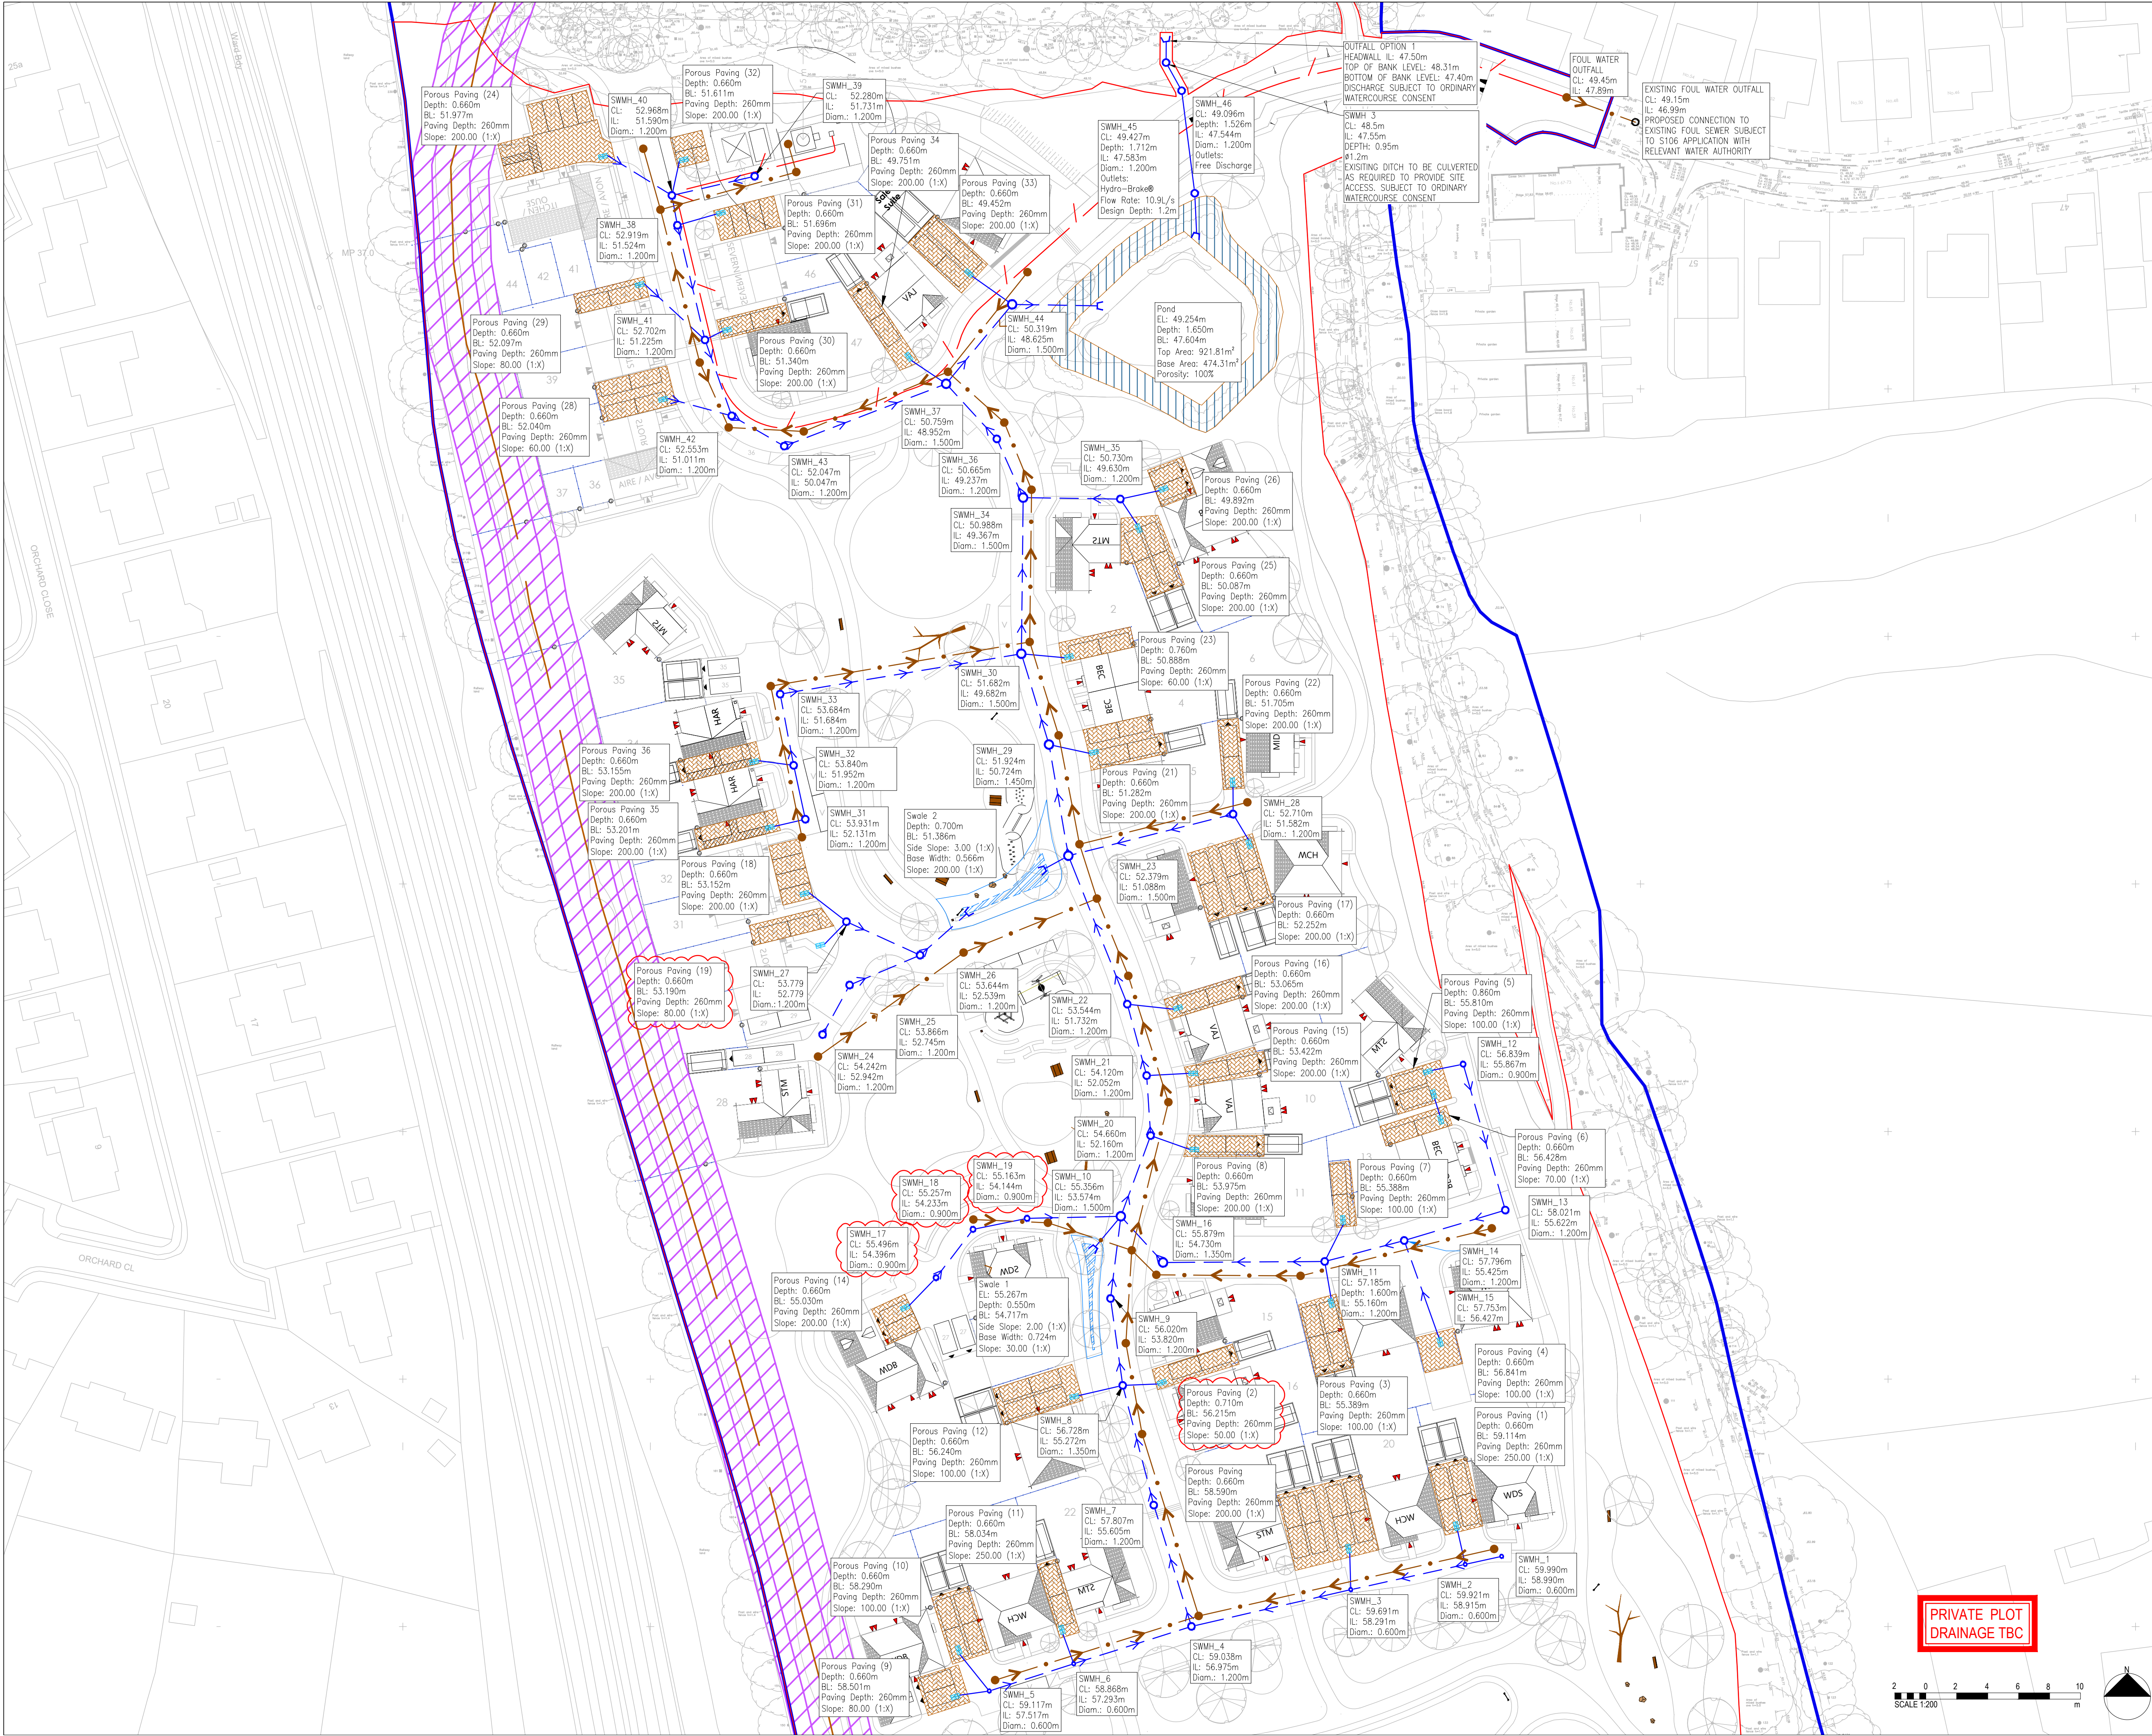

DISCLAIMER NOTES:

- THIS DOCUMENT IS COPYRIGHT OF THE ORIGINATOR AND MUST BE TREATED AS CONFIDENTIAL.
- THIS DOCUMENT MUST NOT BE ALTERED, REPRODUCED OR DISTRIBUTED WITHOUT PRIOR WRITTEN CONSENT OF THE ORIGINATOR
- THIS DOCUMENT MUST NOT BE ALTERED - THE ORIGINATOR ACCEPTS NO RESPONSIBILITY FOR ANY DISCREPANCIES ARISING AS A RESULT OF THE ORIGINATOR'S INFORMATION BEING ALTERED BY OTHERS
- ANY DISCREPANCY MUST BE REPORTED TO THE ORIGINATOR
- DO NOT SCALE THIS DOCUMENT - USE FIGURED DIMENSIONS ONLY
- ALL DIMENSIONS MUST BE CHECKED ON SITE PRIOR TO COMMENCEMENT OF ANY RELATED WORKS
- THIS DOCUMENT MUST BE READ IN CONJUNCTION WITH ALL SUPPORTING DOCUMENTS PRODUCED BY THE ORIGINATOR AND OTHER PROJECT DISCIPLINES
- THE ORIGINATOR ACCEPTS NO RESPONSIBILITY FOR THE ACCURACY OF BACKGROUND INFORMATION PRODUCED BY THIRD PARTIES - THIS MUST BE TREATED AS INDICATIVE ONLY
- USERS OF THIS DOCUMENT ARE RESPONSIBLE FOR CHECKING WHICH REVISION IS CURRENT
- THE DOCUMENT STATUS "INFORMATION" OR "PRELIMINARY" INDICATES THAT THIS DRAWING IS FOR REFERENCE PURPOSES ONLY - THE ORIGINATOR WILL ACCEPT NO RESPONSIBILITY FOR THE COMPLETENESS OF INFORMATION UNDER THIS STATUS
- THE DOCUMENT STATUS "RECORD" OR "AS BUILT" HAS BEEN PREPARED, IN PART, BASED UPON INFORMATION FURNISHED BY OTHERS. WHILE THIS INFORMATION IS BELIEVED TO BE RELIABLE, THE ORIGINATOR ASSUMES NO RESPONSIBILITY FOR THE ACCURACY OF THIS "RECORD" OR "AS BUILT" DOCUMENT OR FOR ANY ERRORS OR OMISSIONS THAT MAY HAVE BEEN INCORPORATED INTO IT AS A RESULT OF INCORRECT INFORMATION PROVIDED TO THE ORIGINATOR. THOSE RELYING ON THE "RECORD" OR "AS BUILT" DOCUMENT ARE ADVISED TO OBTAIN INDEPENDENT VERIFICATION OF ITS ACCURACY

DRAWING NOTES:

CDM REGULATIONS 2015
SIGNIFICANT OR NON-OBSVIOUS RISKS AND RISKS WHICH ARE DIFFICULT TO MANAGE ARE IDENTIFIED ON THIS DRAWING USING THE FOLLOWING SYMBOL IDENTIFIED TO THE RIGHT WITH BRIEF ACCOMPANYING TEXT. FOR FURTHER DETAILS OF THE RISKS IDENTIFIED BY DESIGNERS, REFERENCE SHOULD BE MADE TO CDM HAZARD REGISTER

EXTERNAL REFERENCES:
THIS INFORMATION & RIDGE & PARTNERS LLP CIVIL 3D & ASSOCIATED 3D OUTPUTS ARE BASED UPON THE FOLLOWING INFORMATION FROM THE DESIGN TEAM

LANDSCAPE REFERENCE:
• PAD DESIGN DRG No. 25714/33101 (DATED MARCH 2026)

SURVEY REFERENCE:
• HOOK SURVEYS LTD. DWG No. 525/1048801 - 06 (DATED JULY 2025)
IT IS THE RESPONSIBILITY OF THE CONTRACTOR TO VERIFY THIS INFORMATION IS CURRENT PRIOR TO CONSTRUCTION

LEGEND

- SITE BOUNDARY
- PROPOSED PRIVATE FOUL DRAIN
- PROPOSED PRIVATE S.W. DRAIN
- PROPOSED FOUL RISING MAIN
- EXISTING MANHOLE / GULLY
- PROPOSED 1200mm MANHOLE
- PROPOSED MANHOLE WITH BACKDROP
- PROPOSED PERMEABLE PAVING
- PROPOSED HEADWALL
- PROPOSED DIFFUSER UNIT

P04	IL, DEPTH, BL & PAVING DEPTH AMENDED	01.07.2026	JF	TC
P03	RED LINE BOUNDARY UPDATED	14.05.2026	SS	TC
P02	UPDATED TO LATEST ARCHITECTURAL PLAN	29.04.2026	SS	TC
P01	INITIAL ISSUE	10.04.2026	PJ	TC
REV	DESCRIPTION	DATE	BY	CHKD
ORIGINATOR: www.ridge.co.uk				



PROJECT NUMBER: 5029426

CLIENT: CREST NICHOLSON

IN ASSOCIATION WITH:

PROJECT: LAND WEST OF GATESMEAD

TITLE: DRAINAGE LAYOUT PLAN

DRAWN BY: SS CHECKED BY: APPROVED BY:

SCALE: 1:200 @ A1 DATE: 22/01/2026

STATUS: DESCRIPTION: SS FOR APPOINTING PARTY REVIEW & ACCEPTANCE

DRAWING No: 5029426-RDG-XX-XX-D-C-110500

PROJECT: ORG: FUNCTION: SPATIAL: FORM: DISCIPLINE: NUMBER: REV: 5029426 RDG XX D C 110500 P04