


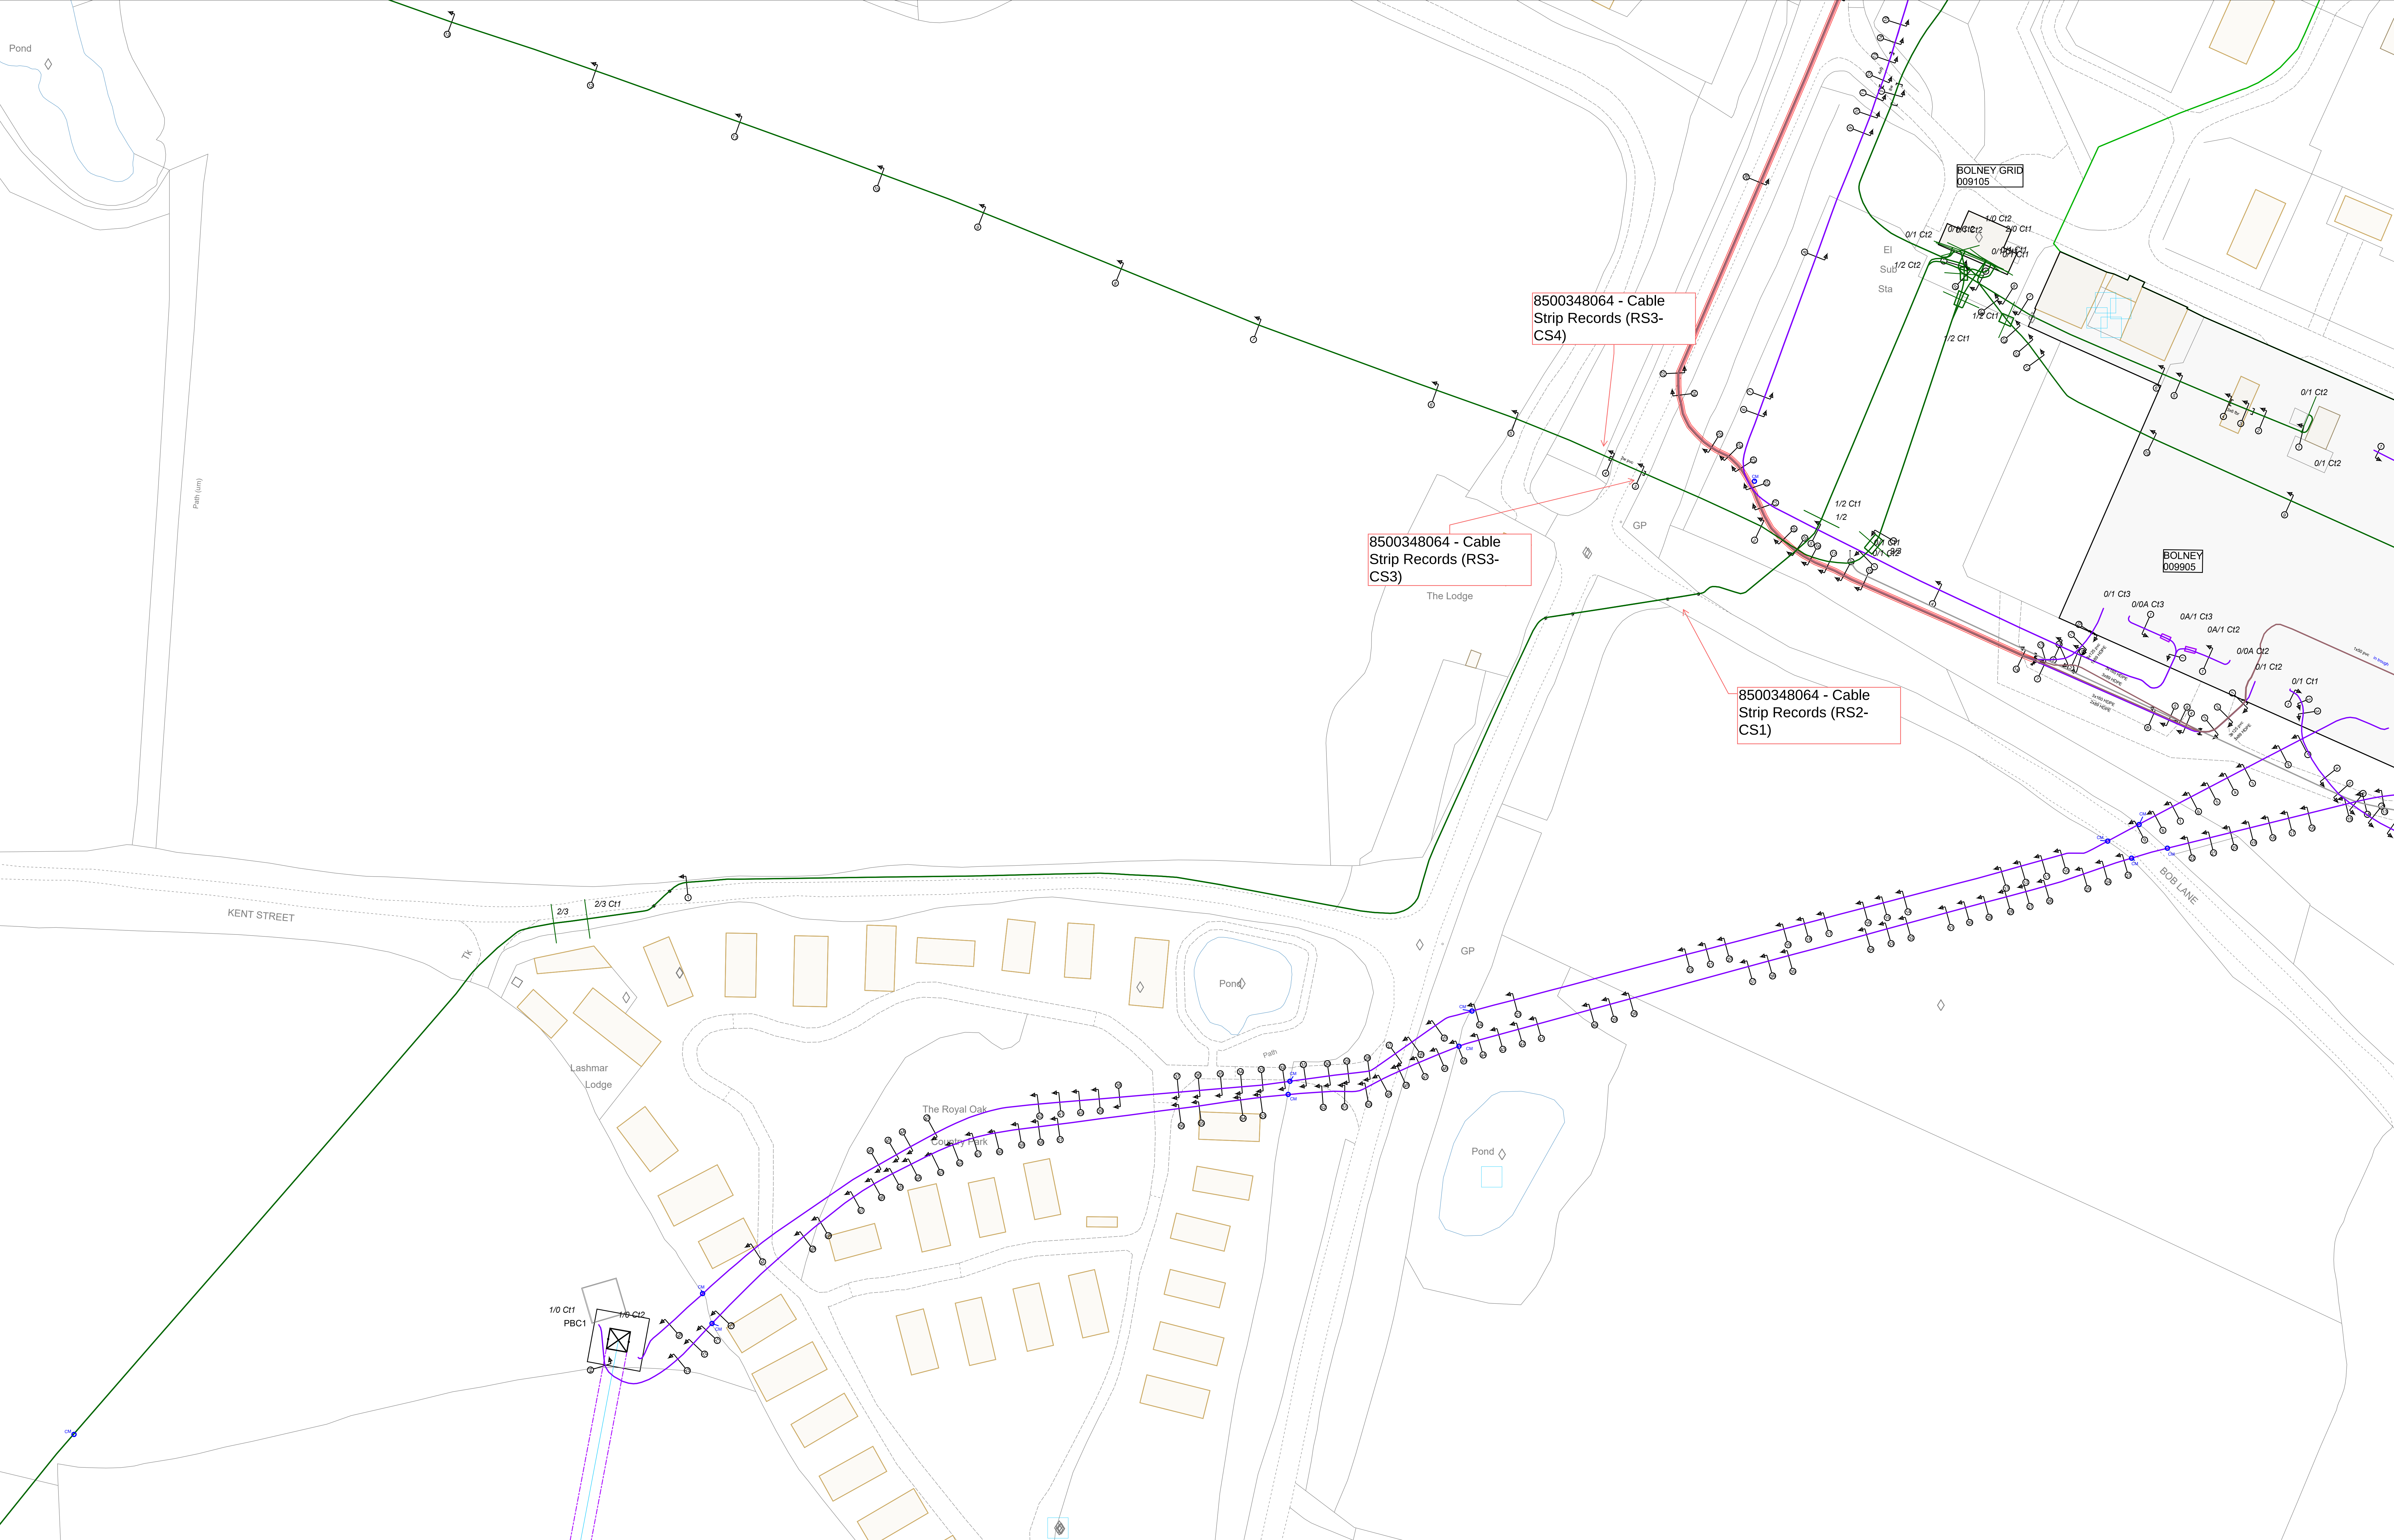

<table><tr><th>Description</th><th>Existing</th><th>Proposed</th></tr><tr><td>LV Cable or Line</td><td></td><td></td></tr><tr><td>HV Cable or Line</td><td></td><td></td></tr><tr><td>EHV Cable or Line</td><td></td><td></td></tr><tr><td>Approx. position</td><td></td><td></td></tr><tr><td>Ductline</td><td></td><td></td></tr><tr><td>Pole & Street Furniture</td><td></td><td></td></tr><tr><td>Substation & Link Box</td><td></td><td></td></tr></table>	Description	Existing	Proposed	LV Cable or Line			HV Cable or Line			EHV Cable or Line			Approx. position			Ductline			Pole & Street Furniture			Substation & Link Box			1. The position of the apparatus shown on this drawing is believed to be correct but the original landmarks may have been altered since the apparatus was installed. 2. The exact position of the apparatus should be verified - use approved cable avoidance tools prior to excavation using suitable hand tools. 3. It is essential that trial holes are carefully made avoiding the use of mechanical tools or picks until the exact location of all cables have been determined. 4. It must be assumed that each property and item of street furniture has an electricity supply. Service cables shown only where known. 5. All cables must be treated as being live unless proved otherwise by UK Power Networks. 6. The information provided must be given to all people working near UK Power Networks plant & equipment. Do not use plans more than 3 months after the issue date for excavation purposes. 7. Please be aware that electric cables/lines belonging to other owners of licensed electricity distribution systems may be present and it is your responsibility to identify their location.	1. UK Power Networks does not warrant that the information provided to you is correct. You rely upon it at your own risk. 2. UK Power Networks does not exclude or limit its liability if it causes the death of any person or causes personal injury to a person where such death or personal injury is caused by its negligence. 3. Subject to paragraph 2 UK Power Networks has no liability to you in contract, in tort (including negligence), for breach of statutory duty or otherwise for any loss, damage, cost, claims, demands, or expenses that you or any third party may suffer or incur as a result of using the information provided whether for physical damage to property or for any economic loss (including without limitation loss of profit, loss of opportunity, loss of savings, loss of goodwill, loss of business, loss of use) or any special or consequential loss or damage whatsoever. 4. This plan has been provided to you on the basis of the terms of use set out in the covering letter that accompanies this plan. If you do not accept and/or do not understand the terms of use set out in the covering letter you must not use the plan and you must return it to the sender of the letter. 5. You are responsible for the security of the information provided to you. It must not be given, sold or made available upon payment of a fee to a third party.	0m 10m 20m 30m 40m 50m 60m 70m 80m 90m 100m The quality and accuracy of any print will depend on your printer, your computer and its print settings. Measurements scaled from this plan may not match measurements between the same points on the ground. Maps produced at 1:2500 scale are LV Geo-Schematics which show LV mains cables and overhead lines (in some cases all voltages). Prior to carrying out excavations you must refer to the 1:500 records to determine the location of all known underground plant and equipment. Plan Provision CHECK IT OUT BEFORE YOU DIG IT OUT CALL 0800 056 5866 EMERGENCY? If you damage a cable or the Phone 0800 096 3766 (24hrs) URGENTLY ALWAYS LOOK UP BEFORE YOU START WORK. Refer to HSE Guidance note GS6 Grid Ref: TQ 23588 20885 Scale: 1:500 (When Plotted at A0) Plotted on: 13/10/2025 Plotted by: Daniel Dunstey
Description	Existing	Proposed																									
LV Cable or Line																											
HV Cable or Line																											
EHV Cable or Line																											
Approx. position																											
Ductline																											
Pole & Street Furniture																											
Substation & Link Box																											