



East Elevation

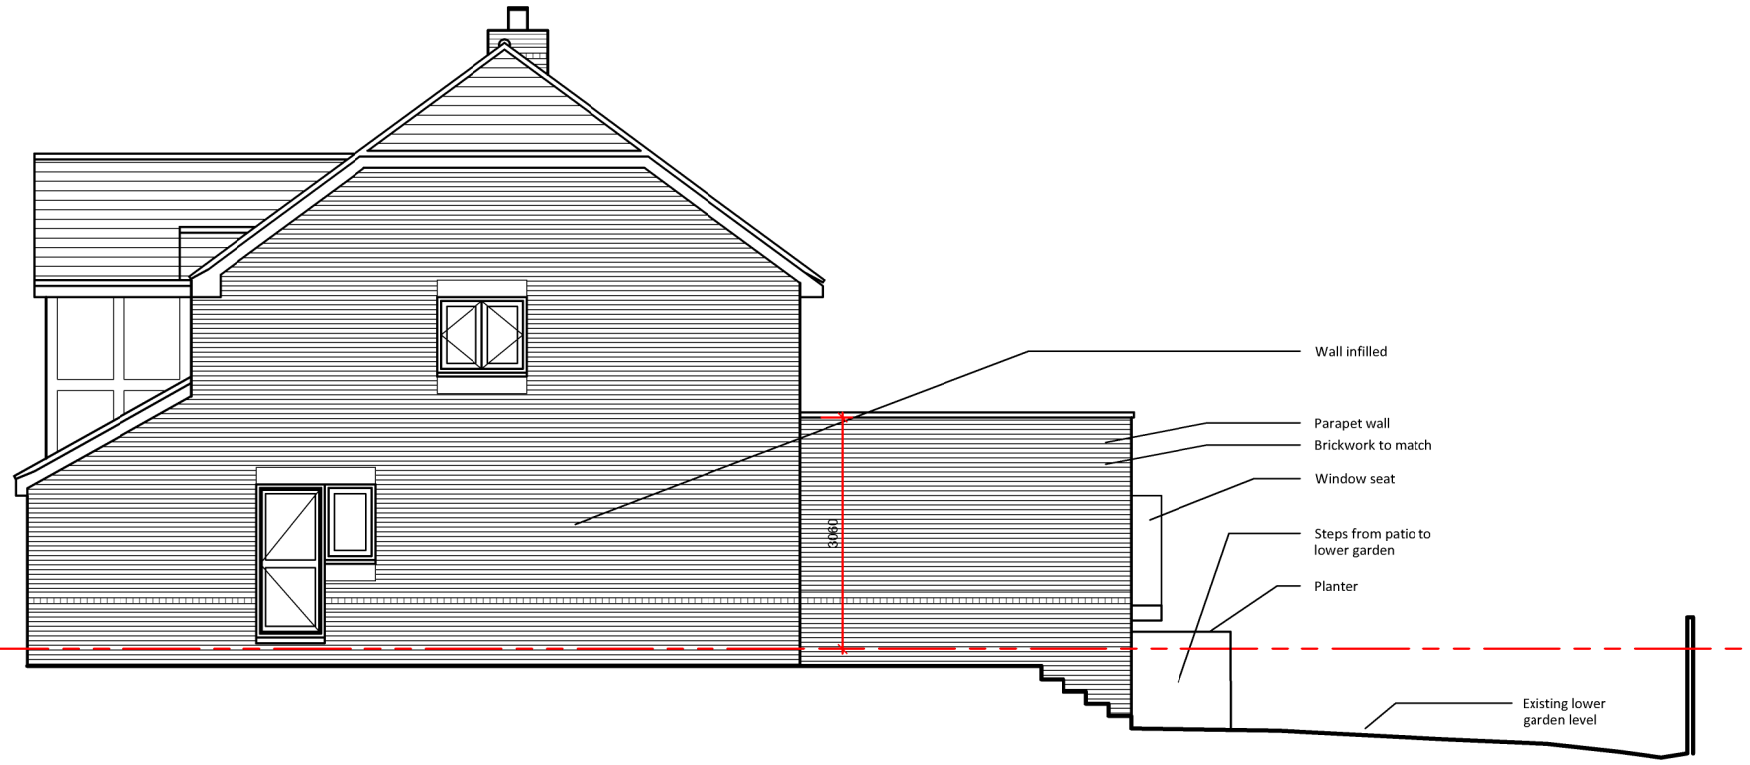

South Elevation

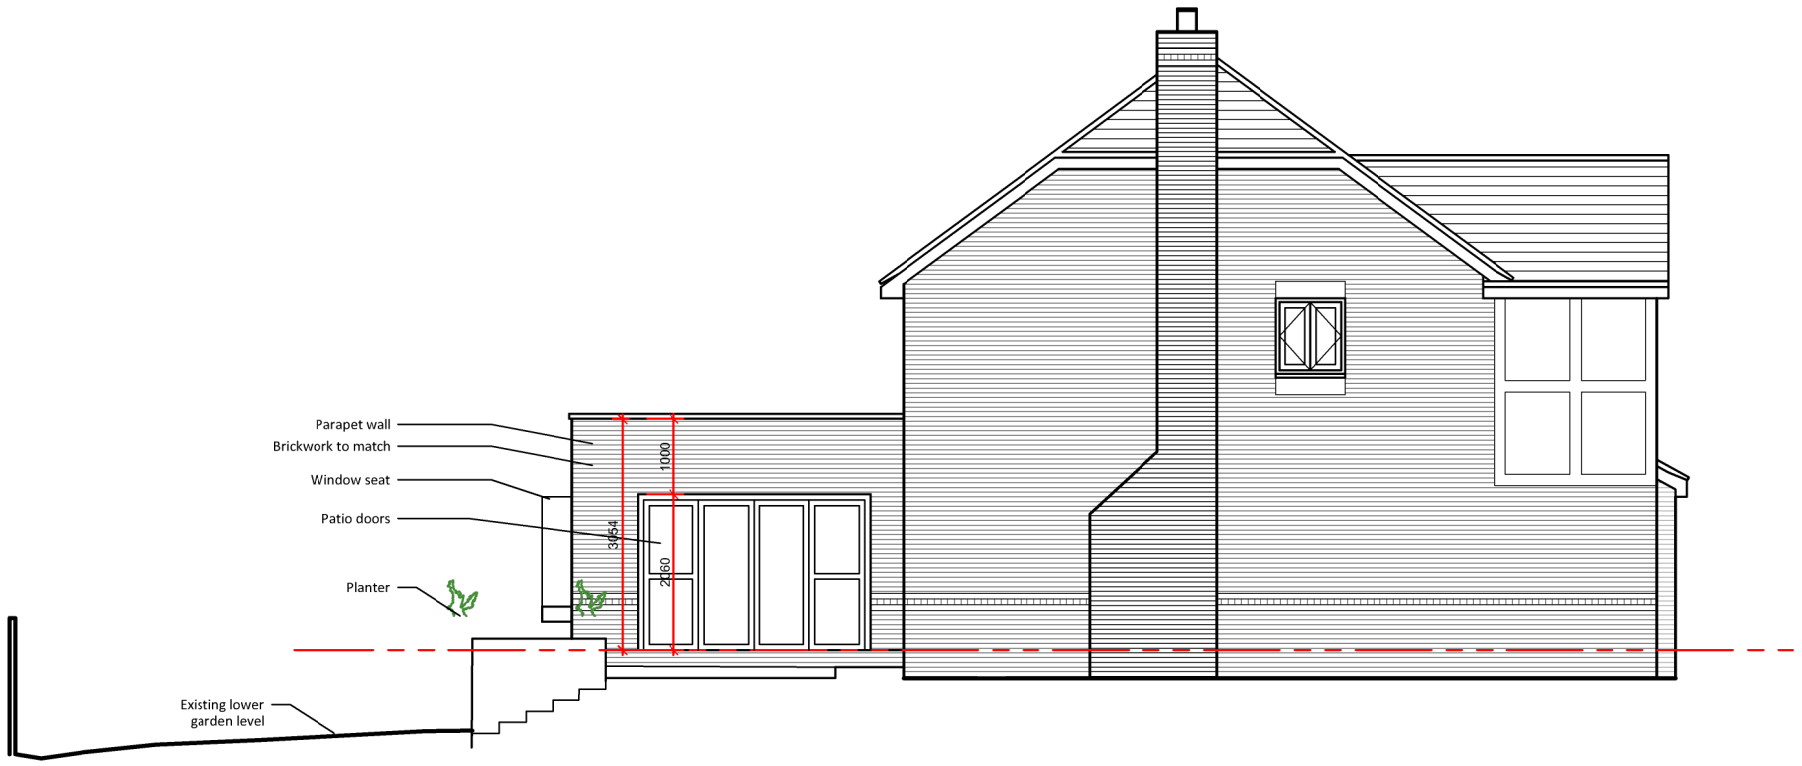

North Elevation

0m 1m 2m 3m 4m 5m 10m

Rev	Date/By	Revision Note
D	10.09.26 JT	Drawings as pe· 'As-Built'
C	11.08.26 JT	Scale of North Elevation altered. West Eevation omitted
B	12.02.25 A	Minor alterations to patio
A	05.02.25 A	Planning Issue

JTA
Jonathan Talley
Architects Limited

Client
Mr and Mrs Dyer

Project
33 Willow Park
Haywards heath
RH16 3UA

Drawing
Proposed Elevations

PLANNING

Drawing Number	Date
067-001-310 Rev D	January 2025
Scale	Paper Size
1:100	A3
Drawn JT	Checked JT

E-mail info@jtalimited.co.uk
Telephone 07956 870 019
Web www.jtalimited.co.uk

All dimensions to be verified on site.
Unauthorised reproduction of information herein is rictly forbidden. Copyright 2022.
Jonathan Talley Architects Limited is the trading nam of Jonathan Talley Architects Limited a limited company registered in England and Wales with registered number 13702?1 whose registered office is at 16 Coniston Avenue, Haywards Heath, RH1? 5LF