

AS BUILT ACCESS

Existing foliage within visibility splay to be cut back.

Retaining wall to be lower than 600mm within visibility splay.

R8.0m

3.9m

1.6m

R7.0m

2.4m * 47m VISIBILITY SPAY

2.4m * 47m VISIBILITY SPAY

COLLEGE ROAD

Granite sets installed indicate mark highway boundary.

Tree with TPO to be unaffected. Does not have an branches within visibility splay as canopy is above visibility splay.

Existing foliage within visibility splay to be cut back.

KEY

BITUMINOUS FOOTWAY CONSTRUCTION (Privately maintained)

300mm surface course resurfacing

PCC HB Kerbs with 125mm upstand

PCC BN Kerbs with 6mm upstand

917mm length transition kerbs (from 6mm to 125mm upstand)

PCC Flush Edging

The location, size, depth and identification of existing services that may be shown or referred to on this drawing have been assessed from non-intrusive investigations, records and/or other sources. The contractor shall safely carry out intrusive investigations, trial holes or soundings prior to commencing work to satisfy himself that it is safe to proceed and that the assessments are accurate. Any discrepancies shall be notified to gta prior to commencing work.

2. Trenching or boring drawings shall not be used for construction or the ordering of materials.

3. Do not scale. All dimensions and levels to be site confirmed.

4. This drawing shall be read in conjunction with all relevant architects' consultants drawings and specifications, together with H&S plan requirements.

5. Copyright: This drawing must not be copied, amended nor reproduced without the prior written agreement of gta.


6. All drawings specifications and recommendations made by gta are subject to Local Authority and other relevant Statutory Authorities' approval. Any works or services made abortive due to the client proceeding prior to these approvals is considered wholly at the Clients risk, gta hold no responsibility for resulting abortive works or costs.

7. If viewing this drawing as an Autocad file (.dwg) in digital format then it is done so with this Disclaimer due to the fact that it can be altered and modified without notice. Issue of this Gta Civils & Transport and therefore, any alteration or modification of DWG data files provided by Gta Civils & Transport, by you or a third party, without Gta Civils & Transport's express written approval, is done so entirely at your own risk. Modification of the drawing is not limited to turning layers on and off, unfreezing layers, and reloading, turning on and off print functions and undoing xrefs.

8. Your attention is also drawn to the fact that the information contained within this file may be subject to alteration at any time, pending technical approval from an approving authority or at the client's instruction. It is therefore strongly recommended that multiple and regular cross checks are made to ensure that the information is correct and up to date.

9. It is your responsibility to ensure that the correct issue or revision of the DWG data file is being used and requests for updated information made accordingly.

10. Should any apparent discrepancies between the data contained within the DWG file and the current contract drawings become evident, it must be reported back to Gta Civils & Transport as soon as reasonably practicable. No responsibility shall be given to the current contract drawings (PDF) unless advised otherwise.

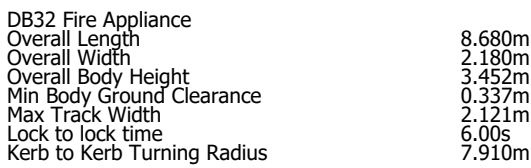

Vehicle Body envelope

[illegible]