
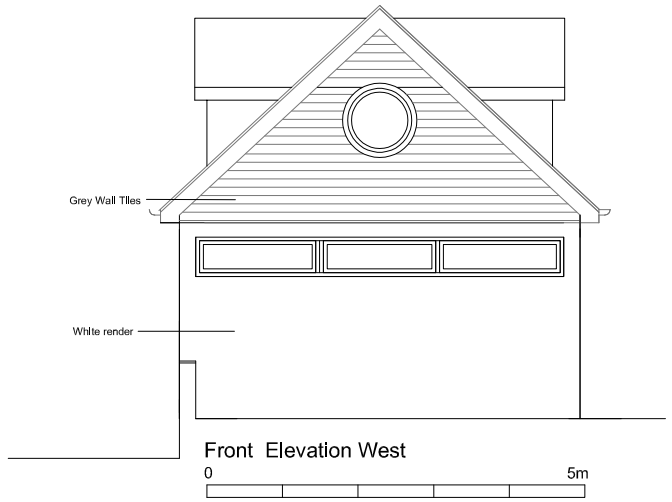



Front Elevation West

0 5m

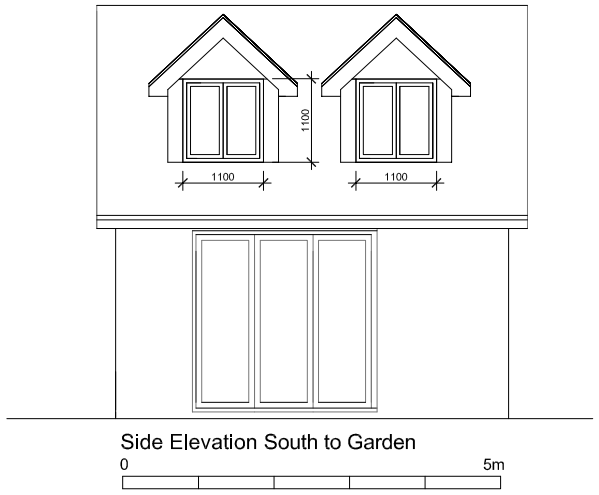


Side Elevation South to Garden

0 5m

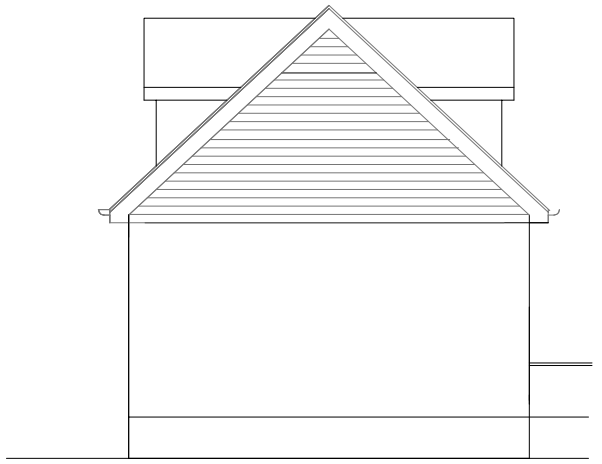

Rear Elevation East


0 5m

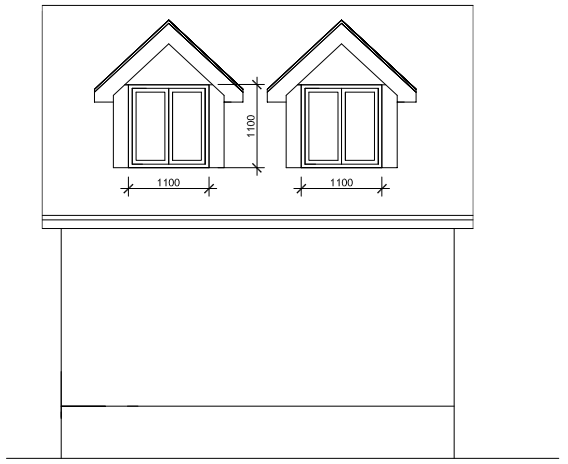

Side Elevation North to Road


0 5m

Dormer windows with tiled pitched roof to match existing
Dormer cheeks finished with Render on Renderboard on 38 treated timber studs at 600mm centres on breather membrane on 9mm OSB on 140mm timber frame with 100mm Celotex GA4000 insulation central to timber frame with 20mm air gap both sides + 12.5 plasterboard internally on 500 gauge vapour control layer

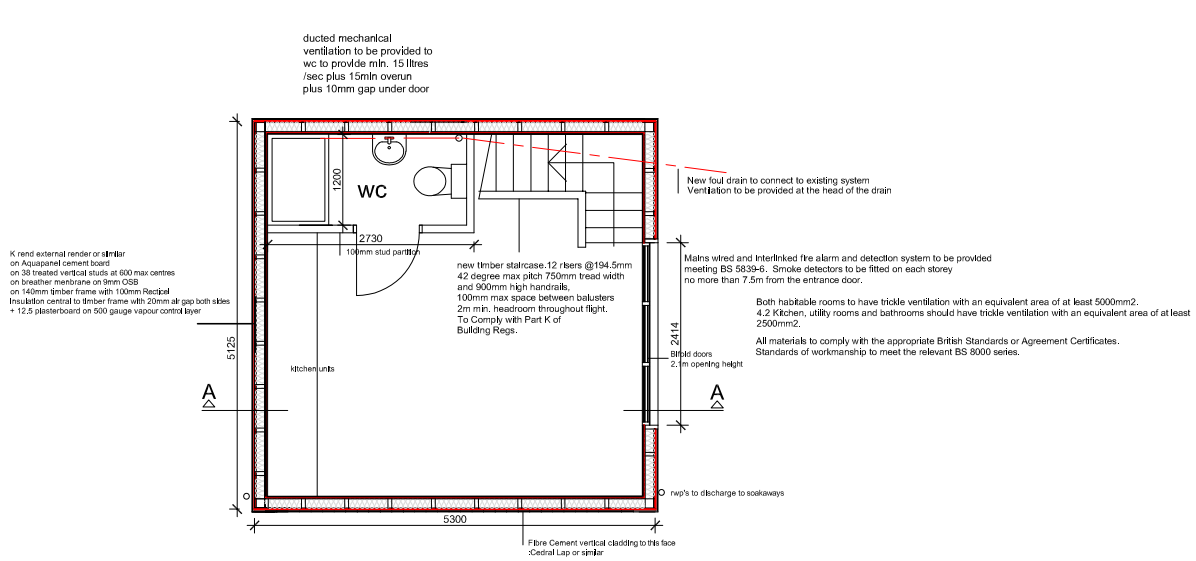


Ground Floor Plan

0 5m

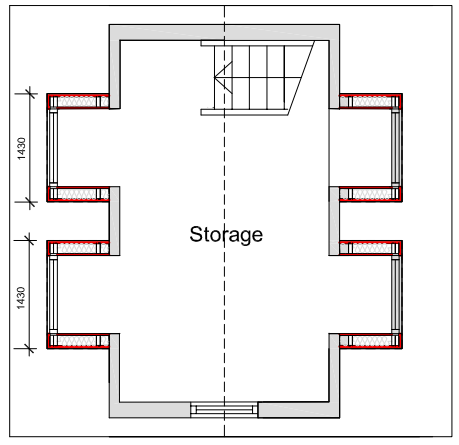

Loft Plan

0 5m

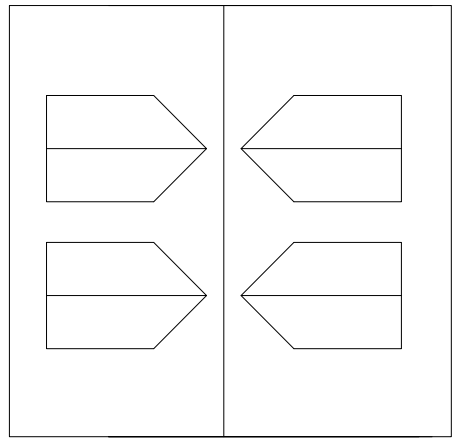

Roof Plan

0 5m

MIKE SILVERWOOD ARCHITECT LTD
MICHAEL SILVERWOOD R.I.B.A.
CHARTERED ARCHITECT
100 Gilders Rd Chessington, KT9 2AN
078855 39367
mikesilverwoodarchitect@yahoo.com
www.michaelsilverwoodriba.co.uk

Drawing : As-built plans and Elevations

Scale : 1:100 @ A3
Date : 2025.07.23

Drawing no: AB.01

-

Rev. /

Project :
49 Marlpit Rd, East Grinstead