DAVID JENKINS DESIGN
ARCHITECTS, PLANNING & BUILDING CONSULTANTS

T: 01444 484811
E: info@davidjenkinsdesign.co.uk

The Architects Office, Gower Road, Haywards Heath RH16 4PL

- ○ SURVEY
- ○ FEASIBILITY
- ● PLANNING
- ○ BUILDING REGULATIONS
- ○ CONSTRUCTION

Notes

Do not scale, use figured dimensions only.

All dimensions to be verified on site prior to the commencement of any work or the production of any shop drawing. All discrepancies to be reported to the Architect.

This drawing is to be read in conjunction with all related Architect's and Engineer's drawings and any other relevant information. It is the contractors responsibility to ensure that all works are in compliance with Building Regulations.

This drawing is copyright of David Jenkins Design.

North Elevation

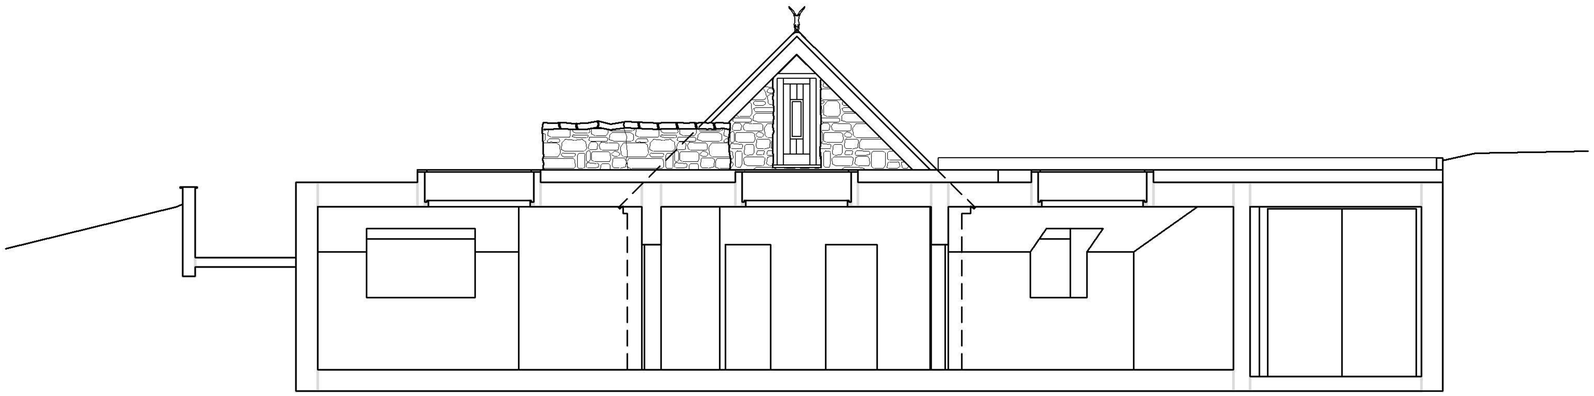

South Elevation

Date	Revision
L	
K	
J	
I	
H	
G	
F	
E	
D	
C	
B	
A	

0 1m 2m 3m 4m 5m 6m 7m 8m 9m
1:100

Client	MR & MRS COOPER
Project	BROADHURST STABLES BROADHURST MANOR ROAD HORSTED KEYNES
Title	NORTH AND SOUTH ELEVATIONS AS BUILT

Date	Scales	Dwg. No.	Rev.
09/25	1:100 @ A3	805/06	