

Plan Notes

Impacts

Holes excavated for fence posts intrude into te RPA's of all trees with the exception of T1, T7 and T9. T9 has no RPA as a category 'U' tree.

The level of intrusion is minimal at <0.5% for all trees except T005 where it is <1%.

No evidence of overhead constraints requiring tree works with the exception of T9, a category 'U' Holly which required the removal of one secondary stem.

Anecdotal evidence reports that no significant roots were encountered during excavations. On site trial pits x4 confirmed this statement.


Tree Protection

All works were carried out using hand tools only.
Excavations for fence posts were restricted to 0.09sqm each.
Where wet pour concrete was used holes have been lined with an impervious membrane (evidenced).

THE CRESCENT

New Fence
Indicated by red line

Tree Legend

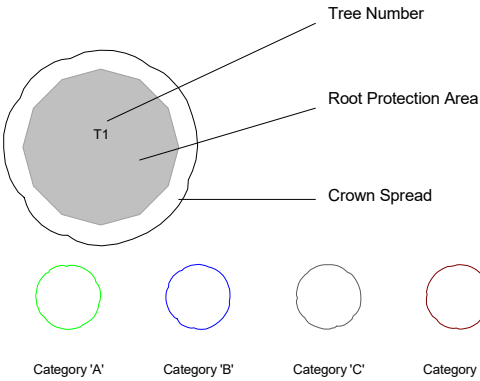

Connick Tree Care
New Pond Farm, Woodhatch Road, Reigate, Surrey, RH2 7QH
Tel: 01737 779191
Email: info@connicktrecare.co.uk

Tree Constraints Plan

SCALE : 1 : 200 @ A3
DATE : 02/02/2026
MAP FILENAME : 228264/TCP/MH
SITE: 8 The Crescent, Hassocks, BN6 8RB

Pear Technology Services Ltd, Email info@peartechology.co.uk
Maps based on Ordnance Survey MasterMap or 1:25000 Mid-scale data with the permission of the Controller of HMSO. © Crown Copyright

